

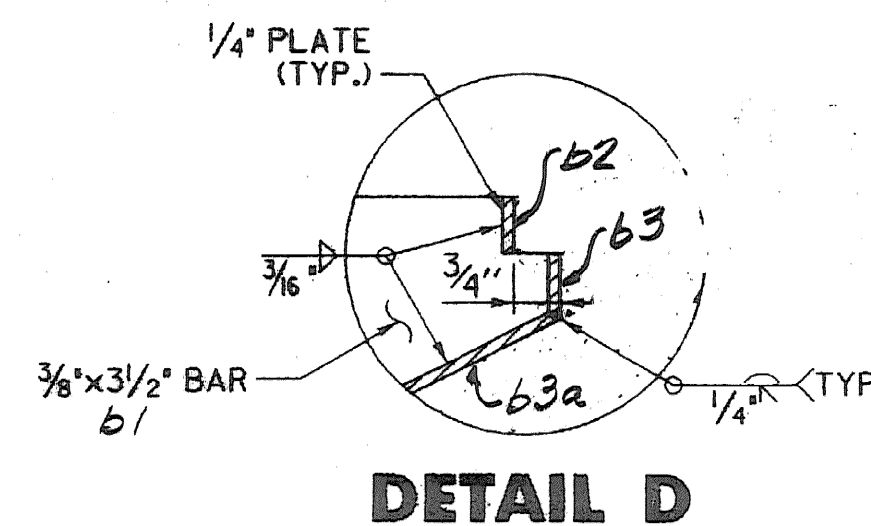
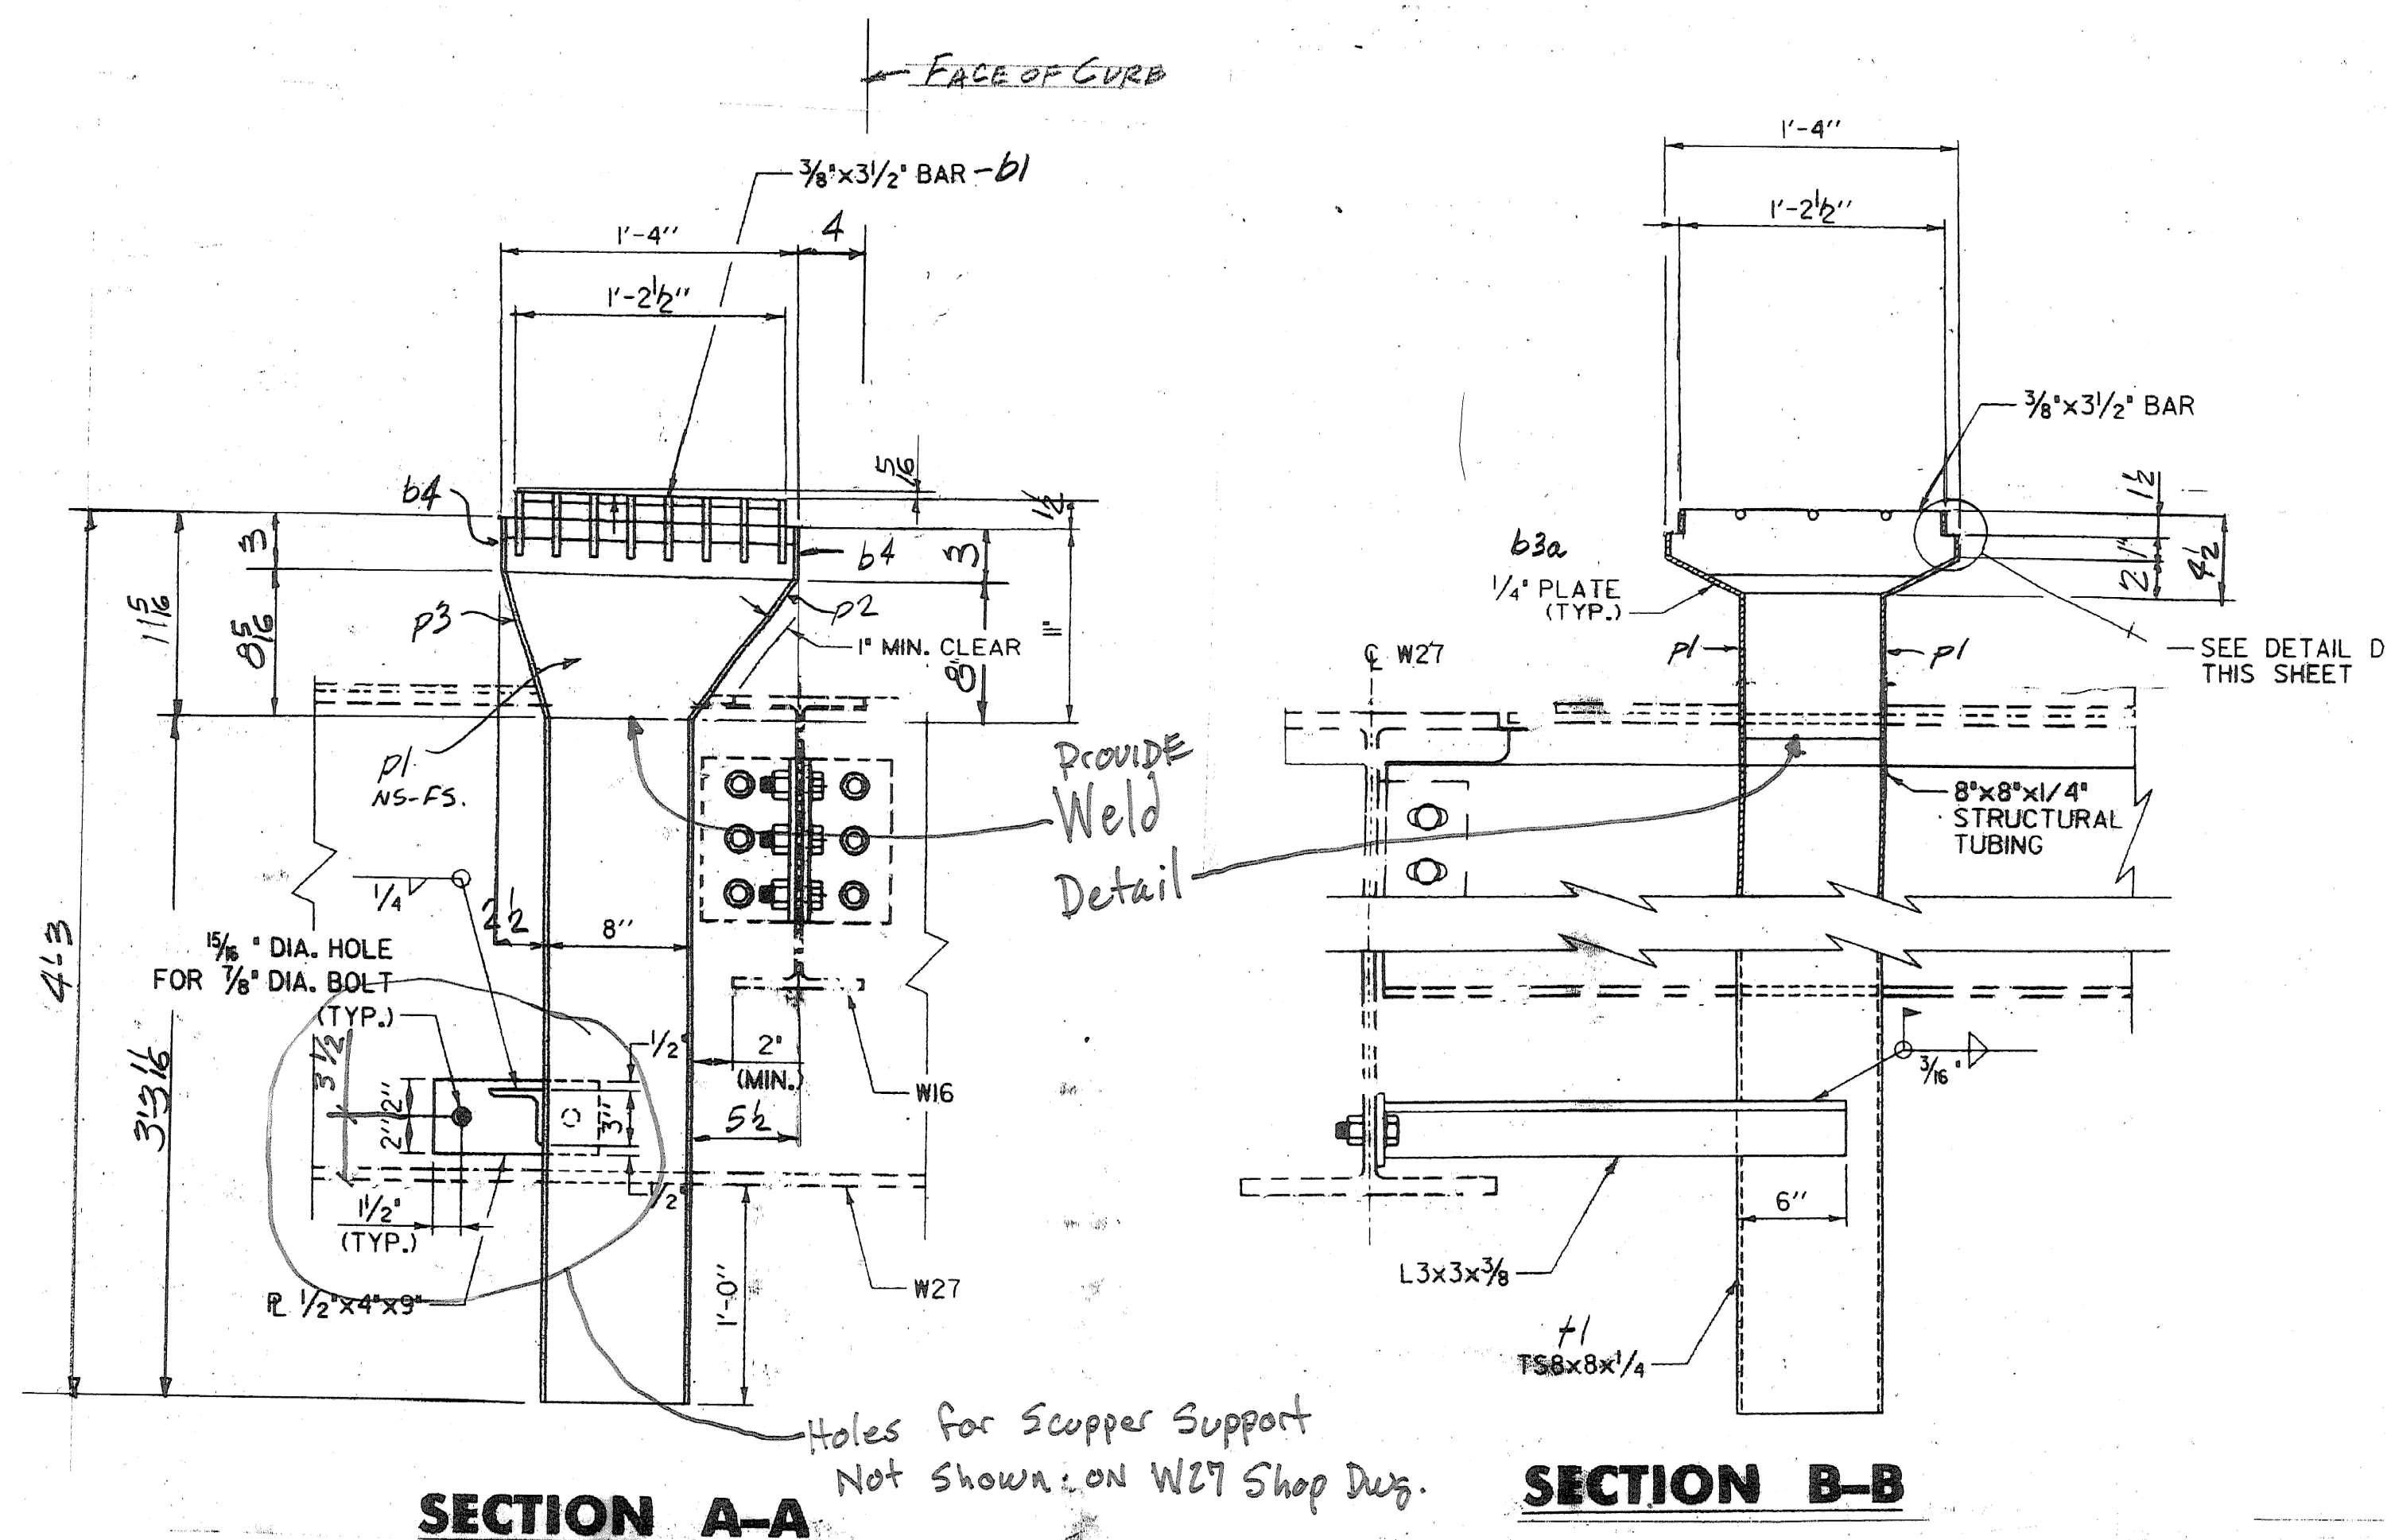
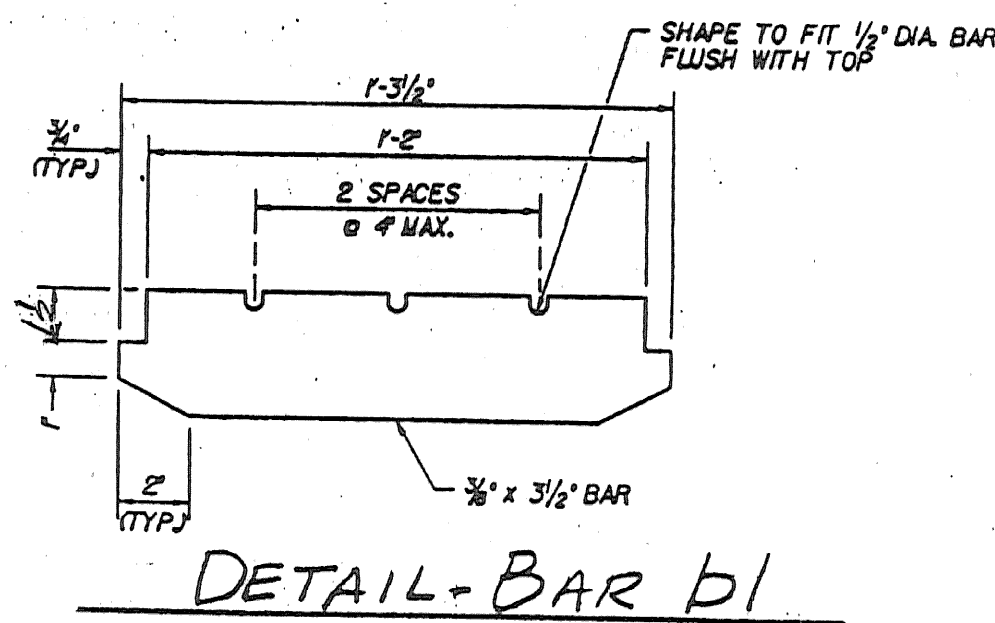


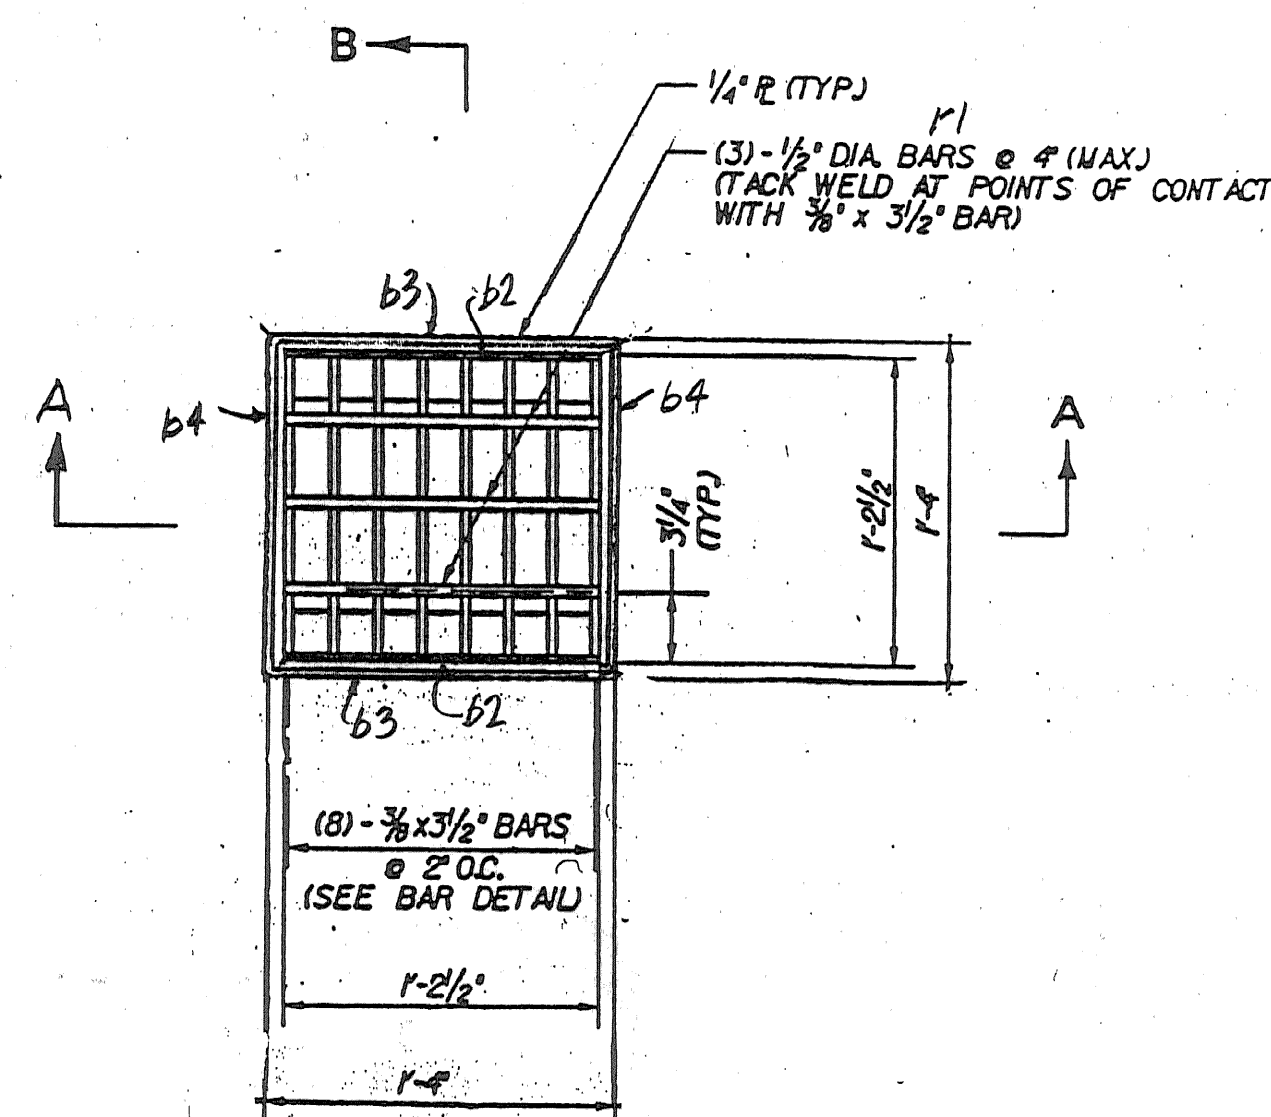

ABM INFO		SHOP BILL					JOB NO. 351	DRG. NO. M1	
PAGE	LINE	NO.	DESCRIPTION	FT	IN	ASSEM. MARK	SHIPPING MARK	REMARKS	WEIGHT
		4	SCUPPERS	4	3		SC1		—
		4	TS 8x8x4	3	3 1/2	+1		PER SUBJECT 74.11	
		32	BAR 3/2 x 3/8	1	3 1/2	b1			
		8	BAR 1/2 x 4	1	2 1/2	b2			
		8	BAR 1" x 4	1	4	b3			
		8	BAR 3/2 x 4	1	4	b3a			
		8	BAR 3 x 4	1	3 1/2	b4			
		12	1/2" BAR	1	2 1/2	F1			
		8	2 1/2 x 3 1/2	1	3 1/2	P1			
		4	2 1/2 x 7 1/2		9 1/2	P2			
		4	2 1/2 x 7 1/2		8 1/2	P3			
		2	L3x3x3/8	2	1 1/2		SAIR		
		2	DO	2	1 1/2		SAIR		
		4	BAR 4x2		9	b5			
		8	2 1/2" TC BOLTS = GALV.	2 1/2			FIELD	w/NEW.	
PAY ITEM: 506.60									

SCUPPER - SC1 - 4 REQ'D.

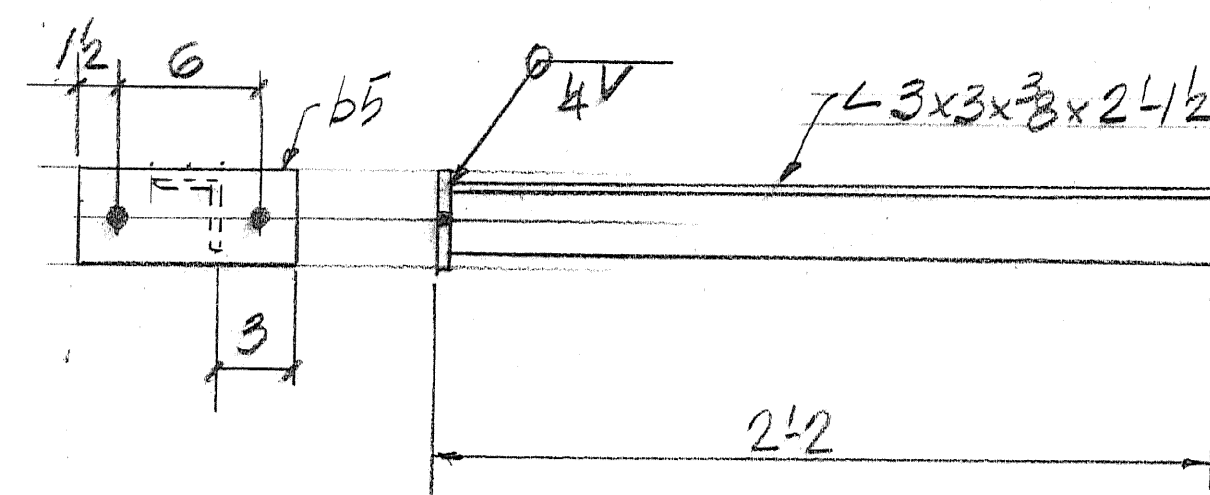

SAIR - 2 - REQ'D - AS SHOWN
 SAIR - 2 - REQ'D - OPPHAND

SHOP DRAWINGS ARE REVIEWED UNLESS NOTED OTHERWISE

NO EXCEPTION TAKEN

REVISE AS NOTED

REVISIONS NOT REQUIRED

REVISE AS NOTED

REVISIONS NOT REQUIRED

REJECTED

DATE 4/17/08

SIGNATURE [Signature]

REVIEW BY STANTEC IS FOR THE SOLE PURPOSE OF ASCERTAINING GENERAL CONFORMITY WITH DESIGN. CONTRACTOR IS RESPONSIBLE FOR DIMENSIONS, FABRICATION AND CONSTRUCTION. DETAIL DESIGN OF COMPONENTS AND METHODS OF COORDINATION OF SUB-TRADES OR OMISSIONS ON SHOP DRAWINGS.

OUT FOR APPROVAL 1/28/08

OUT FOR APPROVAL

ISSUED TO SHOP

FIELD & OFFICE

REV.	REMARKS	DATE	DMN	CHK	APP	Q.A.	NO.	DIA.	LGT	TYPE	WASHER
PROJECT NO. B4F-0302(3) S	STATE PROJECT NO.										
MATERIAL: A572-GR50	ELECTRODES: SEE PROC	HOLES: 1/8" R	SHOP BOLTS: -								
SURFACE PREP. & PAINT:											
GALVANIZE PER SUBJECT. 506.15, PART (a)											
DESCRIPTION: SCUPPERS											
JOB: IMPROVEMENTS											
BRIDGE No. 41 ON TH No. 2											
RICHFORD, VT.											
CUSTOMER: BLOW & COTE INC.											
CASCO BAY STEEL STRUCTURES, INC.											
75 SPRING HILL ROAD SACO, MAINE 04072											
PHONE (207) 282-7360 FAX (207) 282-1179											
JOB NO. 361											
DRG. NO. M1											
REV. 1											