



FED. ROAD DIST. NO.	STATE	FED. AID PROJ. NO.	FISCAL YEAR	SHEET NO.	TOTAL SHEETS
9	VT.				

495

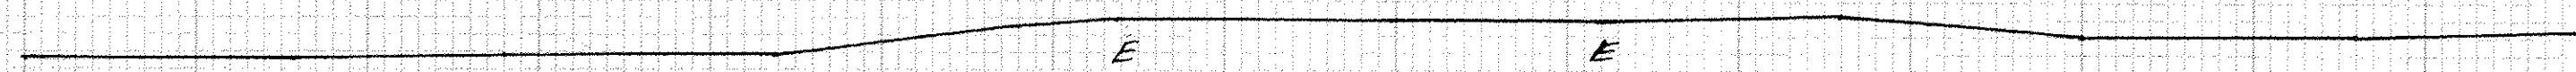


2 + 0

500

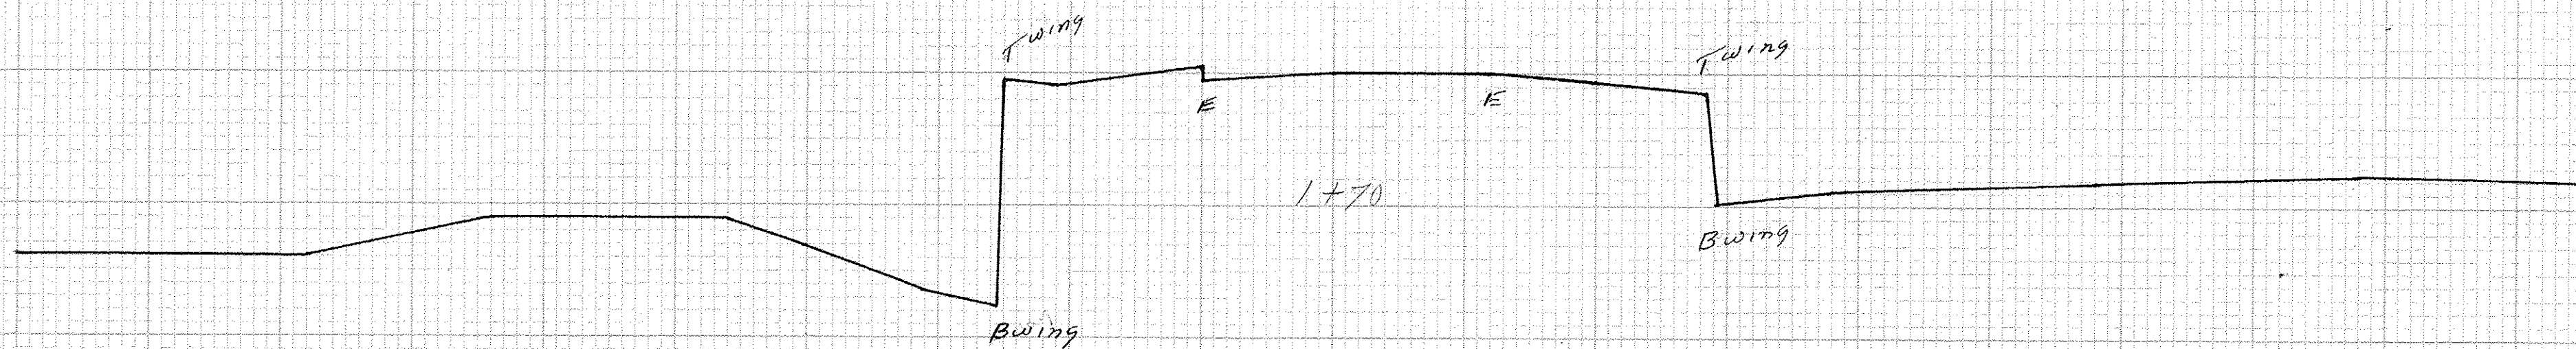

500

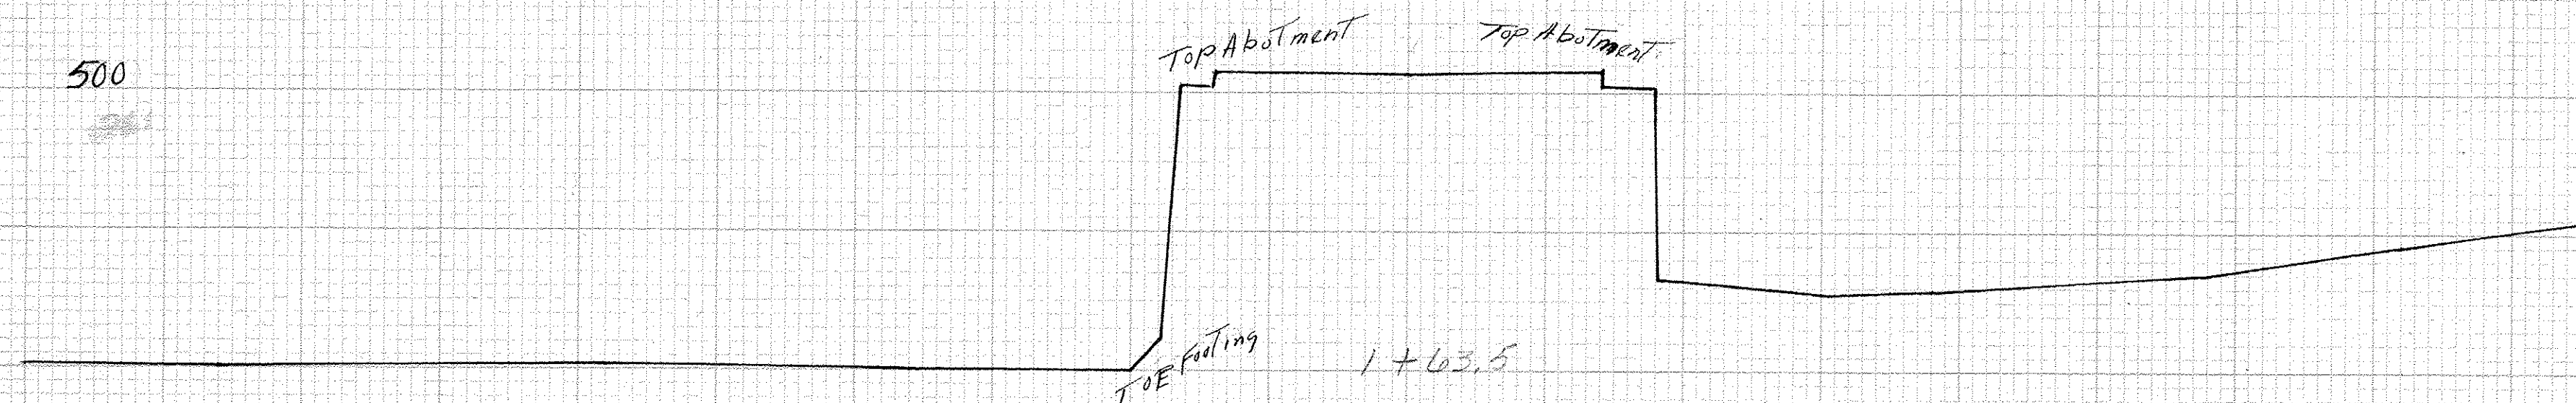

Hancock Churchville Bridge #5C

LEVELS BY	Barrett	CKD. BY	CKD. BY
SECTIONS PLOTTED BY	Kennedy	CKD. BY	CKD. BY
PLANIMETERED BY		CKD. BY	CKD. BY
EXAMINED BY		NO.	FILED
SHEET		OF	