
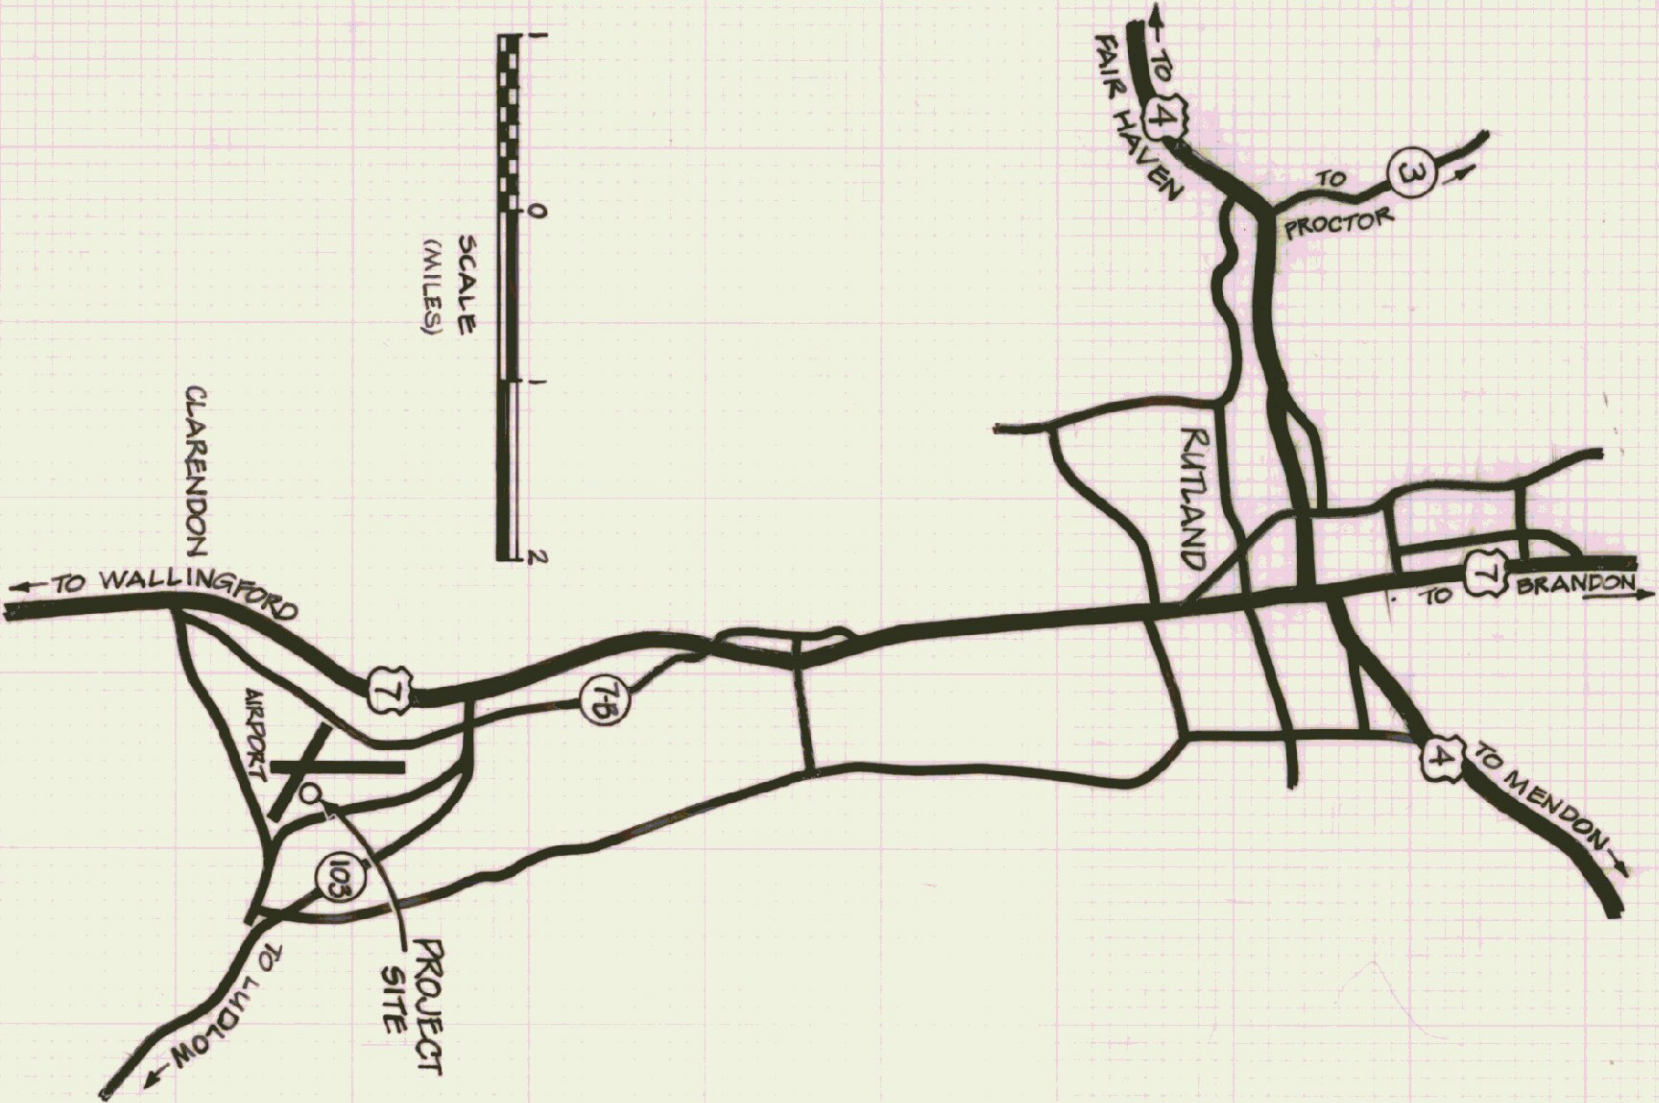


STATE OF VERMONT
AGENCY OF TRANSPORTATION

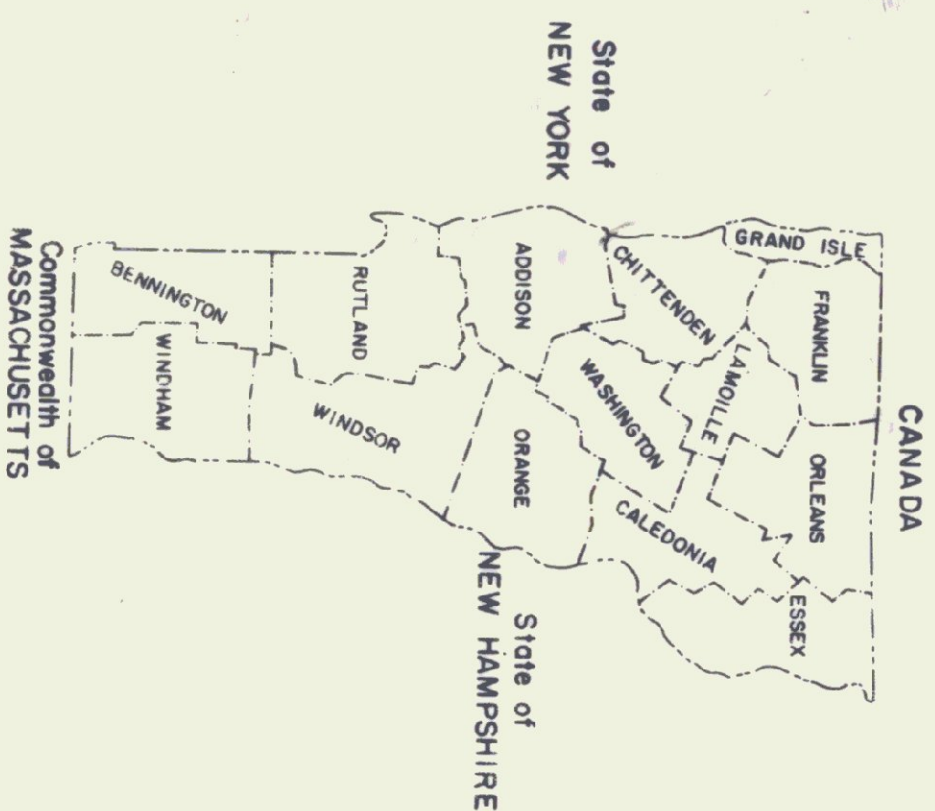

TERMINAL BUILDING
RUTLAND STATE AIRPORT
CLARENDON, VERMONT

AIR 23-2024

PROJECT TO INCLUDE THE SITE PREPARATION AND CONSTRUCTION OF AN AIRPORT
TERMINAL BUILDING WITH ITS PLUMBING, HEATING, AND ELECTRICAL APPLIANCES.
PROJECT ALSO INCLUDES LAYOUT AND PAVING OF AN APRON EXTENSION AREA.

SYMBOLS	
DIMENSION TO TOP, POS. OR C.	(REF. #)
MAJOR SECTIONS THROUGH BLDG	(SHEET #)
LARGE SCALE DETAILS & SECTIONS (IN DETAIL BOOK)	
MATERIAL IN A RELATED PLANE	
INTERIOR ELEVATIONS	(ELEV. #)
DIAMETER	(SHEET # ELEV. APPLICABLE ONLY)
EARTH	
SAND OR GRB	
GRAVEL	
CRUSHED STONE	
CONCRETE	
CEMENT MASONRY UNIT	

BRICK	
SLATE	
STONE	
STEEL REINFORCING	
STEEL CROSS SECTION	
PLYWOOD	
WOOD FRAMING CROSS SECTION - CONTINUOUS	
WOOD FRAMING CROSS SECTION - DISCONTINUOUS	
FINISH WOOD CROSS SECTION	
FINISH WOOD FACE GRAIN	
FIBERGLASS INSULATION	
RIGID INSULATION	

ABBREVIATIONS	
AB	ANCHOR BOLT
BLDG	BUILDING
BTW	BETWEEN
CB	CARRIAGE BOLT
CL	CENTER LINE
CL	CLOSEST
CNU	CEMENT MASONRY UNIT (CONCRETE BLOCK)
CLS	COLUMNS
CONT	CONTINUOUS
DBL	DOUBLE
DF	DRINKING FOUNTAIN
DR	DOOR
DN	DOWN
EF	EACH FACE
EL	ELEVATION
EW	EACH WAY
EXT	EXTERIOR
FO	FLOOR CLEAN OUT
FD	FLOOR DRAIN
FDN	FOUNDATION
FEC	FIRE EXTINGUISHER CABINET
FOF	FACE OF FOUNDATION
FOS	FACE OF STUD
GBB	GRIPSIM WALL BOARD
HCP	HANDICAPPED


INDEX TO DRAWINGS*	
1 OF 23	T-1 TITLE SHEET
2 "	SITE DRAWINGS
23 OF 23	S-1 SITE PLAN & LANDSCAPING S-1a REVISIONS S-1b REVISIONS - AS BUILT ARCHITECTURAL
3 "	A-1 FOUNDATION PLAN
4 "	A-2 FIRST FLOOR PLAN
5 "	A-2 REF FIRST FLOOR REFERENCE PLAN
6 "	A-3 MEZZANINE PLAN
7 "	A-4 NORTH & EAST ELEVATIONS
8 "	A-5 SOUTH WEST ELEVATIONS
9 "	A-6 N/S SECTIONS & RESTROOM ELEVATIONS
10 "	A-7 E/W SECTIONS & INTERIOR ELEVATIONS
11 "	STRUCTURAL
12 "	SF-1 MEZZANINE FRAMING
13 "	SF-2 ROOF FRAMING
14 "	SF-3 FRAMING X-SECTIONS
15 "	ELECTRICAL
16 "	E-1 EQUIPMENT ELEVATIONS & MEZZANINE ELECTRICAL PLAN - AS BUILT
17 "	E-2 FIRST FLOOR ELECTRICAL PLAN & PLAN LAYOUT - AS BUILT
18 "	MECHANICAL
19 "	M-1 HEATING PLAN & DETAILS - AS BUILT
20 "	P-1 PLUMBING PLAN & DETAILS - AS BUILT
21 "	STANDARD SITE DETAILS
22 "	STANDARD DR (APRIL 4, 1973)
23 "	STANDARD D11(AUGUST 24, 1982)
24 "	APPENDIX NO. 1
25 "	A-8 VERTICAL LIFT - HANDICAPPED
26 "	*FOR LARGE SCALE DETAILS SEE "DETAIL BOOK"

NO	DATE	DESCRIPTION	NO
1	12-17-84	REVISIONS SIMPSON - YELLOW HILLS FOR A	1
2	12-20-84	A.O.T. 1 SET YELLOW HILLS	2
3	1-7-85	SIMPSON - 4, L&H-1, KCE-1, W&V-1 SEES LESS 18 & 19 OF 20 (REMOVED SITE DETAILS)	3


AIP 3-50-0015-02

AGENCY OF ADMINISTRATION DEPARTMENT OF STATE BUILDINGS	APPROVED DATE 8/10/84
COMMISSIONER	
SUBMITTED BY ORDER OF THE STATE TRANSPORTATION BOARD	
APPROVED DIRECTOR OF ENGINEERING AND CONSTRUCTION	DATE 8/10/84
DEPARTMENT OF TRANSPORTATION FEDERAL AVIATION ADMINISTRATION	
APPROVED CHIEF ENGINEERING BRANCH - AIRPORTS DIVISION	
PROJECT AIR No 23-2024	
SHEET 1 of 20 SHEETS	

TYPE 'A' PAYER PLAN

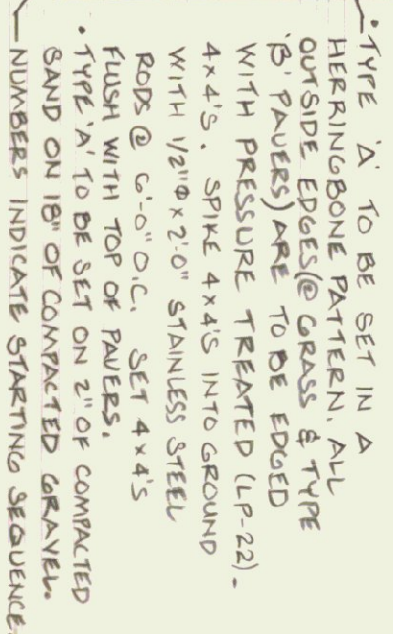

SCALE: FULL SIZE

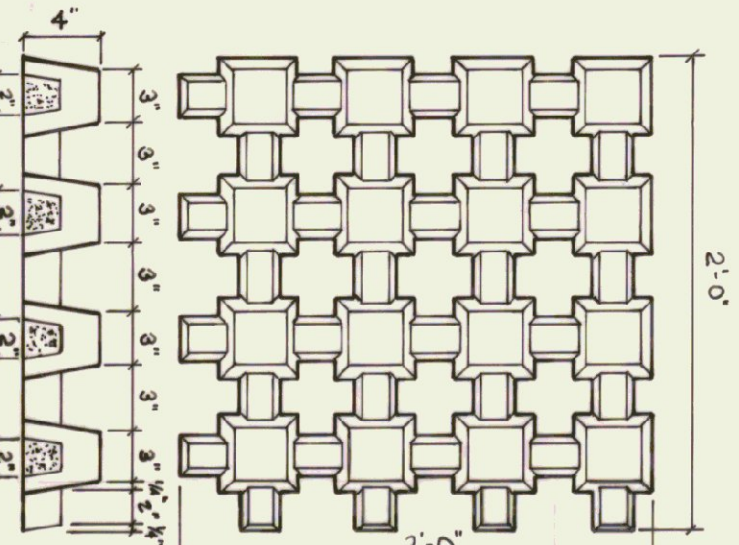


TYPE 'B' PAPER

BUTT UNITS CONTINUOUSLY PER LOCATION AS INDICATED ON SITE PLAN.



TYPE 'B' PAPER


TYPE 6) TO BE SET ON 2 OF COMPACTED SAND ON 10' OF COMPACTED GRAVEL, FILL JOINTS IN PAVEMENT FLUSH WITH A MIXTURE OF TOPSOIL, LIME, FERTILIZER (10-20-20) AND PEAT MOSS, WATER WITH A MIST SPRAY TO SETTLE. ADD ADDITIONAL TOPSOIL MIX TO BRING THE TOPSOIL FLUSH WITH TOP OF THE PAVEMENT. SEED AT SLIGHTLY LESS THAN NORMAL RATE, AND MULCH. WHEN GRASS IS 2 1/2" HIGH, CUT TO 1 1/4".

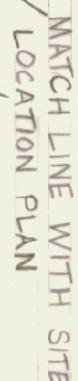

LOCATION PLAN


PLANTING LIST		SIZE & REMARKS
1	P. PERUVIANIKLE 1650 PLANTS @ 9" x 1/2 in 5 BEDS - VINCA MINOR	6"-9" HT. 18"-24" SPREAD 5 GAL. C
2	CJ - CREEPING JOUNIPER - 65 PLANTS @ 3' x 1/2 - 2 BEDS - JOUNIPER HORIZONTALIS	BARE ROOT
3	PJ - PROSTRATE CREMONA JOUNIPER - 124 PLANTS - 3' x 1/2 - 4 BEDS - JOUNIPER C. DRESSERA	12"-15" HT. 24"-30" SPREAD 5 GAL. C
4	LB - LOW BUSH PLEASANT BERRY - 120 PLANTS - 2' x 1/2 in 2 BEDS - V. AUSTRIACA LAEVIFL	6"-9" HT. 6" FIBER POT
5	CR - CAROLINA ROSE - 56 PLANTS @ IN TWO BEDS - - ROSA CANADIANA	18"-24" HT. 2 GAL. C
6	VR - VIRGINIA ROSE - 22 PLANTS IN 2 BEDS - - ROSA VIRGINIANA	24"-30" HT. 3 GAL. C
7	SB - SINKING BERRY - 22 PLANTS @ 4' x 1/2 in ONE BED - SYMPLOCARPA ALBIDA LINDL	3'-4" HT. 3 GAL. C / 6" B B B

FOR GRAIS & LAYOUT OF ROADS NORTH
OF SITE WORK CONTRACT LIMIT LINE
REFER TO DRAWINGS FOR RUTLAND STATE AIRPORT, DATED 8-15-83
PREPARED BY PINKHAM ENGINEERING ASSOC., INC.,
DRAWING 3 OF 44 FOR GRADES, AND
DRAWING 15 OF 44 FOR ROAD LAYOUT.

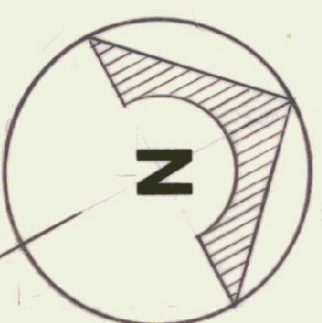

KEY:

 STEWOKER CONTRACT LIMITS
FIRST 6 CONTRACTS @ 110000000
PREPARED CONTOURS
SAINT PARY SEWER
WATER ENTRY
ELECTRICAL ENTRY
TYPE 'A' PAVERS
TYPE 'B' PAVERS.



 FENCE - X.F. = EXISTING
 - X.F. = REMOVED
 RF = RELOCATED
 GRANITE CURBING

METAL EDGING
AT PLANTING BEDS

DIVISION OF STATE BUILDINGS
AGENCY OF ADMINISTRATION
MONTPELIER, VERMONT


RUTLAND TERMINAL BUILDING AIR 23-2024

RUTLAND STATE AIRPORT
CLARENDON, VERMONT

① AS BUILT RUTLAND STATE AIRPORT PARKING LOT EXTENSION DRAWINGS DATED 7-23-73, GUY D'AMICO, RESIDENT ENGINEER.
② DRAWINGS PREPARED BY DURENE - HENRY, RUTLAND STATE AIRPORT CONTACT 1 OF 2, PLAN & PROFILE SHEET 4 OF 13, AND GRADING, DRAINAGE DETAILS AND PROFILES SHEET 5 OF 13, DATED 9-12-77 & 9-8-77.

ISSUE RECORD		NO
DATE	DESCRIPTION	PTS
12-1-84	NEVERGIONS SIMPSON HUNG FOR A	1
12-20-84	ADJ. OPERATIONS-1 A. YELSON HUNG SIMPSON-1 KC-1, VV-1	2 7

DATE: 6-8-84	SCALE: 1" = 2'-0"	REVISIONS: 6/27/84 S.A.MULLER	DWG. NO. S-1
DRAWN BY: RA	APPROVED BY: RA FOR DSB	Δ 10-30-84	2 OF 20

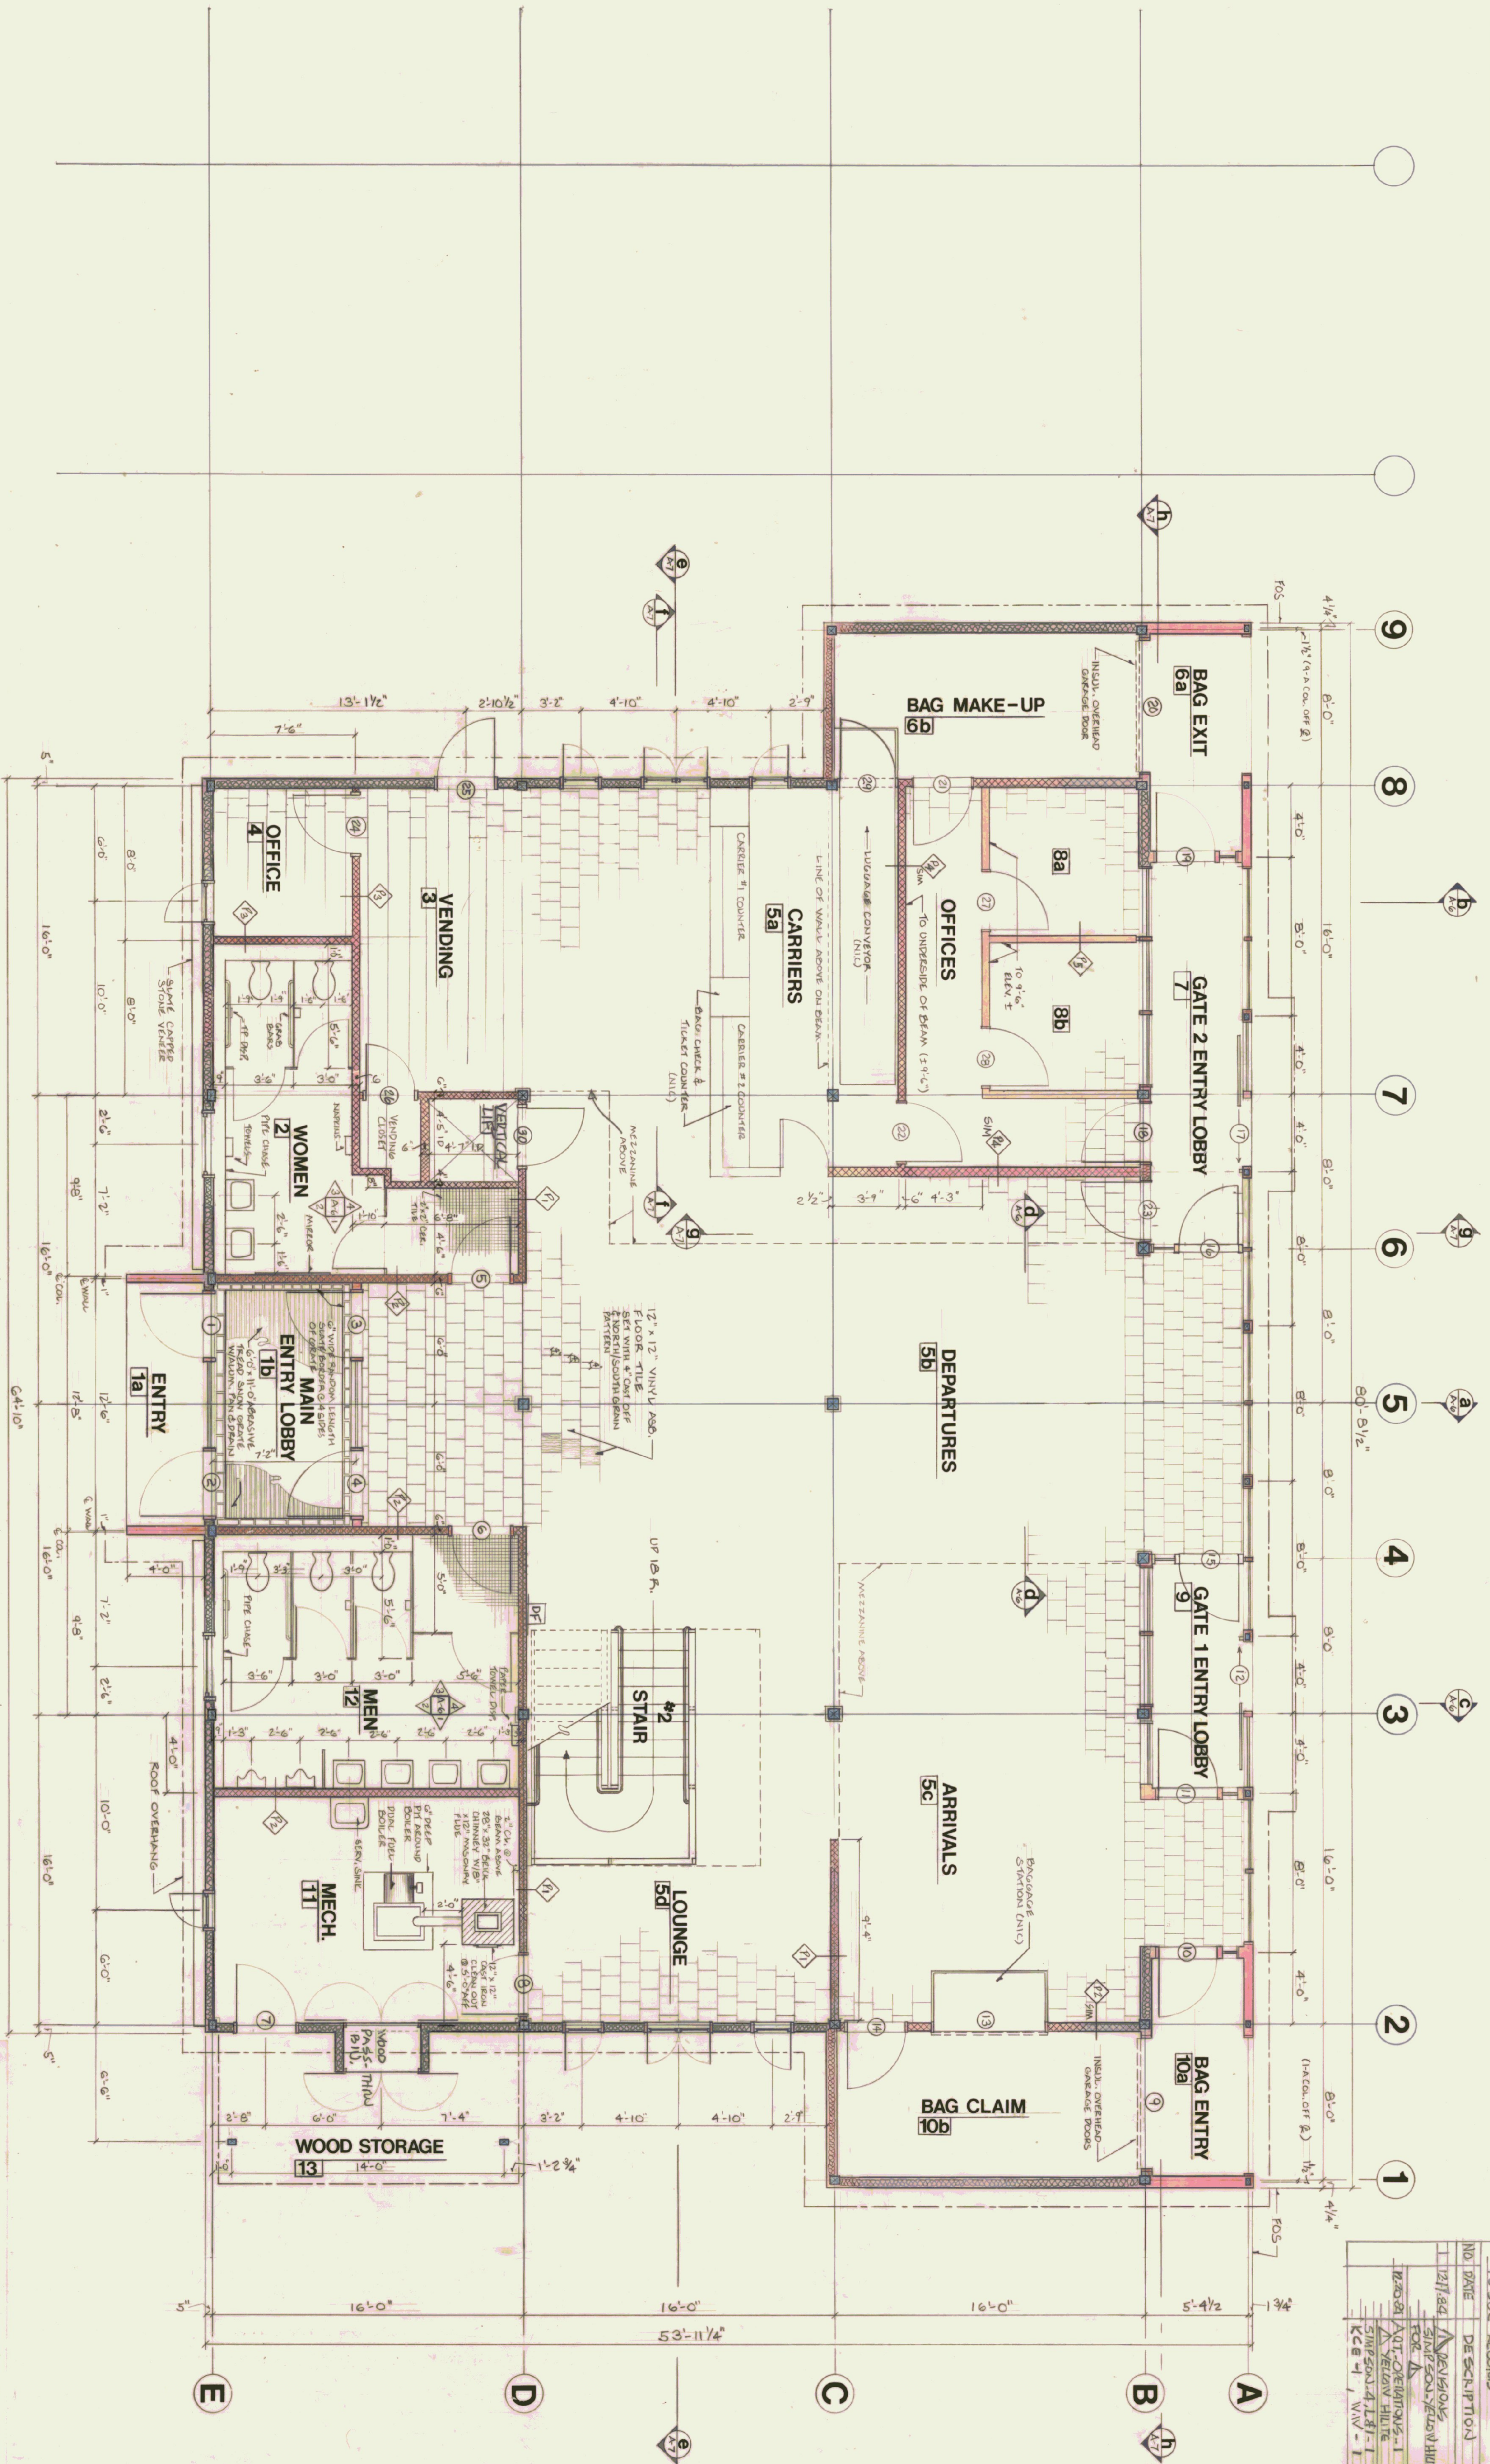

REVISION RECORD		
NO.	DATE	DESCRIPTION
1	12/1/84	REVISIONS SIMPSON, J. H. HILL FOR A
2	12/28/84	REVISED SIMPSON, J. H. HILL FOR A
3	1/1/85	REVISED SIMPSON, J. H. HILL FOR A
4	1/1/85	REVISED SIMPSON, J. H. HILL FOR A
5	1/1/85	REVISED SIMPSON, J. H. HILL FOR A
6	1/1/85	REVISED SIMPSON, J. H. HILL FOR A
7	1/1/85	REVISED SIMPSON, J. H. HILL FOR A

STATE OF VERMONT
DIVISION OF STATE BUILDINGS
AGENCY OF ADMINISTRATION
MONTPELIER, VERMONT


RUTLAND STATE AIRPORT
CLARENDON, VERMONT
FIRST FLOOR PLAN
RUTLAND TERMINAL BUILDING AIR 23-2024

DATE: 6/18/84
DRAWN BY: J. H. HILL
SCALE: 1/4" = 1'-0"
APPROVED BY: J. H. HILL
SIGNED: J. H. HILL
10-30-84


REVISIONS:
1. 12/1/84
2. 12/28/84
3. 1/1/85
4. 1/1/85
5. 1/1/85
6. 1/1/85
7. 1/1/85

DWG. NO.
A2
4 OF 20

ISSUE RECORD		
NO.	DATE	DESCRIPTION
1	10/10/84	REVISIONS
2	10/20/84	FOR A-2 REF
3	10/20/84	FOR A-2 REF
4	10/20/84	FOR A-2 REF
5	10/20/84	FOR A-2 REF
6	10/20/84	FOR A-2 REF
7	10/20/84	FOR A-2 REF

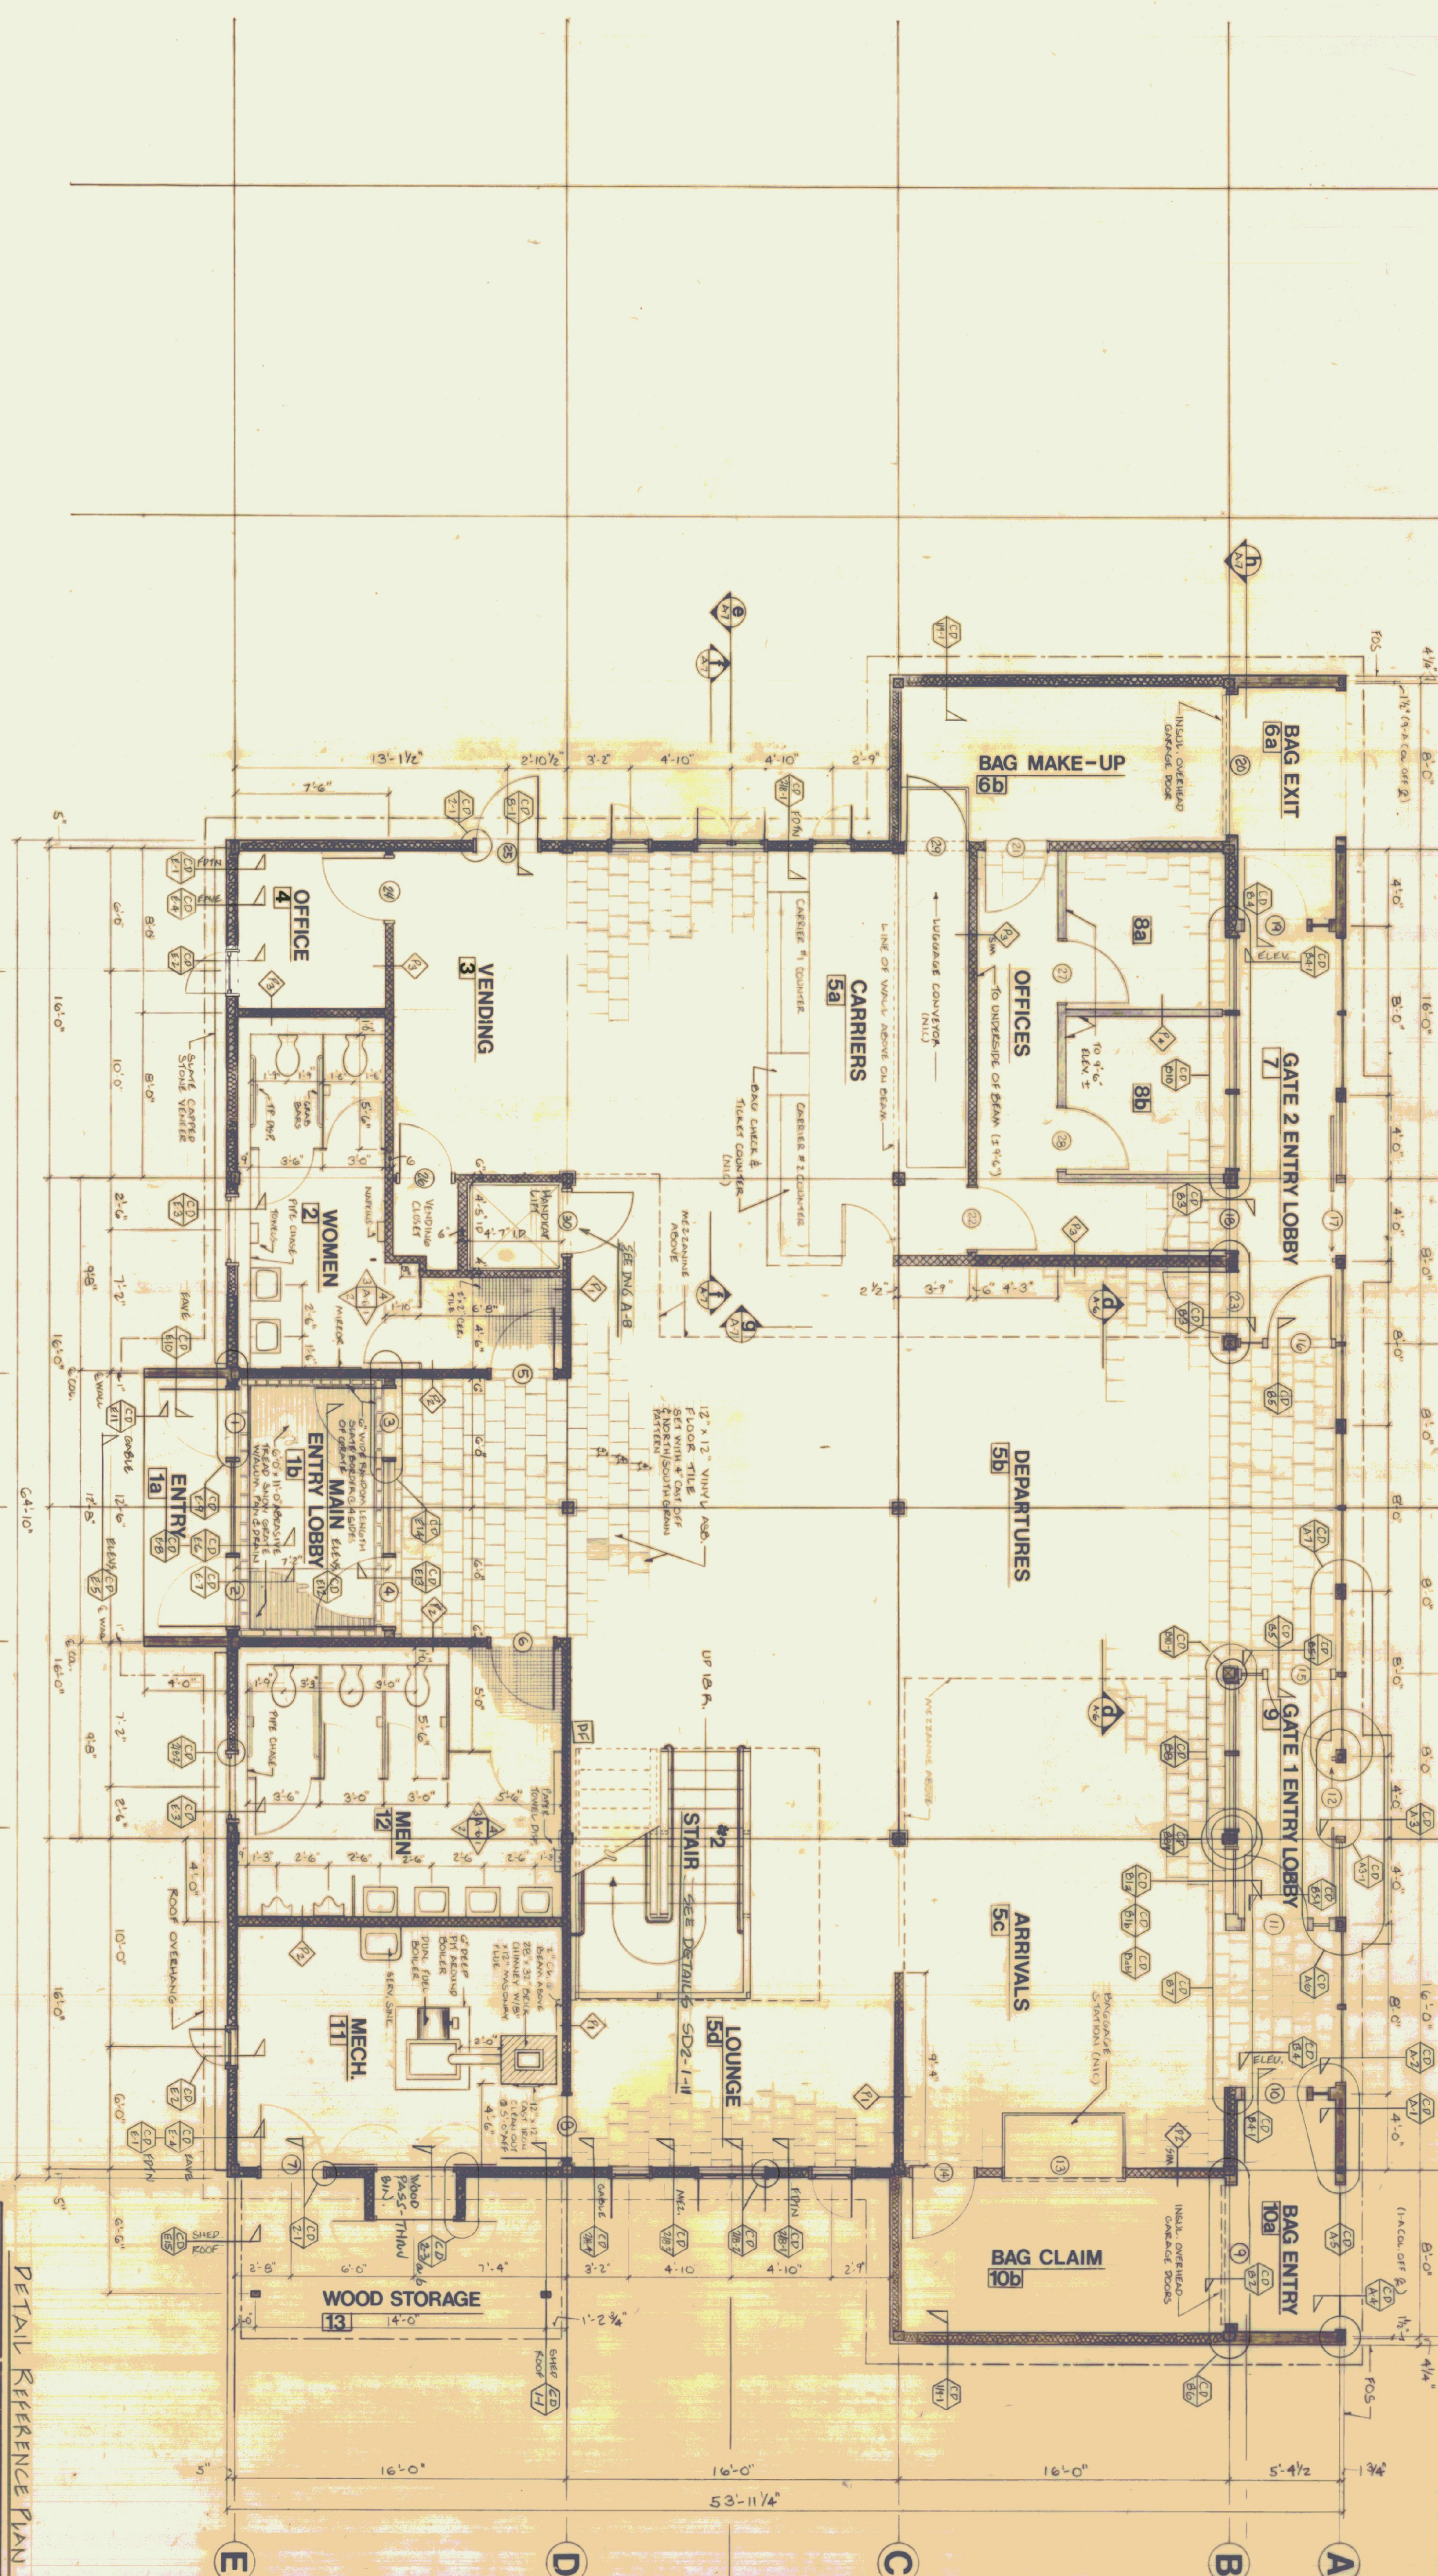


NO	DATE	DESCRIPTION	PRINTS
1	12/7/84	REVISIONS GAMSON VERNON HILL FOR A	1
2	12/28/84	ADDITIONAL REVISIONS-1 FOR A	2
3	1/2/85	REVISIONS-2 FOR A	3
4	1/2/85	REVISIONS-3 FOR A	4
5	1/2/85	REVISIONS-4 FOR A	5
6	1/2/85	REVISIONS-5 FOR A	6
7	1/2/85	REVISIONS-6 FOR A	7

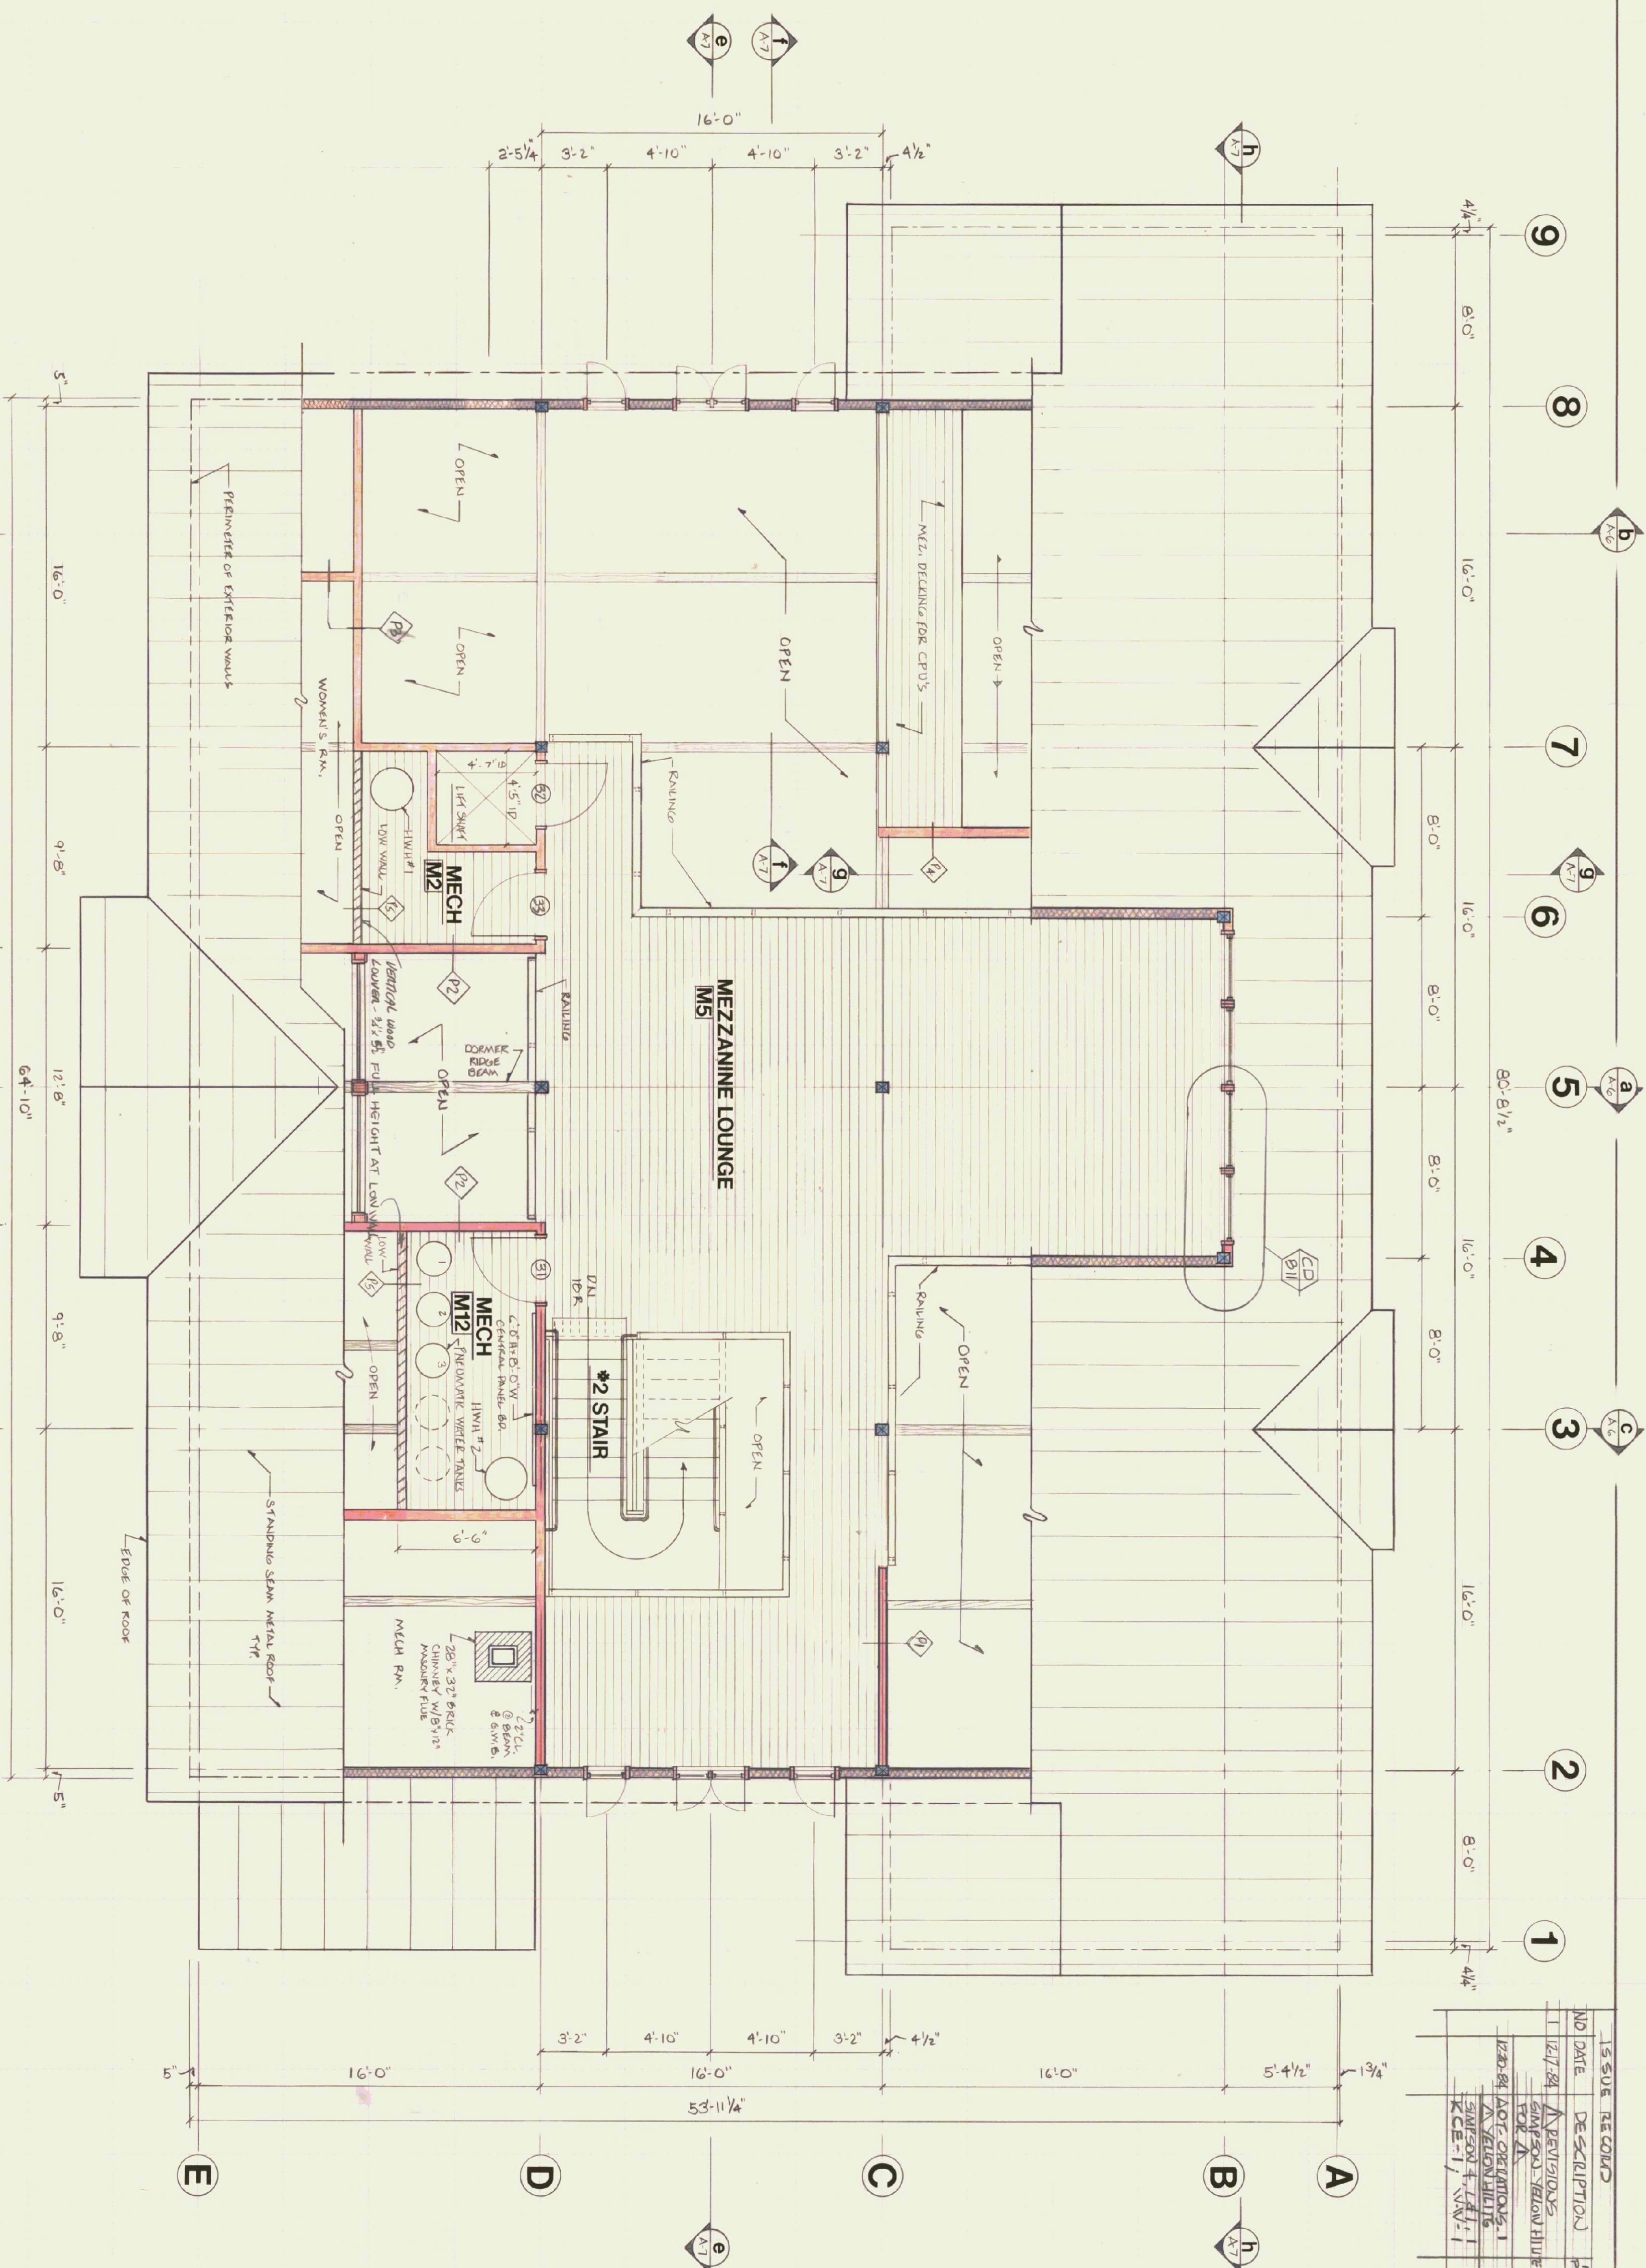


STATE OF VERMONT
DIVISION OF STATE BUILDINGS
AGENCY OF ADMINISTRATION
MONTPELIER, VERMONT

RUTLAND TERMINAL BUILDING AIR 23-2024
MEZZANINE PLAN
RUTLAND STATE AIRPORT
CLARENDON, VERMONT


DATE: 10-30-84
SCALE: 1/4" = 1'-0"
DRAWN BY: JAH FOR DS/B
APPROVED BY: [Signature]
DWG. NO. A-3
6 OF 20

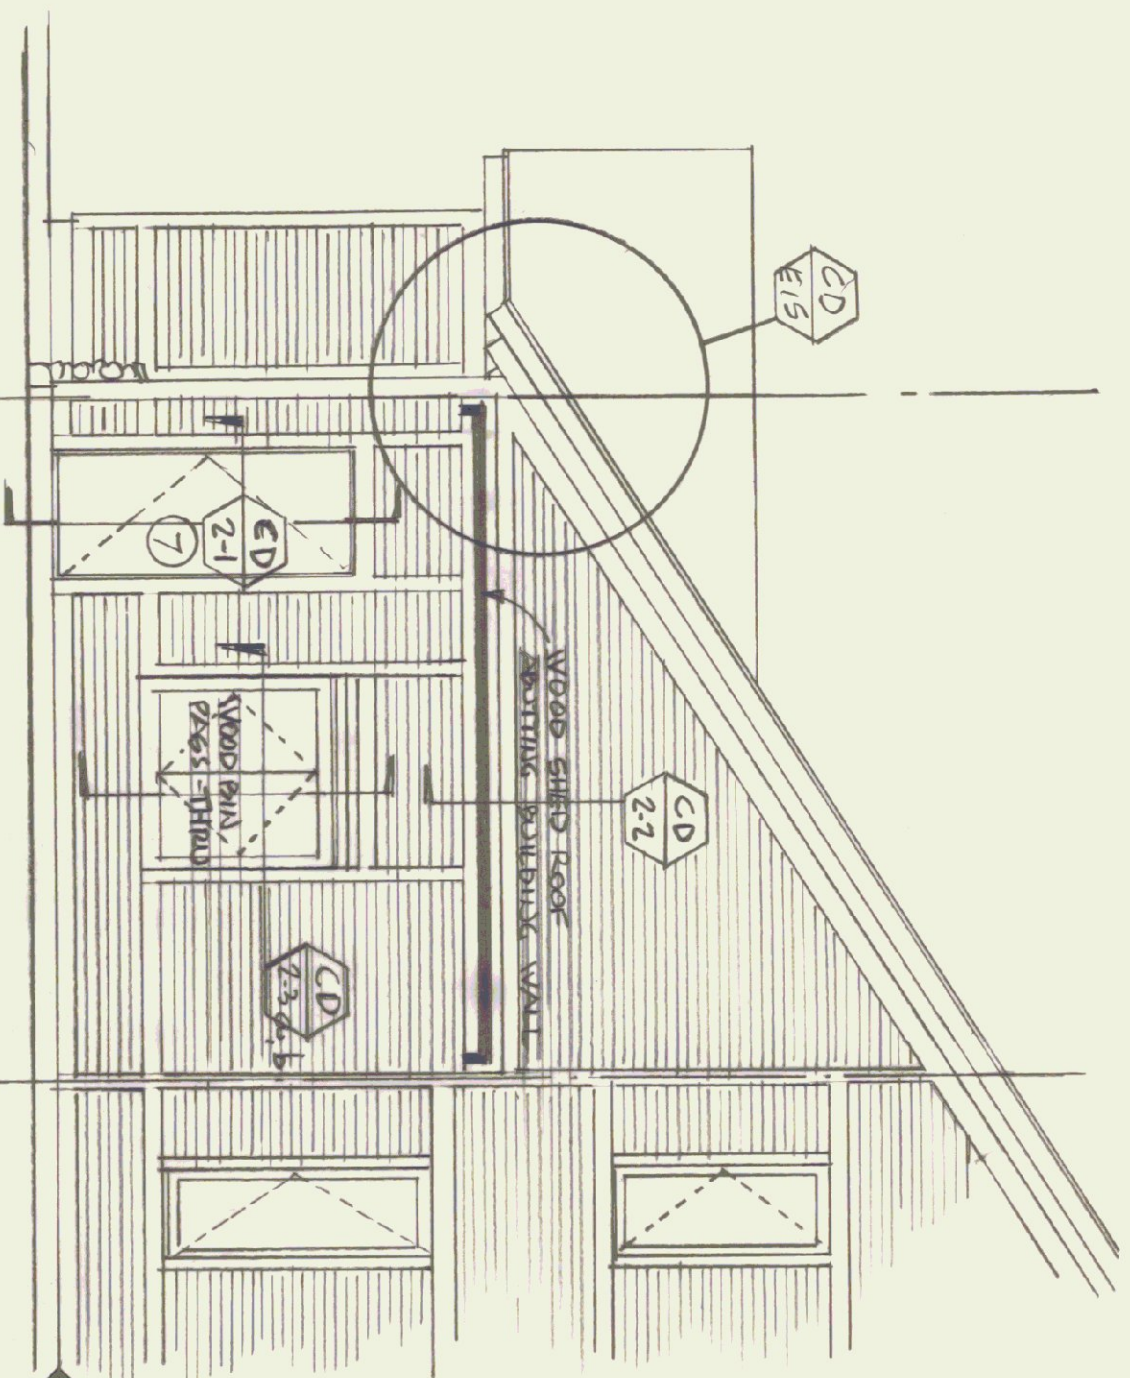

PART WEST ELEVATION
WOOD SHED

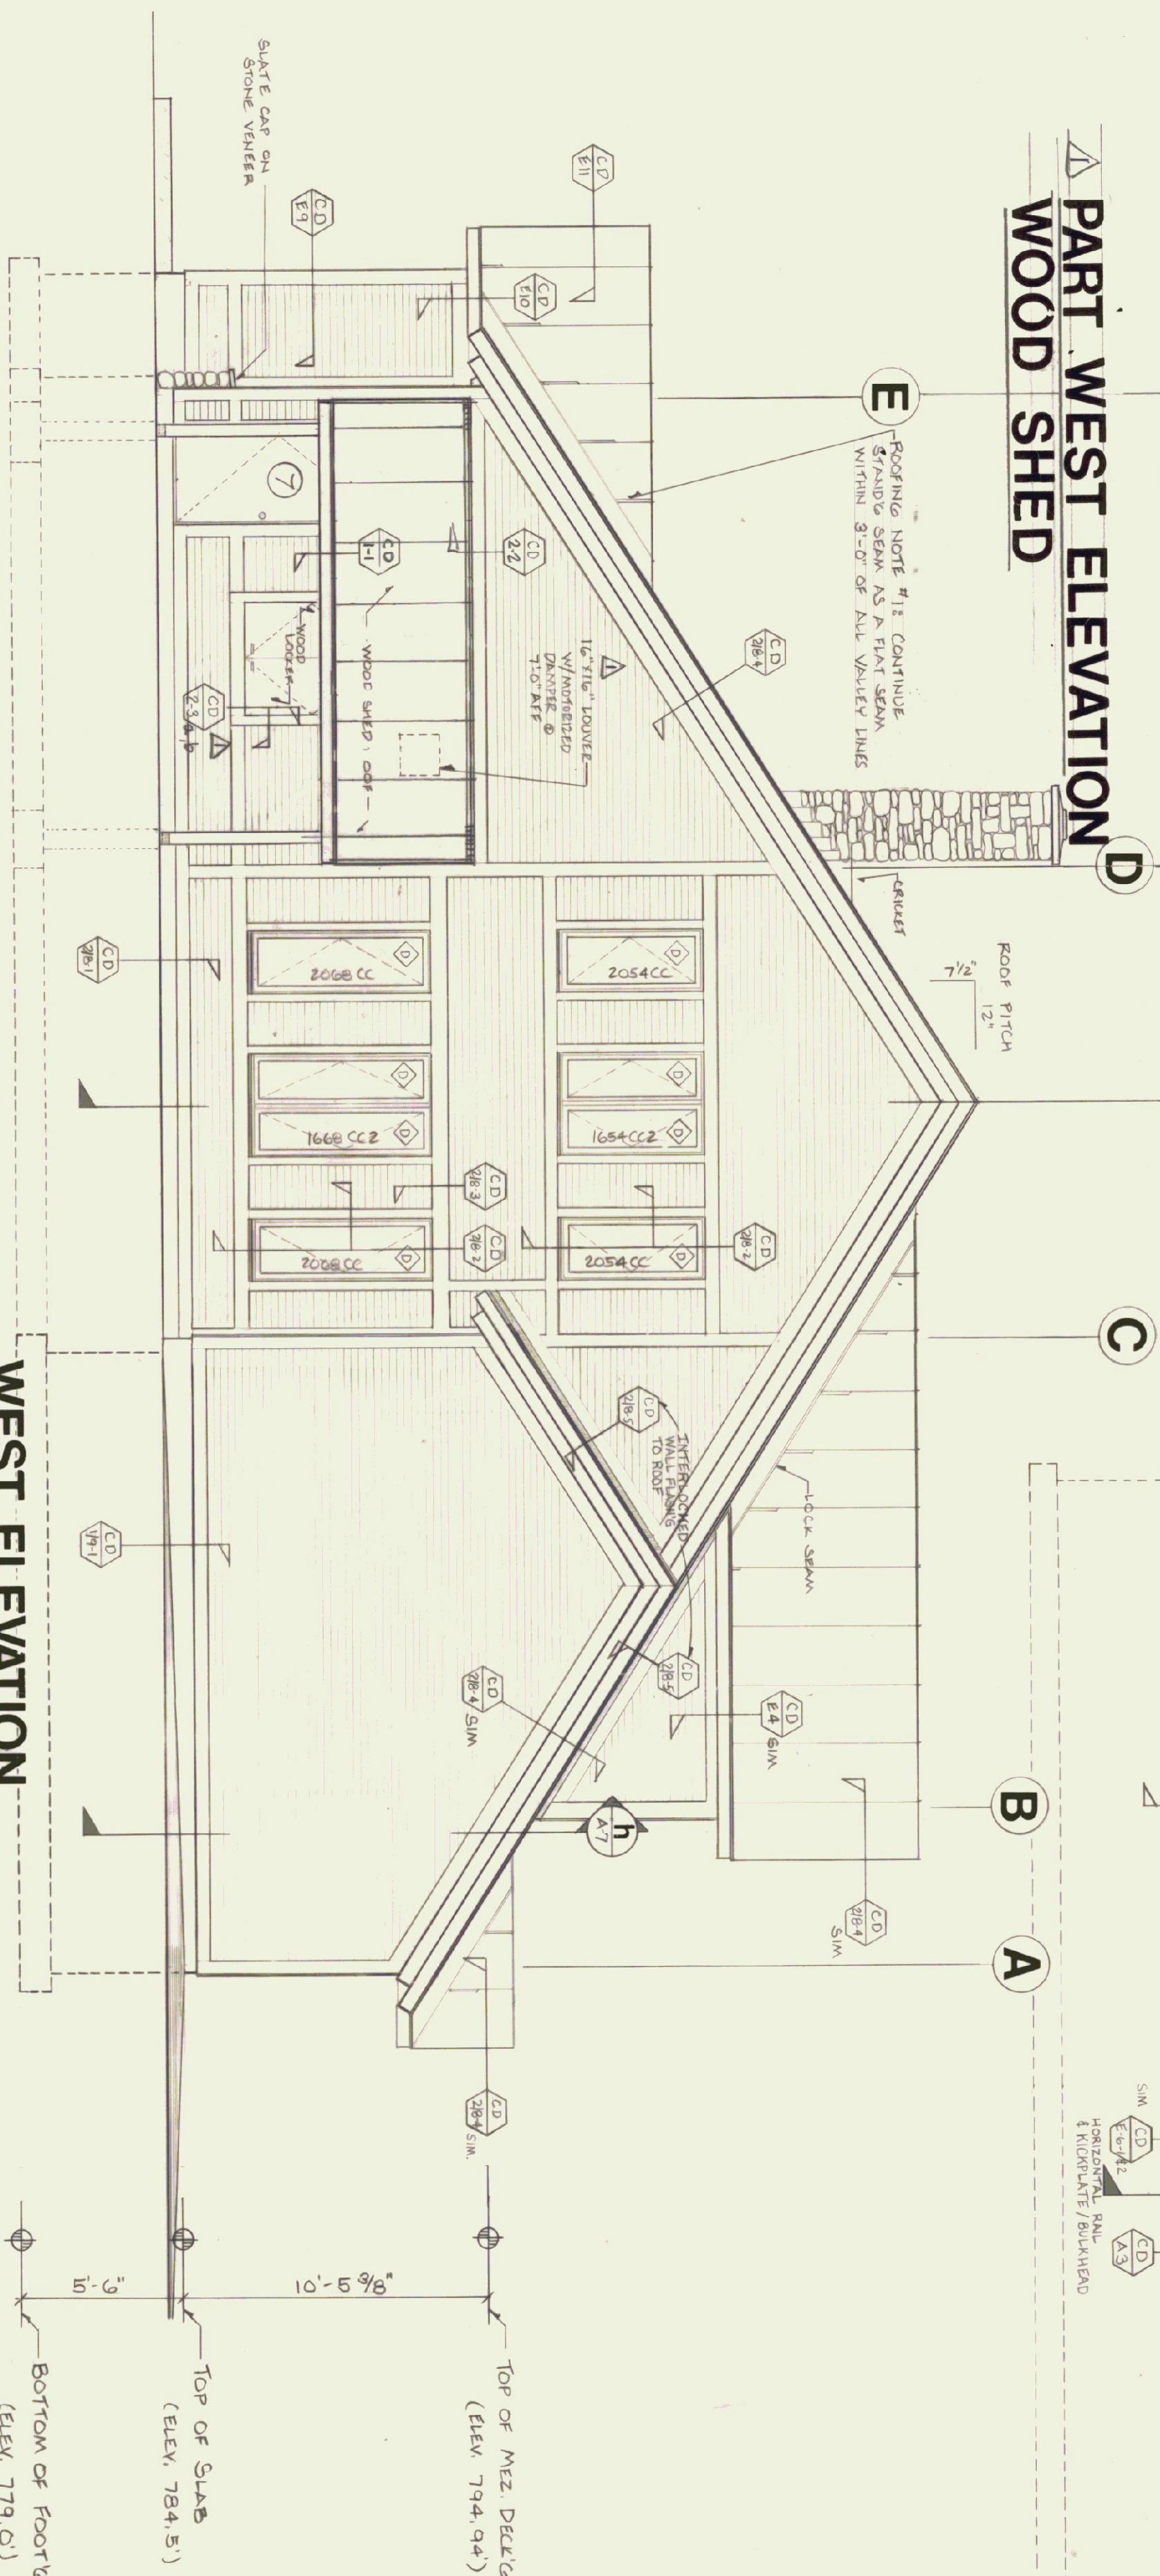

WEST ELEVATION

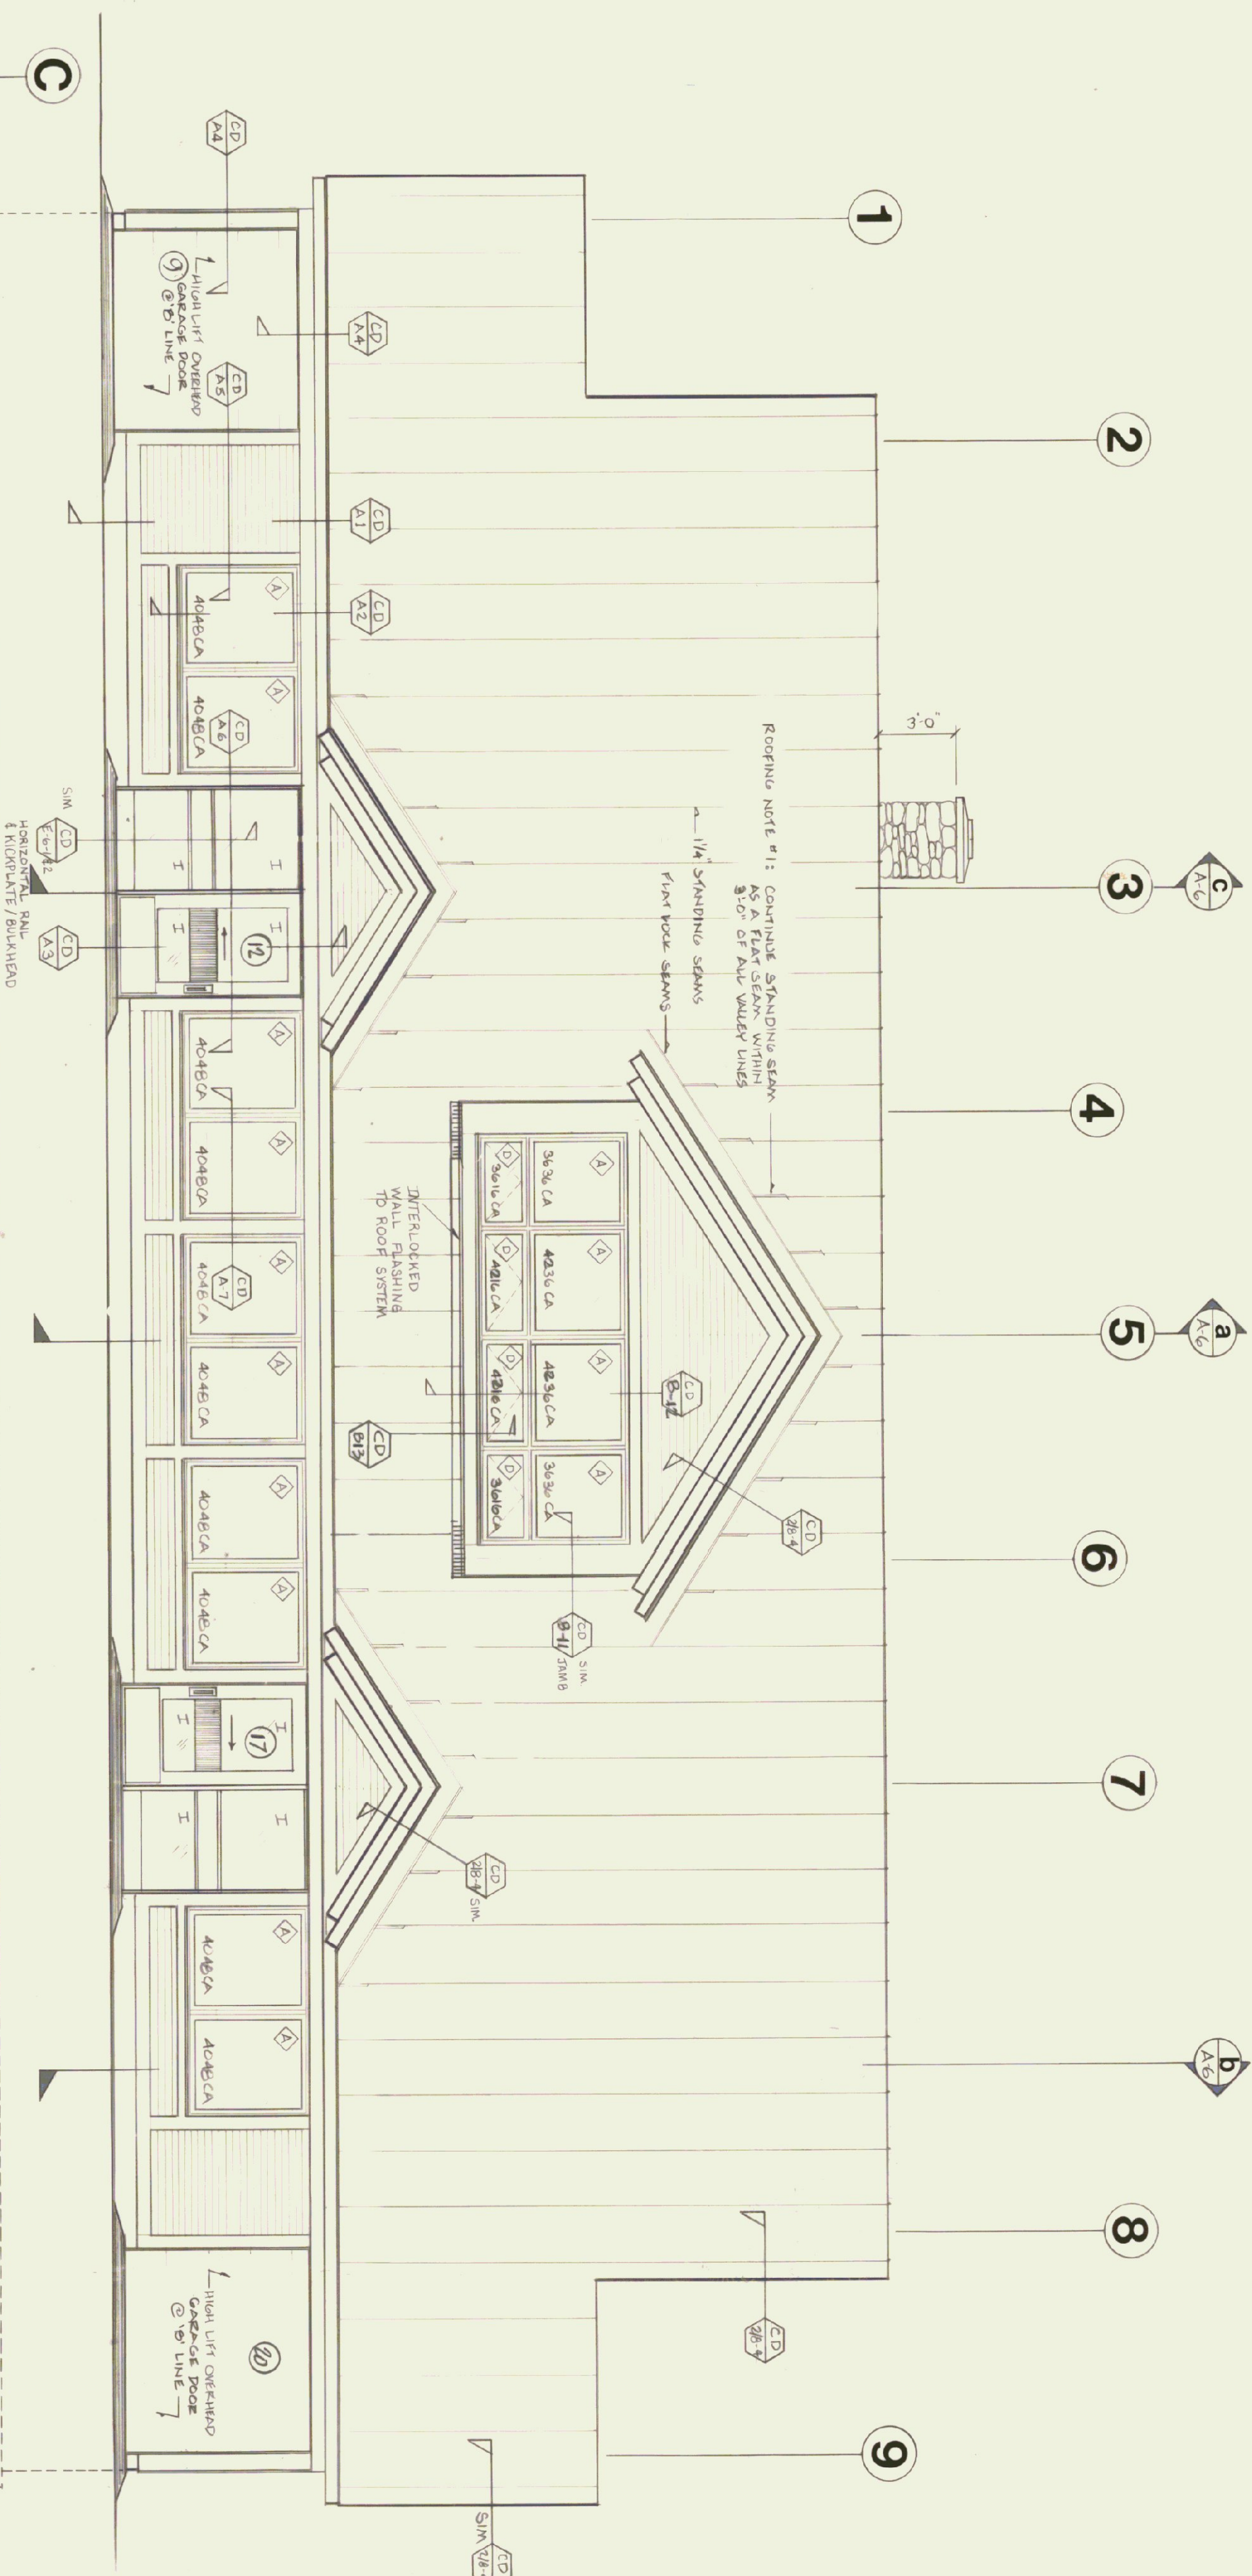

SOUTH ELEVATION







NOTE
SEE DWG. A7 FOR WINDOW UNITS
AT INTERIOR WALL OF AIR SIDE CORRIDOR-SECTION (B)

NO	DATE	DESCRIPTION	BY
1	12/1/24	DESIGN DEVELOPMENT	SA
2	12/1/24	REVISED FOR PERMITS	SA
3	12/1/24	REVISED FOR PERMITS	SA
4	12/1/24	REVISED FOR PERMITS	SA
5	12/1/24	REVISED FOR PERMITS	SA
6	12/1/24	REVISED FOR PERMITS	SA
7	12/1/24	REVISED FOR PERMITS	SA

STATE OF VERMONT
DIVISION OF STATE BUILDINGS
AGENCY OF ADMINISTRATION
MONTPELIER, VERMONT
RUTLAND TERMINAL BUILDING AIR 23-2024
ELEVATIONS
RUTLAND STATE AIRPORT
CLARENDON, VERMONT

DATE 6-8-24	SCALE 1/4" = 1'-0"	REVISIONS 4/8/24 SA MUELLER	DWG. NO. A-5
DRAWN BY: JPO	APPROVED BY: RAK DGP	DATE 10-30-24	8 OF 20

ISSUE RECORD		
NO	DATE	DESCRIPTION
1	12-17-24	DESIGN FOR CONSTRUCTION
2	12-20-24	FOR REVIEW
3	12-20-24	FOR REVIEW
4	12-20-24	FOR REVIEW
5	12-20-24	FOR REVIEW
6	12-20-24	FOR REVIEW
7	12-20-24	FOR REVIEW

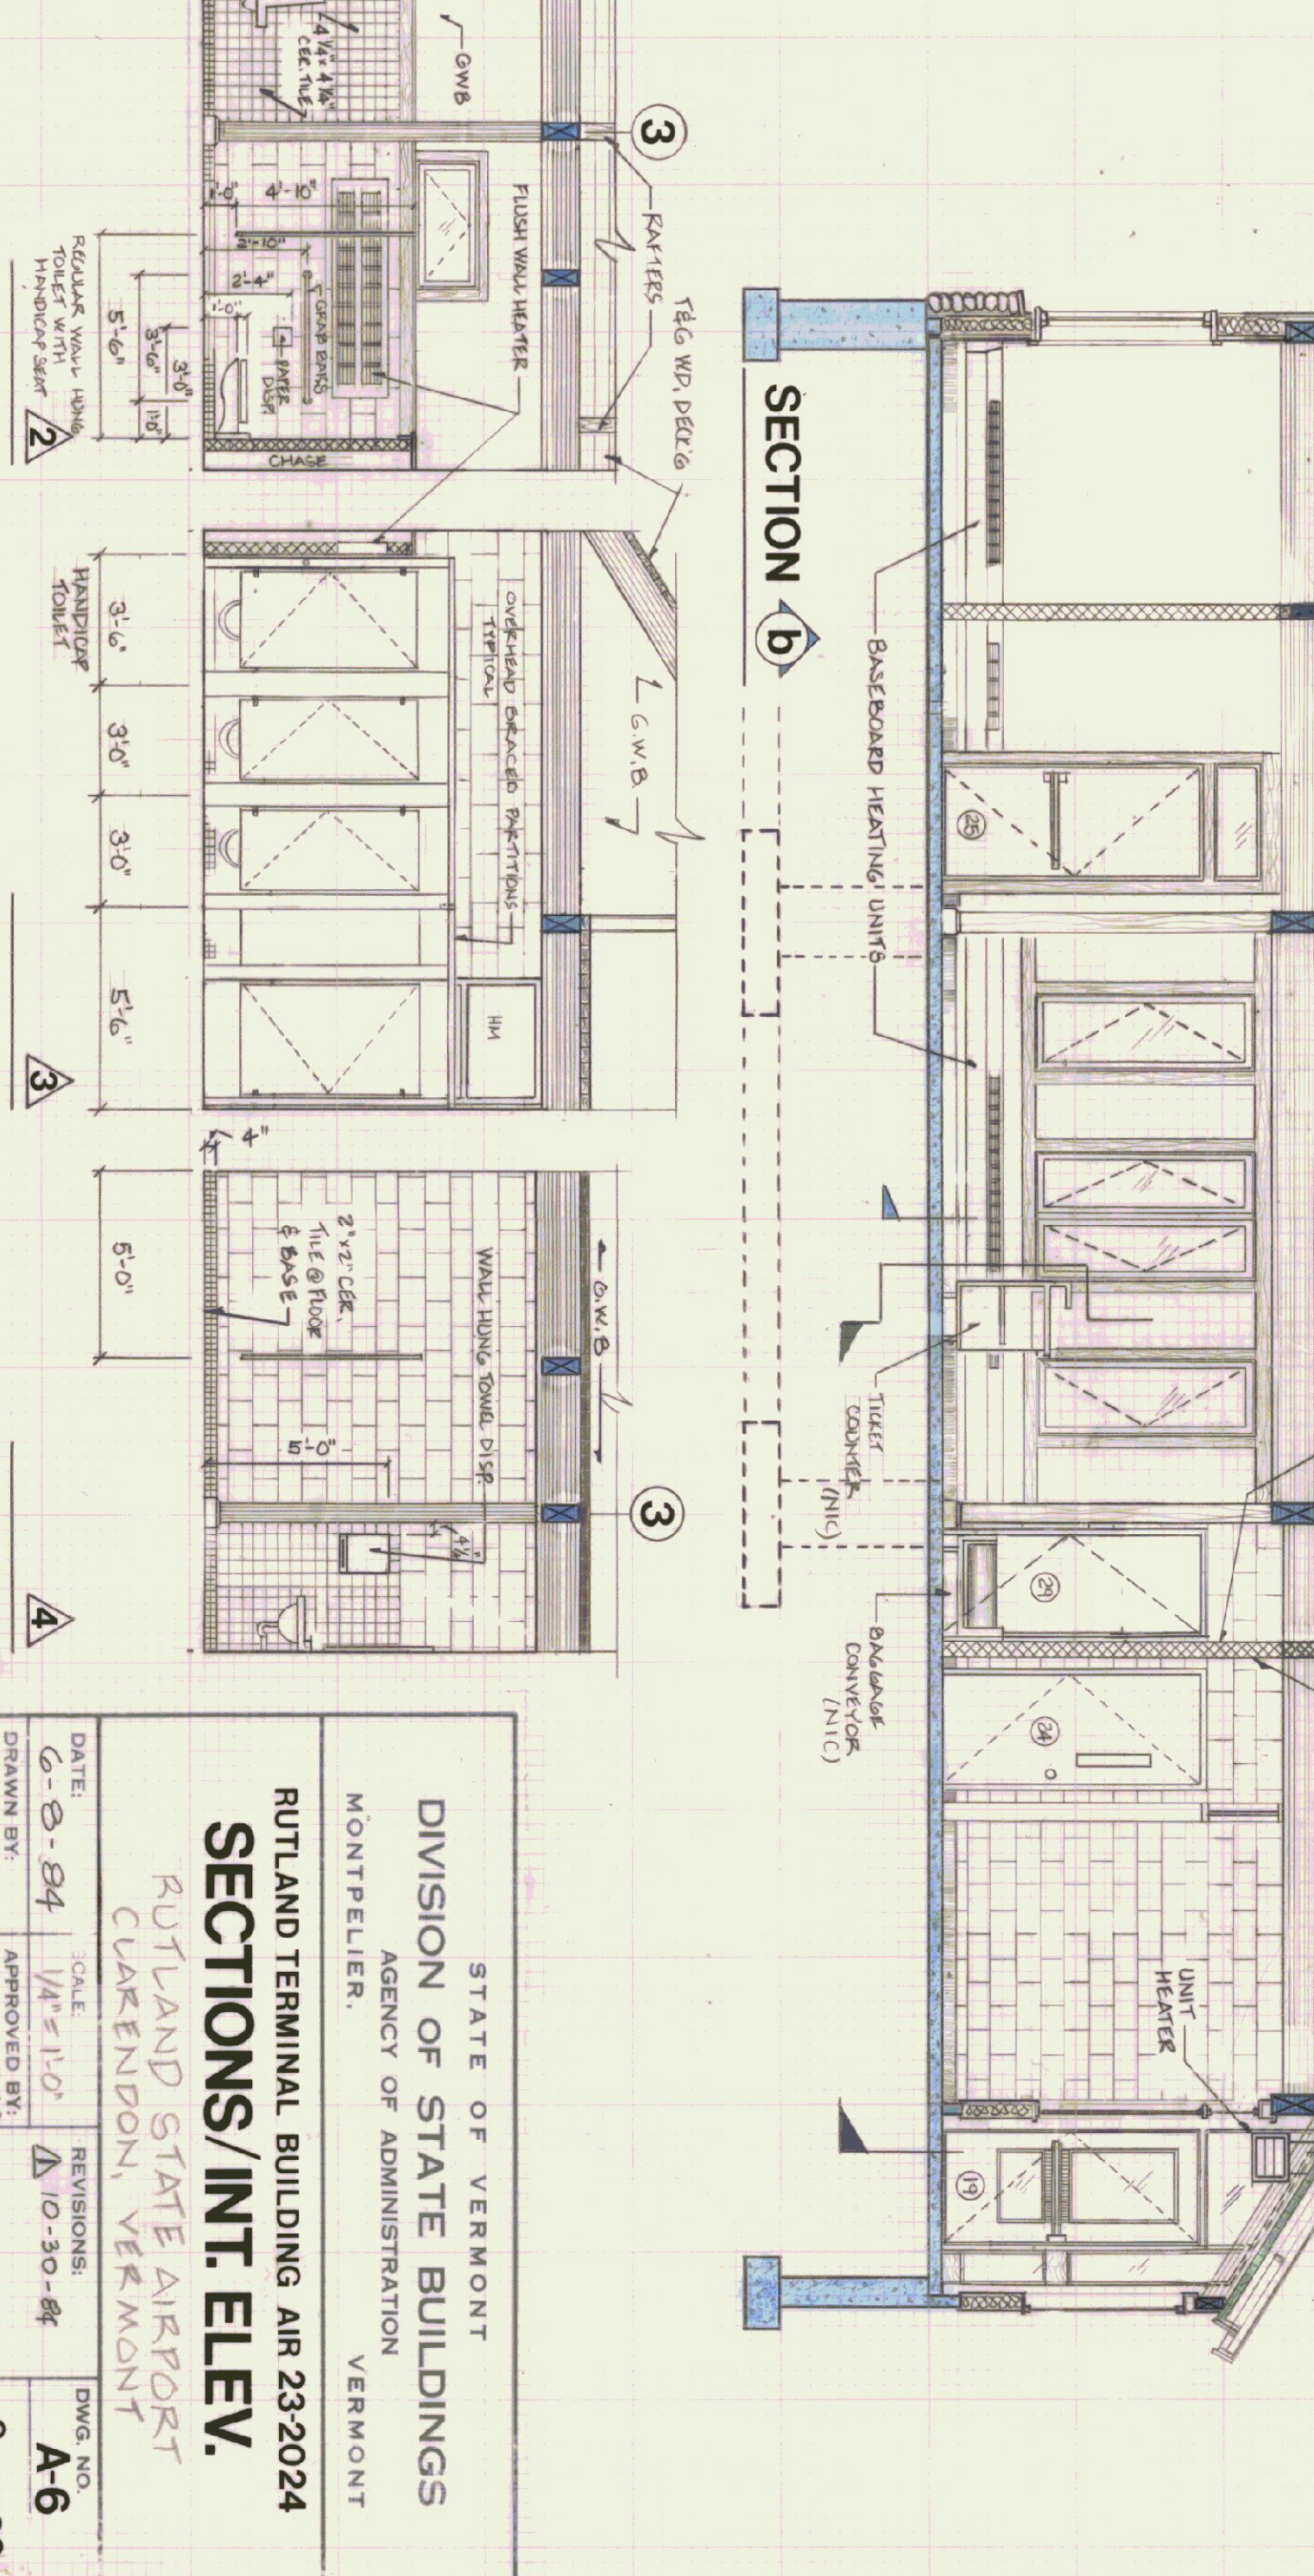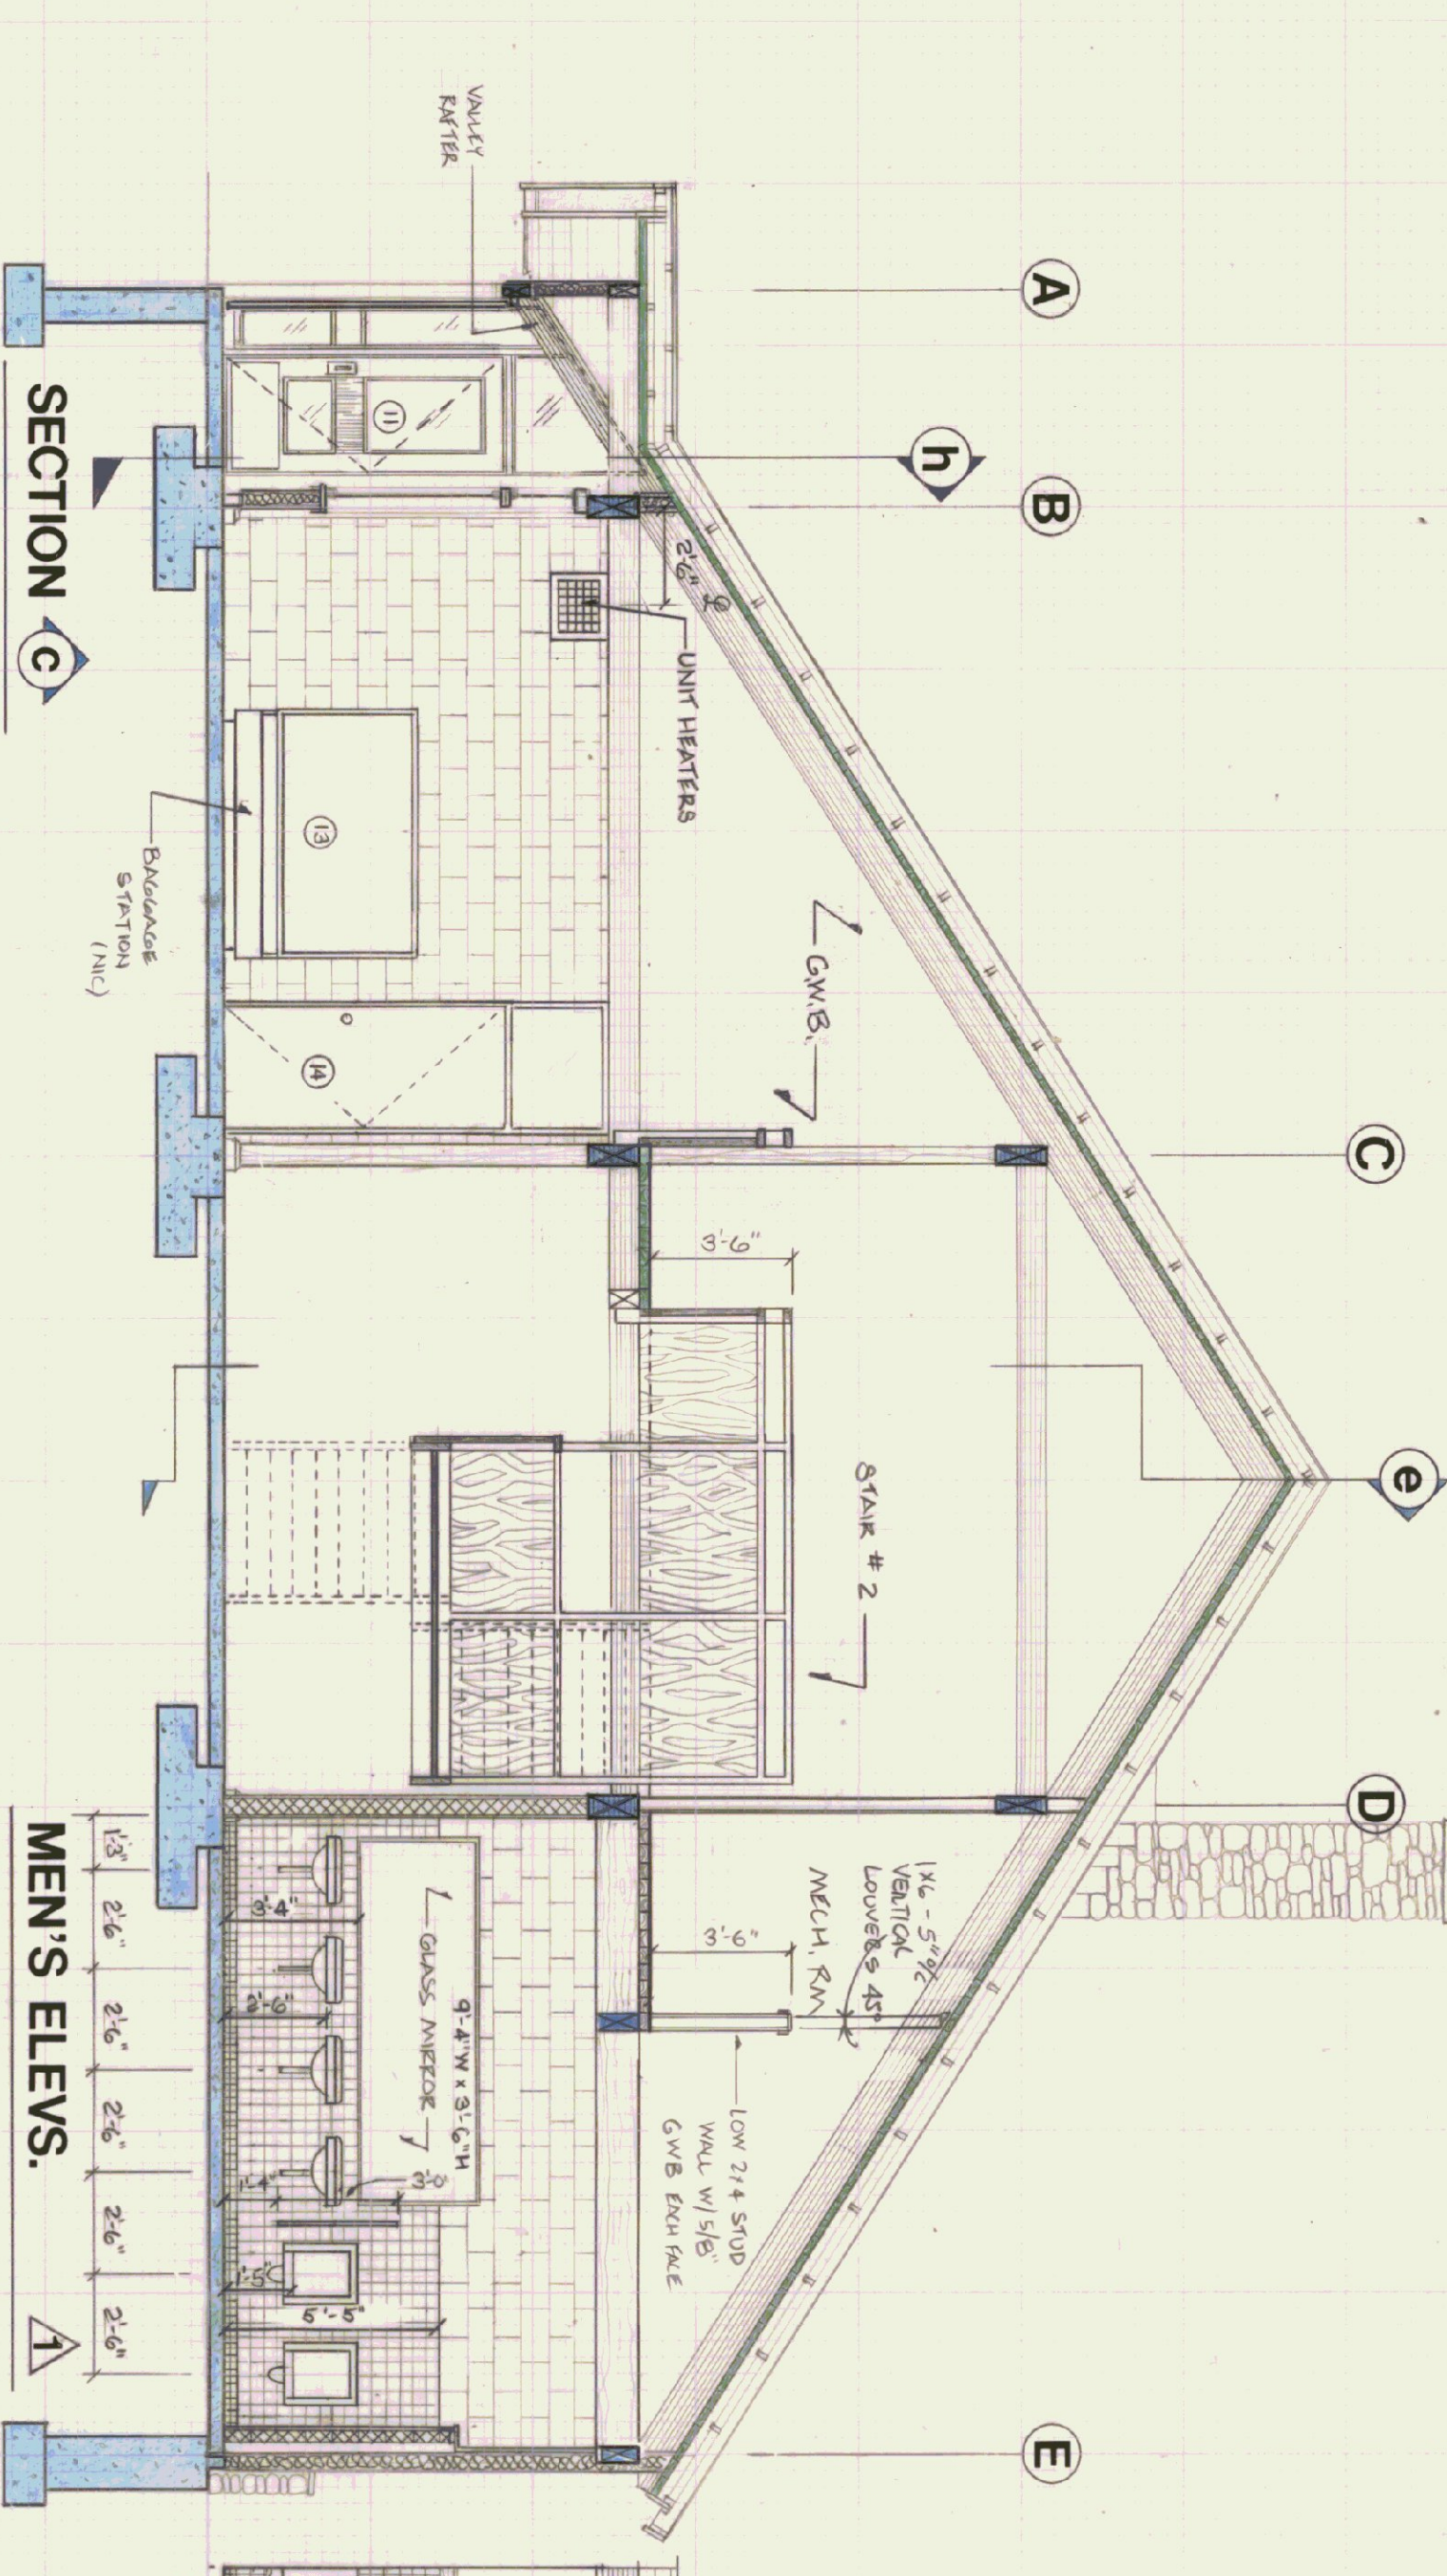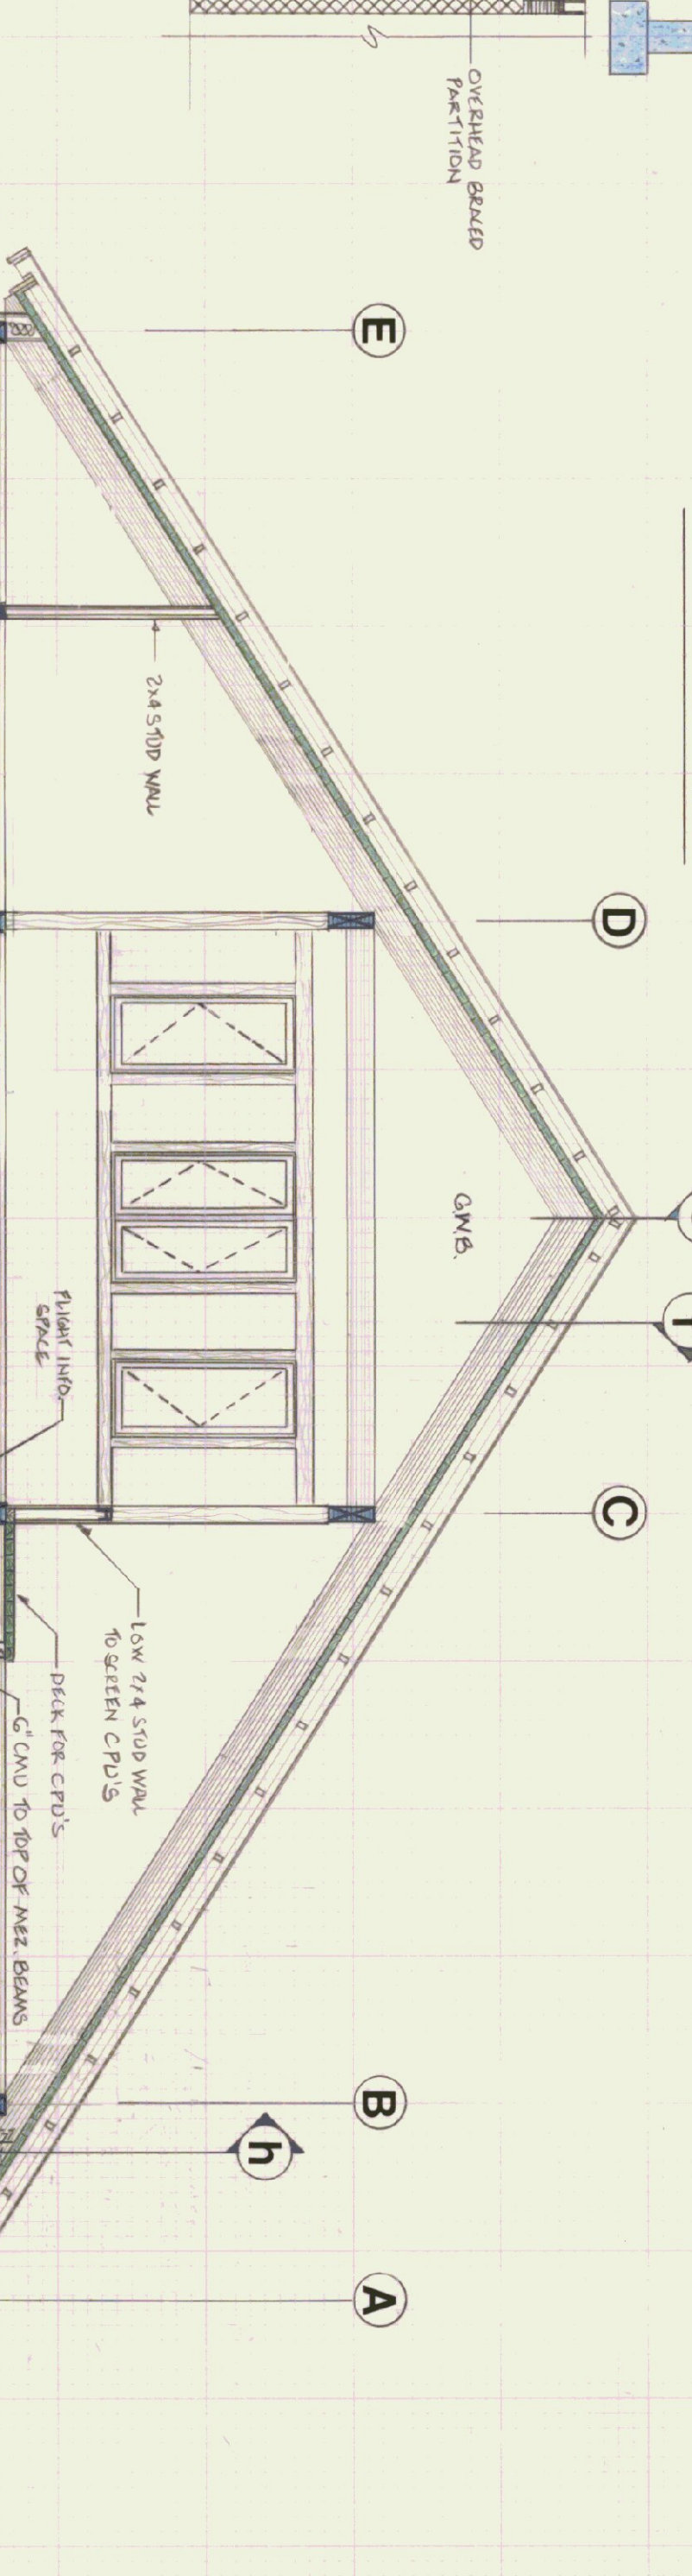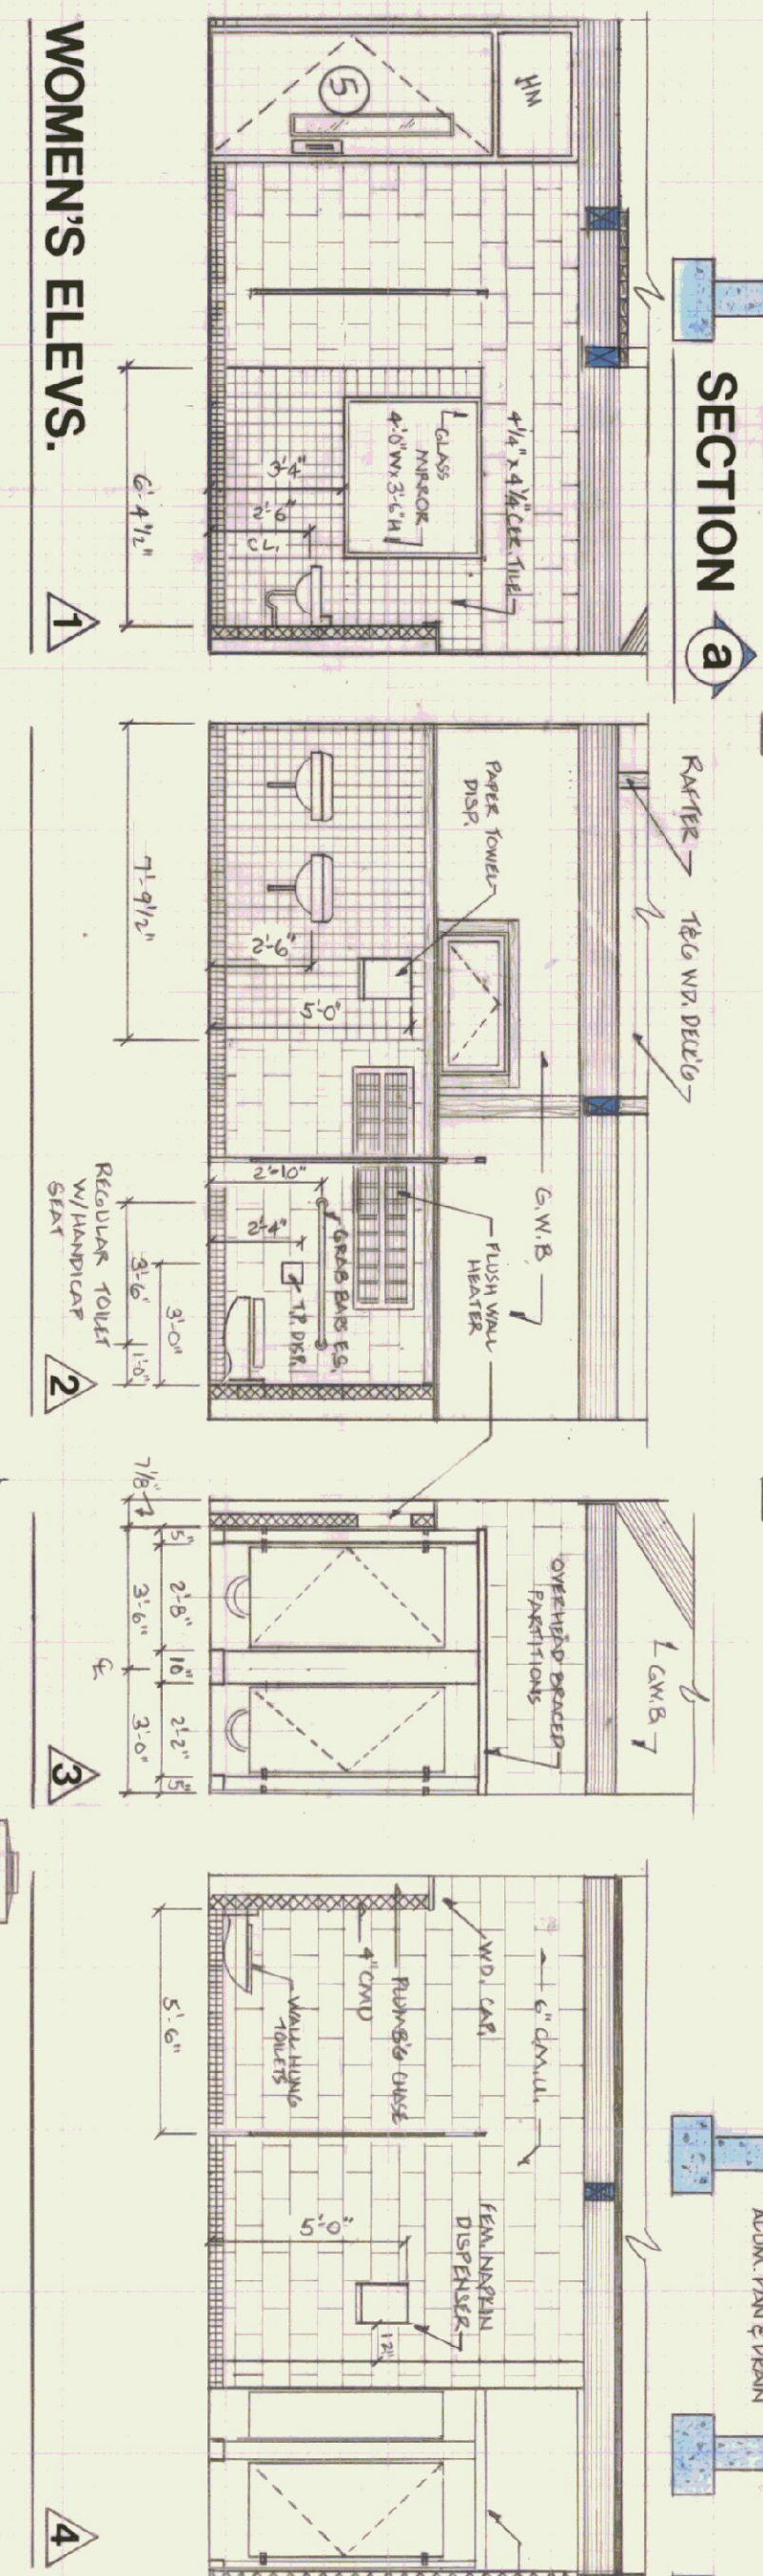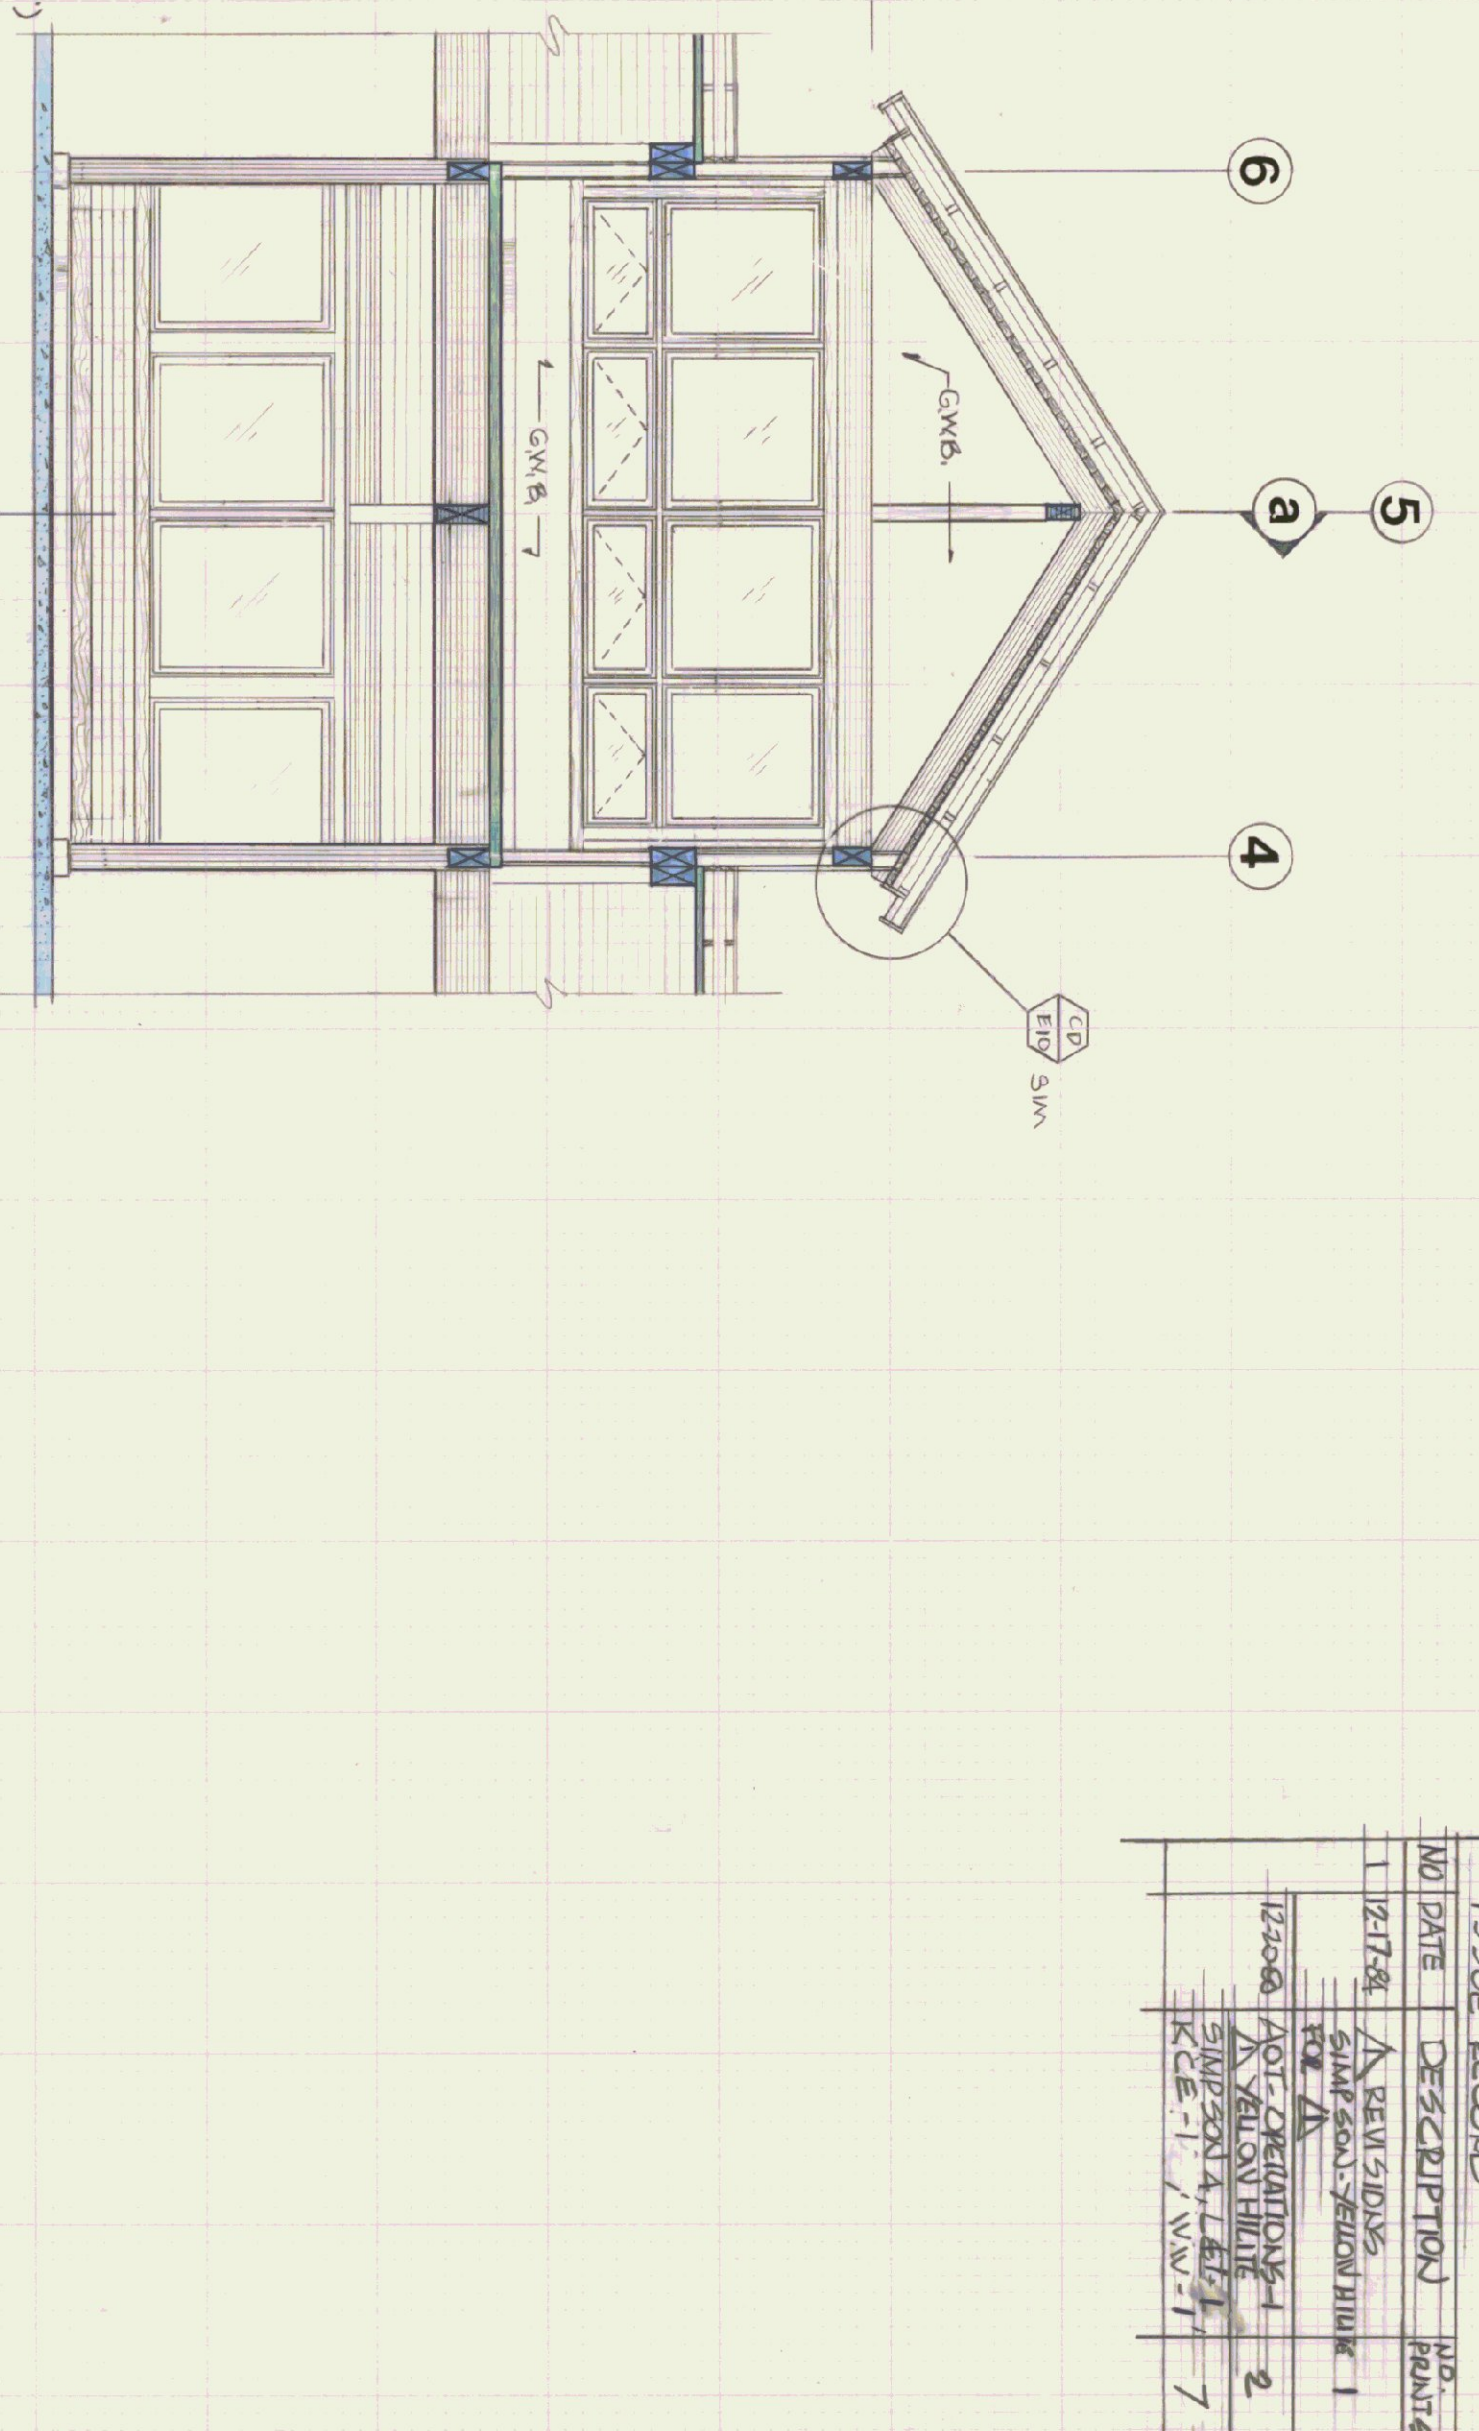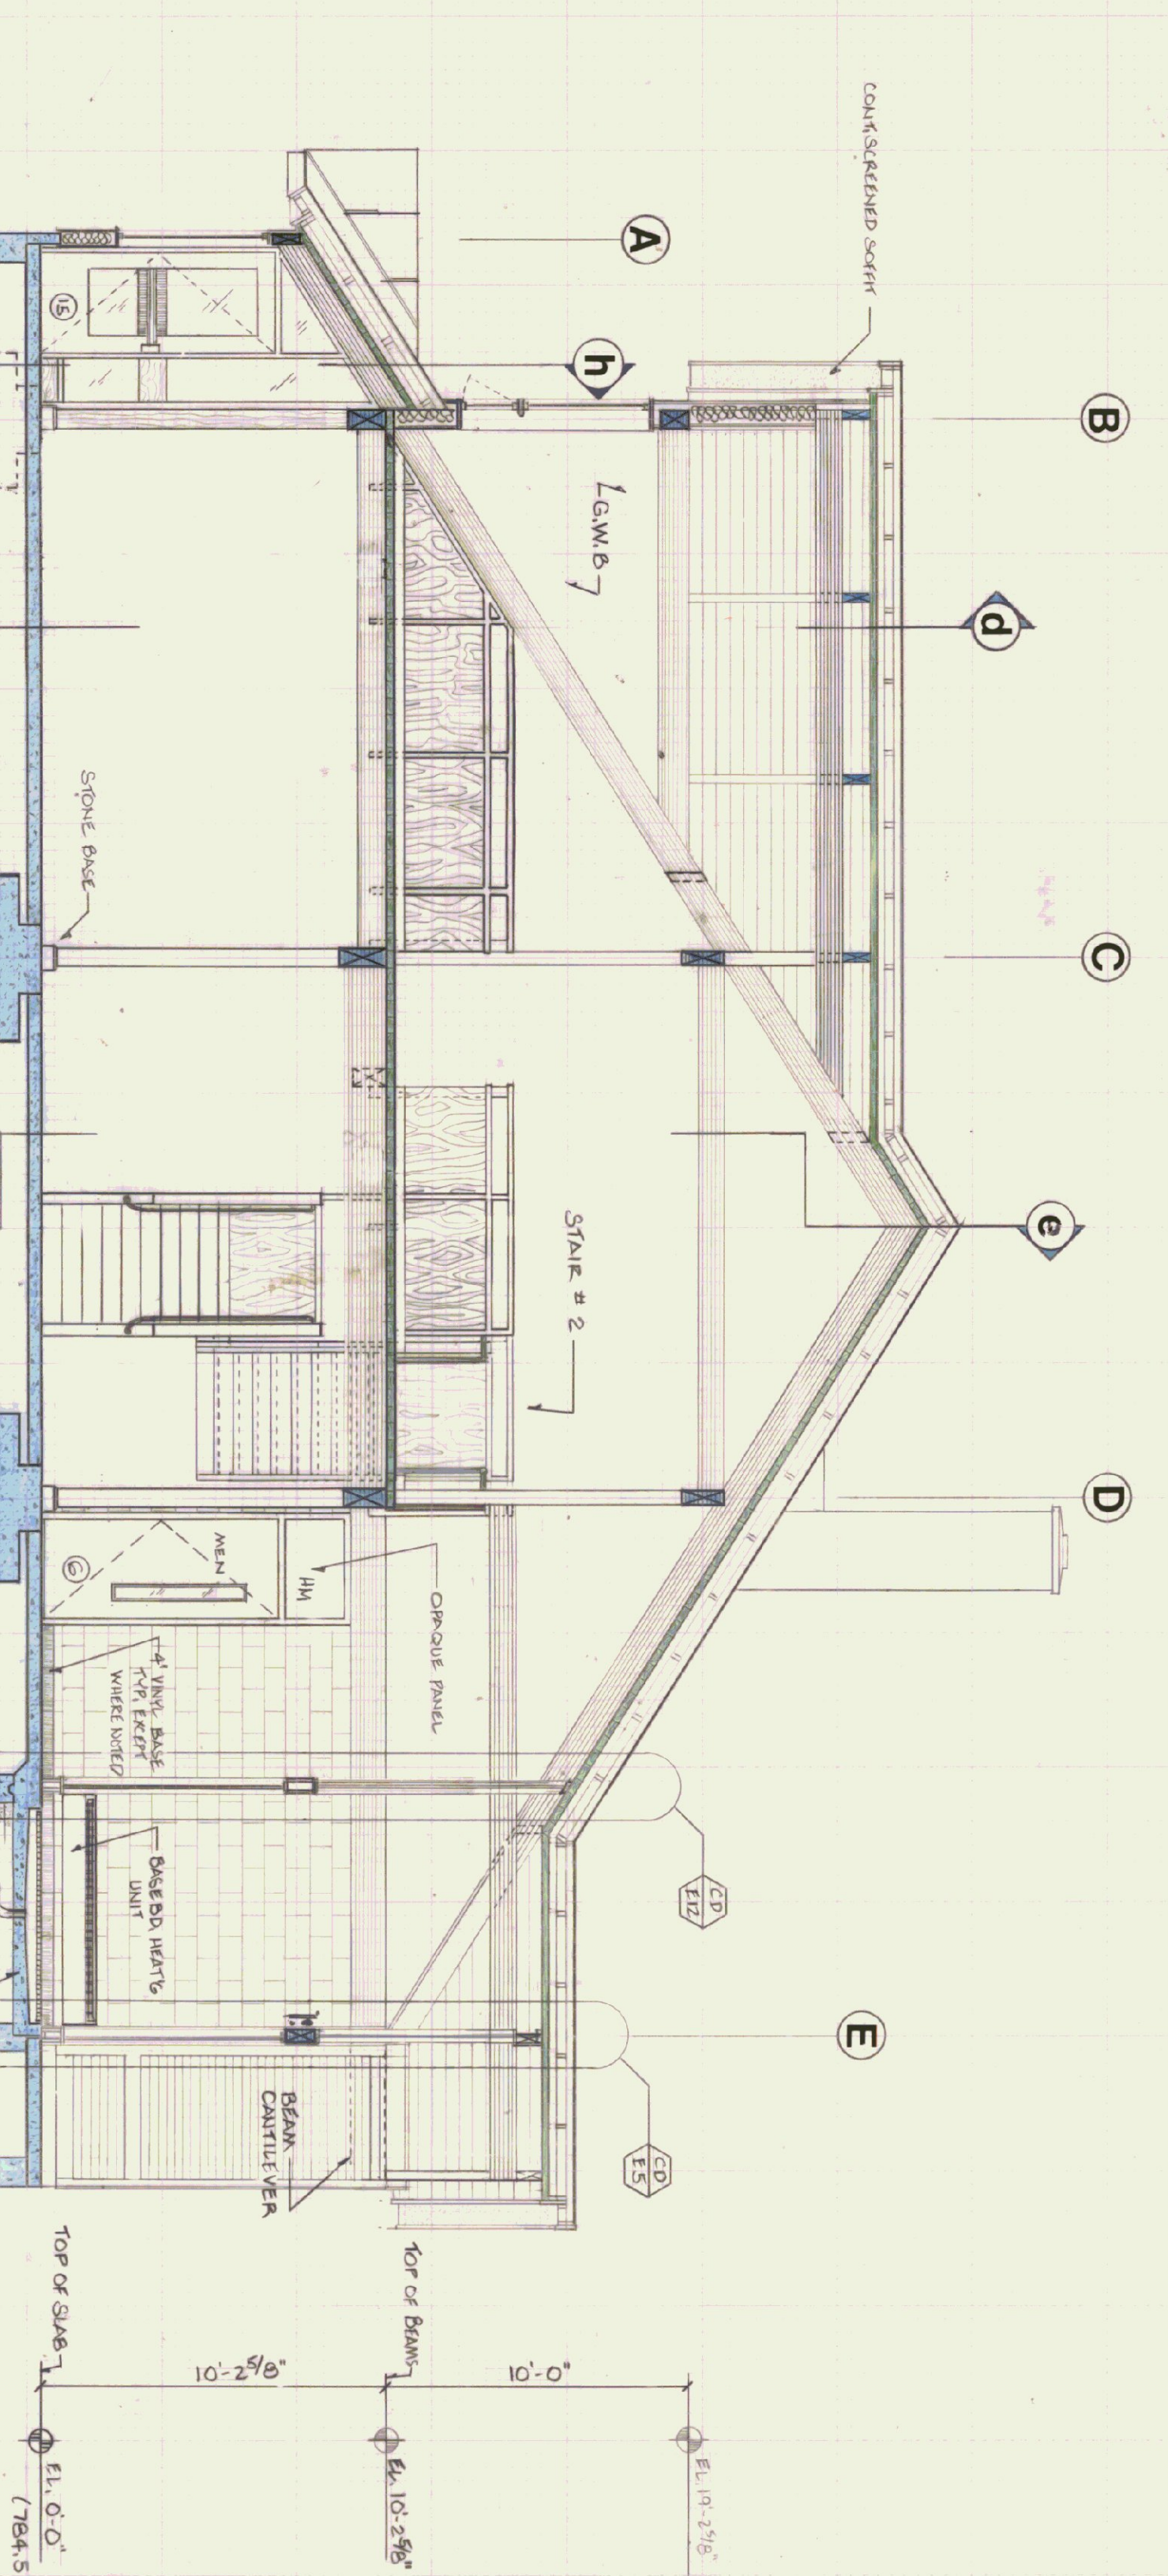

STATE OF VERMONT
DIVISION OF STATE BUILDINGS
AGENCY OF ADMINISTRATION
MONTPELIER.


RUTLAND TERMINAL BUILDING AIR 23-2024
SECTIONS/INT. ELEV.

RUTLAND STATE AIRPORT
CLARENDON, VERMONT


DATE: 6-8-24
SCALE: 1/4" = 1'-0"
DRAWN BY: 570
APPROVED BY: 104 POL DSB

REVISIONS:
10-30-24
A-6


DWG. NO. 9
9-20

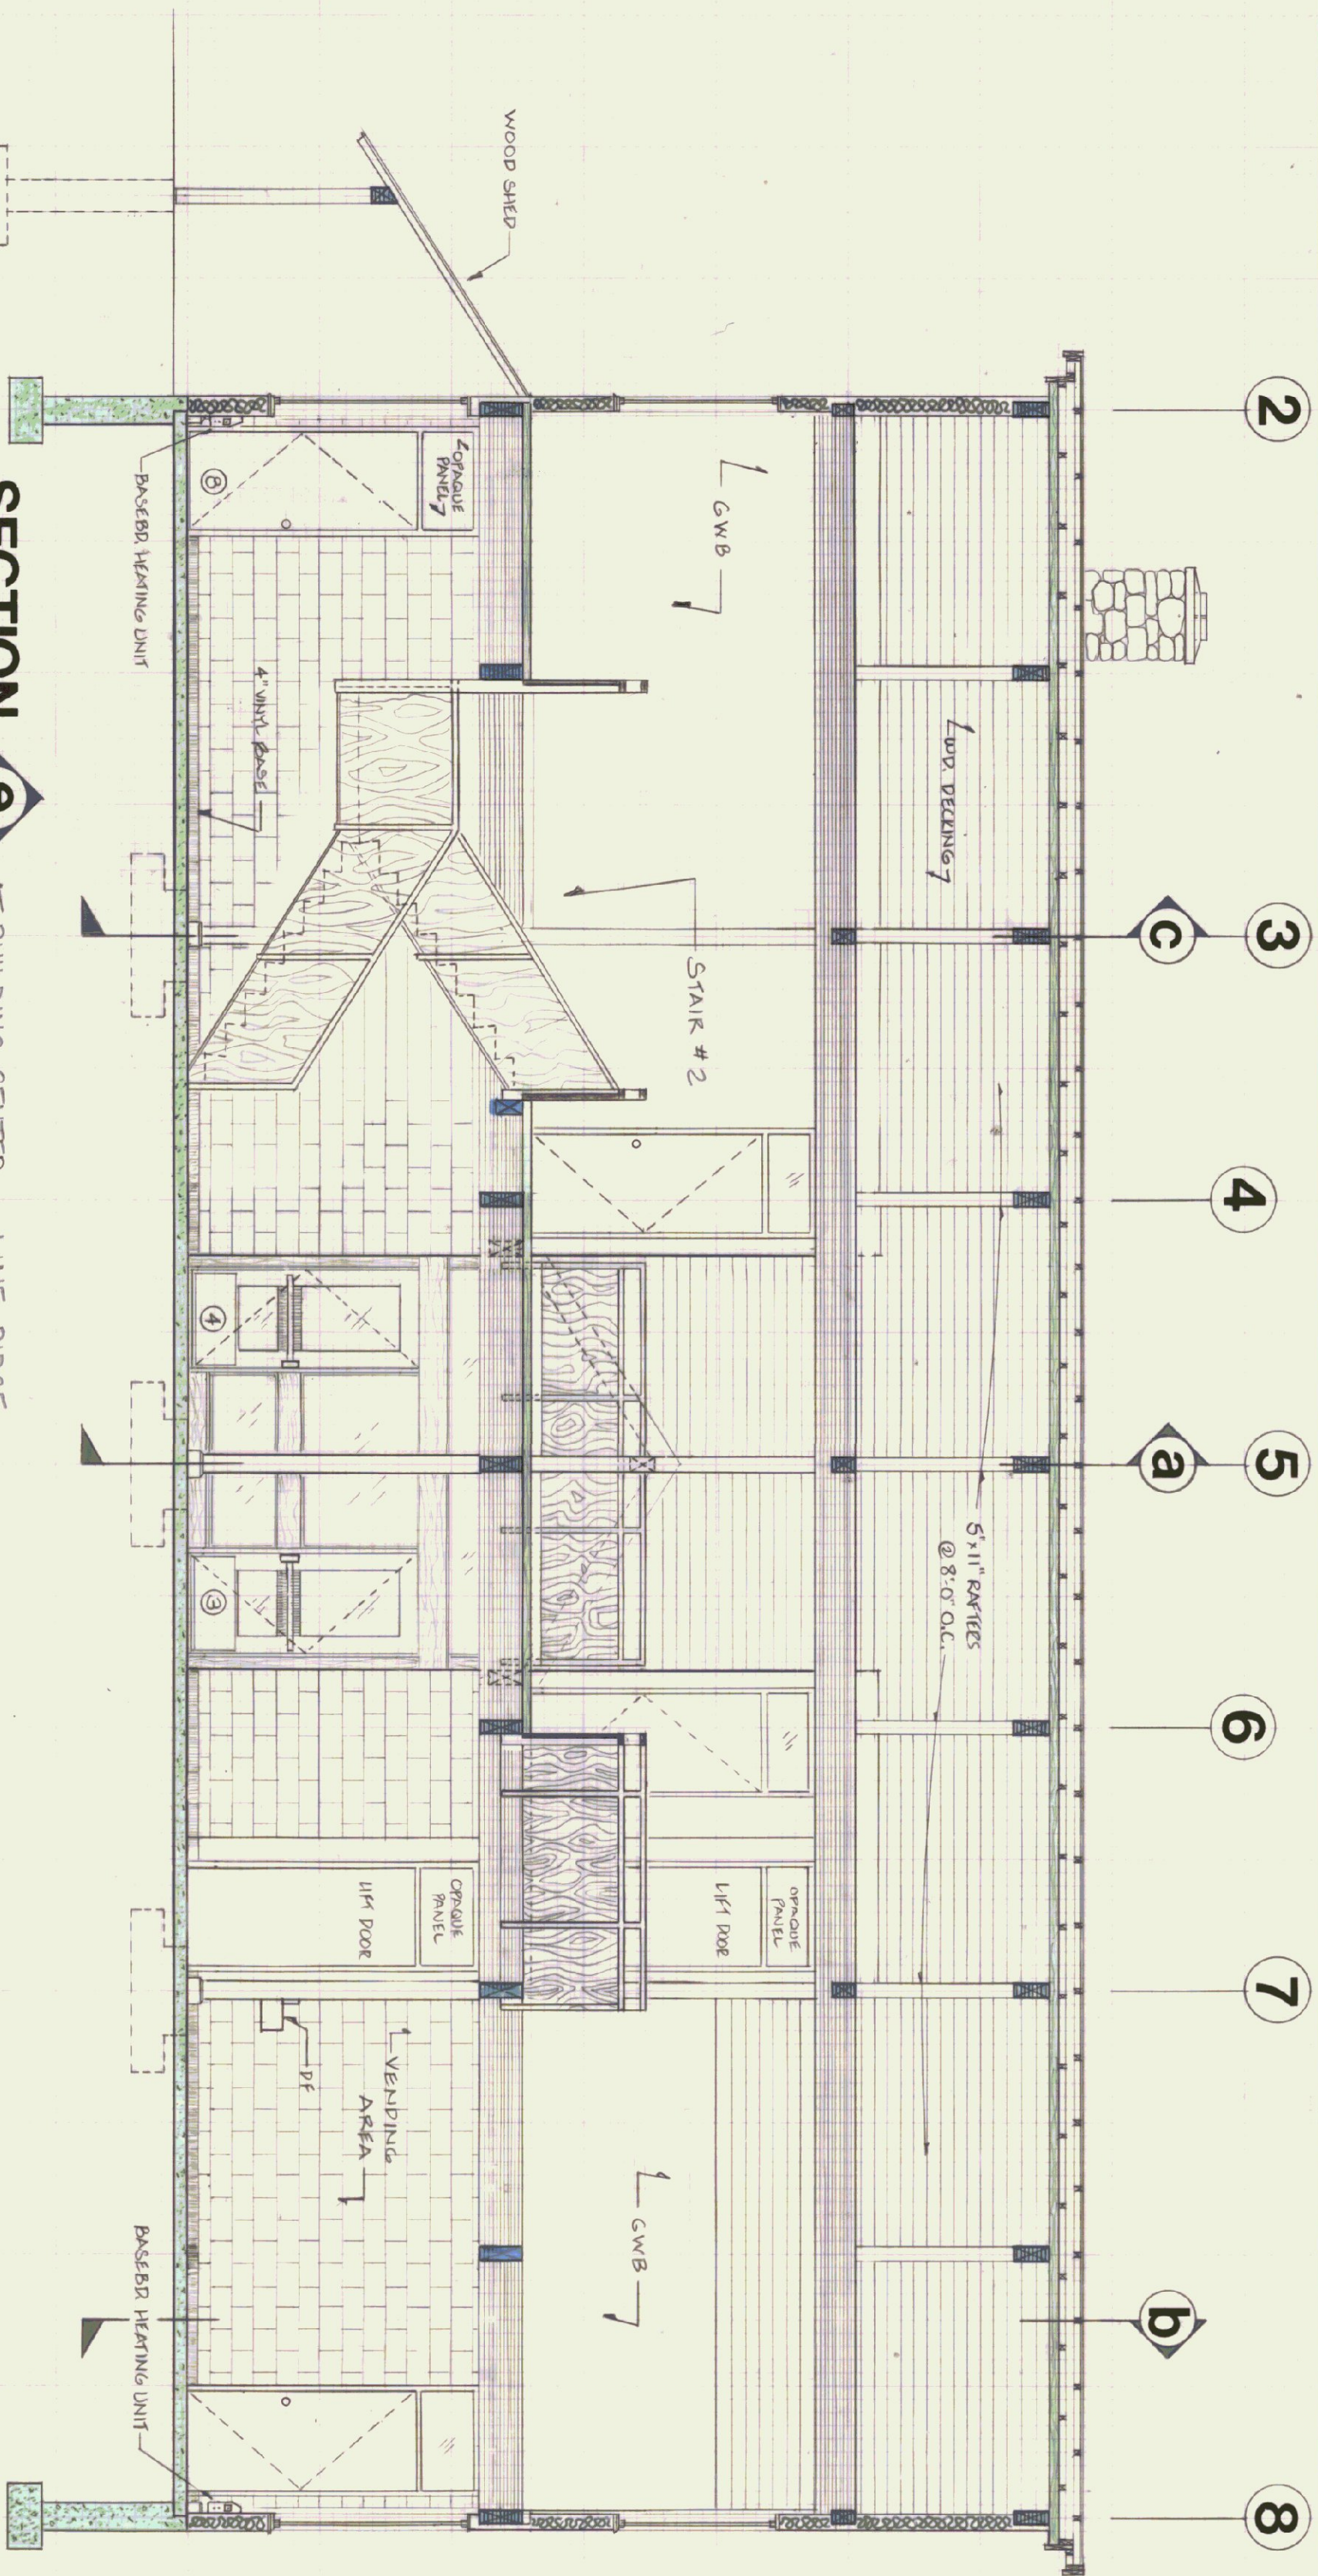


SECTION e AT BUILDING CENTER LINE-RIDGE

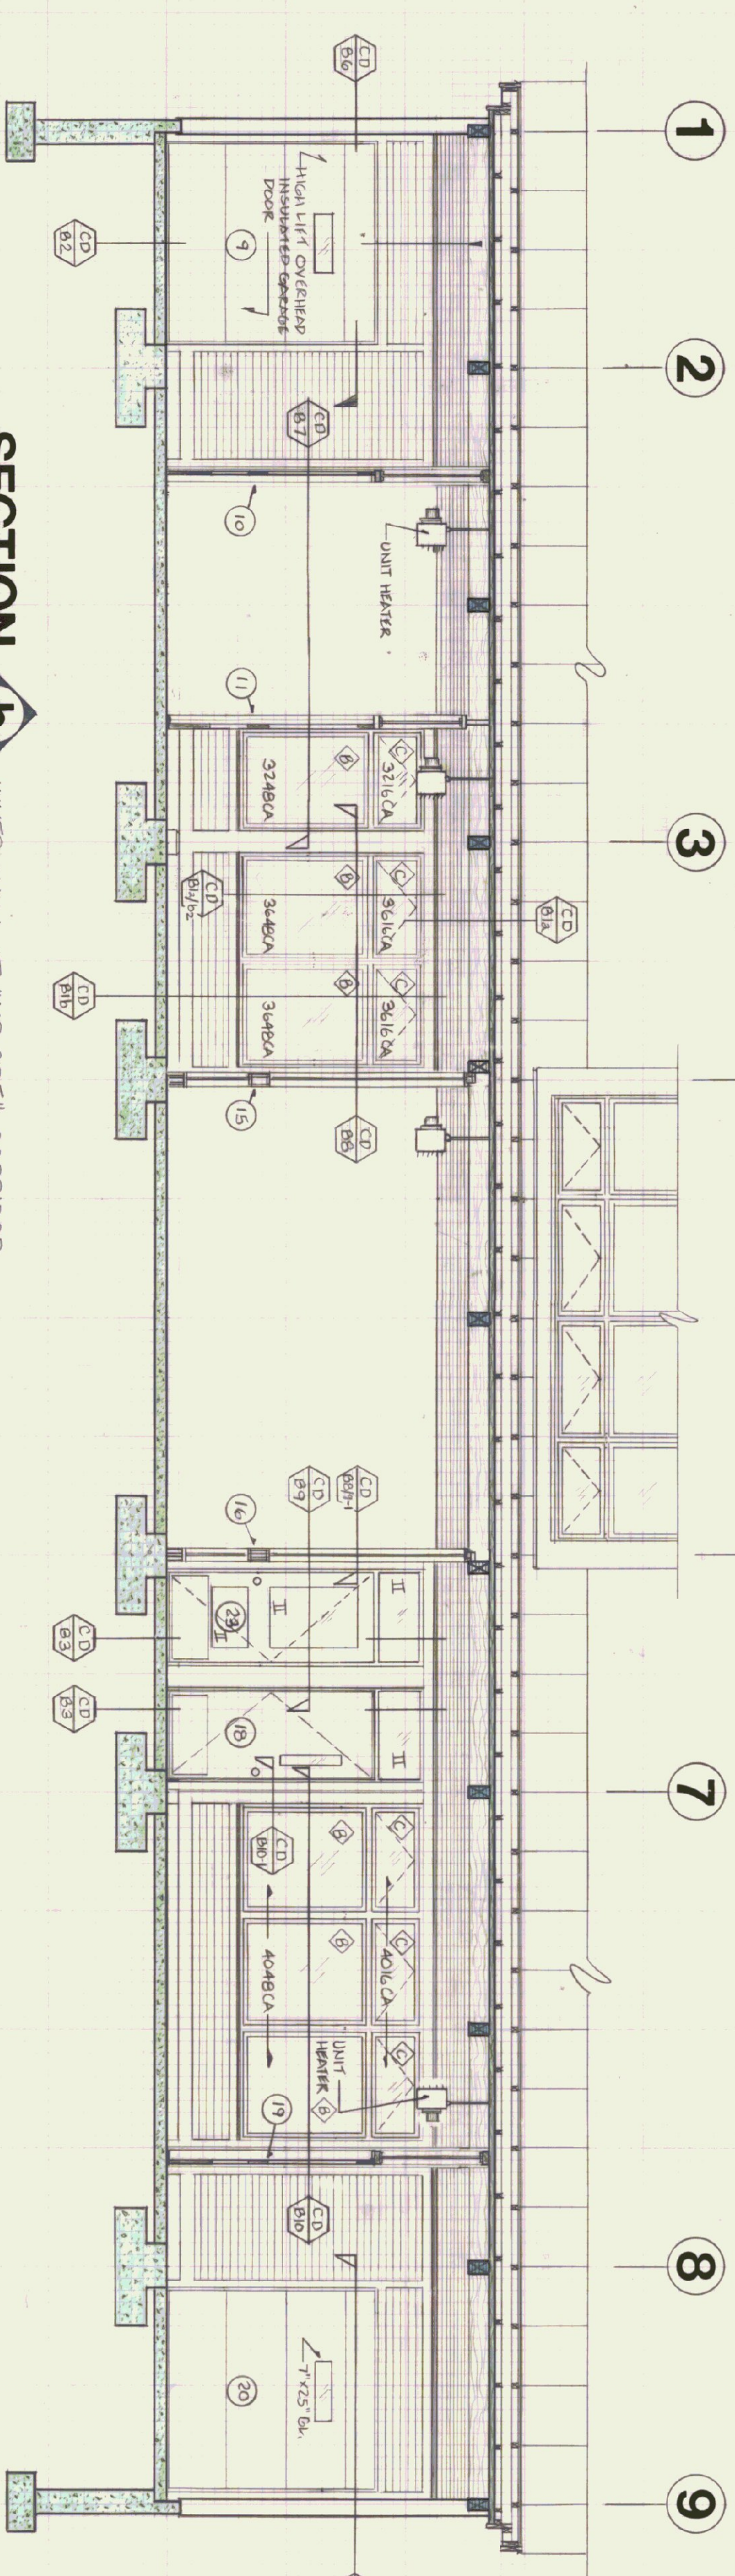

SECTION h INNER WALL AT "AIR-SIDE" CORRIDOR

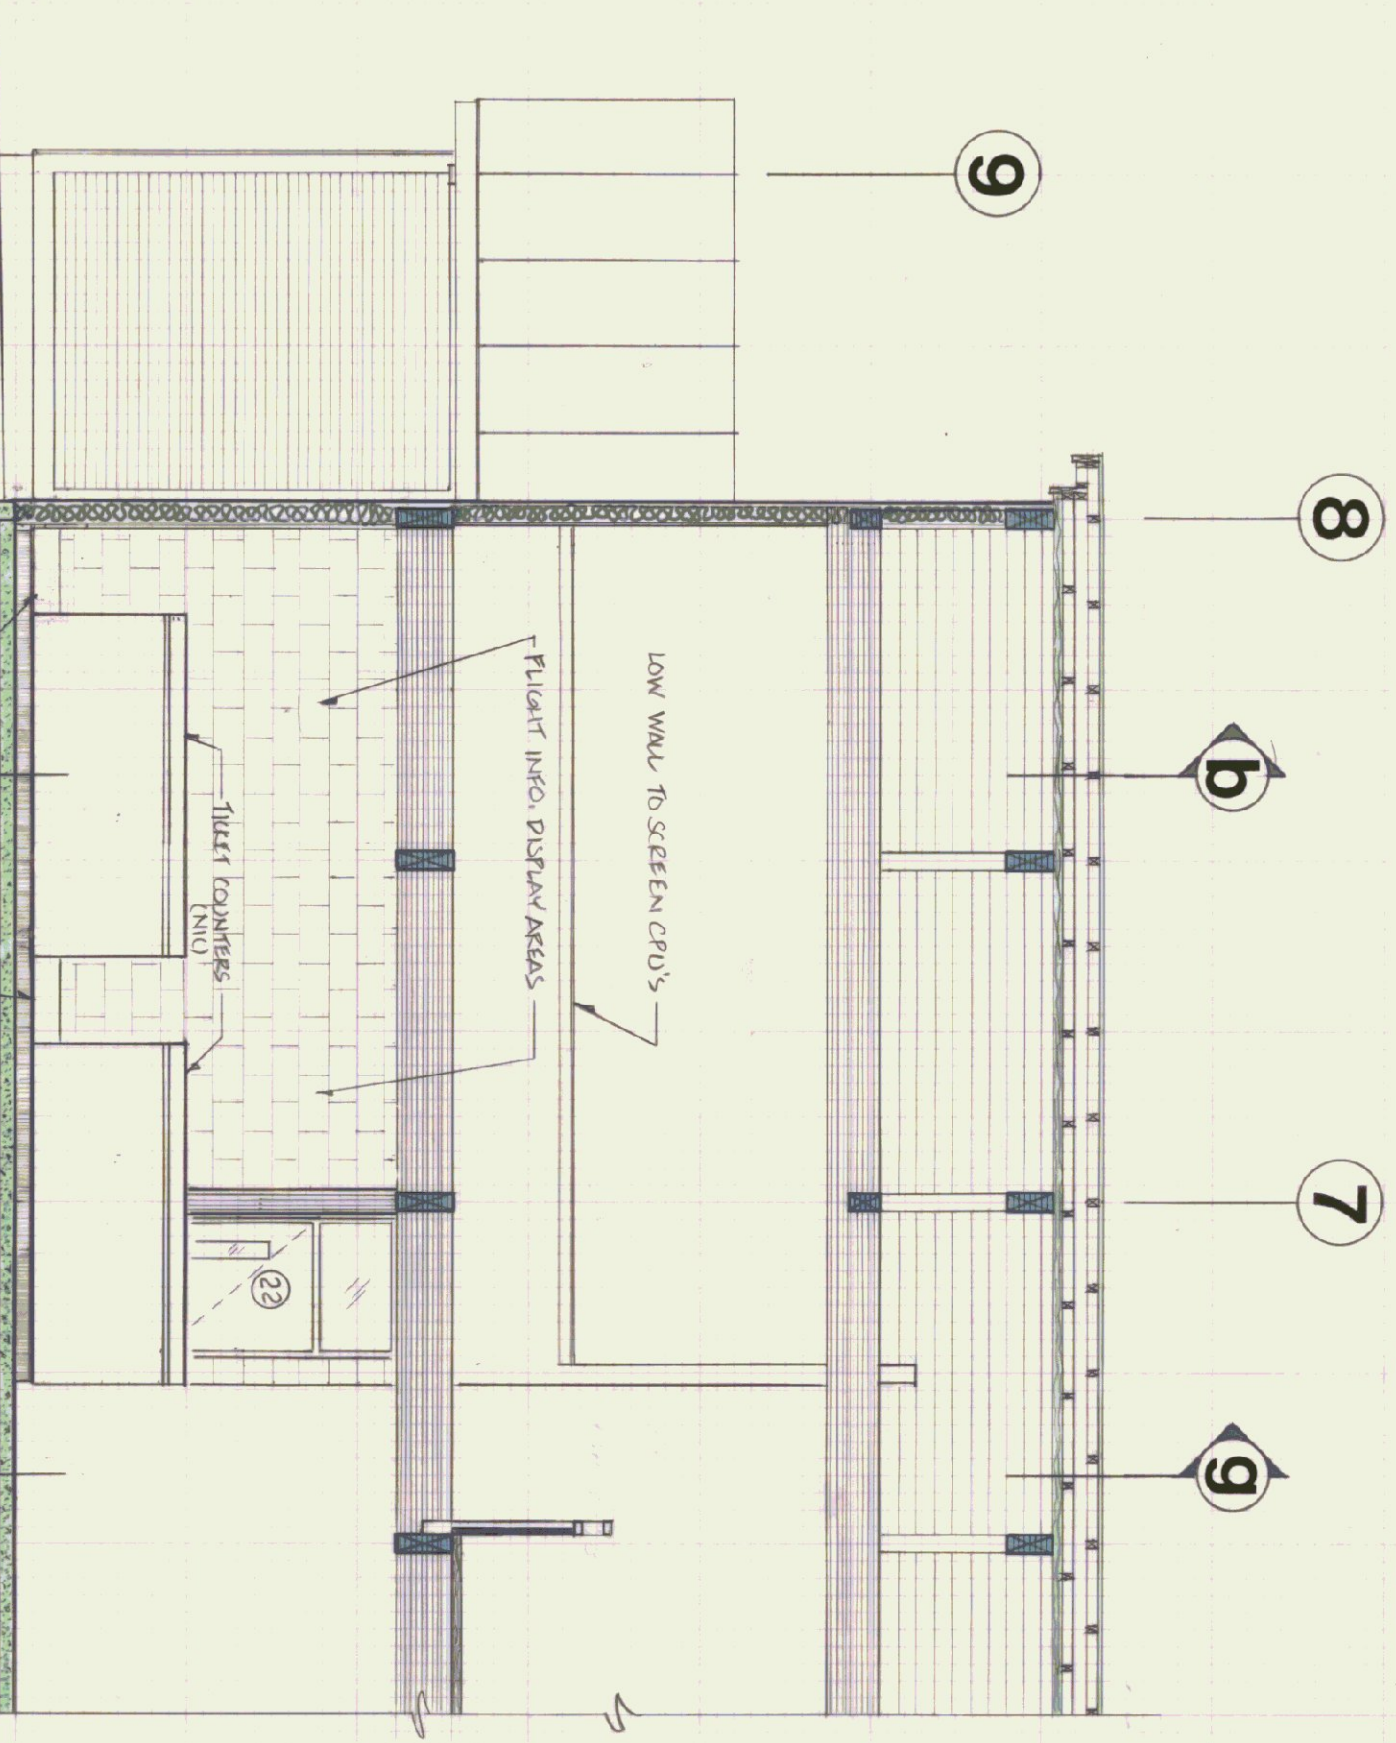

SECTION f

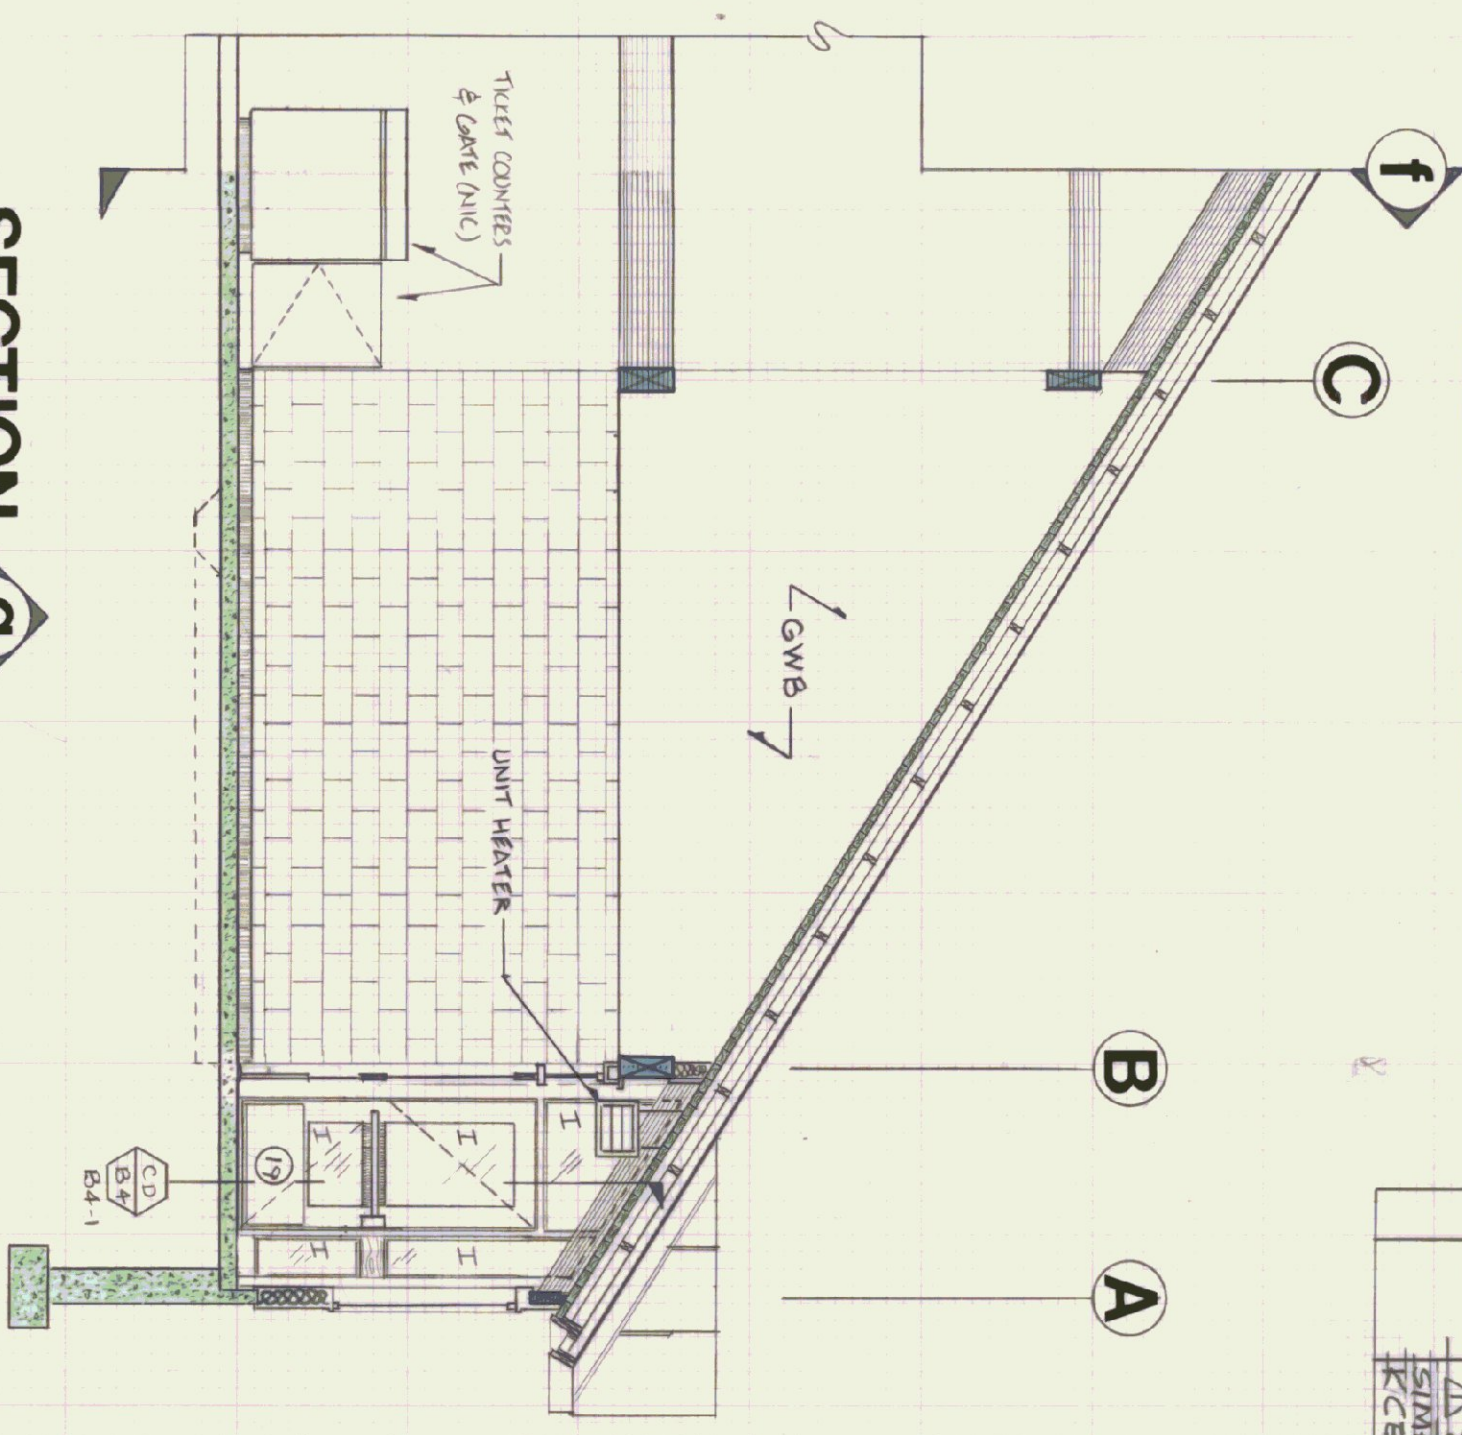


SECTION g

NO.	DATE	DESCRIPTION	BY
1	12/1/24	ISSUE RECORD	PM
2	12/30/24	REVISIONS	PM
3	1/1/25	REVISIONS	PM
4	1/1/25	REVISIONS	PM
5	1/1/25	REVISIONS	PM
6	1/1/25	REVISIONS	PM
7	1/1/25	REVISIONS	PM

STATE OF VERMONT			
DIVISION OF STATE BUILDINGS			
AGENCY OF ADMINISTRATION			
MONTPELIER, VERMONT			
RUTLAND TERMINAL BUILDING AIR 23-2024			
SECTIONS/INT. ELEV.			
RUTLAND STATE AIRPORT			
CLARENDON, VERMONT			
DATE:	SCALE:	REVISIONS:	DWG. NO.
0-8-24	1/8" = 1'-0"	6/2/24 SAH/MLH	A-7
DRAWN BY:	APPROVED BY:		
SPO	MLH/DGB		

ISSUE RECORD		
NO	DESCRIPTION	DATE
1	12-17-84 DAVIS/OLSON SIMPSON - YELLOW HILL FOR A	
2	12-29-84 DAVIS/OLSON SIMPSON - YELLOW HILL FOR A	
7	12-29-84 DAVIS/OLSON SIMPSON - YELLOW HILL FOR A	

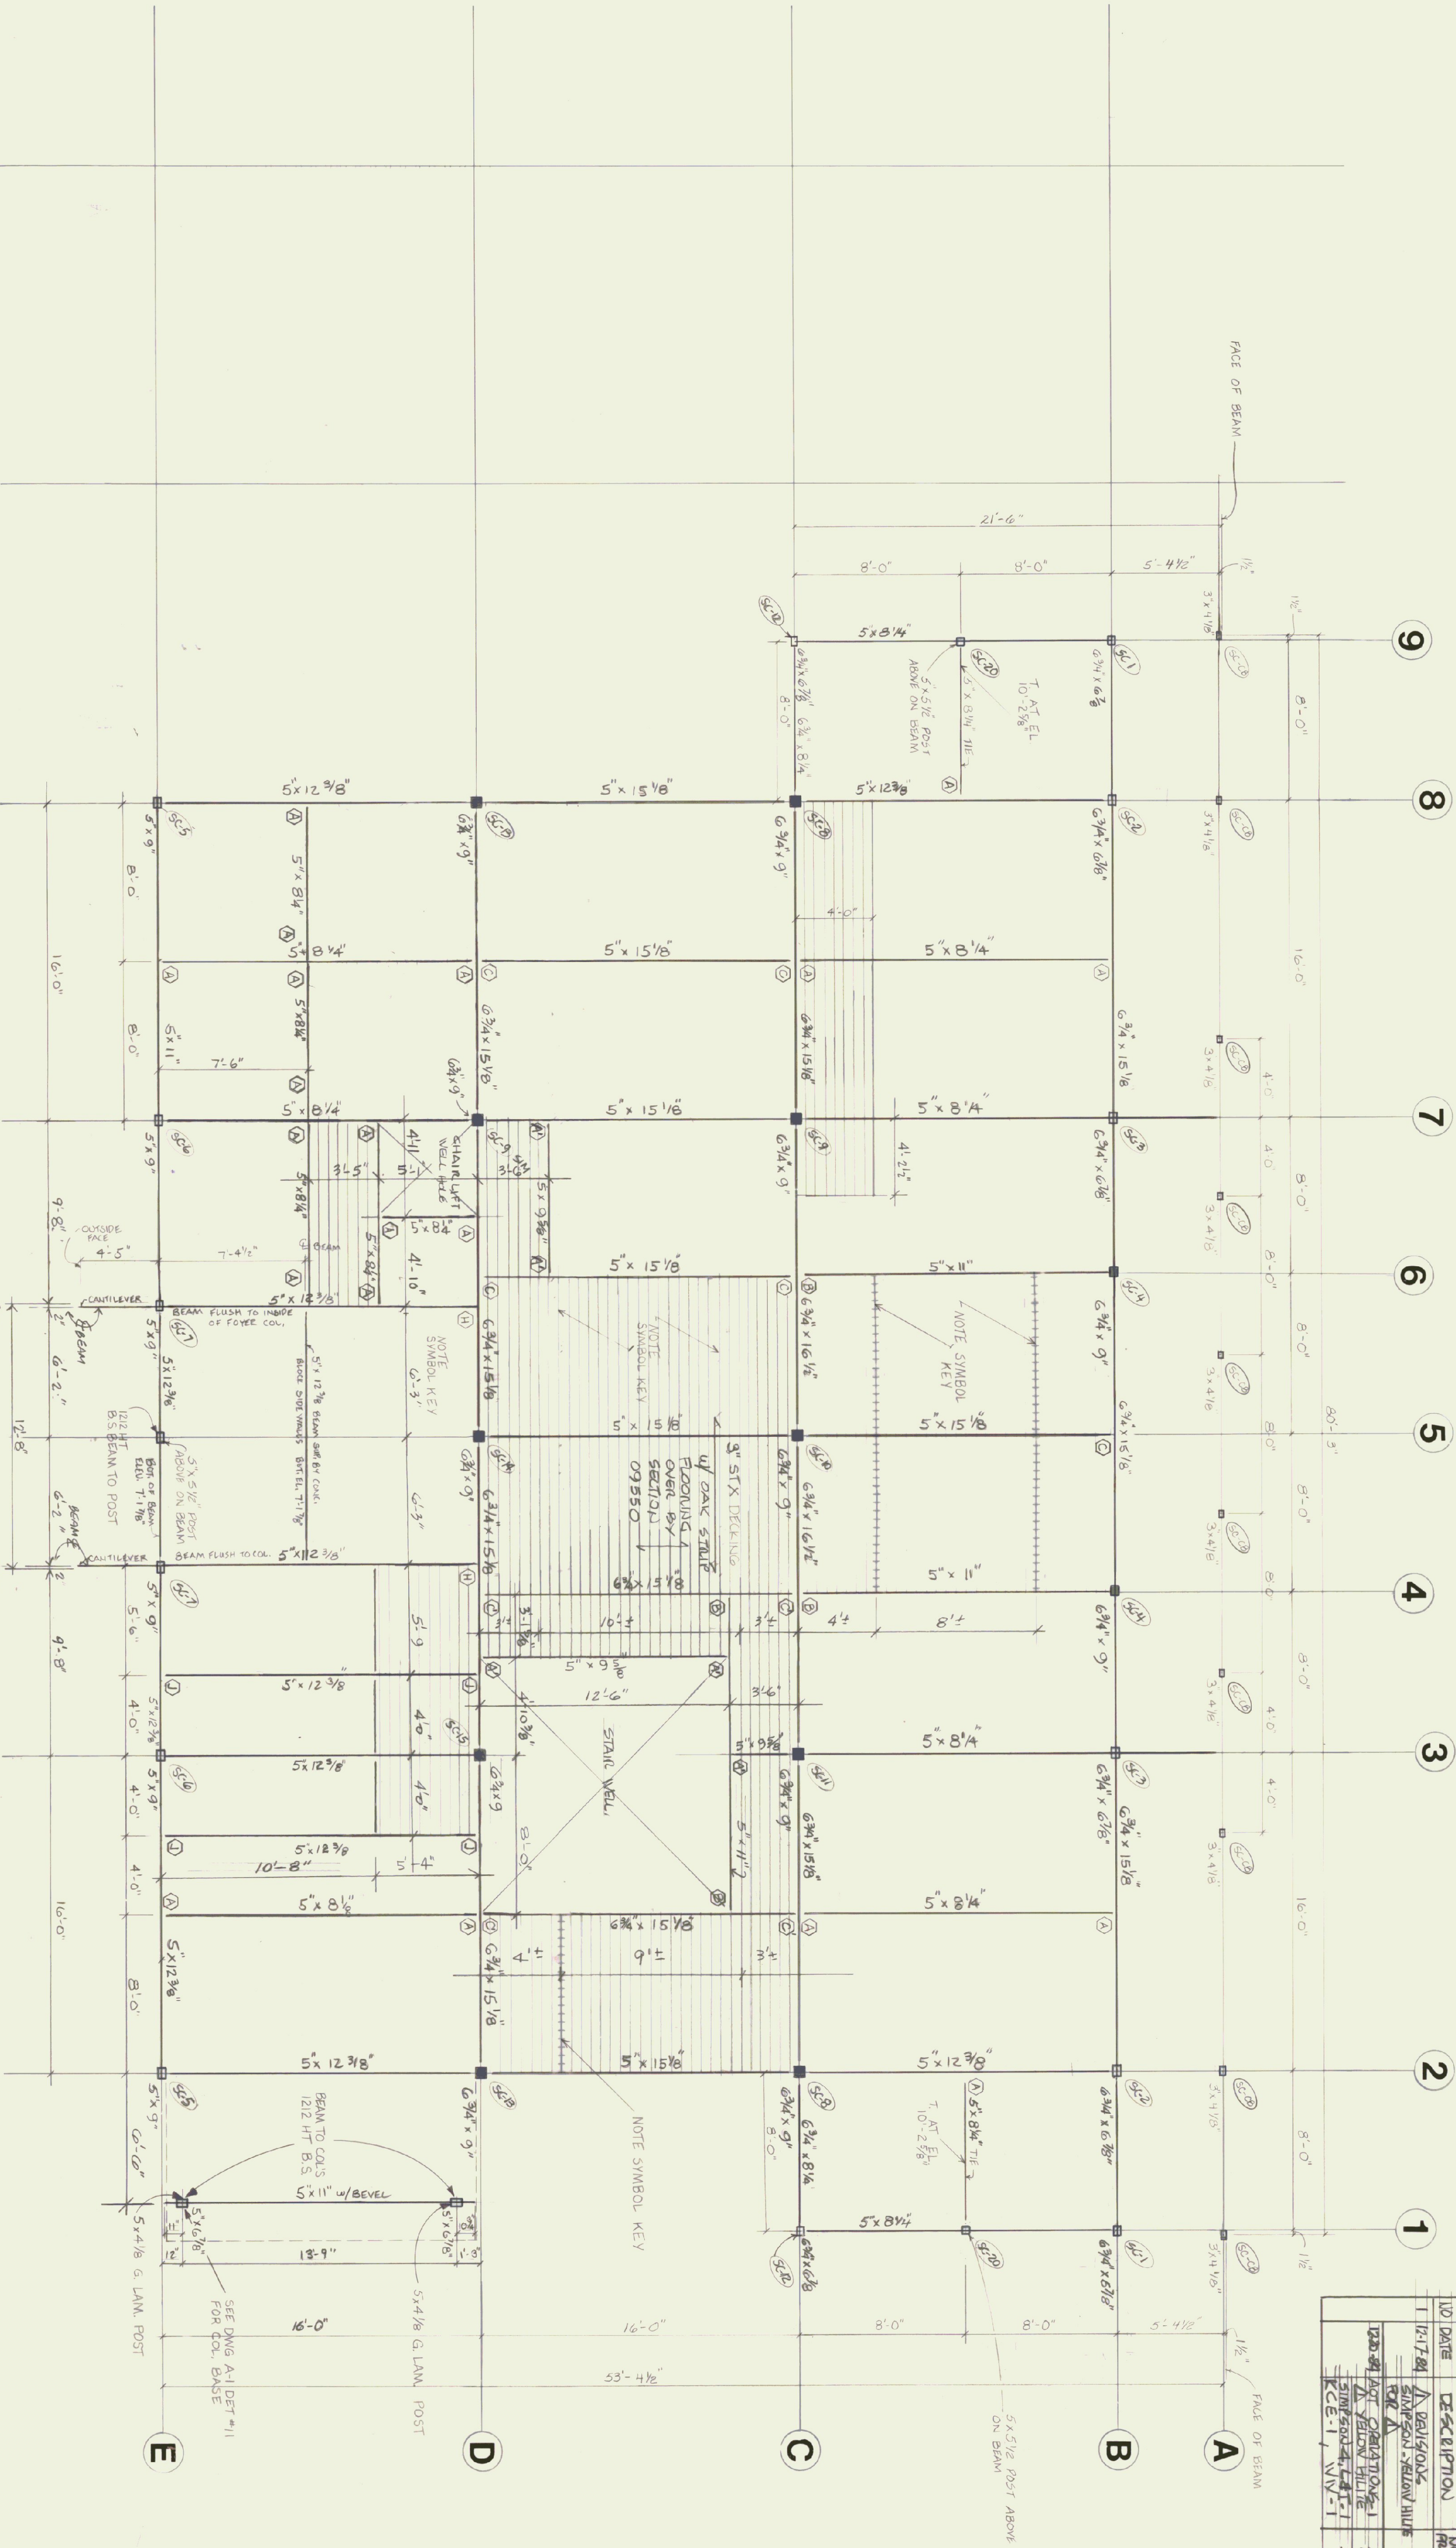

NOTE: 1. TOP OF ALL BEAMS AT 10'-2 5/8" EXCEPT AS NOTED AT ENTRANCE (13'-0" SPAN)
2. FOR CONNECTIONS SEE DETAIL DWG. SERIES SC-1 TO SC-21 & SC-22 - SCHEDULE OF BEAM TO BEAM OR COL. CONNECTION FOR (A) (B) (C) (D) ETC. DESIGNATED
3. STANDARD CORRECTIONS I.E.: 122 HT BBL, HST 242, 1224, 1212, ETC. AS INDICATED BY THE SIMPSON CO. - STRONG-TIE

KEY

- COLUMN STOP, BENEATH BEAM
- COLUMN CONTINUES
- ↑ FIRST COLUMN DIMENSION
- ↑ SECOND COLUMN DIMENSION
- ++++ ROUT OUT AT UNDER SIDE / DECK SOFTENING 3/4" DEEP x 1/4" AT 4" OF DECKING PLANK UNIT, CONTINUOUS FOR FULL LENGTH OF DECKING





REVISED 10-30-84

STATE OF VERMONT
DIVISION OF STATE BUILDINGS
AGENCY OF ADMINISTRATION
MONTPELIER, VERMONT

RUTLAND TERMINAL BUILDING AIR 23-2024
MEZZANINE FRAMING
CLARENDON, VERMONT

DATE: 6-8-84	SCALE: 1/4" = 1'-0"	REVISIONS: 7/26/84 S.A. MUEHLEN	DWG. NO. SF-1
DRAWN BY: JPD	APPROVED BY: MFC/DSE		11 OF 20

ISSUE RECORD	
NO	DESCRIPTION
1	12/1/84 A. DENISON'S SIMPSON YELLOW HIRE FOR A
2	12/20/84 POST-OPERATIONS-1 A. SELDON HILL
3	12/20/84 A. SELDON HILL
4	12/20/84 A. SELDON HILL
5	12/20/84 A. SELDON HILL
6	12/20/84 A. SELDON HILL
7	12/20/84 A. SELDON HILL

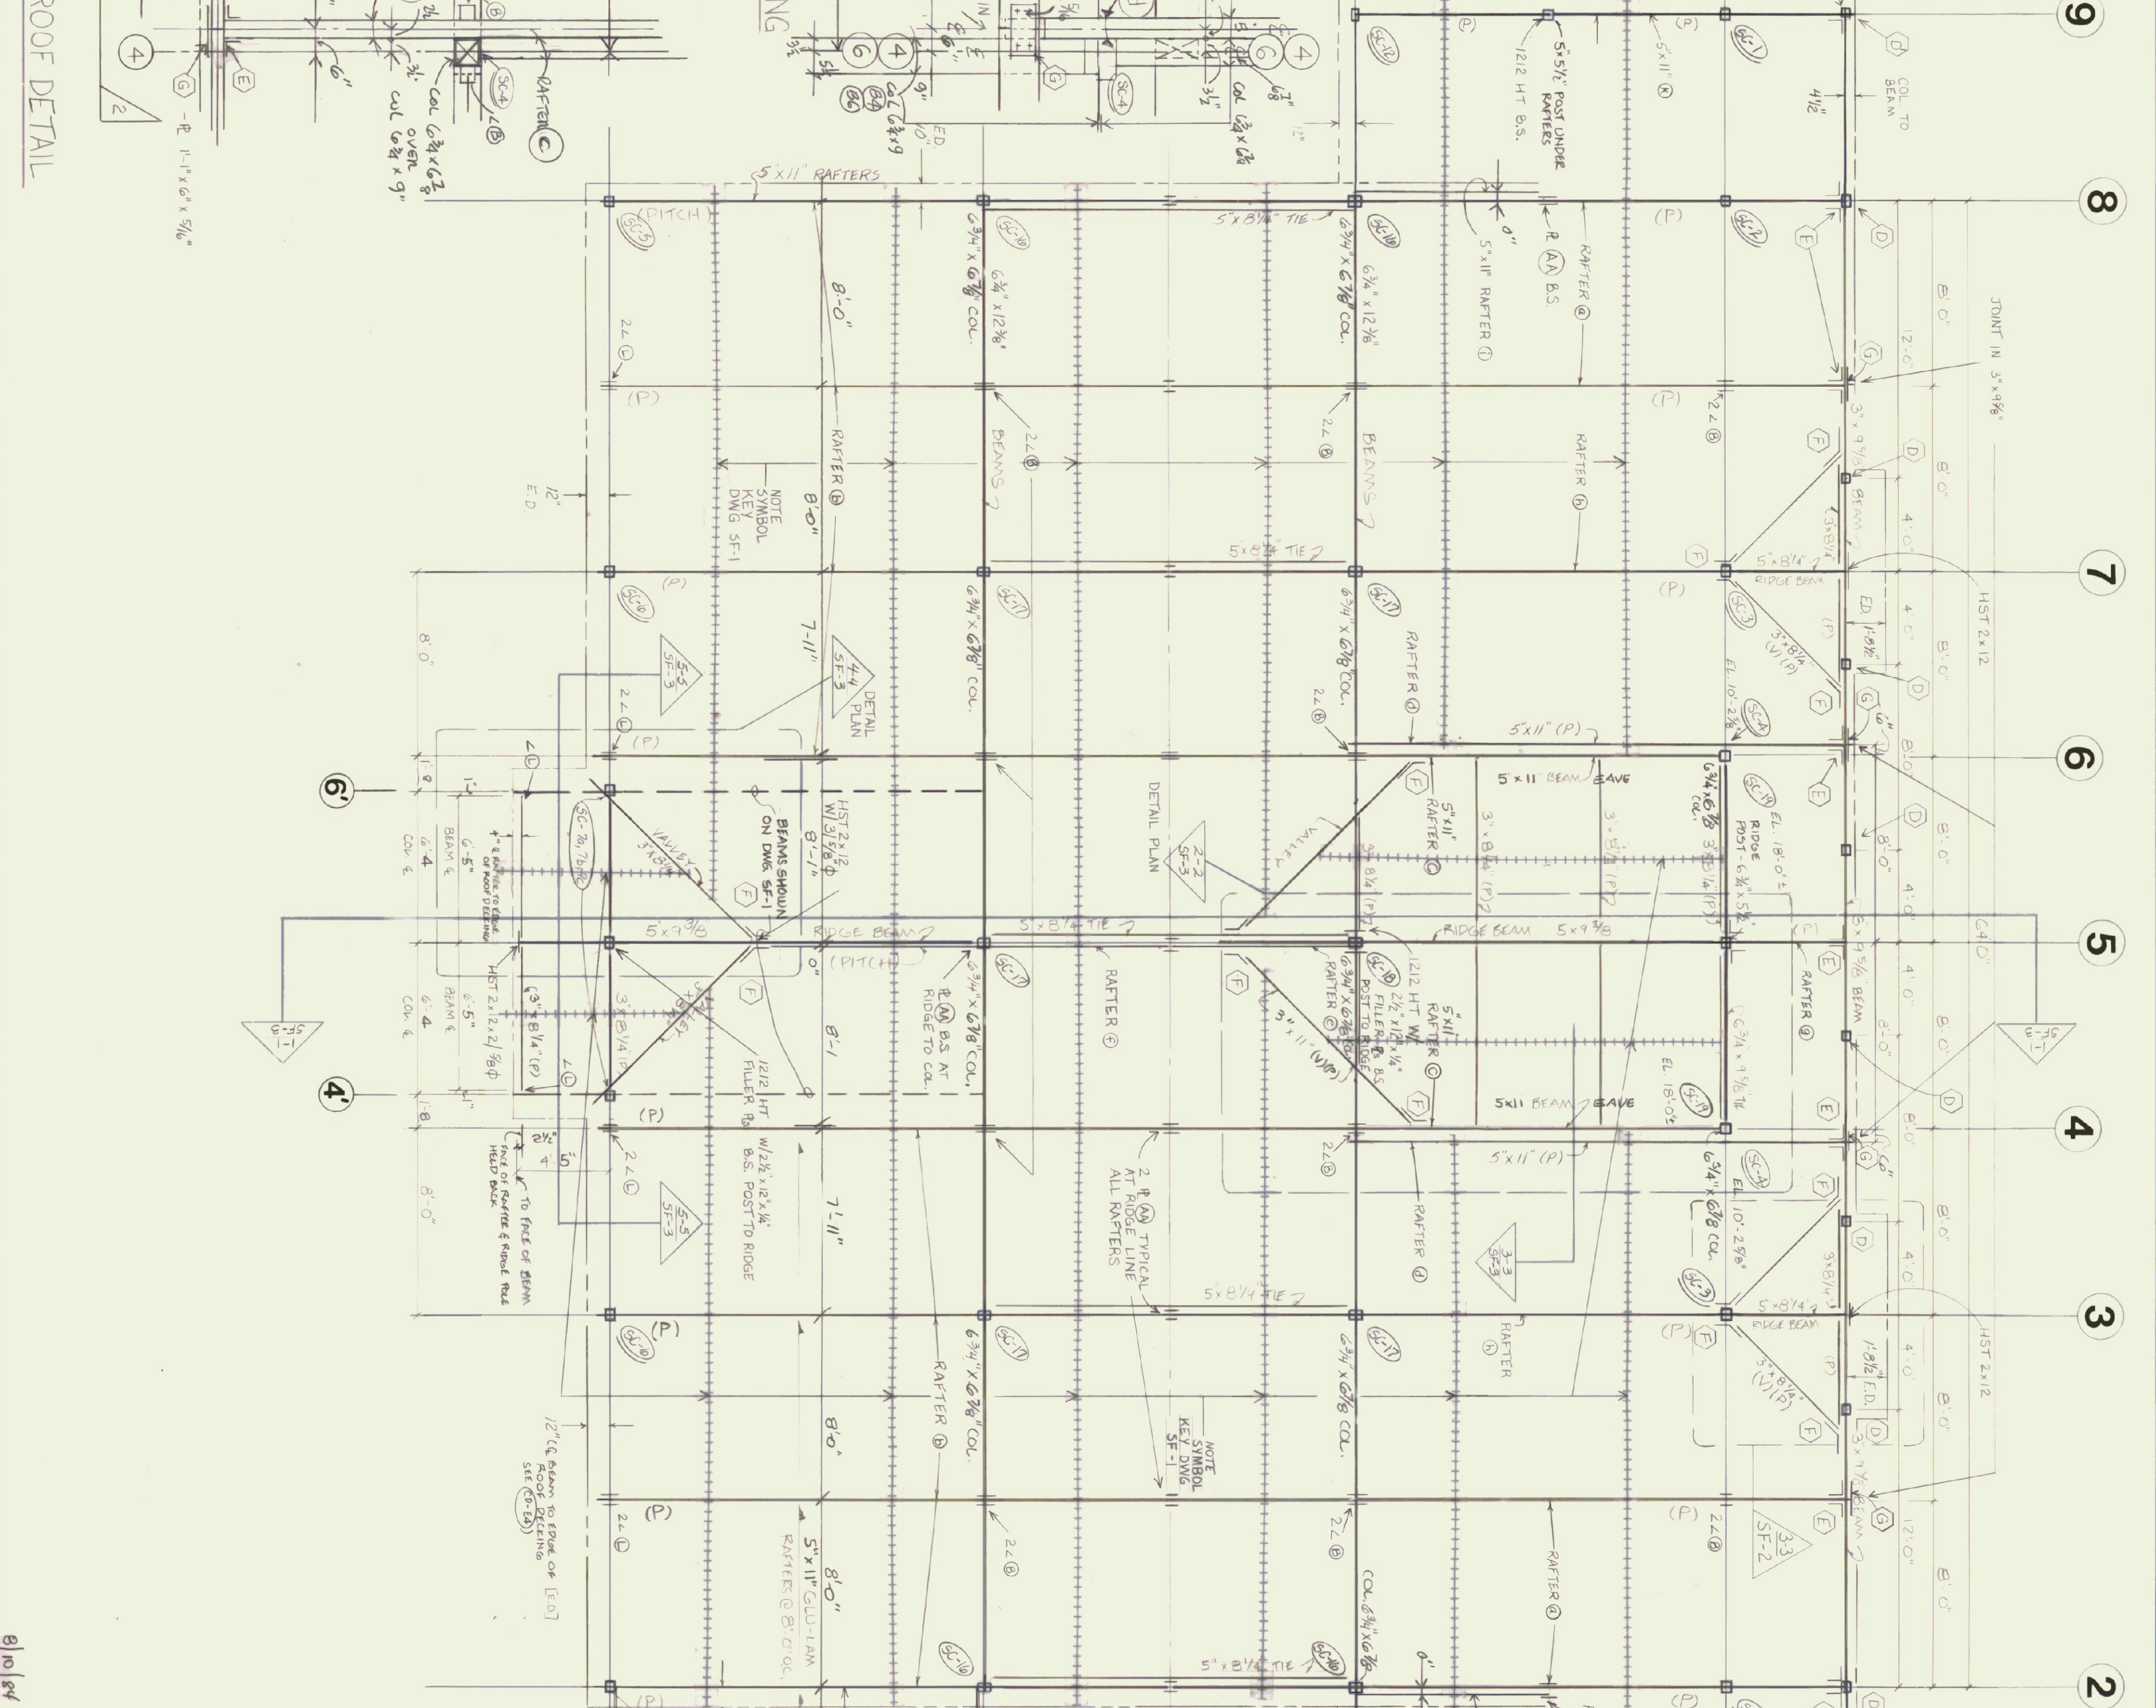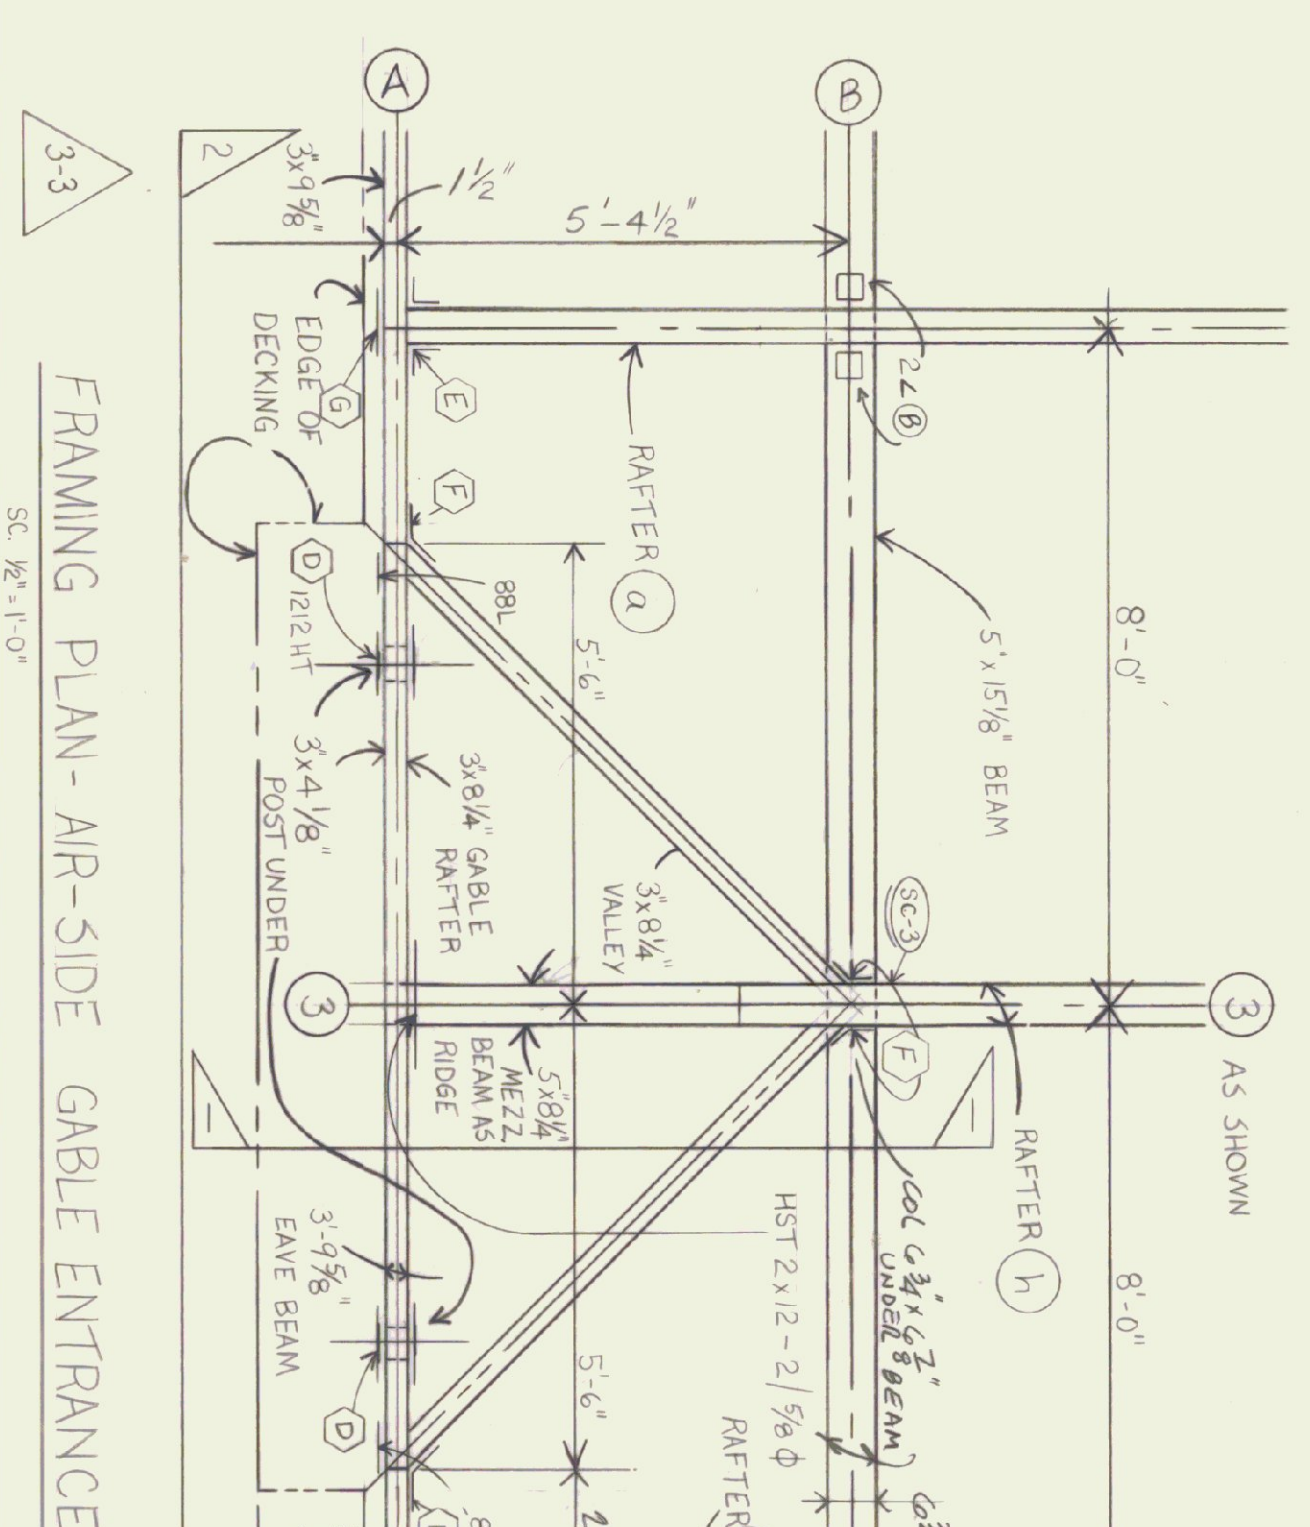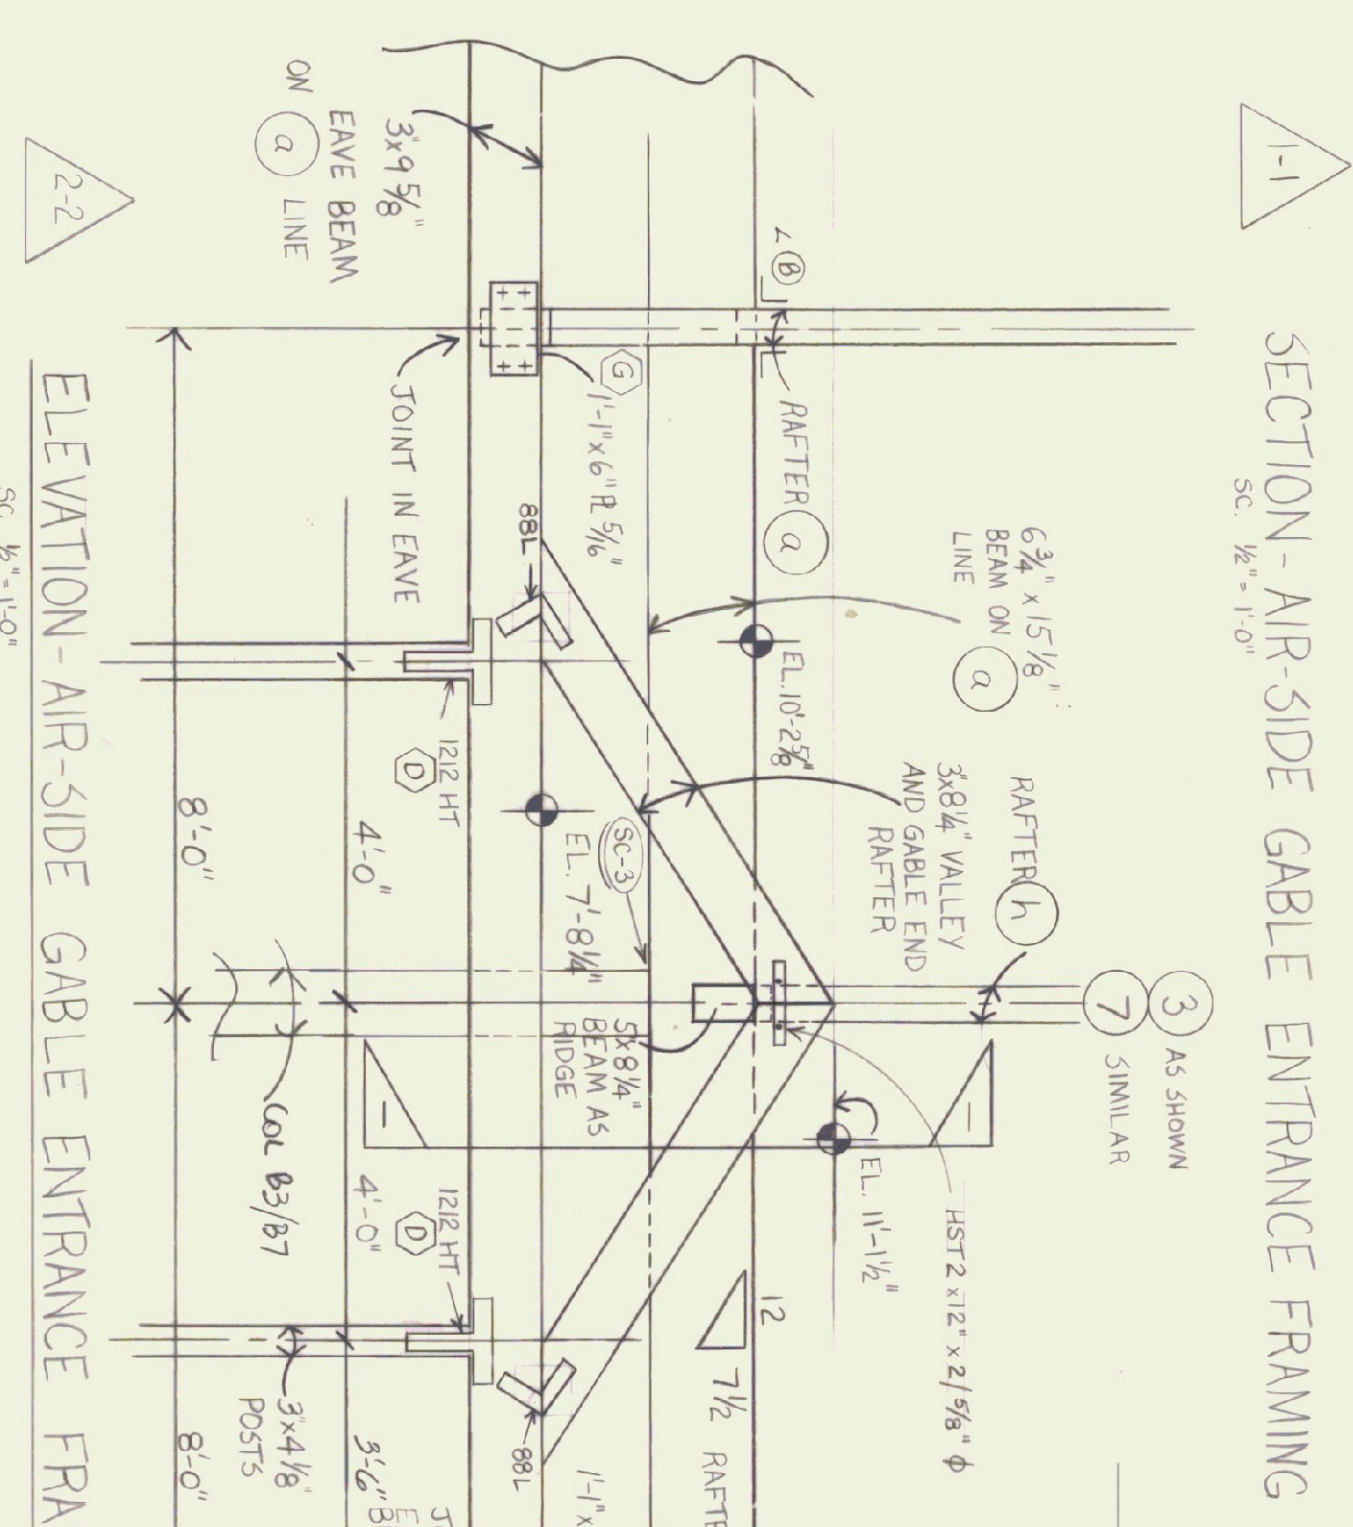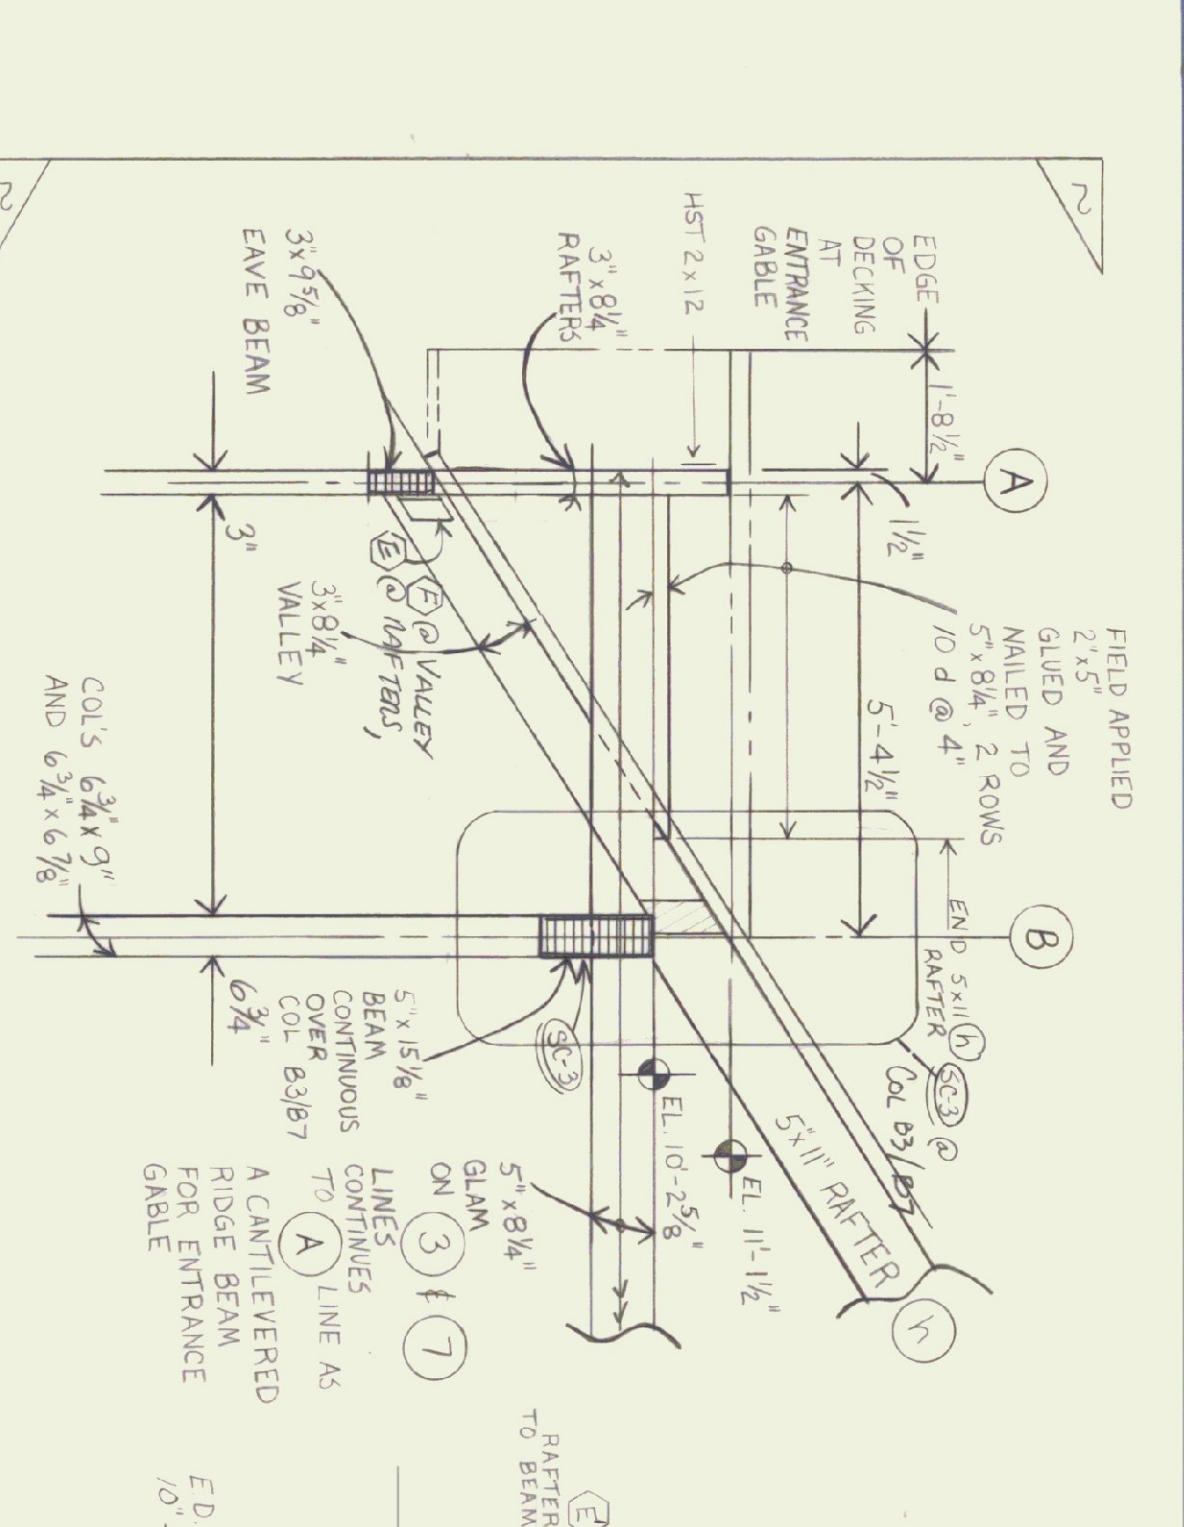



DATE: 6/8/84
DRAWN BY: JPD
SCALE: 1/4\"/>

REVISIONS:
7/10/84 S.A. MILLER
10-30-84
DWG. NO. SF-2
12 OF 20


STATE OF VERMONT
DIVISION OF STATE BUILDINGS
AGENCY OF ADMINISTRATION
MONTPELIER
VERMONT
RUTLAND TERMINAL BUILDING AIR 23-2024
ROOF FRAMING
RUTLAND STATE AIRPORT
CLARENDON, VERMONT

REVISED 10-30-84 ADDENDA NO. 1.

LIGHTING FIXTURE SCHEDULE			
Type	Description	Lamps	Equal to
A	FLUORESCENT 2-LAMP W/4000K ACRYLIC DIFFUSER	2-F40W	LITHONIA SC240
B	OPEN		
C	SIMILAR TO A, 4 LAMPS	4-F40W	LITHONIA SC240
D	FLUORESCENT 24 X 48 SURFACE WITH 4-F40W 4 LAMPS, 1/2 X 1/2 X 1/2 ALUM.	4-F40W	DAY-BRITE
E	FLUORESCENT 24 X 48 SURFACE WITH 2-LAMP 2-F40W	2-F40W	DAY-BRITE
F	SIMILAR TO D, 24 X 48, 2-LAMP 2-F40W	2-F40W	DAY-BRITE
G	FLUORESCENT OPEN STRIP, 2-LAMP 2-F40W	2-F40W	LITHONIA C140
H	FLUORESCENT OPEN STRIP, 1-LAMP 1-F40W	1-F40W	LITHONIA C240
I	WALL MOUNTED SINGLE-LAMP FLUOR. METAL BOX SHIELD, BRONZE FIN.	1-F40W	CH-4241
J	SIMILAR TO I, BUT 8 FT LONG	2-F40W	LITHONIA CH-4241
K	WALL-MOUNTED SINGLE-LAMP FLUOR. OPAL ACRYLIC W/4000K DIFFR.	1-F40W	PRESCOTTITE 3087
L	EXTENSION INCAN. WALL BRACKET, 6 IN. DIA., BRONZE FIN.	A19 91W	PRESCOTTITE 1185-363
M	INCAN. PENDANT 6-IN. CYLINDER BRONZE FIN.	PAR-38 130W FL	PRESCOTTITE 1125-920
N	SAME AS M	R-30, 75W	
O	INCAN. BRACKET, 5-IN. CYLINDER BRONZE FIN.	R-30 75W	PRESCOTTITE 1092-910
P	FLUORESCENT SINGLE-LAMP VANDAL PROOF, POLY CARB LENS	F40W	RECALL 7140
Q	SAME AS O BUT WITH LO-TEMP BALLAST		

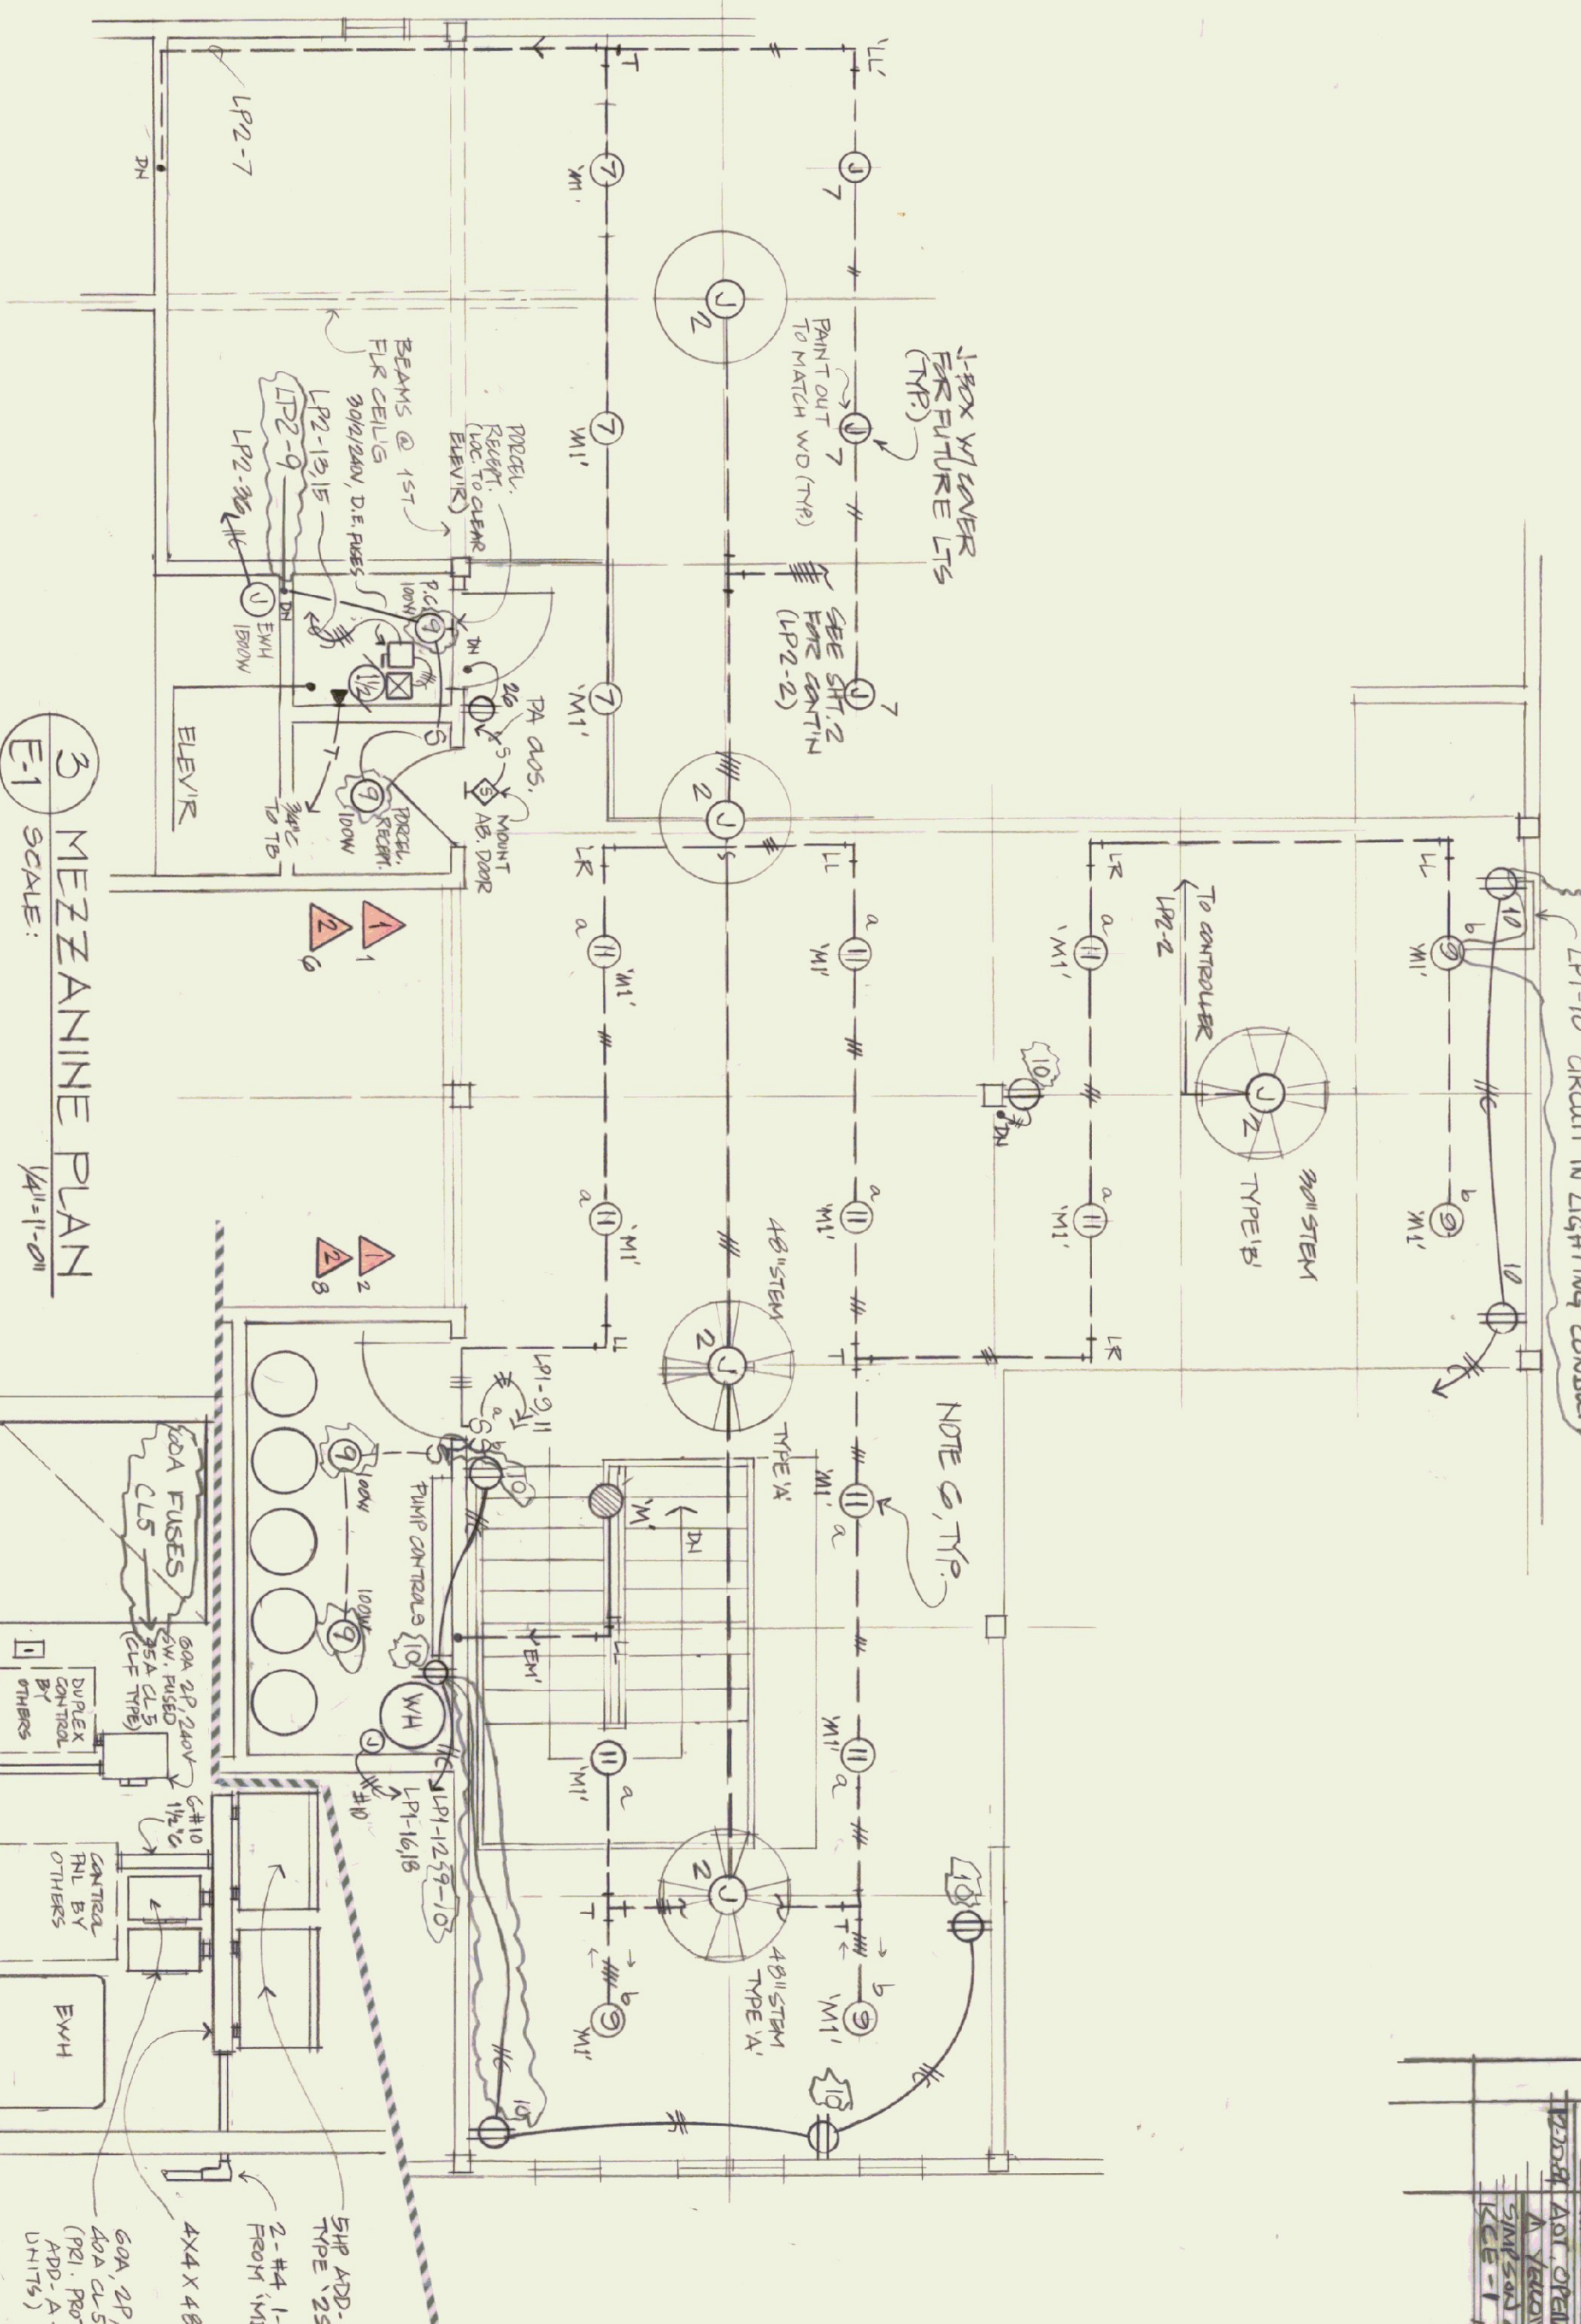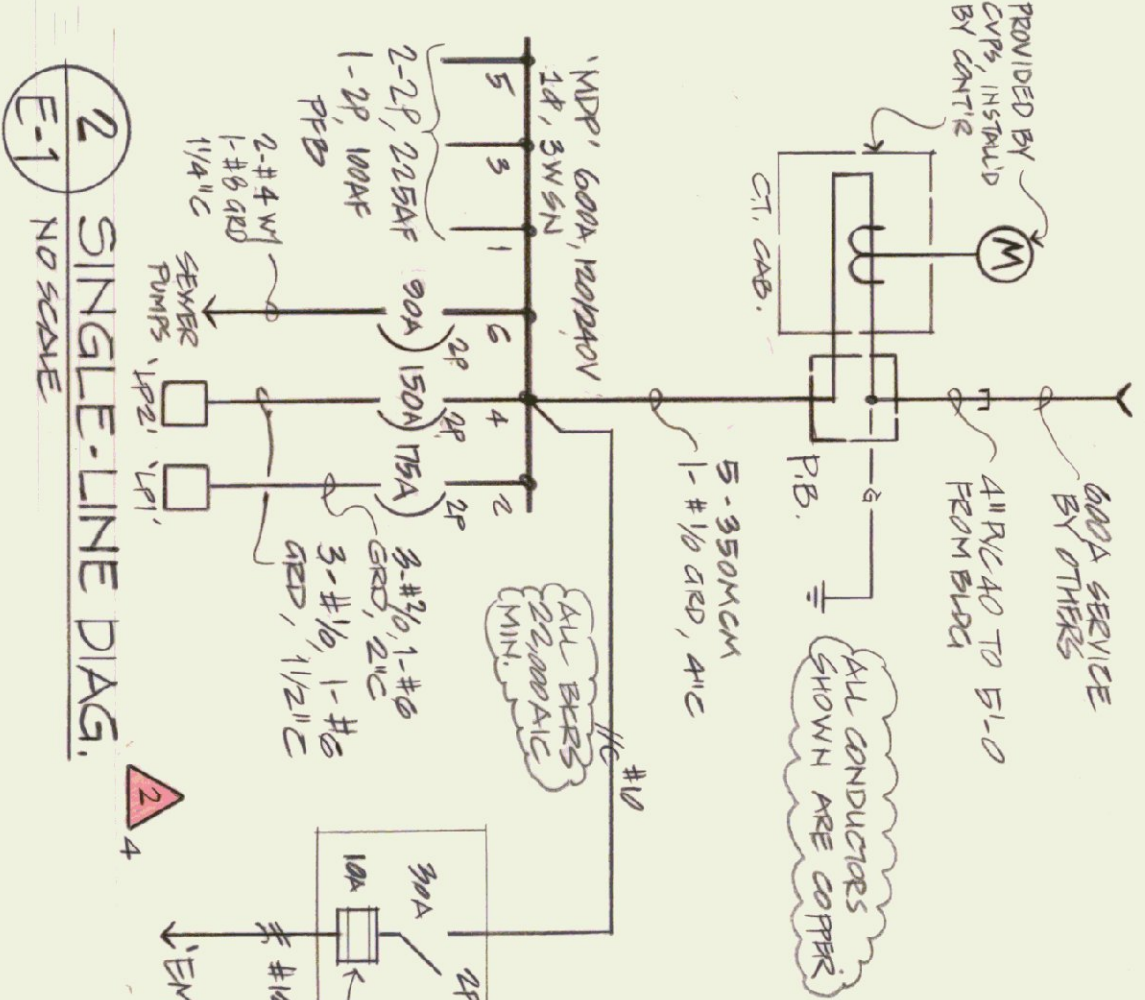

4 ELEV. @ PUMP CONTROL E-1 SCALE: 1/2" = 1'-0"

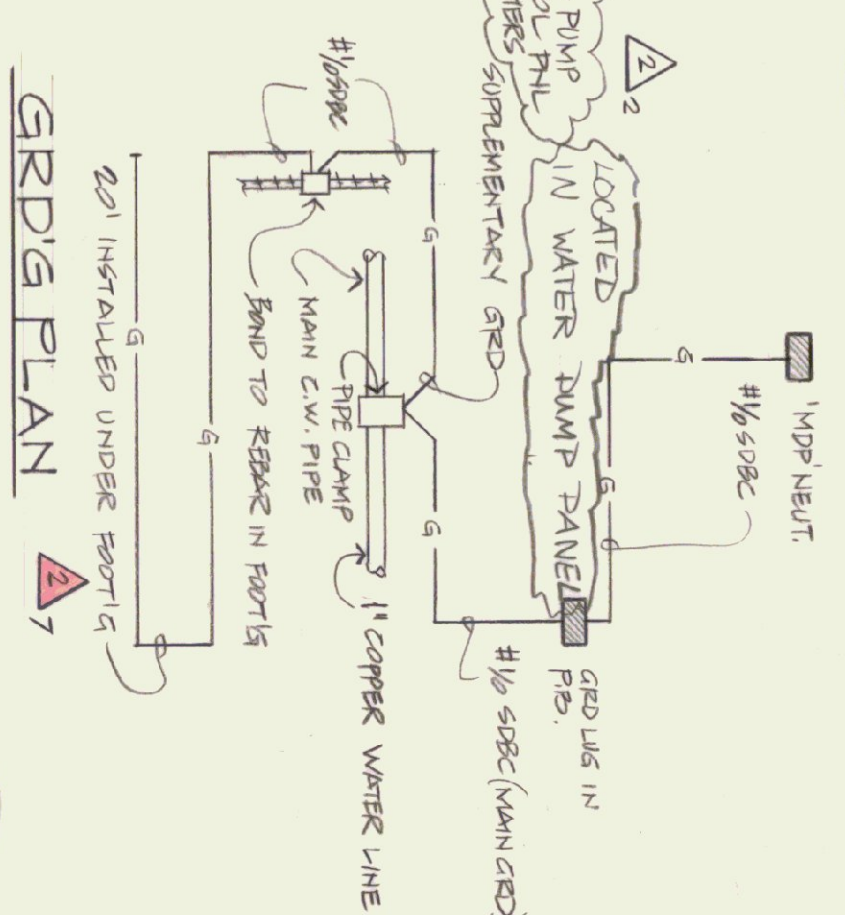

GRDG PLAN E-1 SCALE: 1/2" = 1'-0"



GRDG PLAN E-1 SCALE: 1/2" = 1'-0"



ISSUE RECORD		
NO	DATE	DESCRIPTION
1	12-17-84	DESIGN
2	12-20-84	REVISED
3	12-20-84	REVISED
4	12-20-84	REVISED
5	12-20-84	REVISED
6	12-20-84	REVISED
7	12-20-84	REVISED
8	12-20-84	REVISED
9	12-20-84	REVISED
10	12-20-84	REVISED

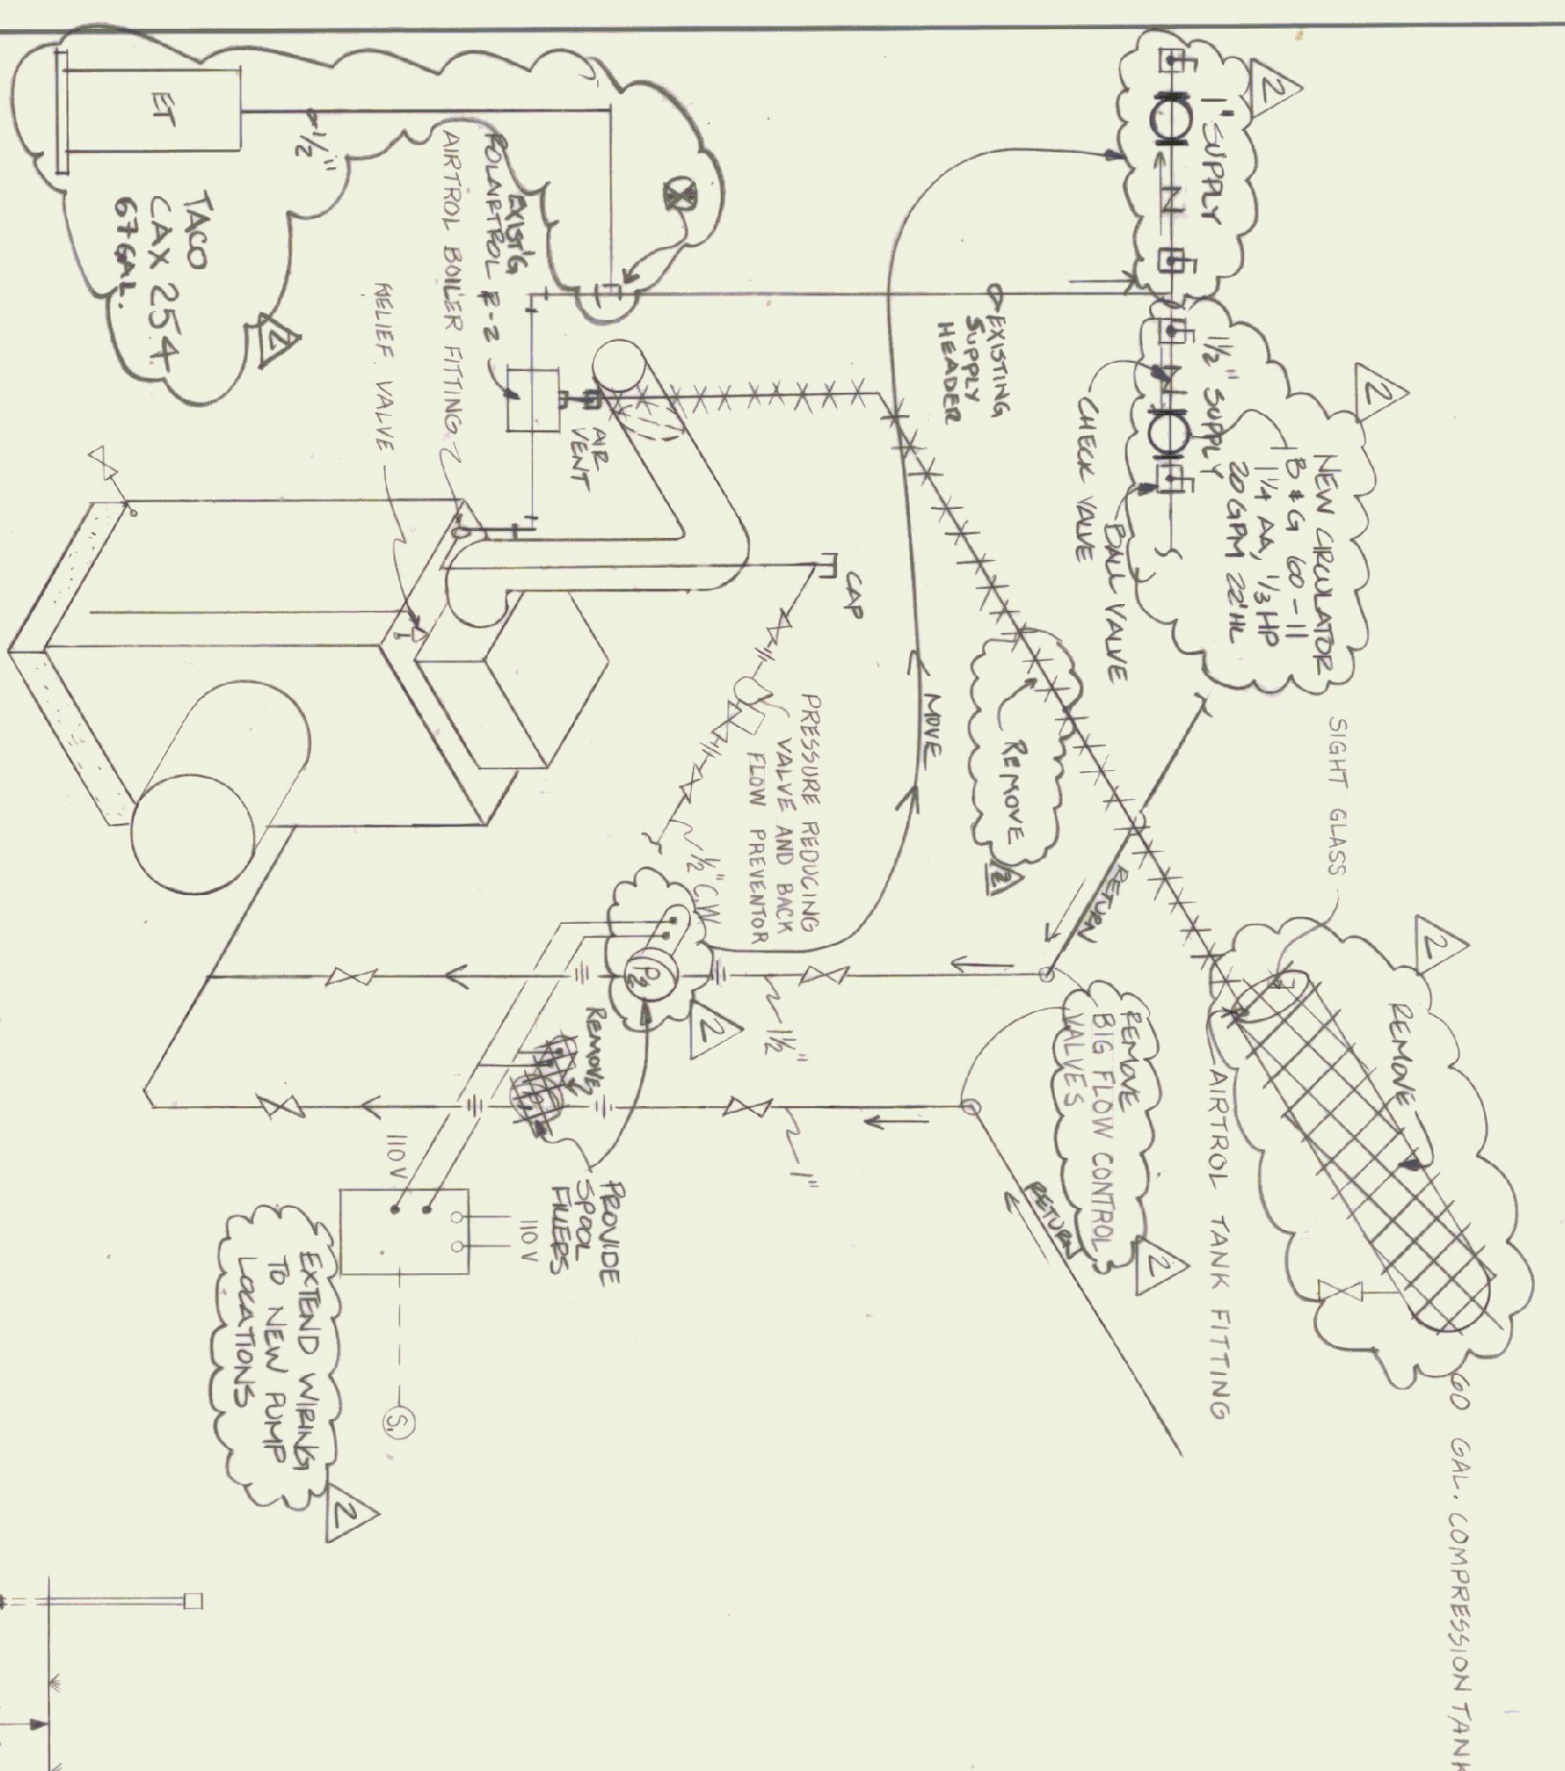


BOILER PIPING SCHEMATIC

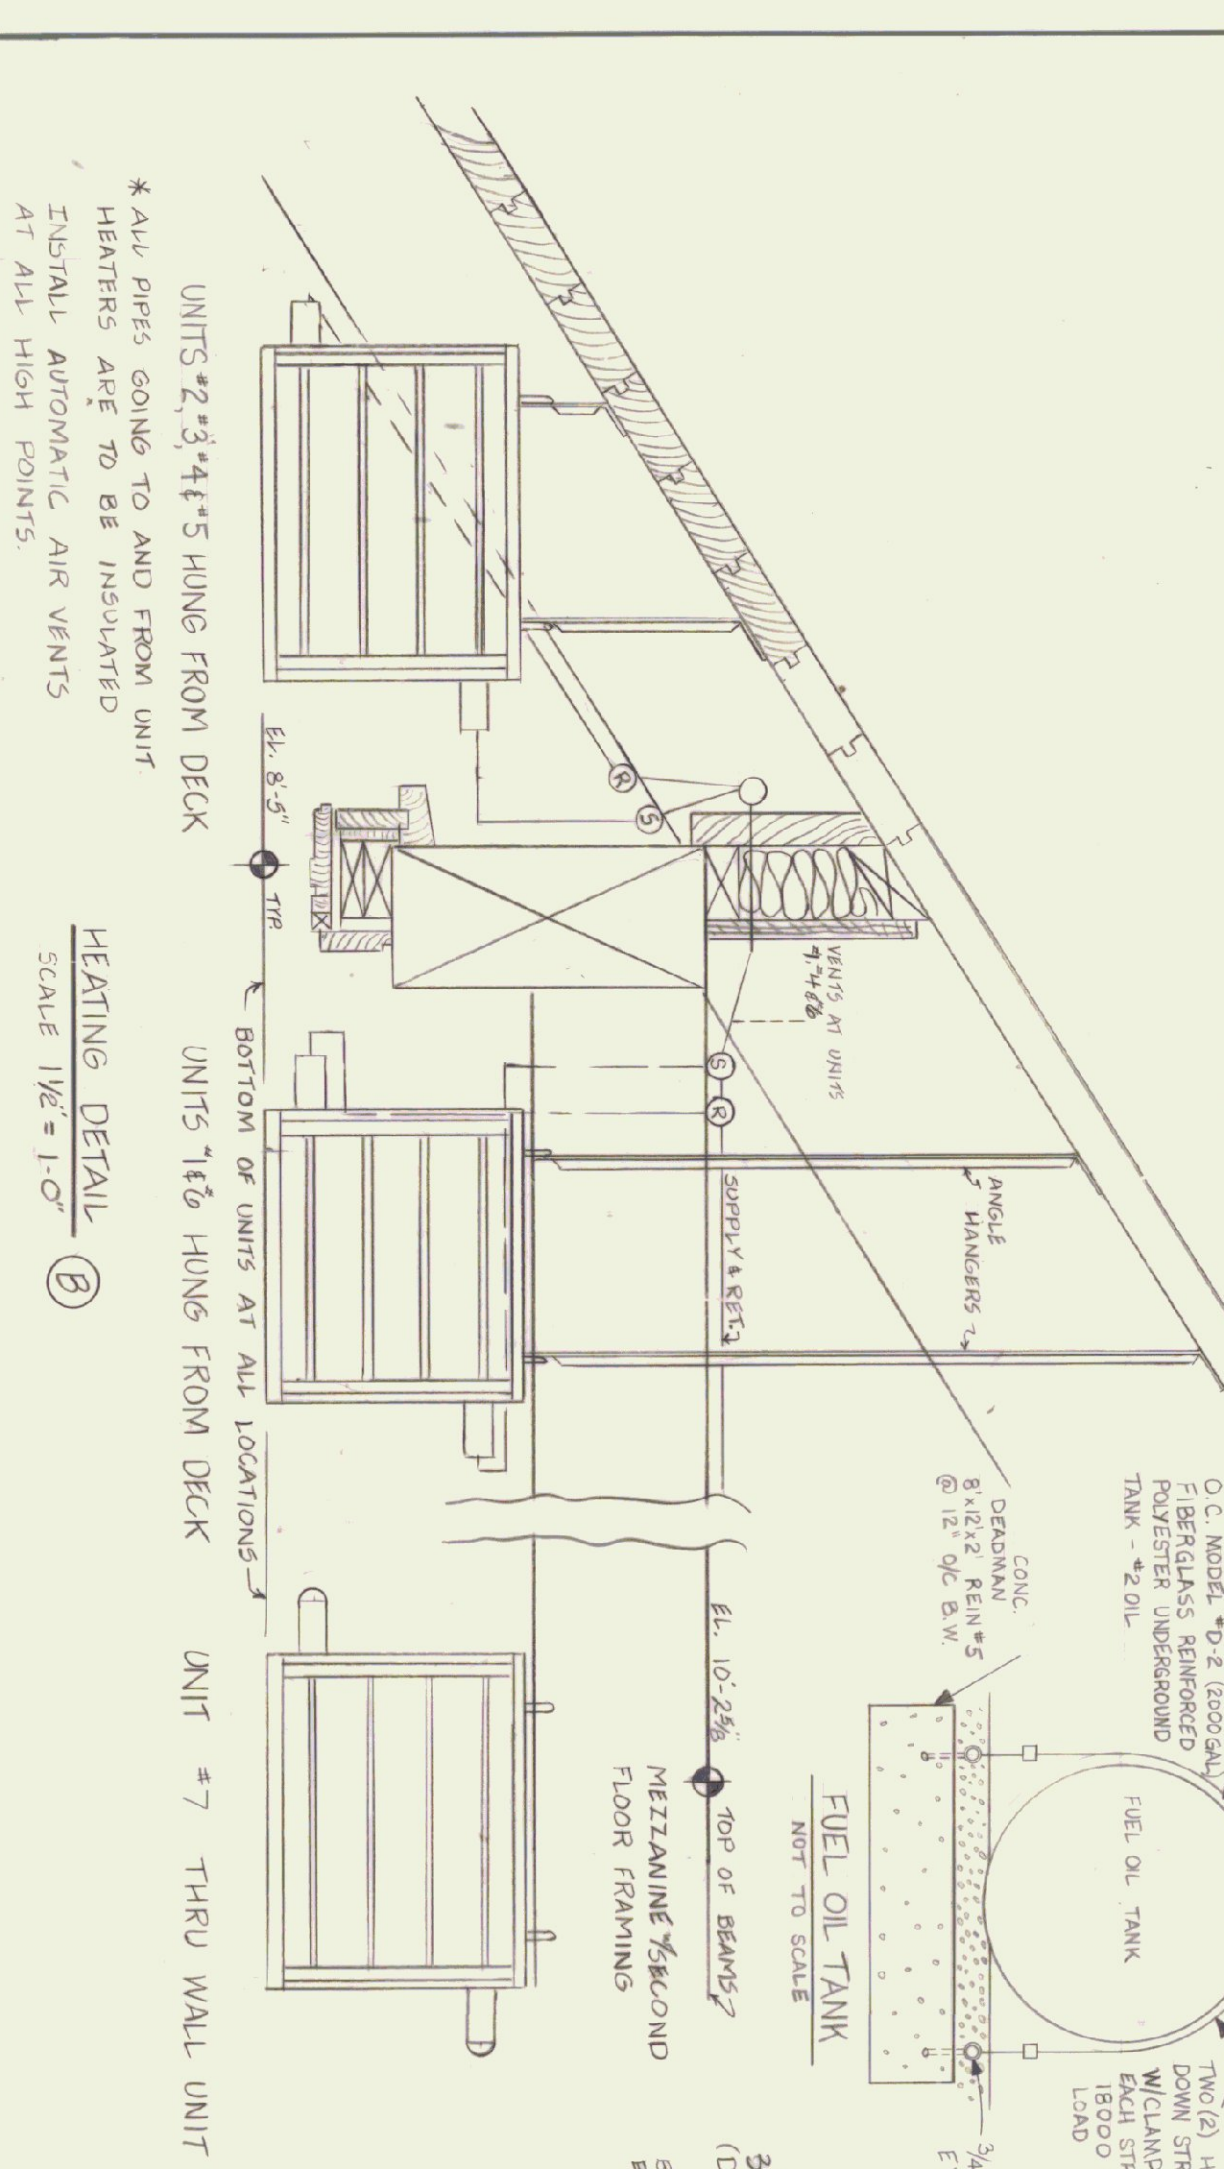


HEATING DETAIL

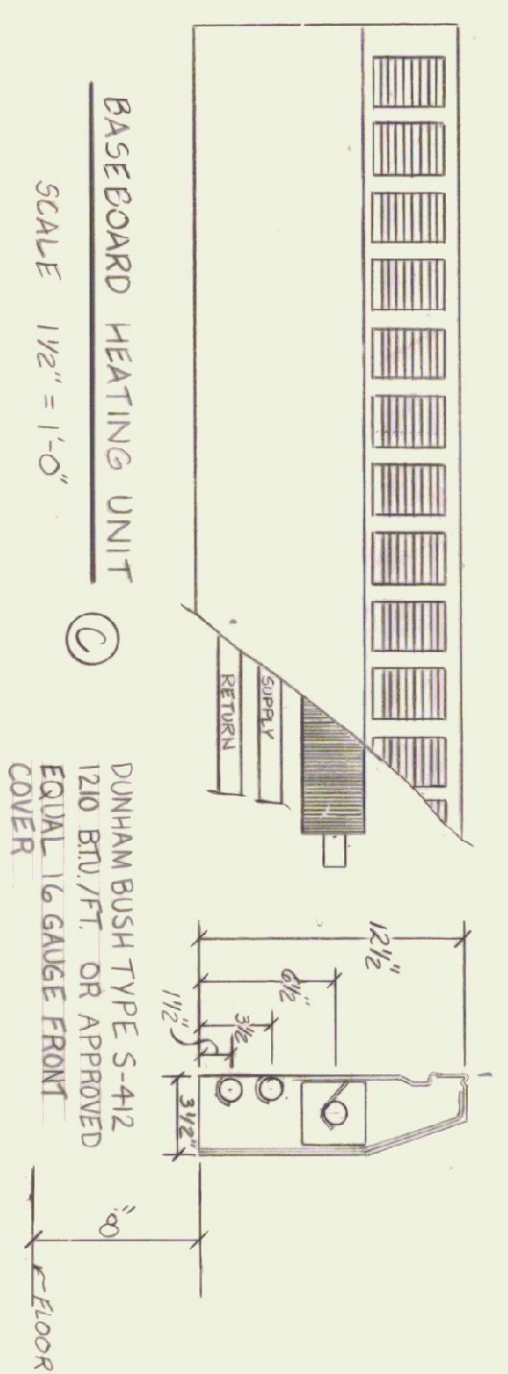


BASEBOARD HEATING UNIT

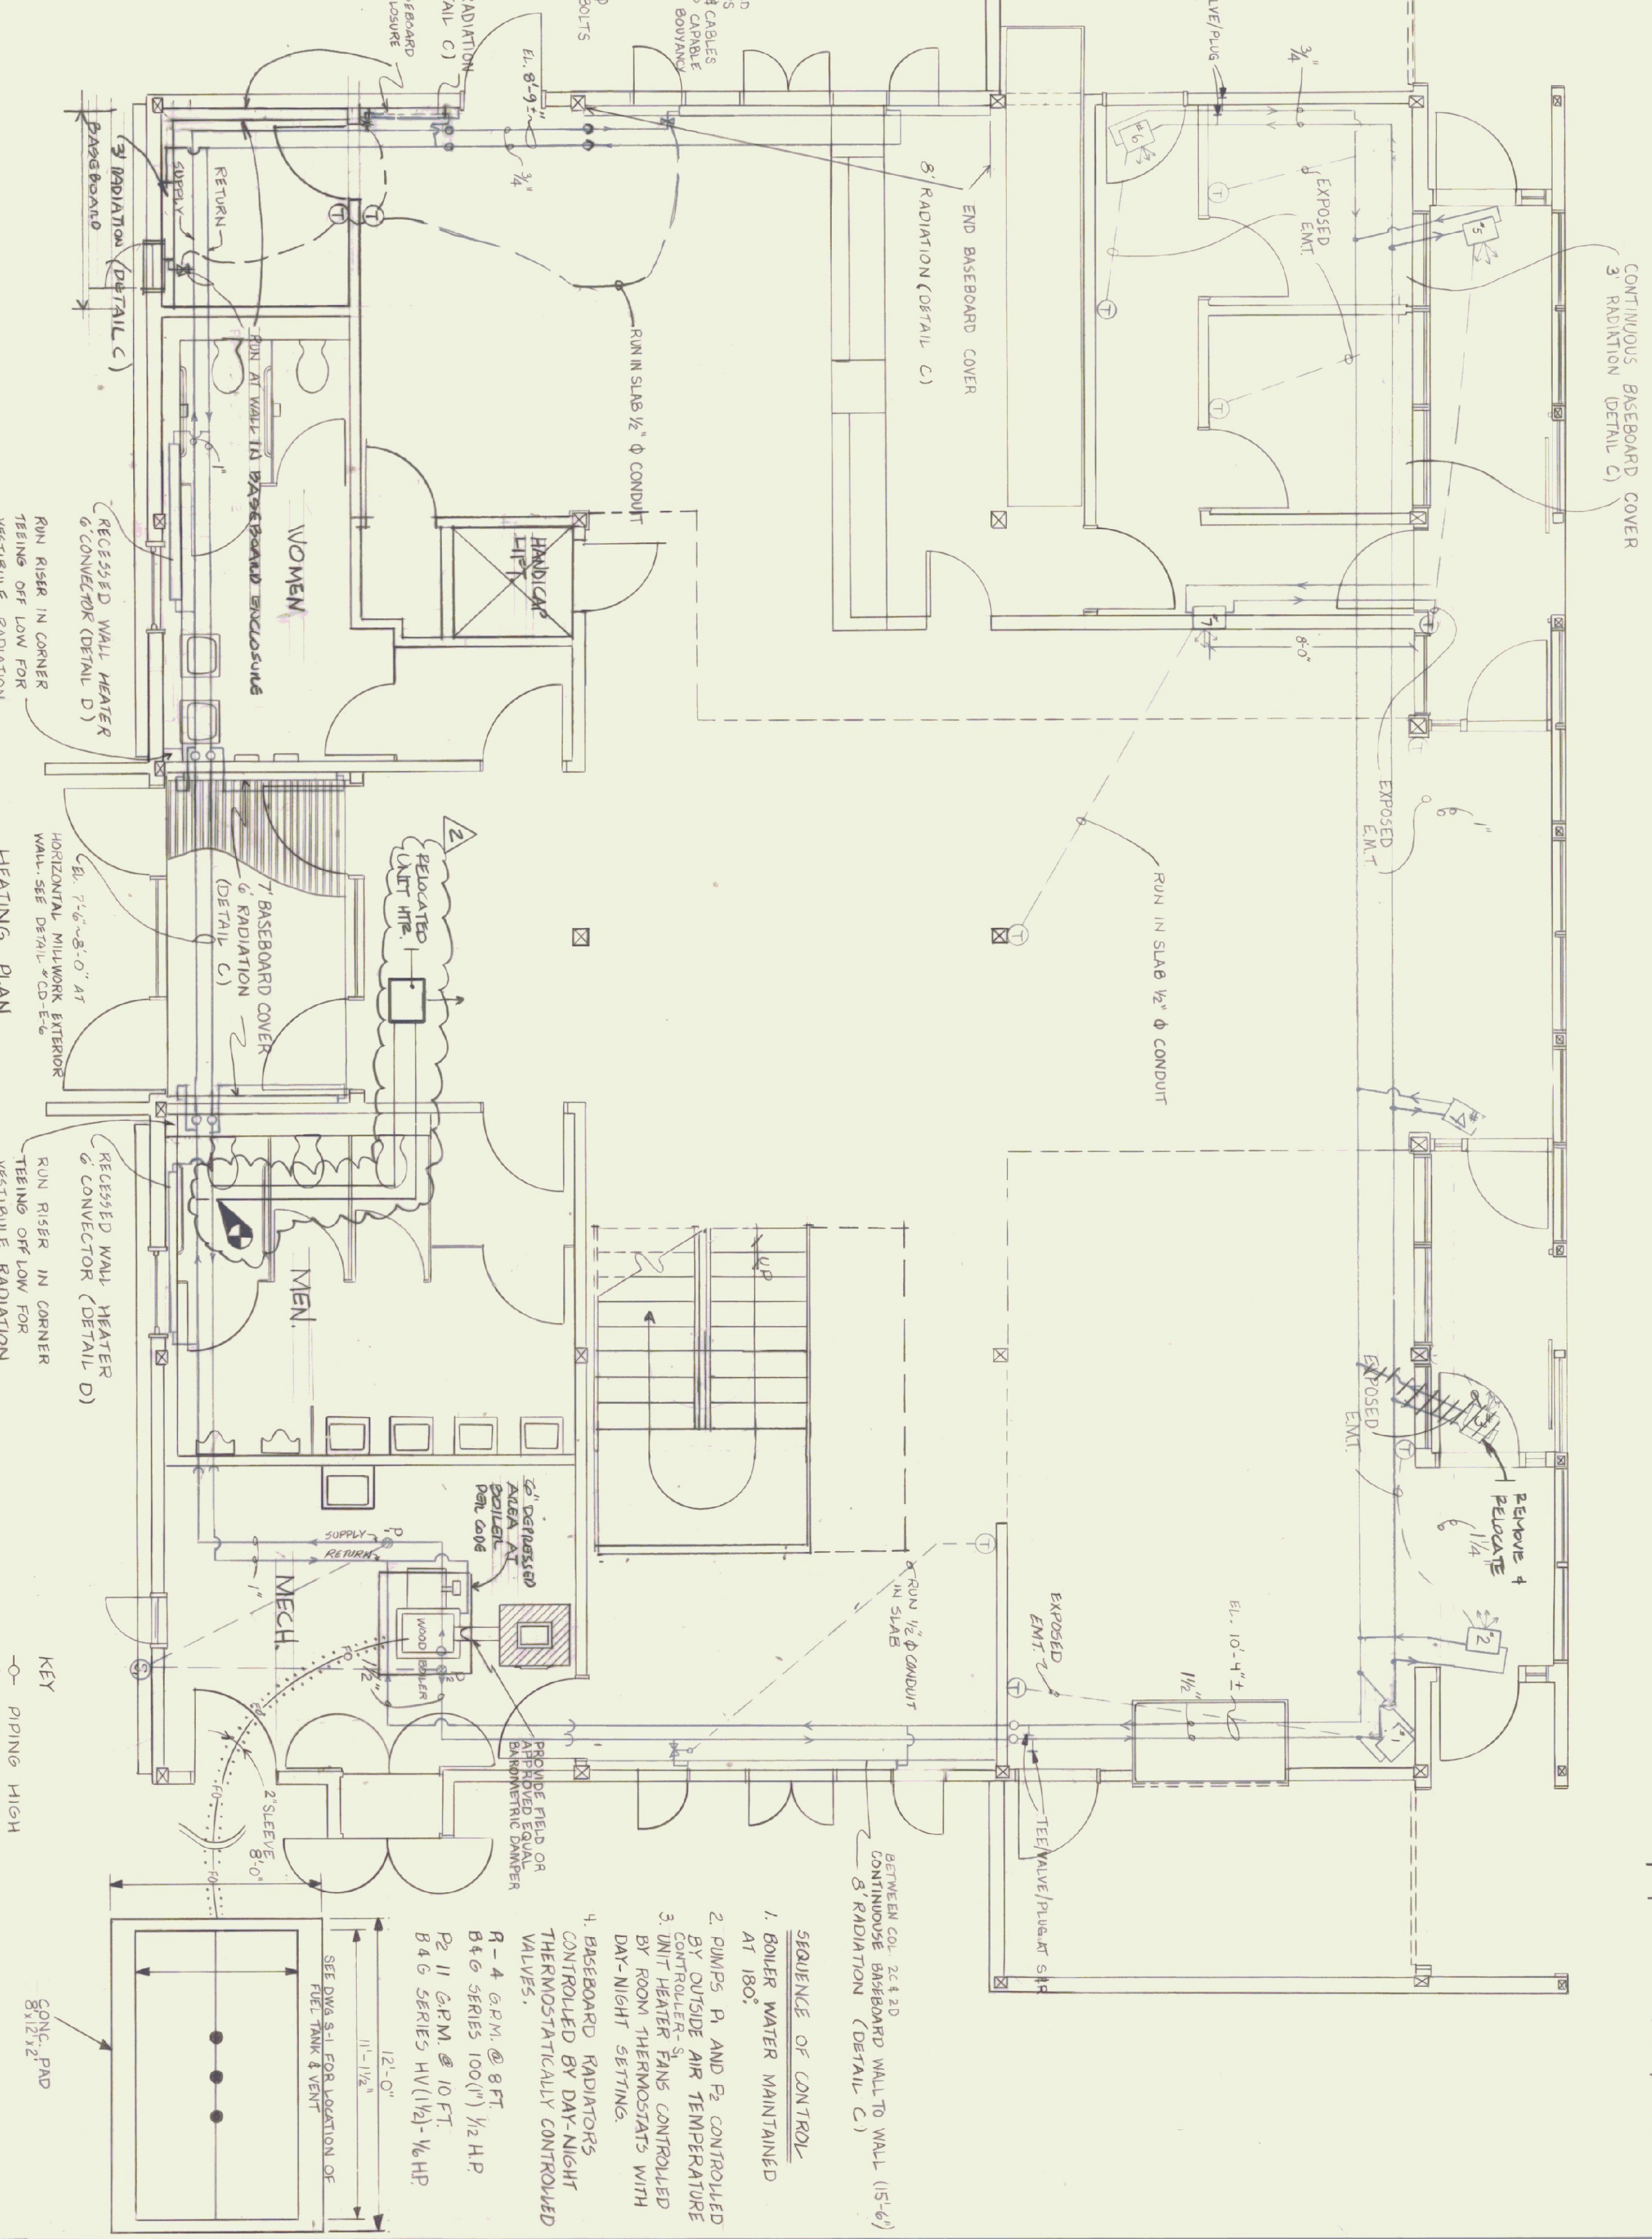

HEATING PLAN

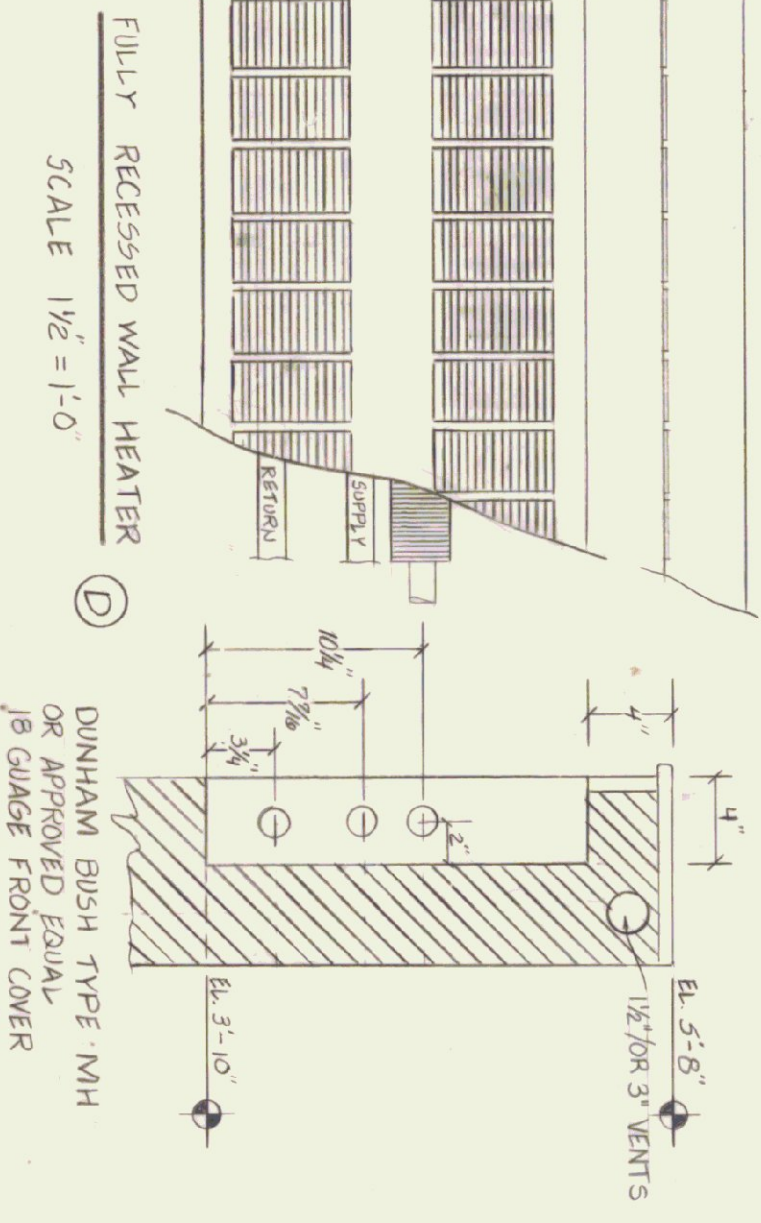


FULLY RECESSED WALL HEATER

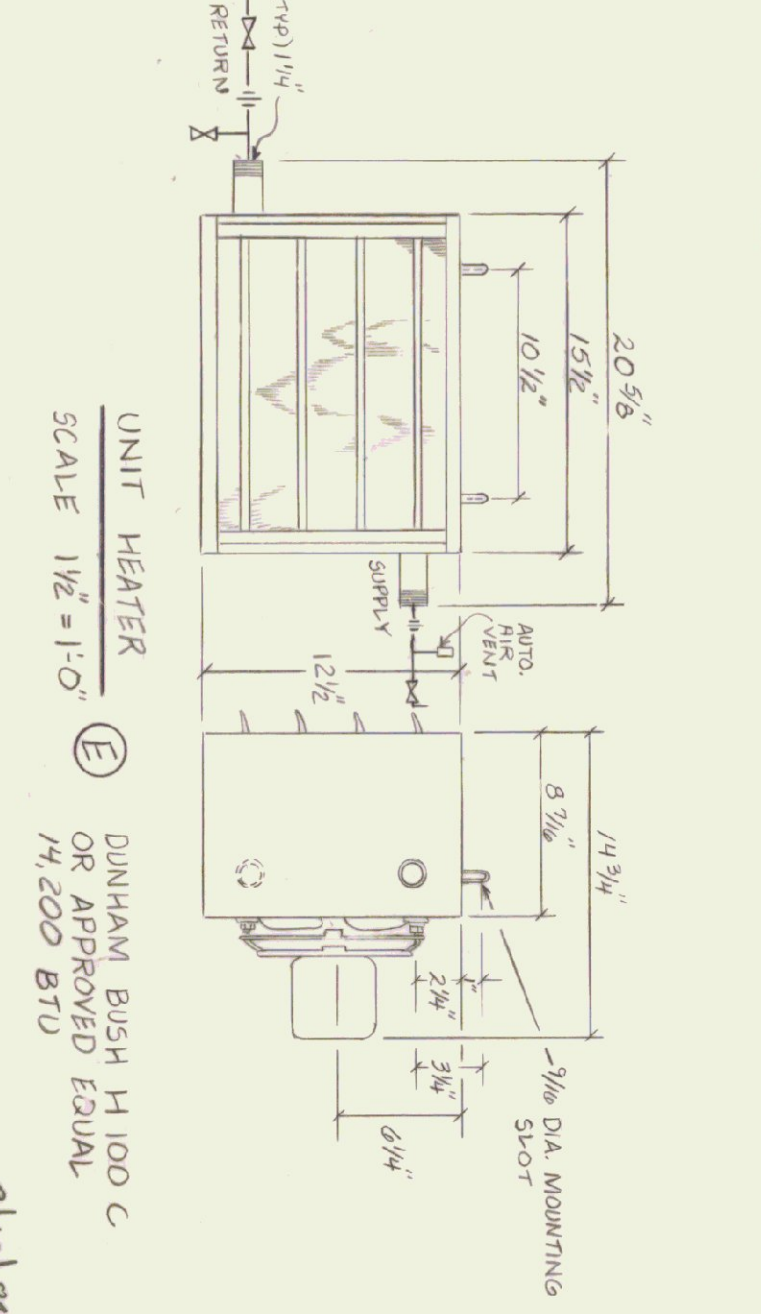

UNIT HEATER

STATE OF VERMONT	
DIVISION OF STATE BUILDINGS	
AGENCY OF ADMINISTRATION	
MONTPELIER, VERMONT	
RUTLAND TERMINAL BUILDING AIR 23-2024	
HEATING PLAN	
CLARENDON, VERMONT	
DATE: 6/8/84	SCALE: 1/2" = 1'-0"
DRAWN BY: AS NOTED	APPROVED BY: 10-30-84
REVISIONS: 10-30-84	16 OF 20


ISSUE RECORD			NO.
NO.	DATE	DESCRIPTION	BY
1	12/1/84	REVISIONS SINK 300-1600/1616-1	FOR
2	1/20/85	DO NOT OPEN TROUSERS IN FRONT OF OTHERS	2
3	1/20/85	DO NOT OPEN TROUSERS IN FRONT OF OTHERS	7

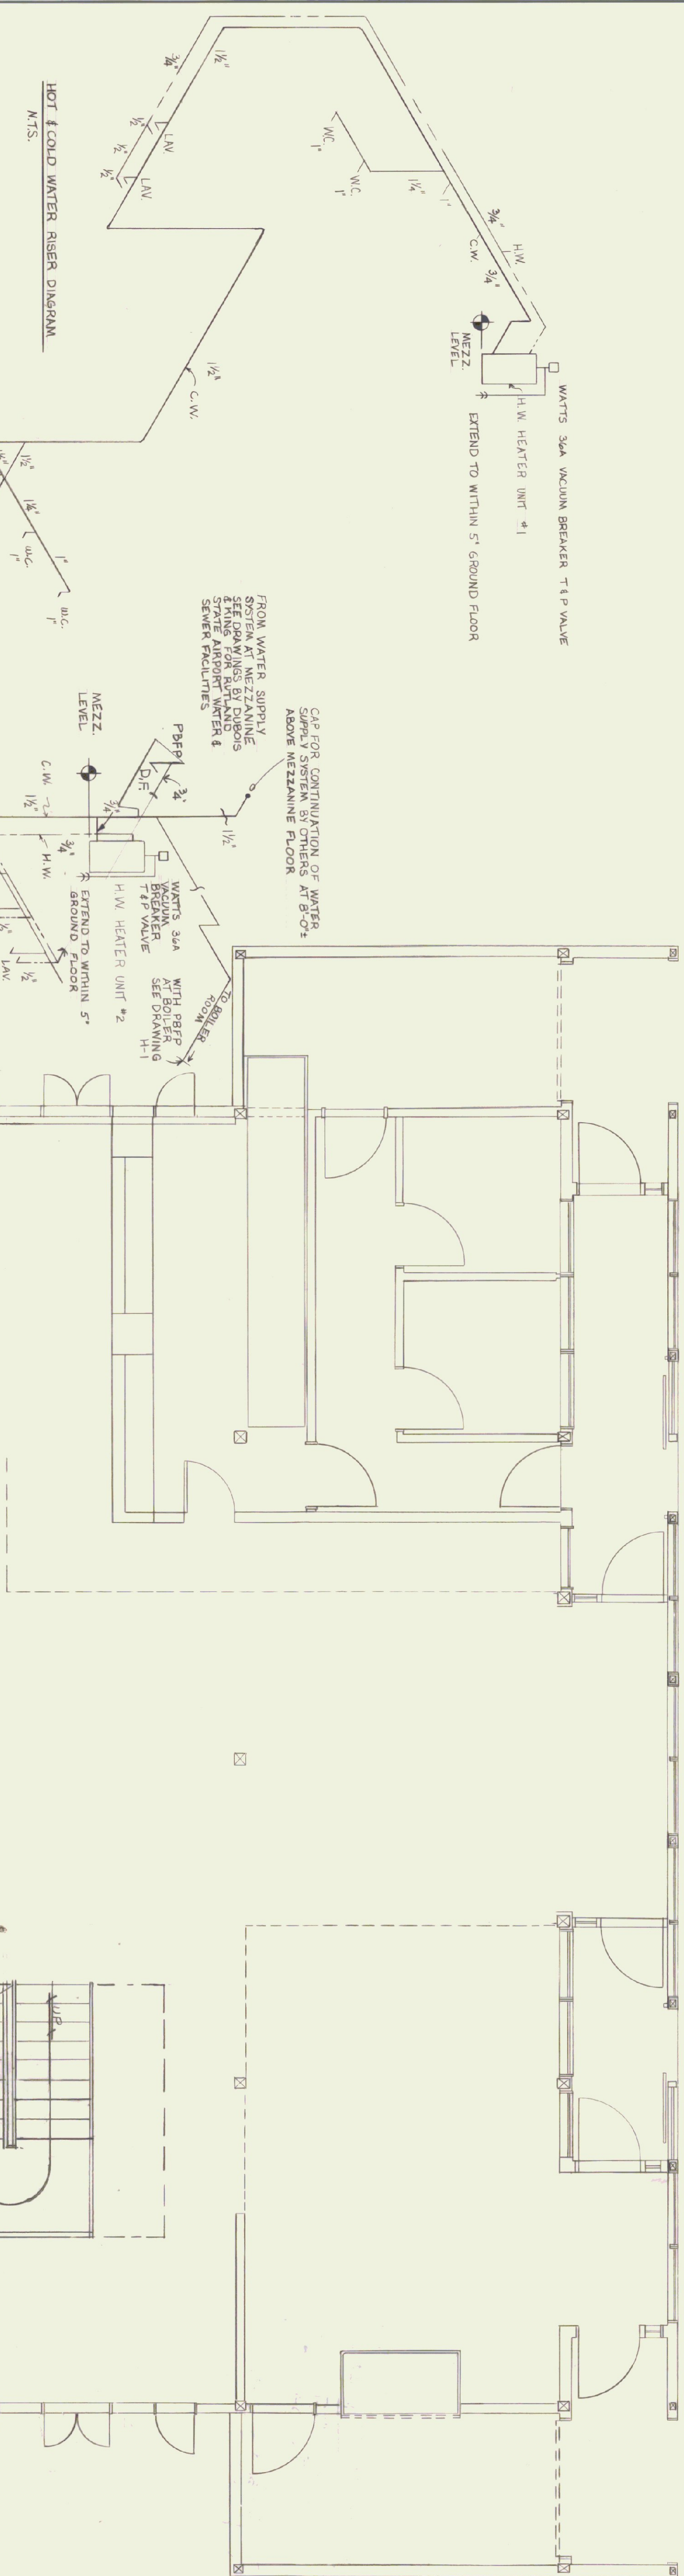

HOT & COLD WATER RISER DIAGRAM
N.T.S.

SANITARY WASTE & VENT RISER DIAGRAM
N.T.S.

PLUMBING FIXTURE SCHEDULE		
FIXTURE	MFR	NAME/NO./COLOR
WATER CLOSET	AM STD	WATER SNIER AF WALL 2472 016
URINAL	AM STD	WASHBROOK 6501010 WHITE
LAVATORY	AM STD	CONRAD 20-18 0124131 CONCEALED ARMS WHITE
SERVICE SINK	AM STD	AKRON 2-4 20 R-36-316 WBS79026 FIN GRIND
DRINKING FOUNTAIN	ELAVY	
WATER HEATER	1 1/2 GAL. 230V	1500W 120V 4500W 230V

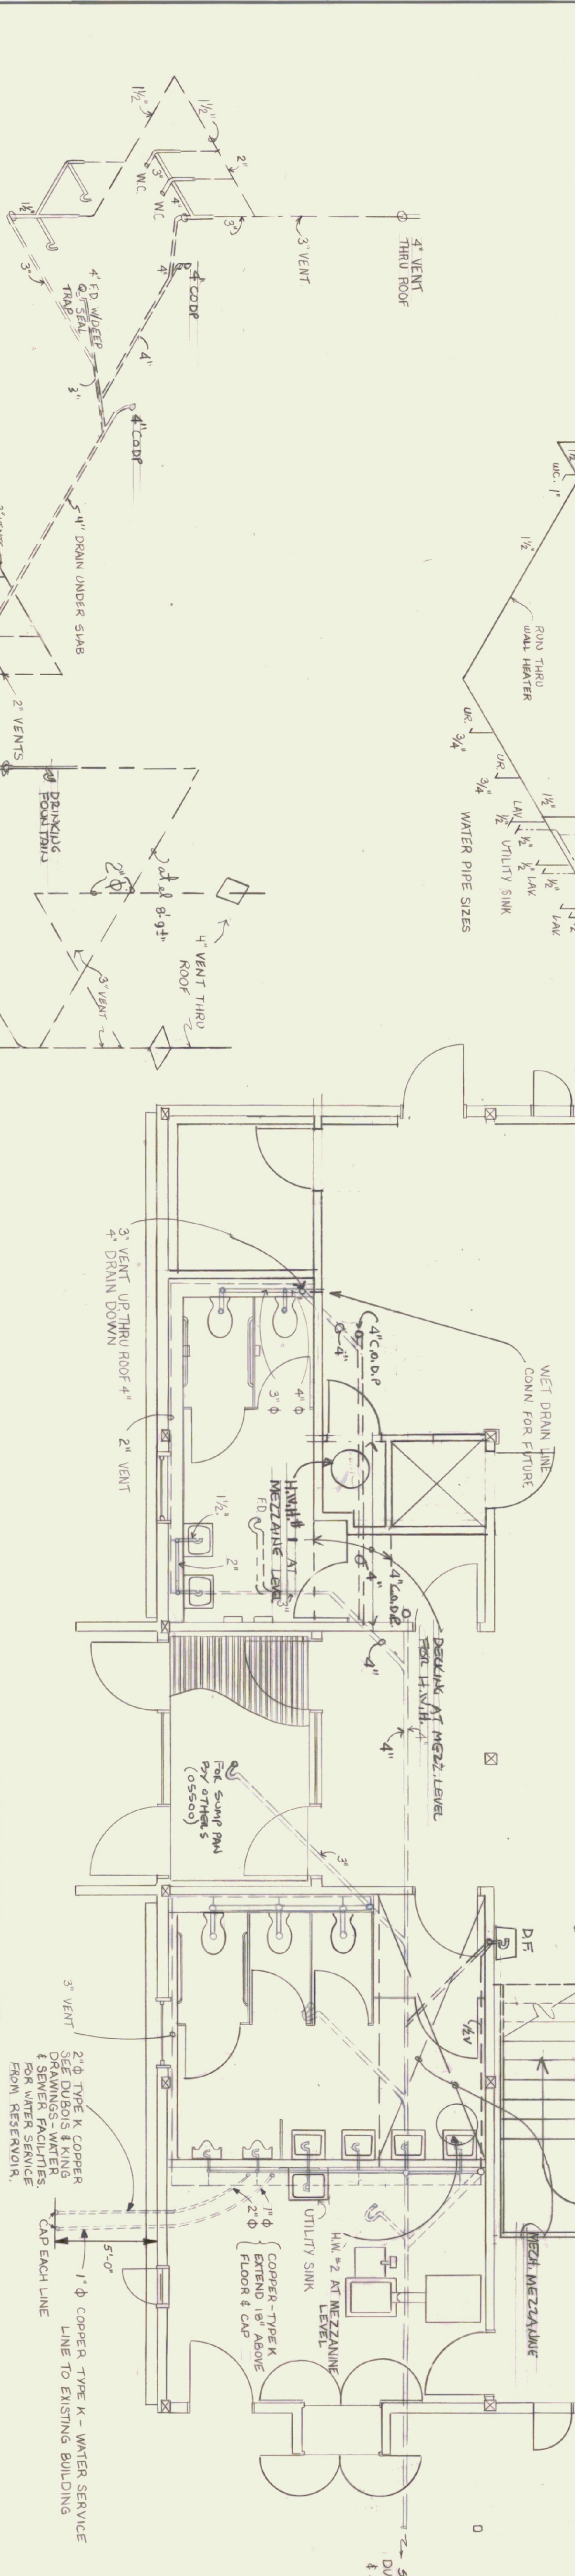


STATE OF VERMONT
DIVISION OF STATE BUILDINGS
AGENCY OF ADMINISTRATION
VERMONT

RUTLAND TERMINAL BUILDING AIR 23-2024
PLUMBING PLAN
RUTLAND STATE AIRPORT
CLARENDON, VERMONT

DATE: 6/8/84
DRAWN BY: 88/84 S.A. MULLER
R.B.T. 1/10/84 M. HICKEY

SCALE: 1/4" = 1'-0"
REVISIONS: 10-30-84
DWG. NO.: P-1
17 OF 20

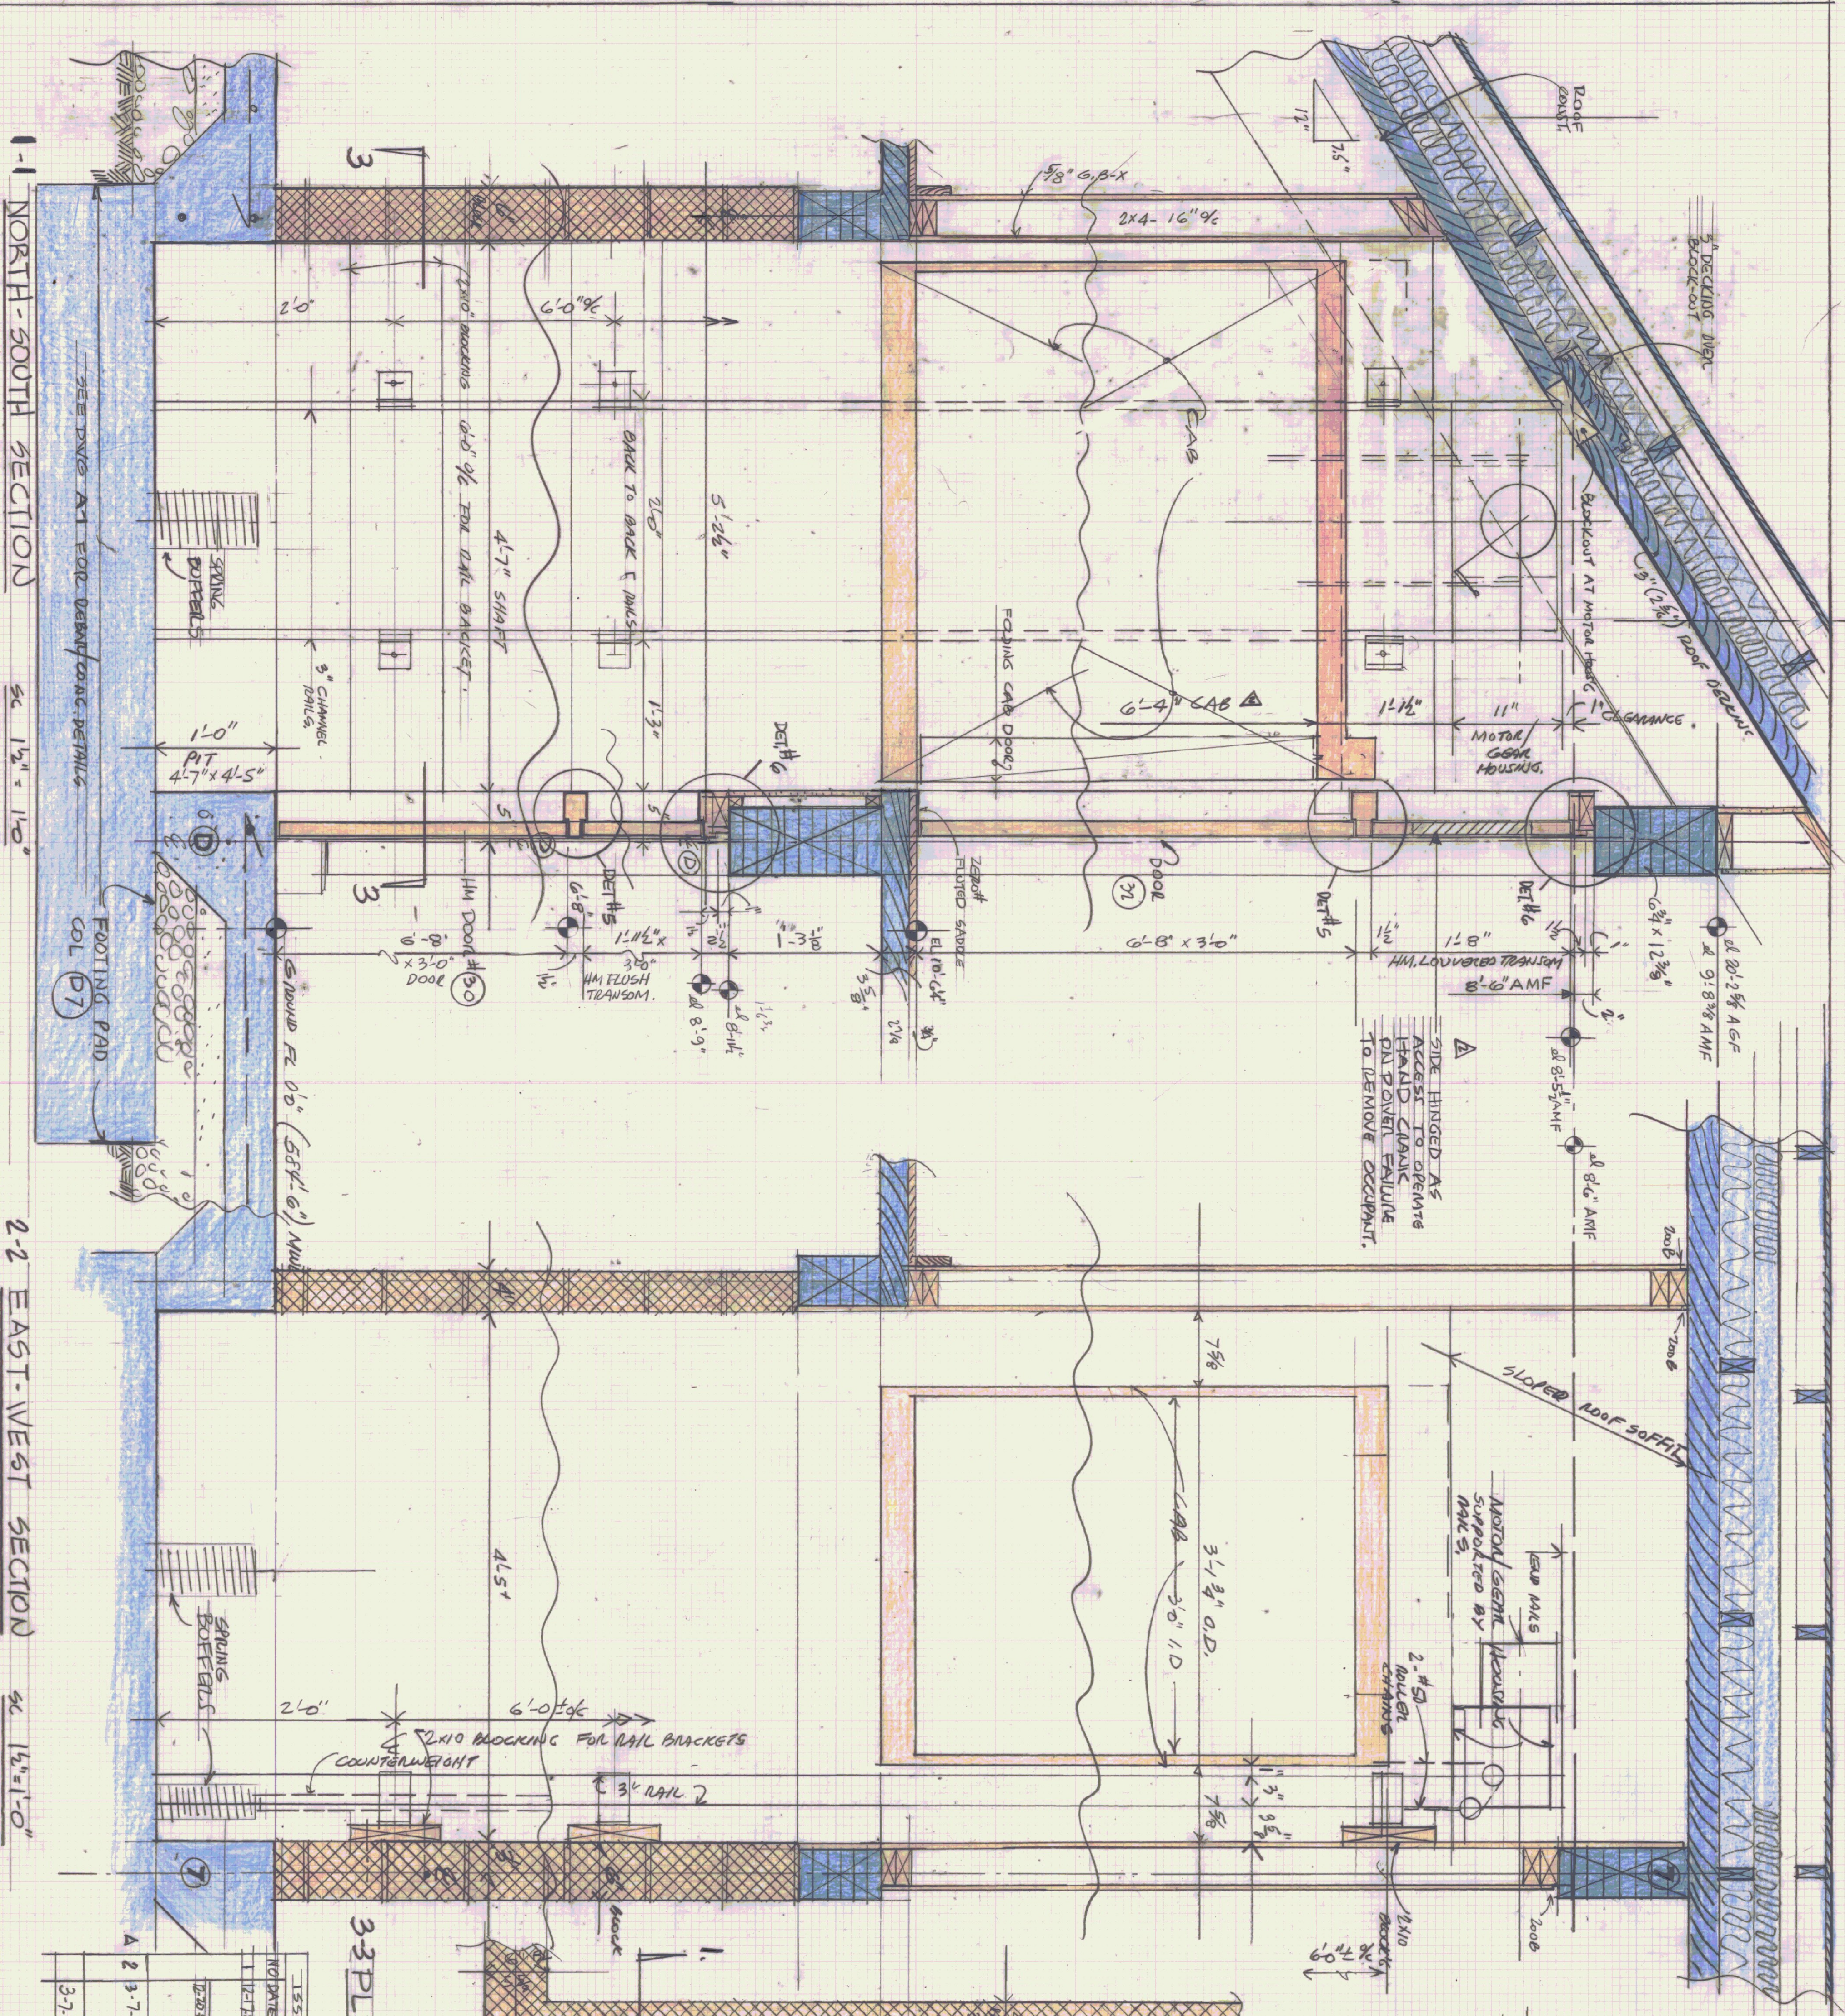

1-1 NORTH-SOUTH SECTION

SC 1 1/2" = 1'-0"

2-2 EAST-WEST SECTION

SC 1 1/2" = 1'-0"

ISSUE RECORD			STATE OF VERMONT		
NO	DATE	DESCRIPTION	NO	DATE	DESCRIPTION
1	11-27-84	DESIGN	1	11-27-84	DESIGN
2	3-7-85	REVISED FOR L&I	2	3-7-85	REVISED FOR L&I
3	3-7-85	REVISED FOR L&I	3	3-7-85	REVISED FOR L&I
4	3-7-85	REVISED FOR L&I	4	3-7-85	REVISED FOR L&I
5	3-7-85	REVISED FOR L&I	5	3-7-85	REVISED FOR L&I
6	3-7-85	REVISED FOR L&I	6	3-7-85	REVISED FOR L&I
7	3-7-85	REVISED FOR L&I	7	3-7-85	REVISED FOR L&I
8	3-7-85	REVISED FOR L&I	8	3-7-85	REVISED FOR L&I
9	3-7-85	REVISED FOR L&I	9	3-7-85	REVISED FOR L&I
10	3-7-85	REVISED FOR L&I	10	3-7-85	REVISED FOR L&I


STATE OF VERMONT
DEPARTMENT OF STATE BUILDINGS
AGENCY OF ADMINISTRATION
MONTPELIER, VERMONT

RUTLAND TERMINAL BUILDING, AIR 23-2024
VERTICAL LIFT: HANDICAPPED
CLARENDON, VERMONT

DATE: 11-27-84
DRAWN BY: M. R. D. S. B.
APPROVED BY: M. R. D. S. B.
SCALE: AS SHOWN
REVISIONS: A-8

3-3 PLAN @ GROUND LEVEL

SC 1 1/2" = 1'-0"

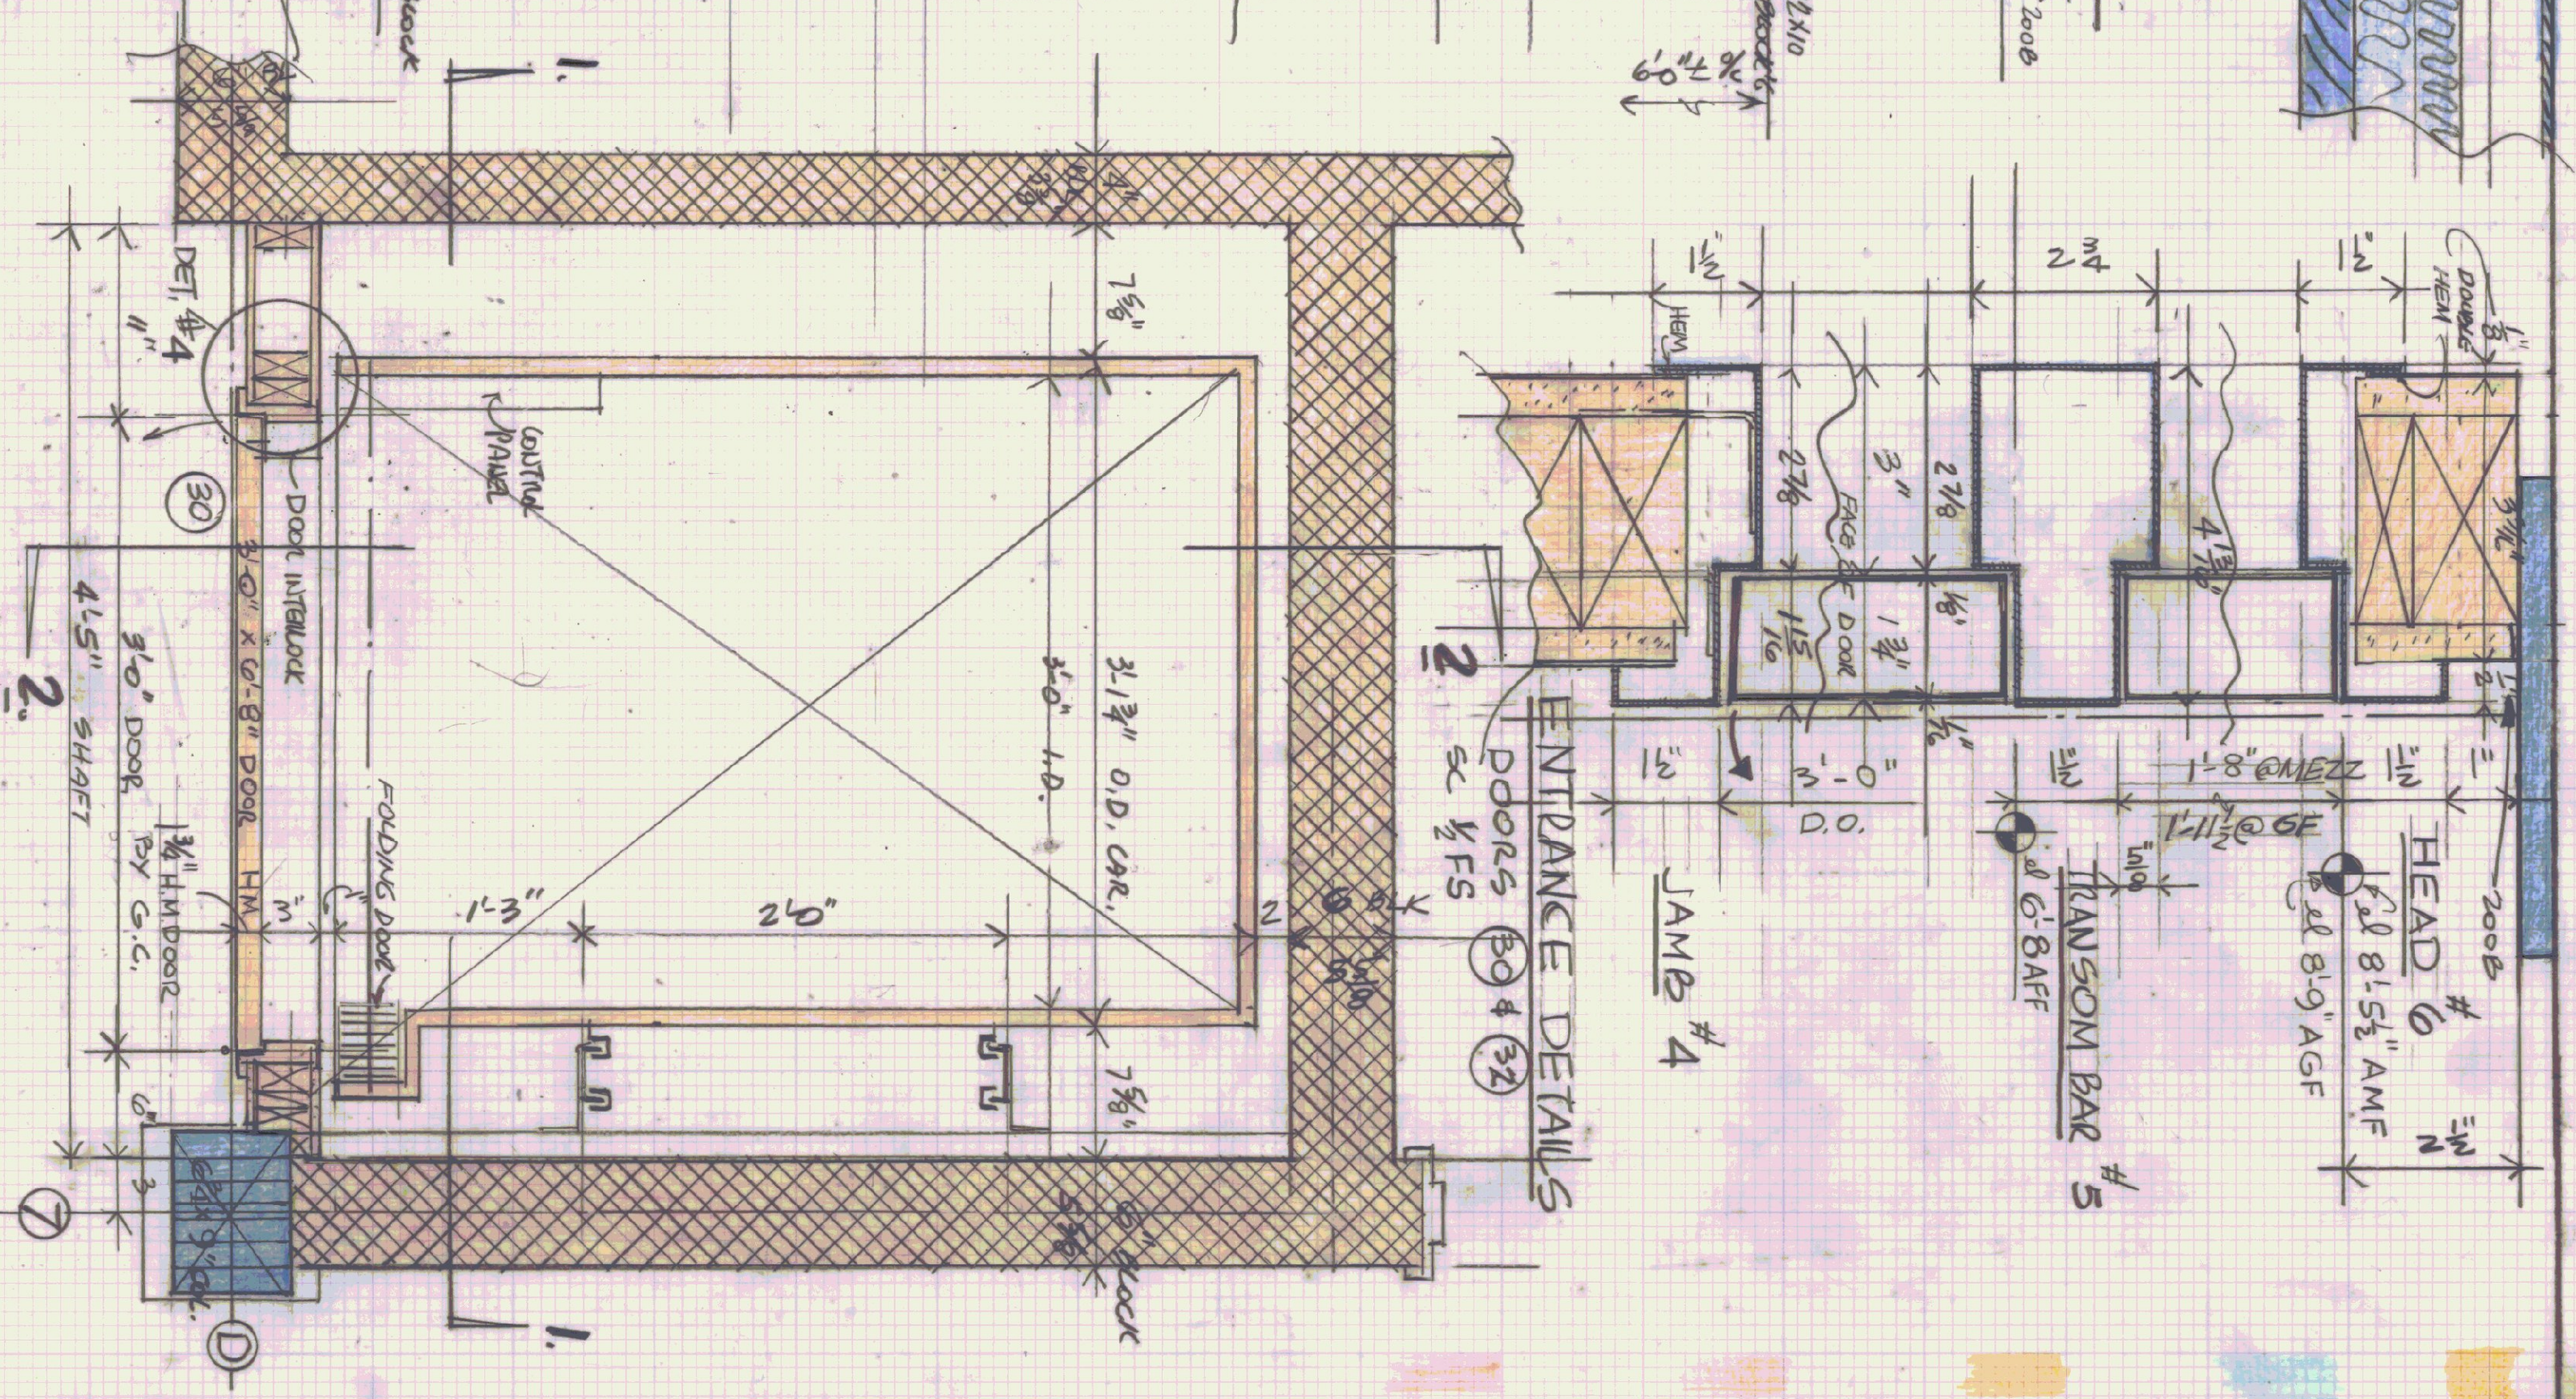


ENTRANCE DETAILS

DOORS #3 & #4

SC 1/8" = 1'-0"

ISSUE RECORD		
NO.	DATE	DESCRIPTION
1	12/1/84	REVISIONS SIMPSON-REYNOLDS FOR A
2	12/28/84	AUT. ORIENTATION SIMPSON-REYNOLDS FOR A
7	10/10/84	REVISIONS SIMPSON-REYNOLDS FOR A

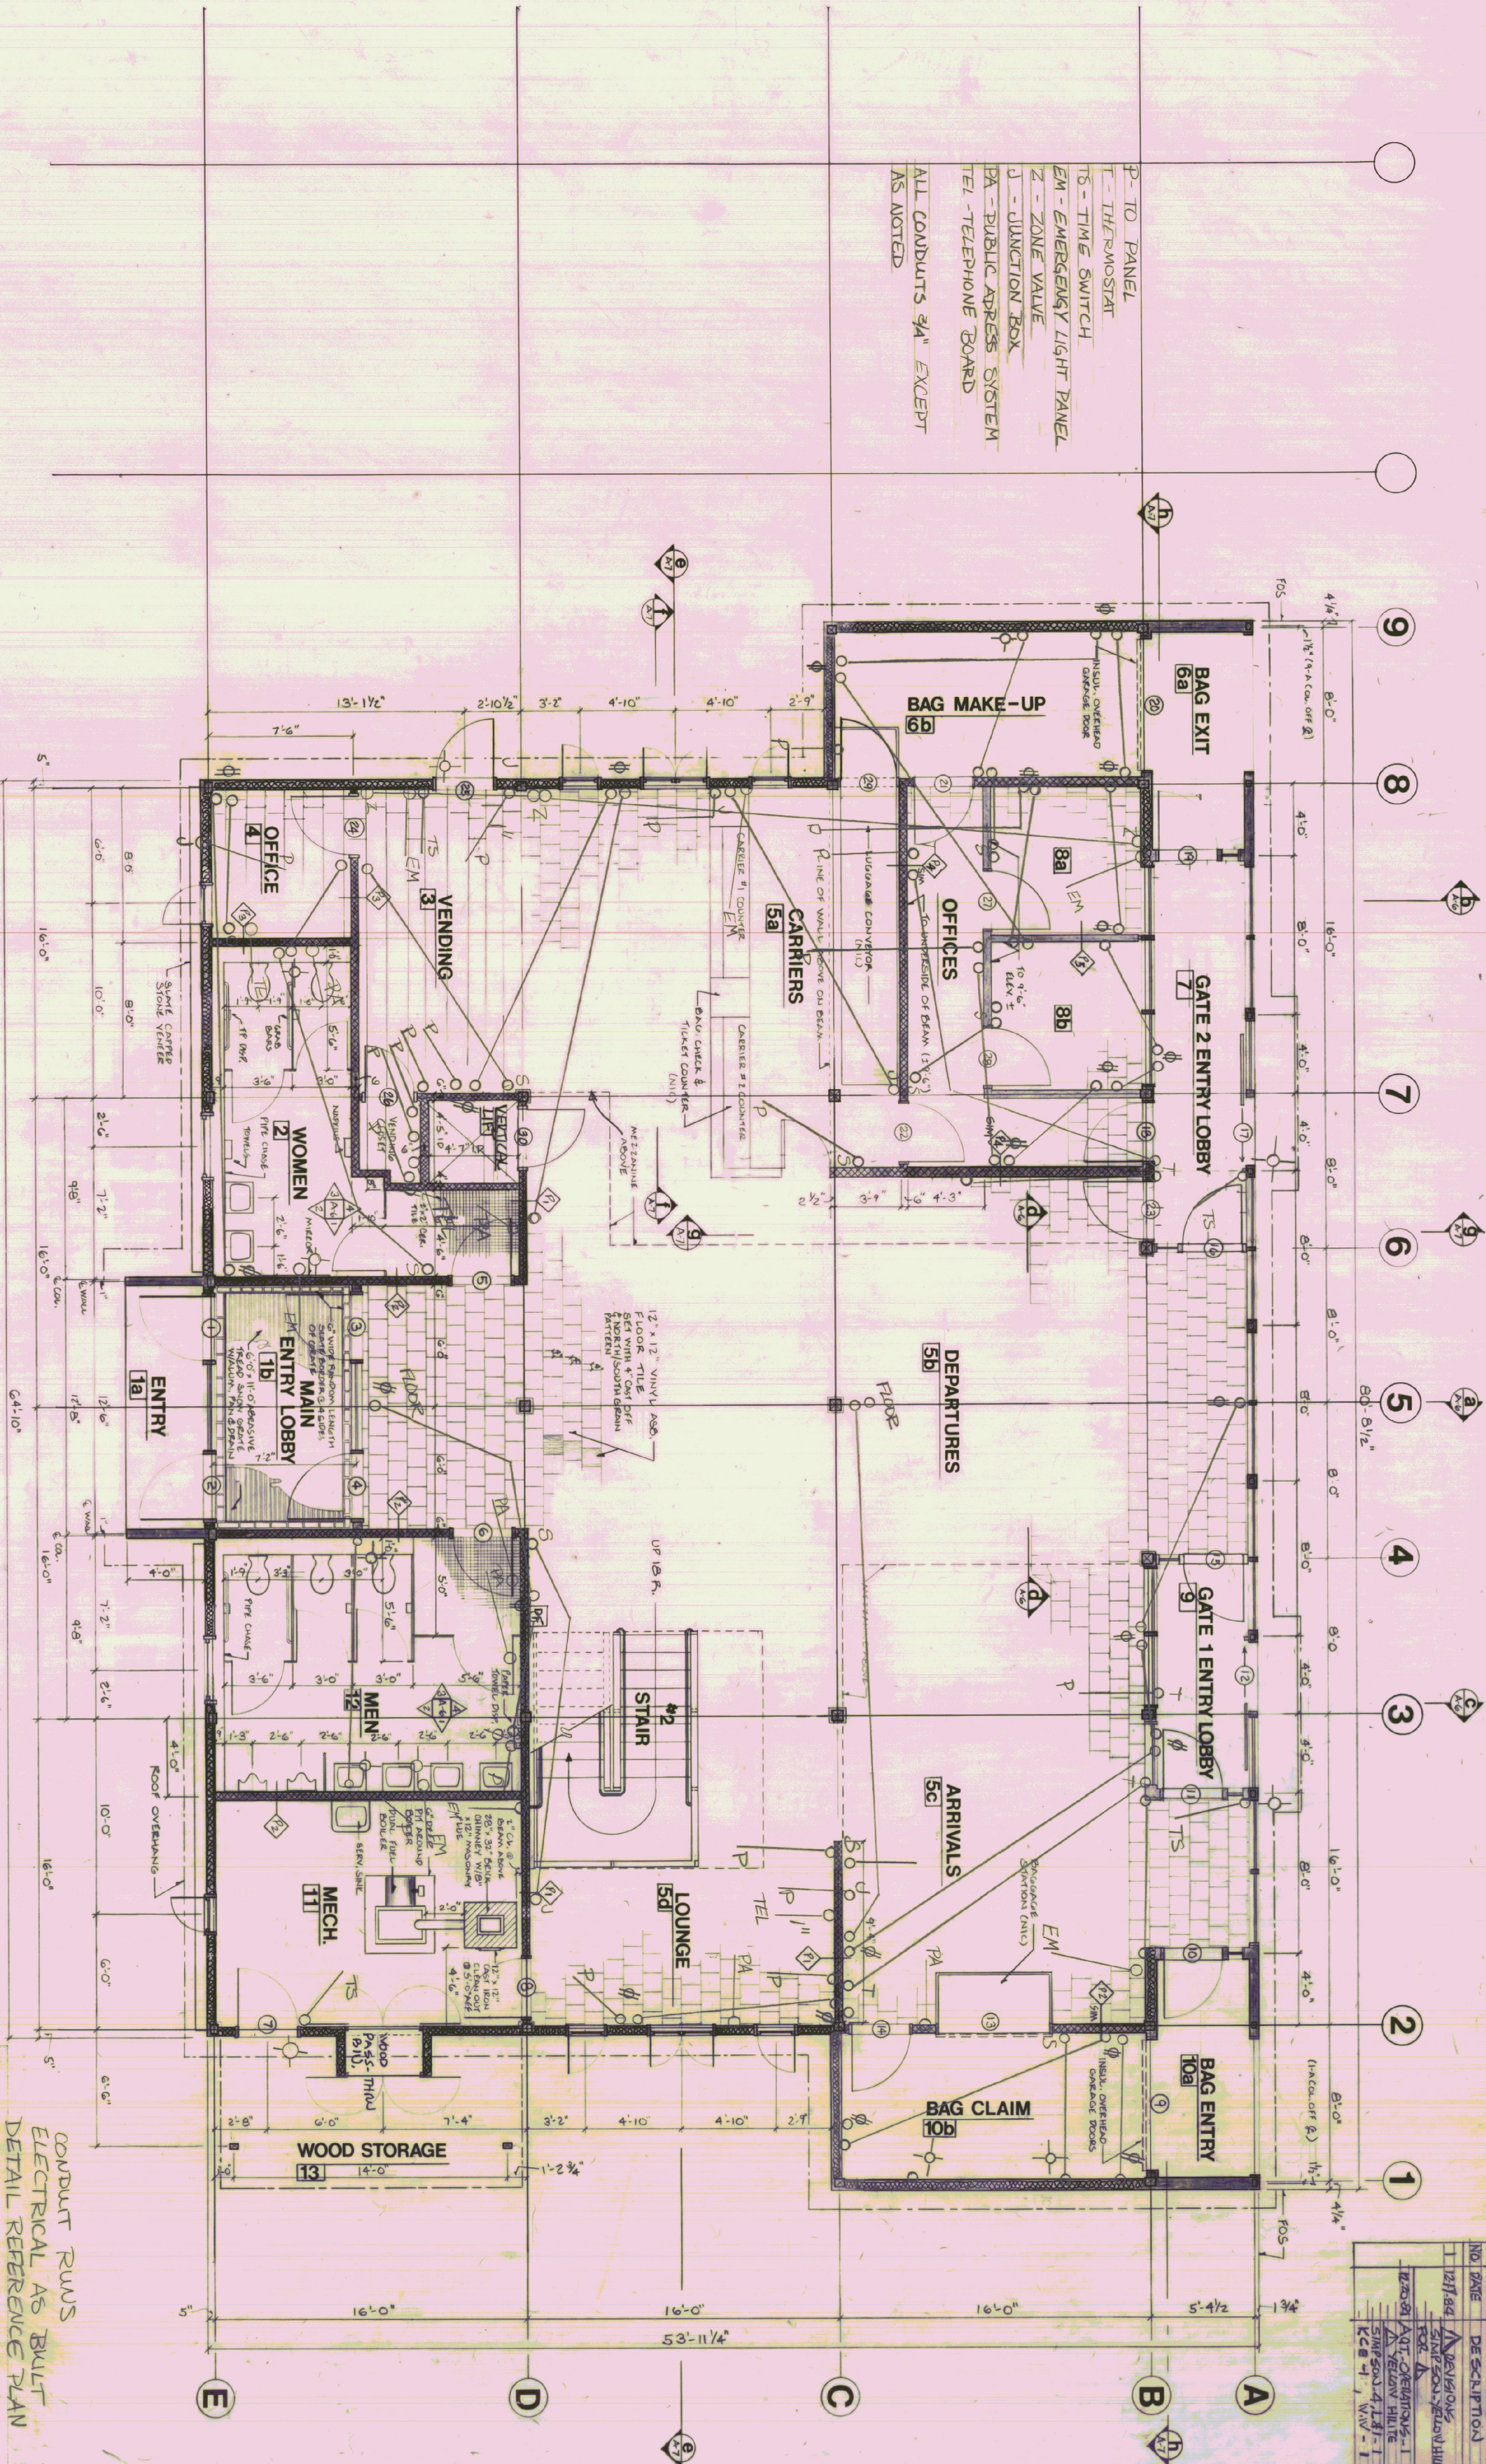


CONDUIT RUNS
ELECTRICAL AS BUILT
DETAIL REFERENCE PLAN

STATE OF VERMONT
DIVISION OF STATE BUILDINGS
AGENCY OF ADMINISTRATION
MONTPELIER, VERMONT

RUTLAND STATE AIRPORT
CLARENDON, VERMONT
FIRST FLOOR PLAN

DATE	SCALE	REVISIONS	DWG. NO.
6/18/84	1/4" = 1'-0"	78 894 S.A. MILLER	E-3
DRAWN BY:	APPROVED BY:		
10/16/84	10/16/84		21

[illegible]

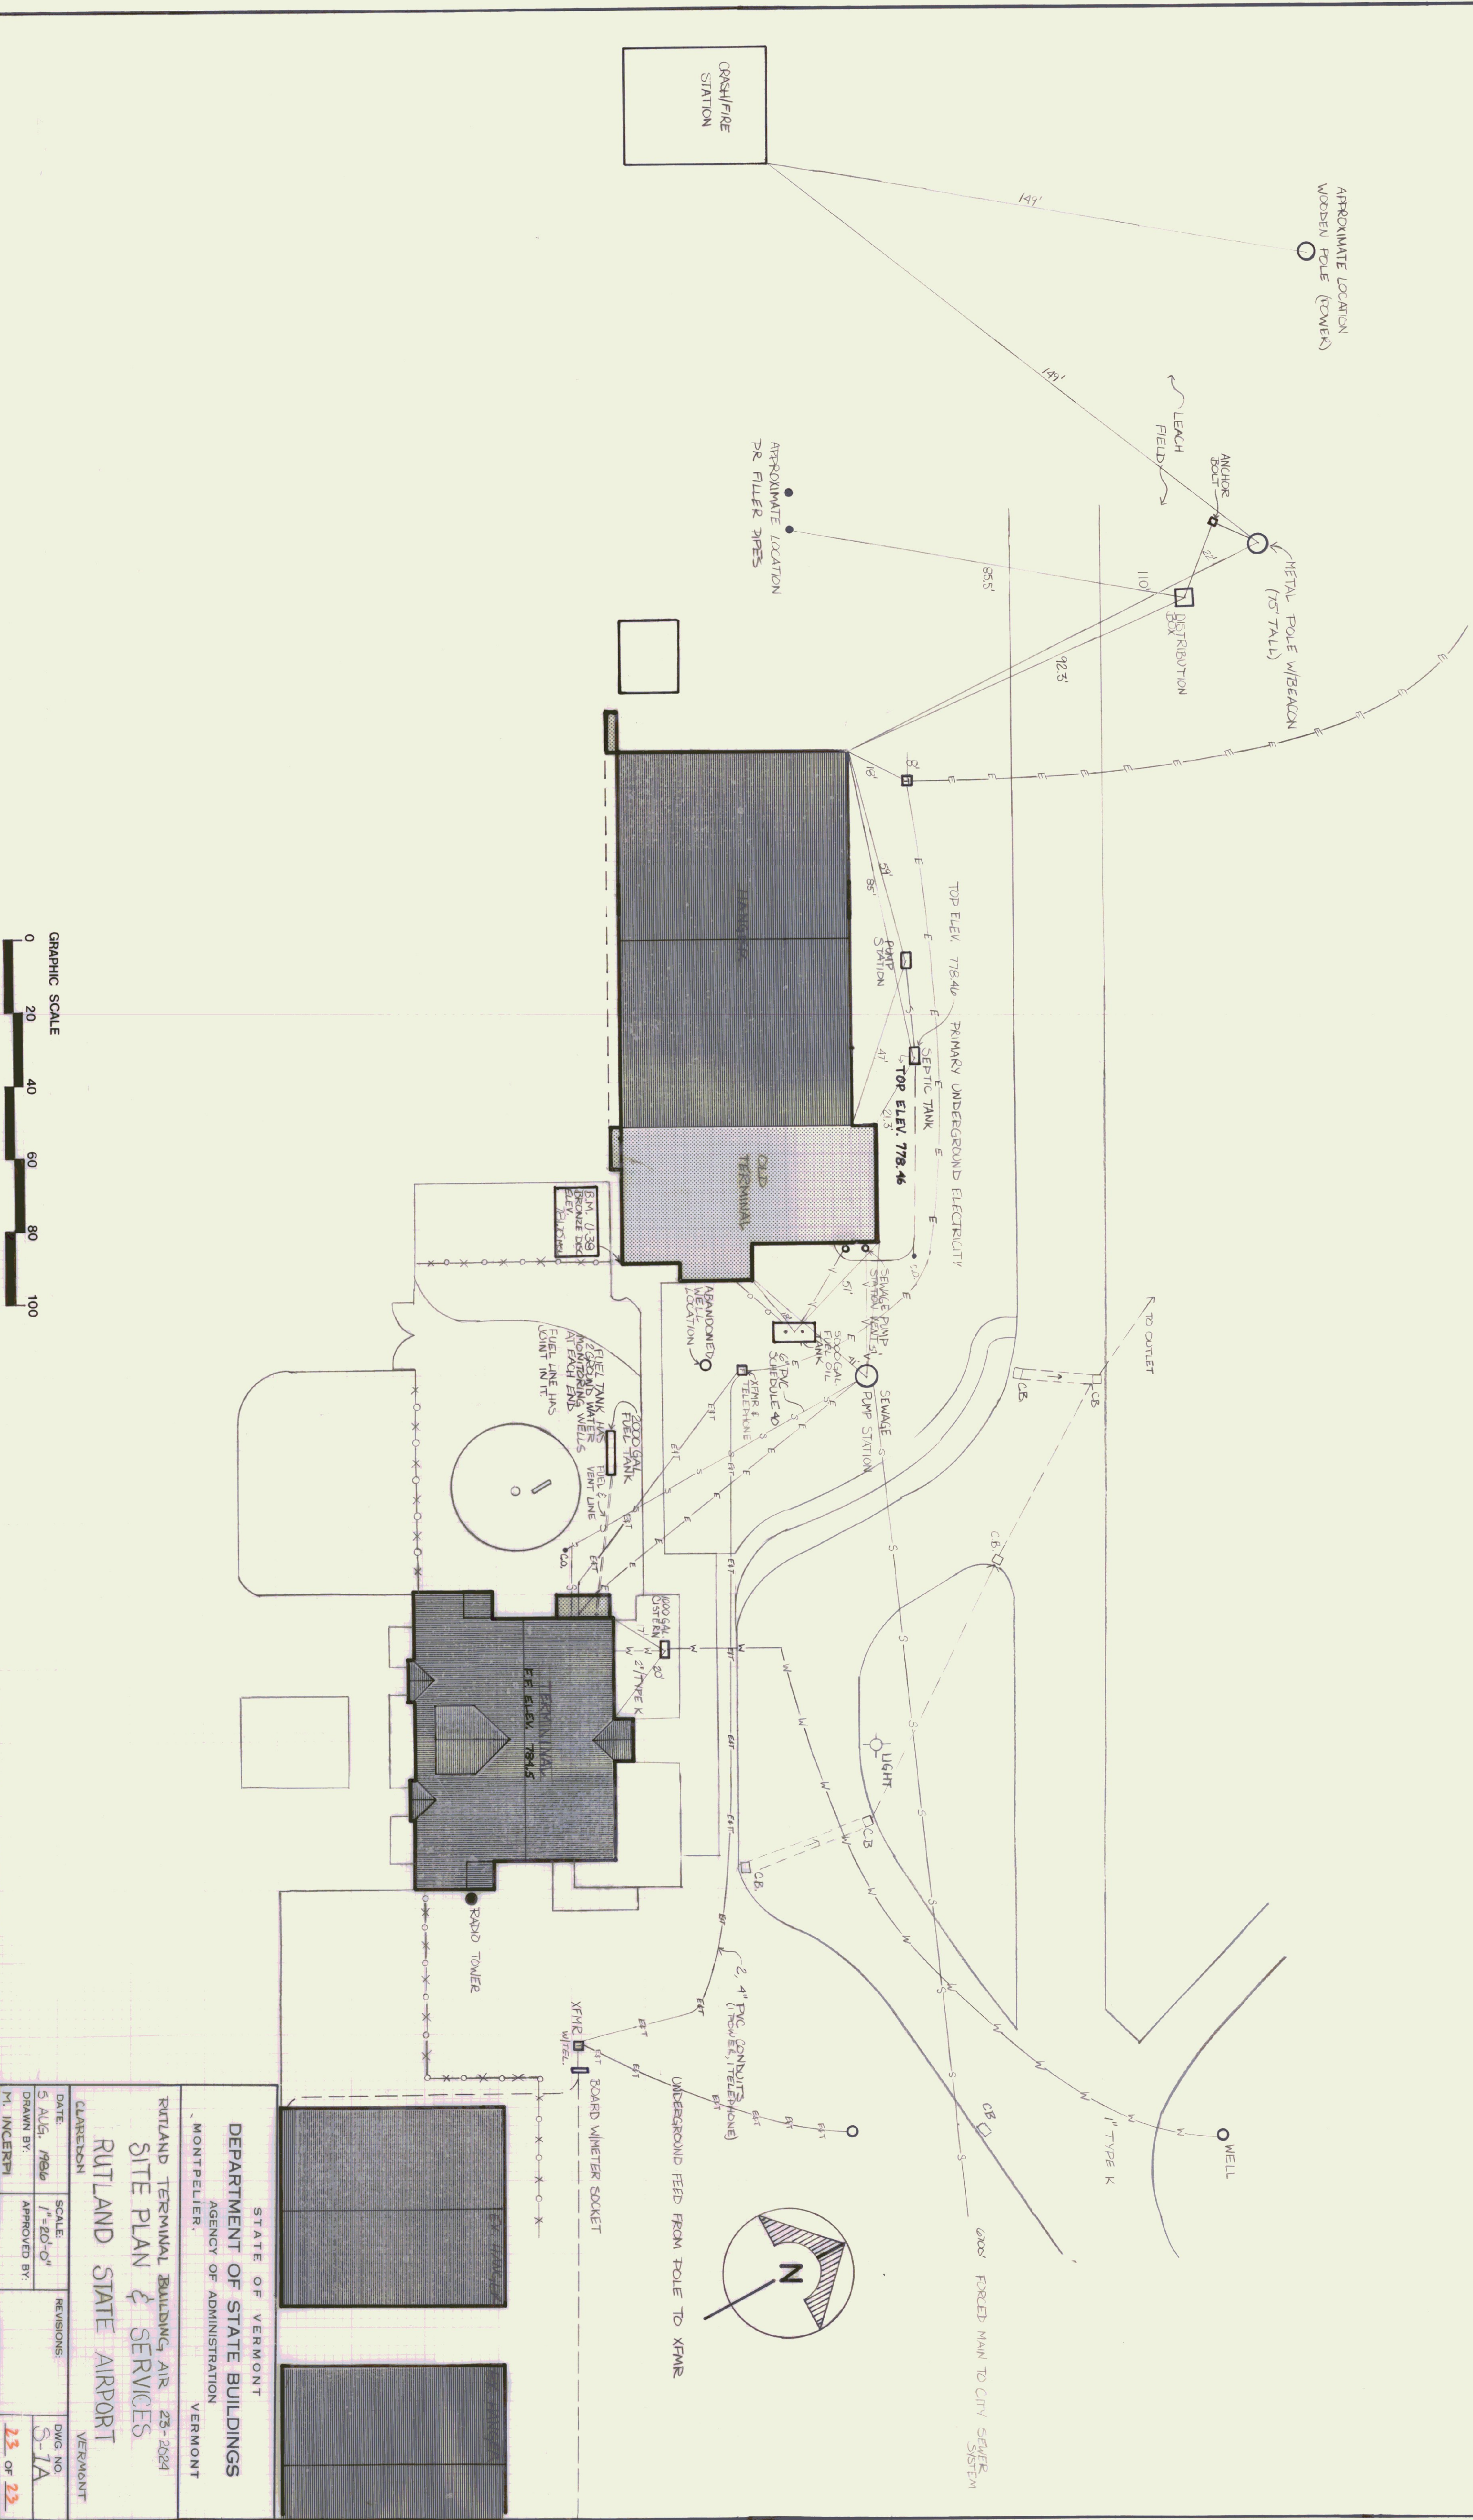

STATE OF VERMONT			
DEPARTMENT OF STATE BUILDINGS			
AGENCY OF ADMINISTRATION			
MONTPELIER, VERMONT			
RUTLAND TERMINAL BUILDING, AIR 23-2024			
SITE PLAN & SERVICES			
RUTLAND STATE AIRPORT			
CLARENCE	VERMONT		
DATE: 5 AUG. 1986	SCALE: 1"=20'-0"	REVISIONS:	DWG NO. S-1A
DRAWN BY: M. INCERPI	APPROVED BY:		23 OF 23

23"

STATE OF VERMONT
RUTLAND TERMINAL BUILDING
DEDICATED JANUARY 18, 1986
MADELEINE M. KUNIN
GOVERNOR




PLAQUE ELEVATION

SCALE: FULL SIZE

NOTES:

- MARBLE TYPE - ADIRONACK VERDE
- LETTER STYLE - SADD BLASTED ROMAN
- LETTER COLOR - GOLD

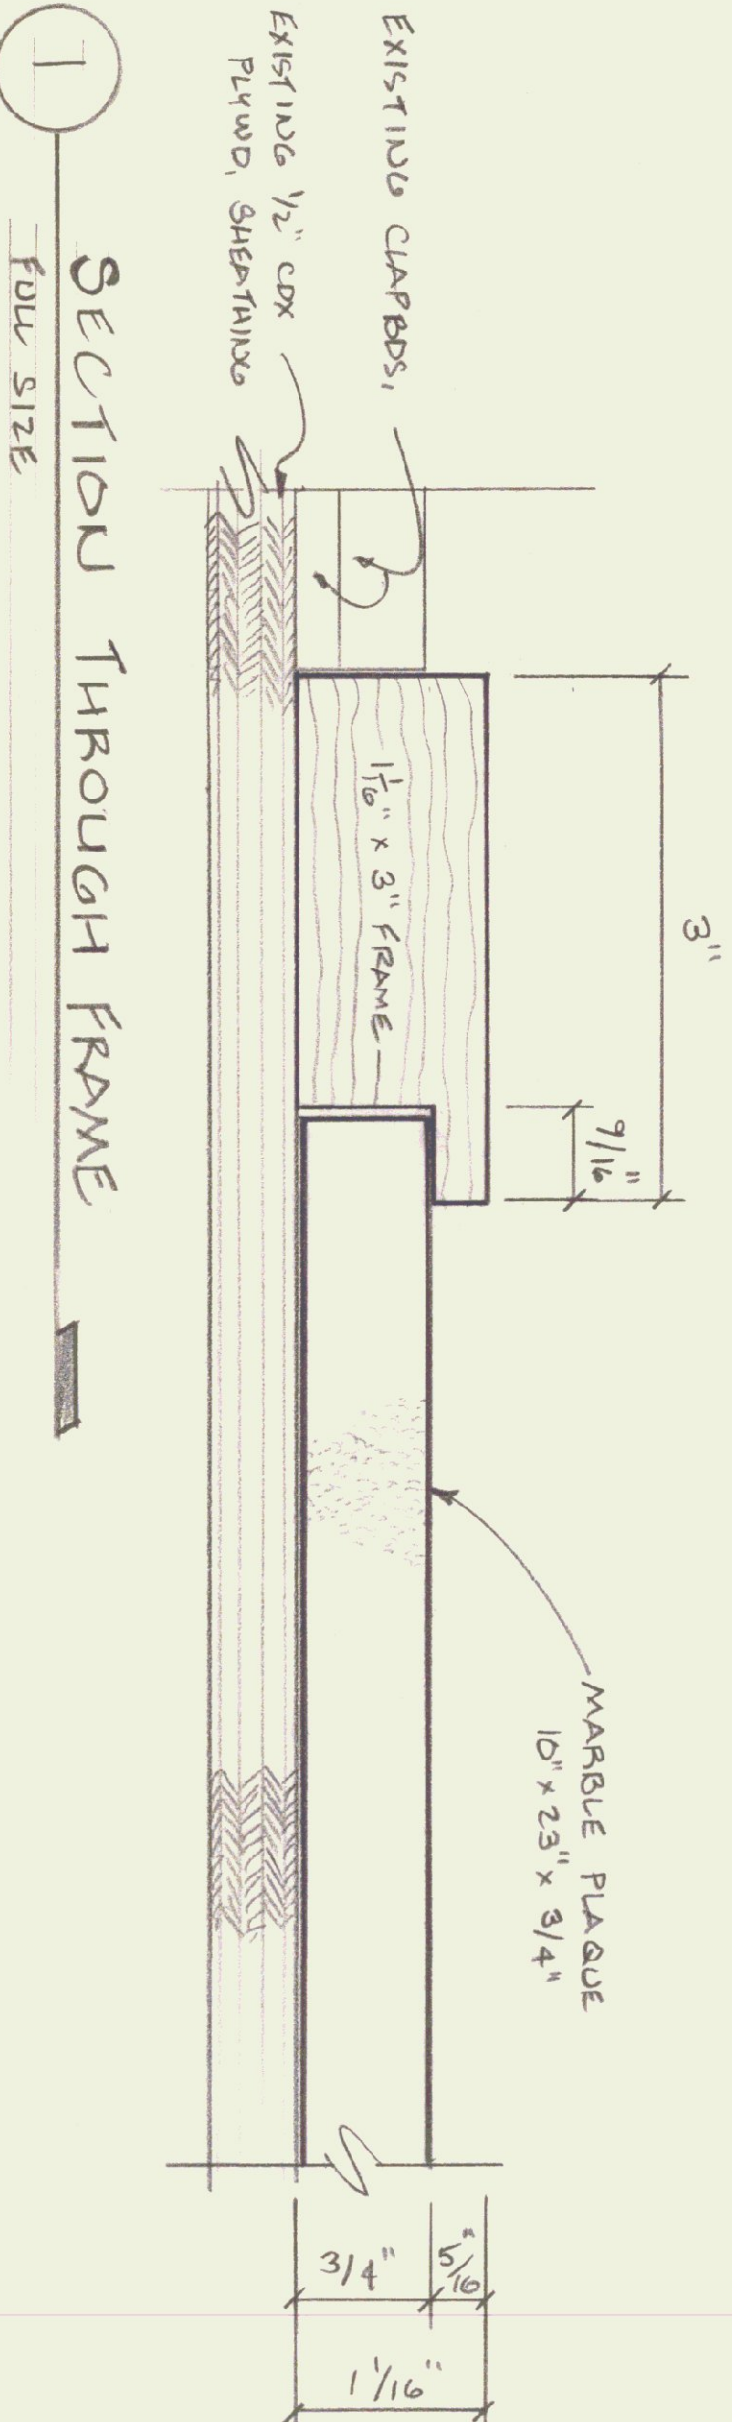


SECTION THROUGH FRAME

SCALE: FULL SIZE

STATE OF VERMONT
DEPARTMENT OF STATE BUILDINGS
AGENCY OF ADMINISTRATION
MONTPELIER
VERMONT

PLAQUE LAYOUT
RUTLAND TERMINAL BUILDING

DATE	SCALE	REVISIONS	DWG. NO.
3/7/80	Full Size		1
DRAWN BY	APPROVED BY		
SAND OSGOOD			


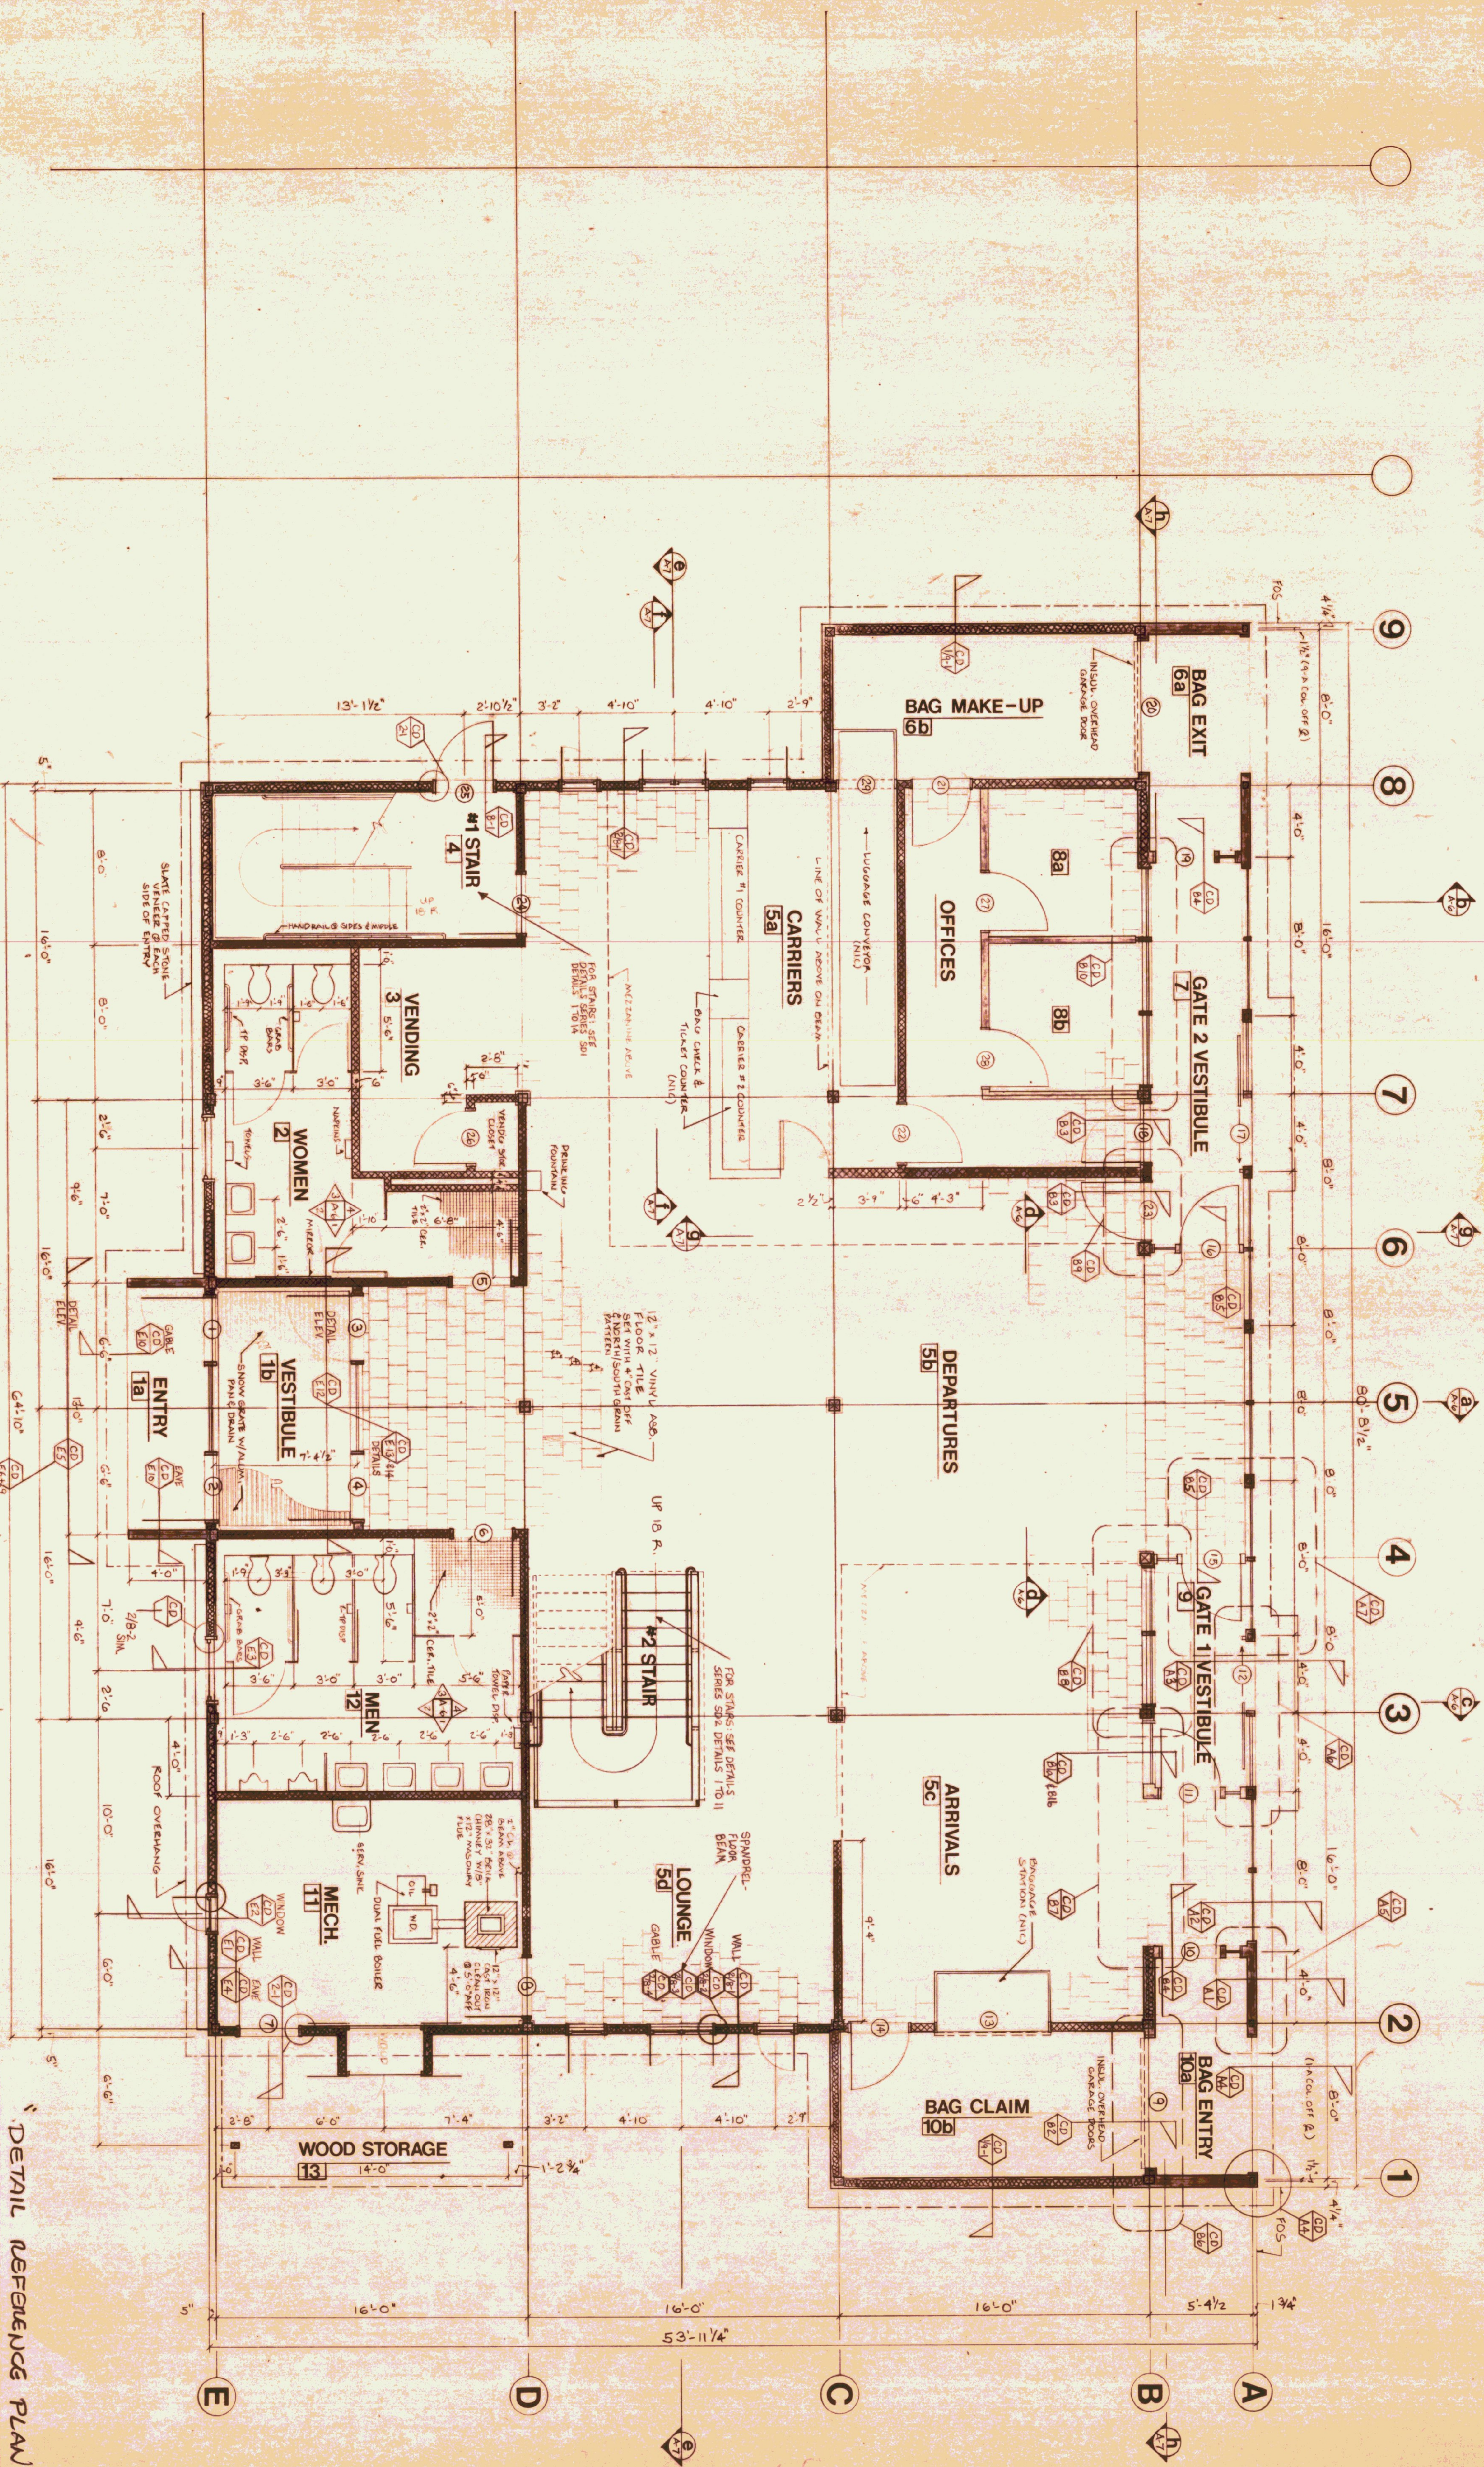


DETAIL REFERENCE PLAN"

STATE OF VERMONT
DIVISION OF STATE BUILDINGS
AC. INC. OF ADMINISTRATION
MONTPELIER, VERMONT

RUTLAND TERMINAL BUILDING AIR 23-2024
FIRST FLOOR PLAN
RUTLAND STATE AIRPORT
CLARENDON, VERMONT

DATE	SCALE	REVISIONS	DWG. NO.
6/8/84	1/2" = 1'-0"		A-2Ref.
DRAWN BY			5 OF 19
APPROVED BY			
1/24 Rev. 05/8			

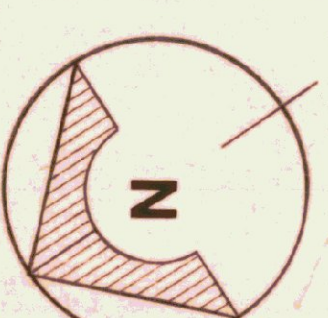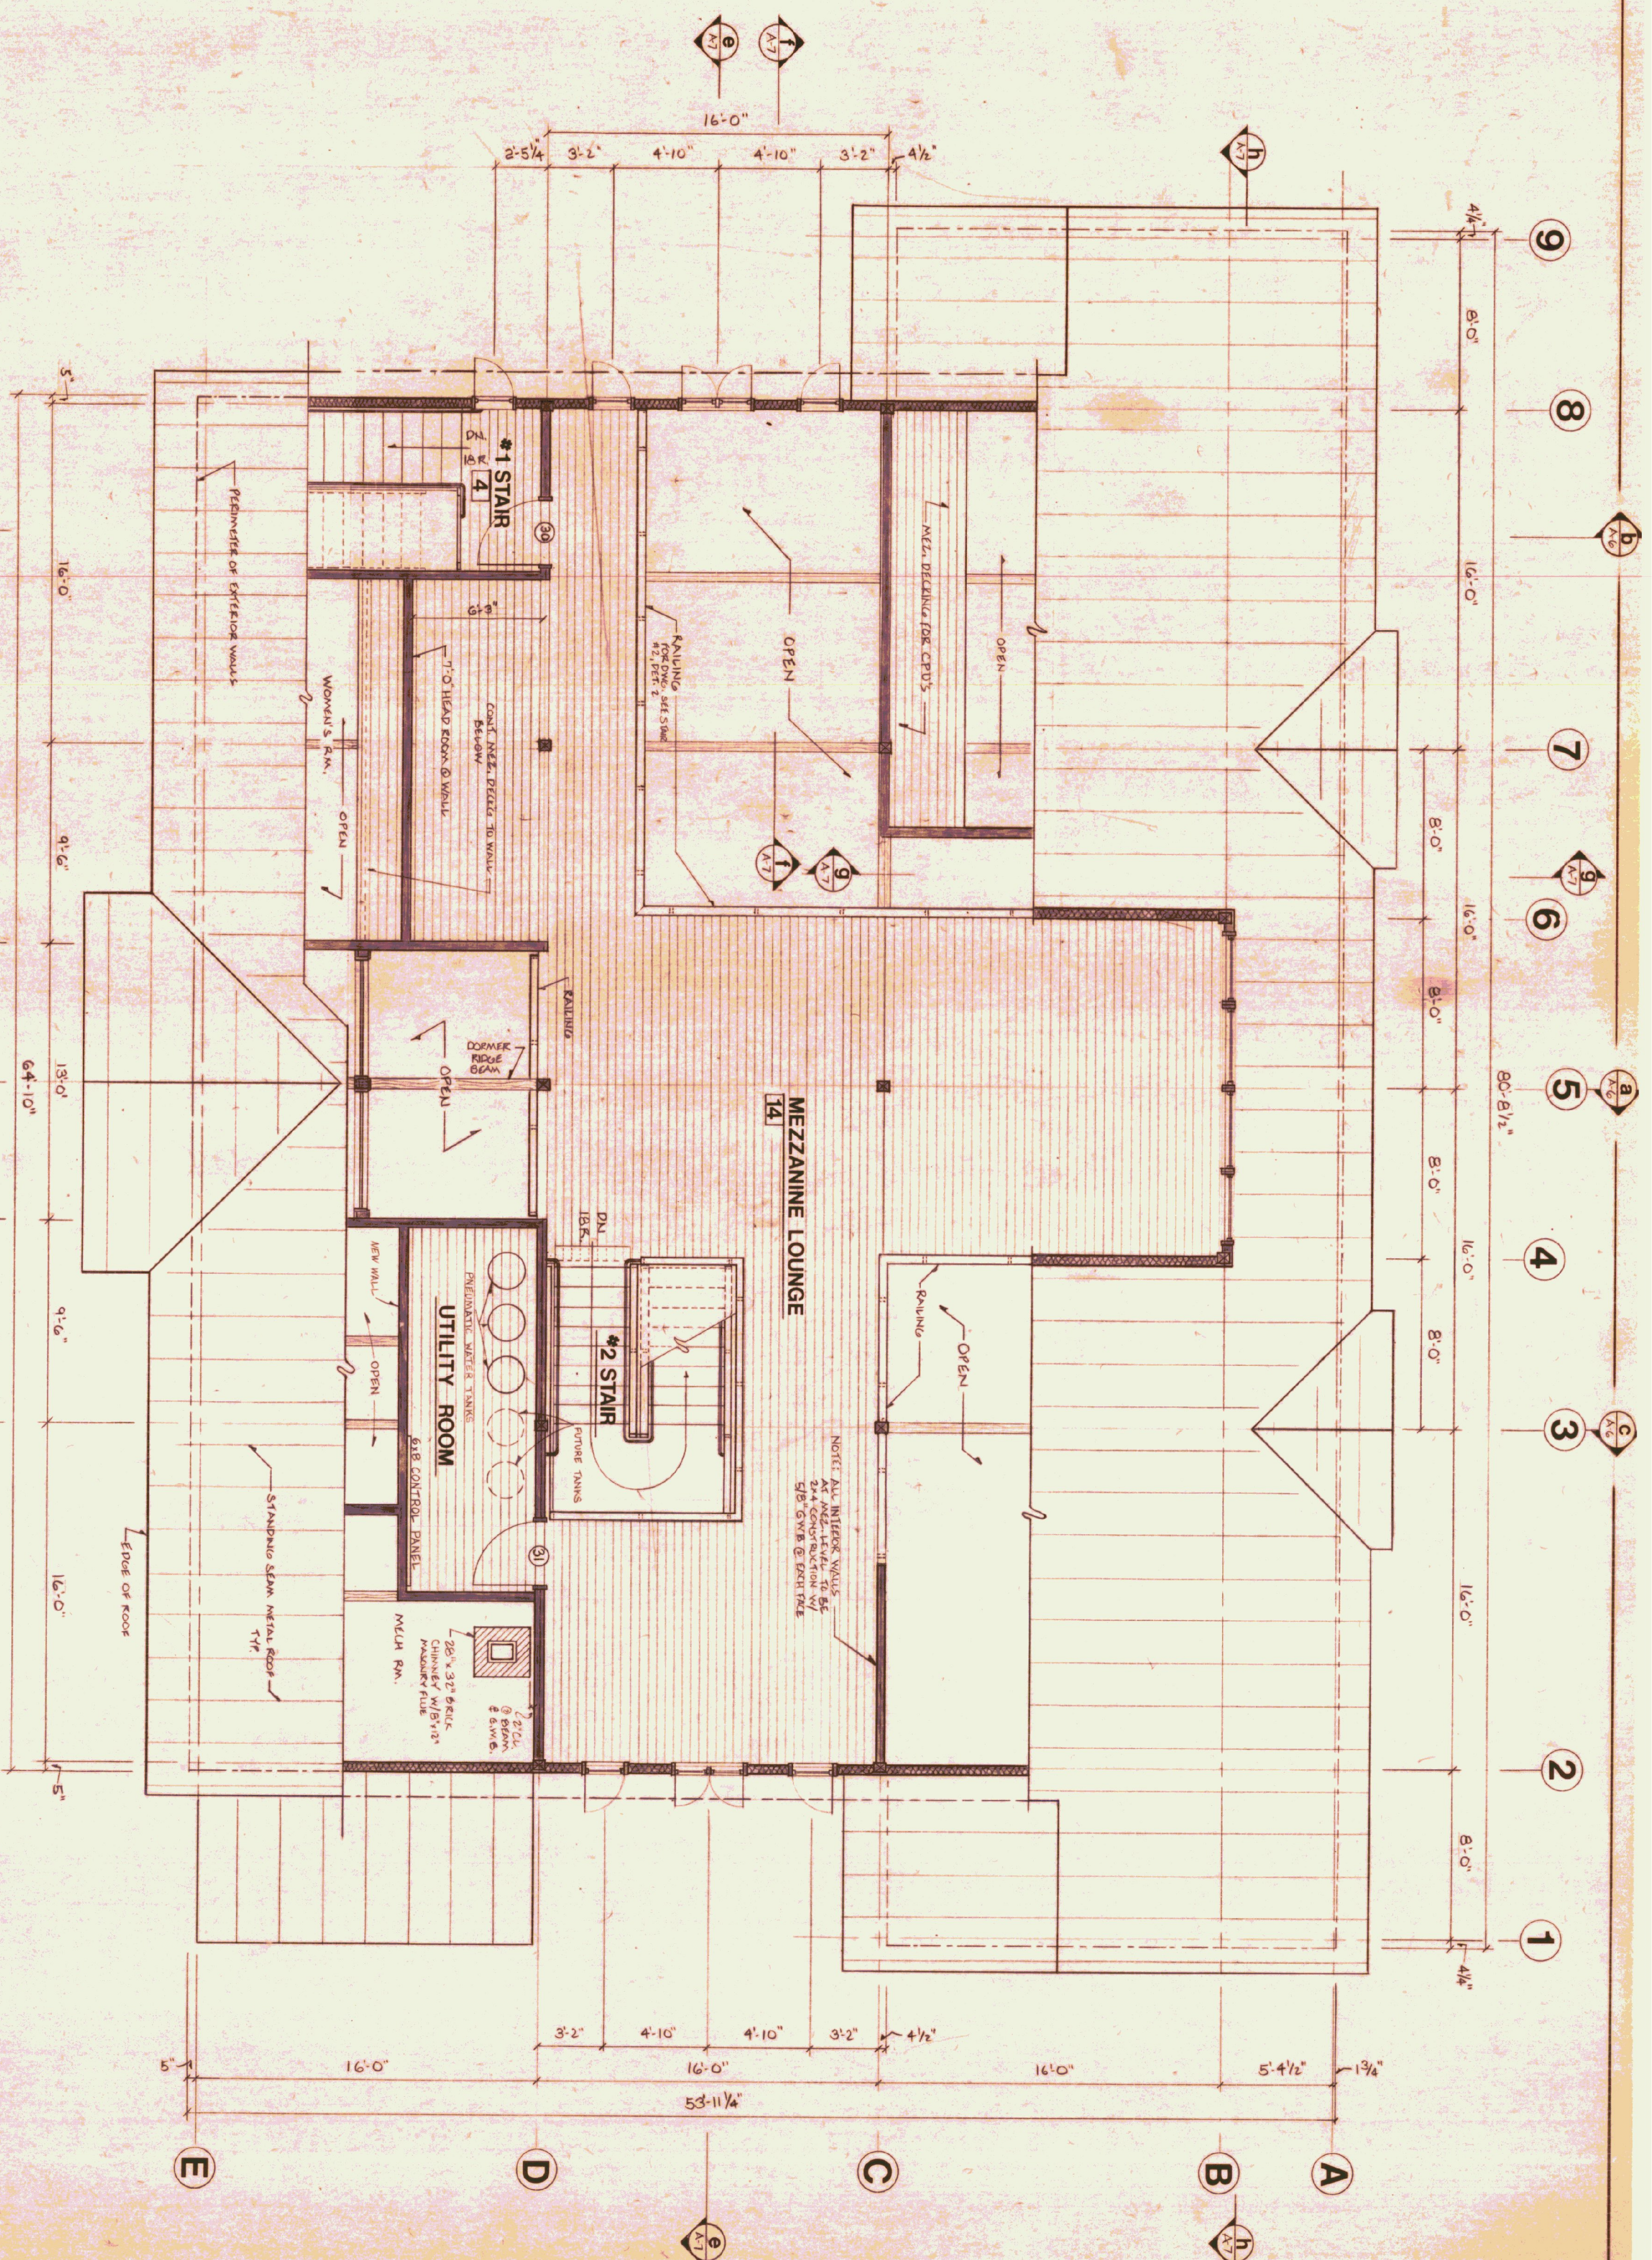

STATE OF VERMONT
DIVISION OF STATE BUILDINGS
AGENCY OF ADMINISTRATION
MONTPELIER, VERMONT

RUTLAND TERMINAL BUILDING AIR 23-2024

MEZZANINE PLAN

RUTLAND STATE AIRPORT
CLARENDON, VERMONT

DATE	SCALE	REVISIONS	DWG. NO.
6-8-84	1/4" = 1'-0"	REVISED BY J. J. LAMBERT	A-3
DRAWN BY: JTO	APPROVED BY: J. J. LAMBERT		6 OF 19

8/10/84