

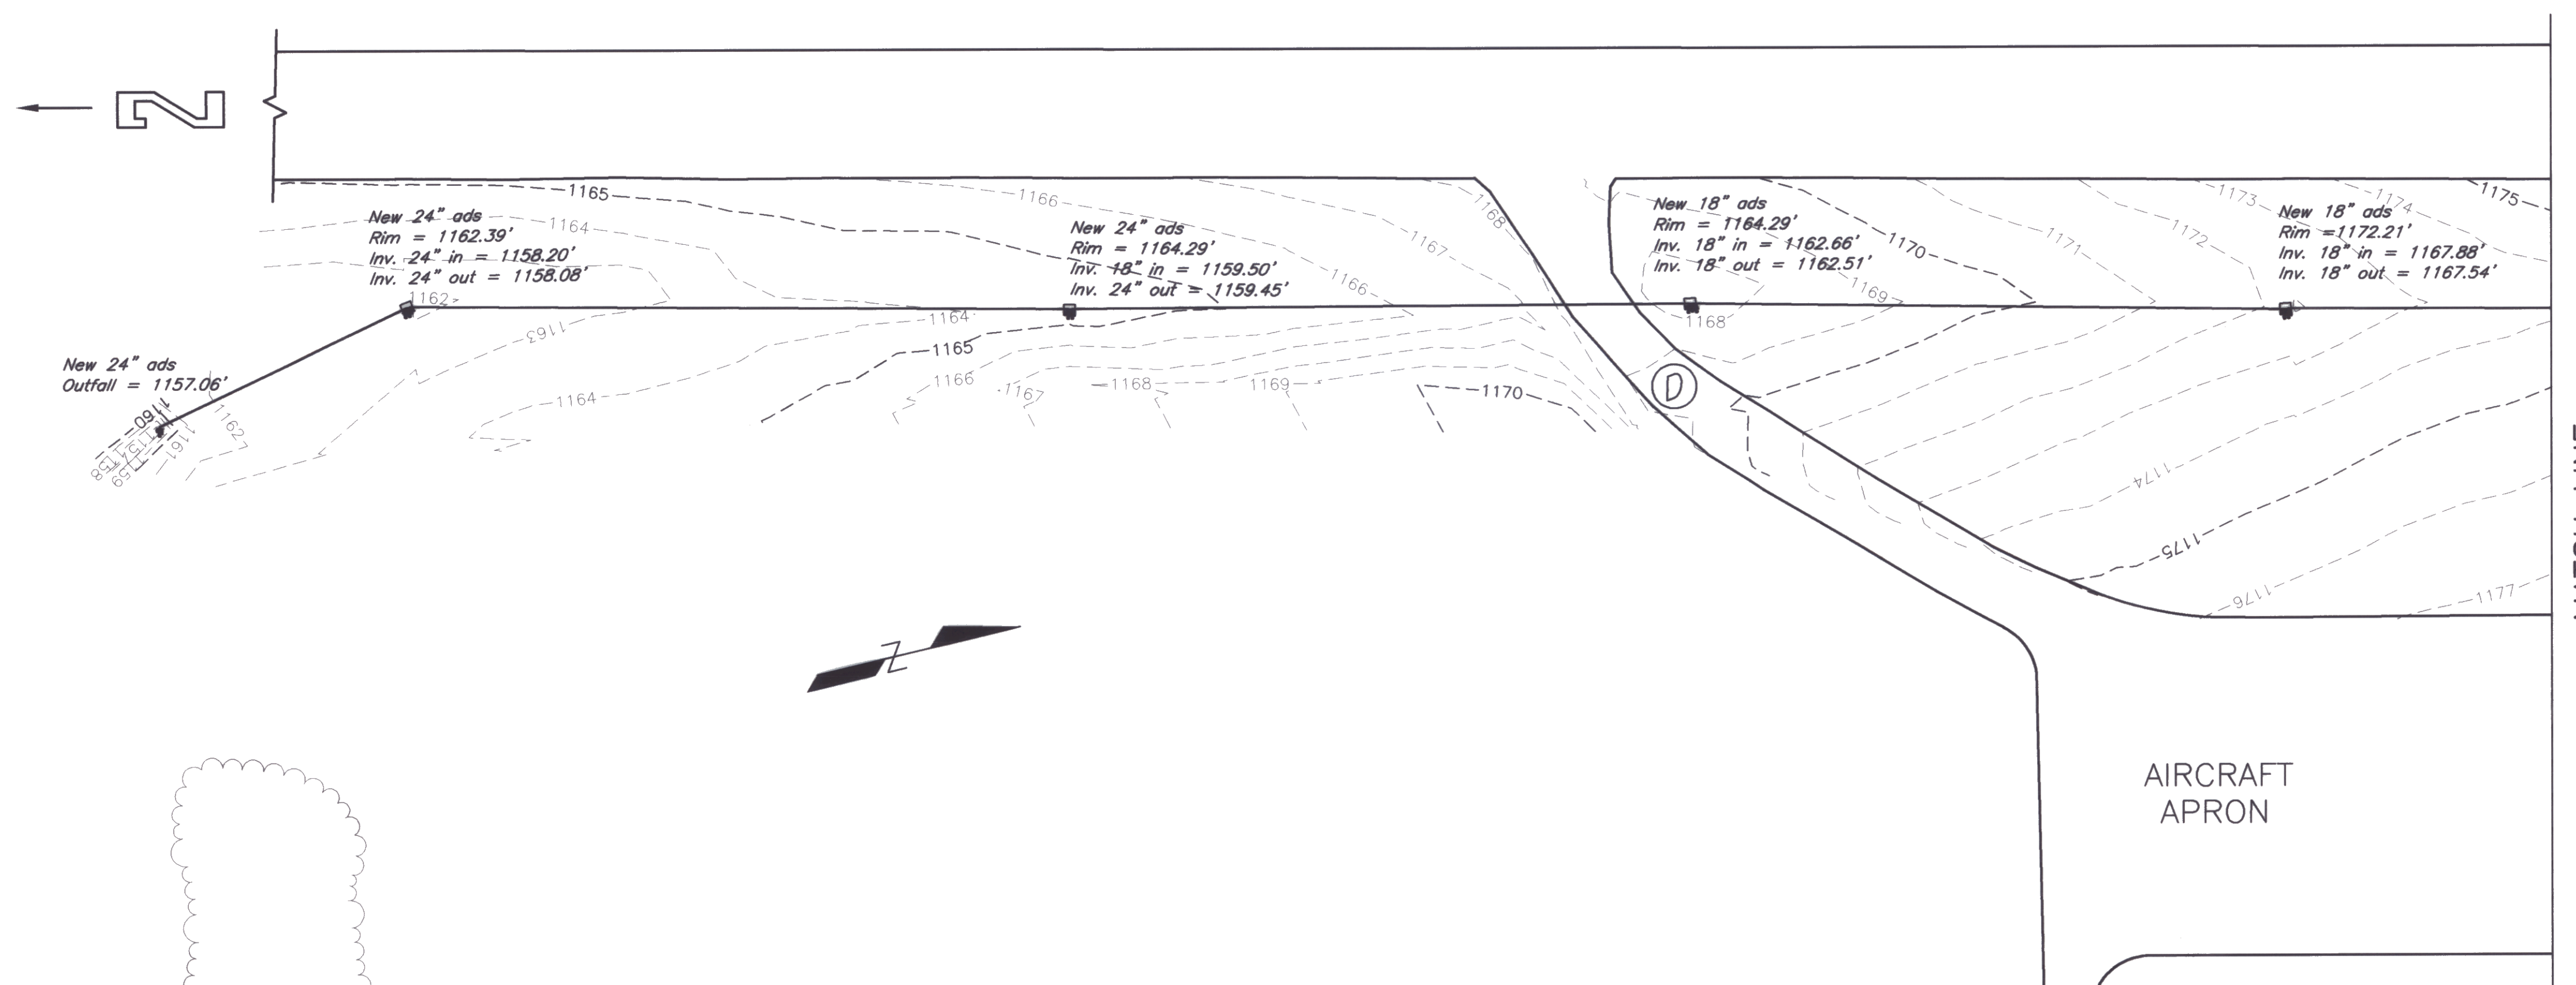


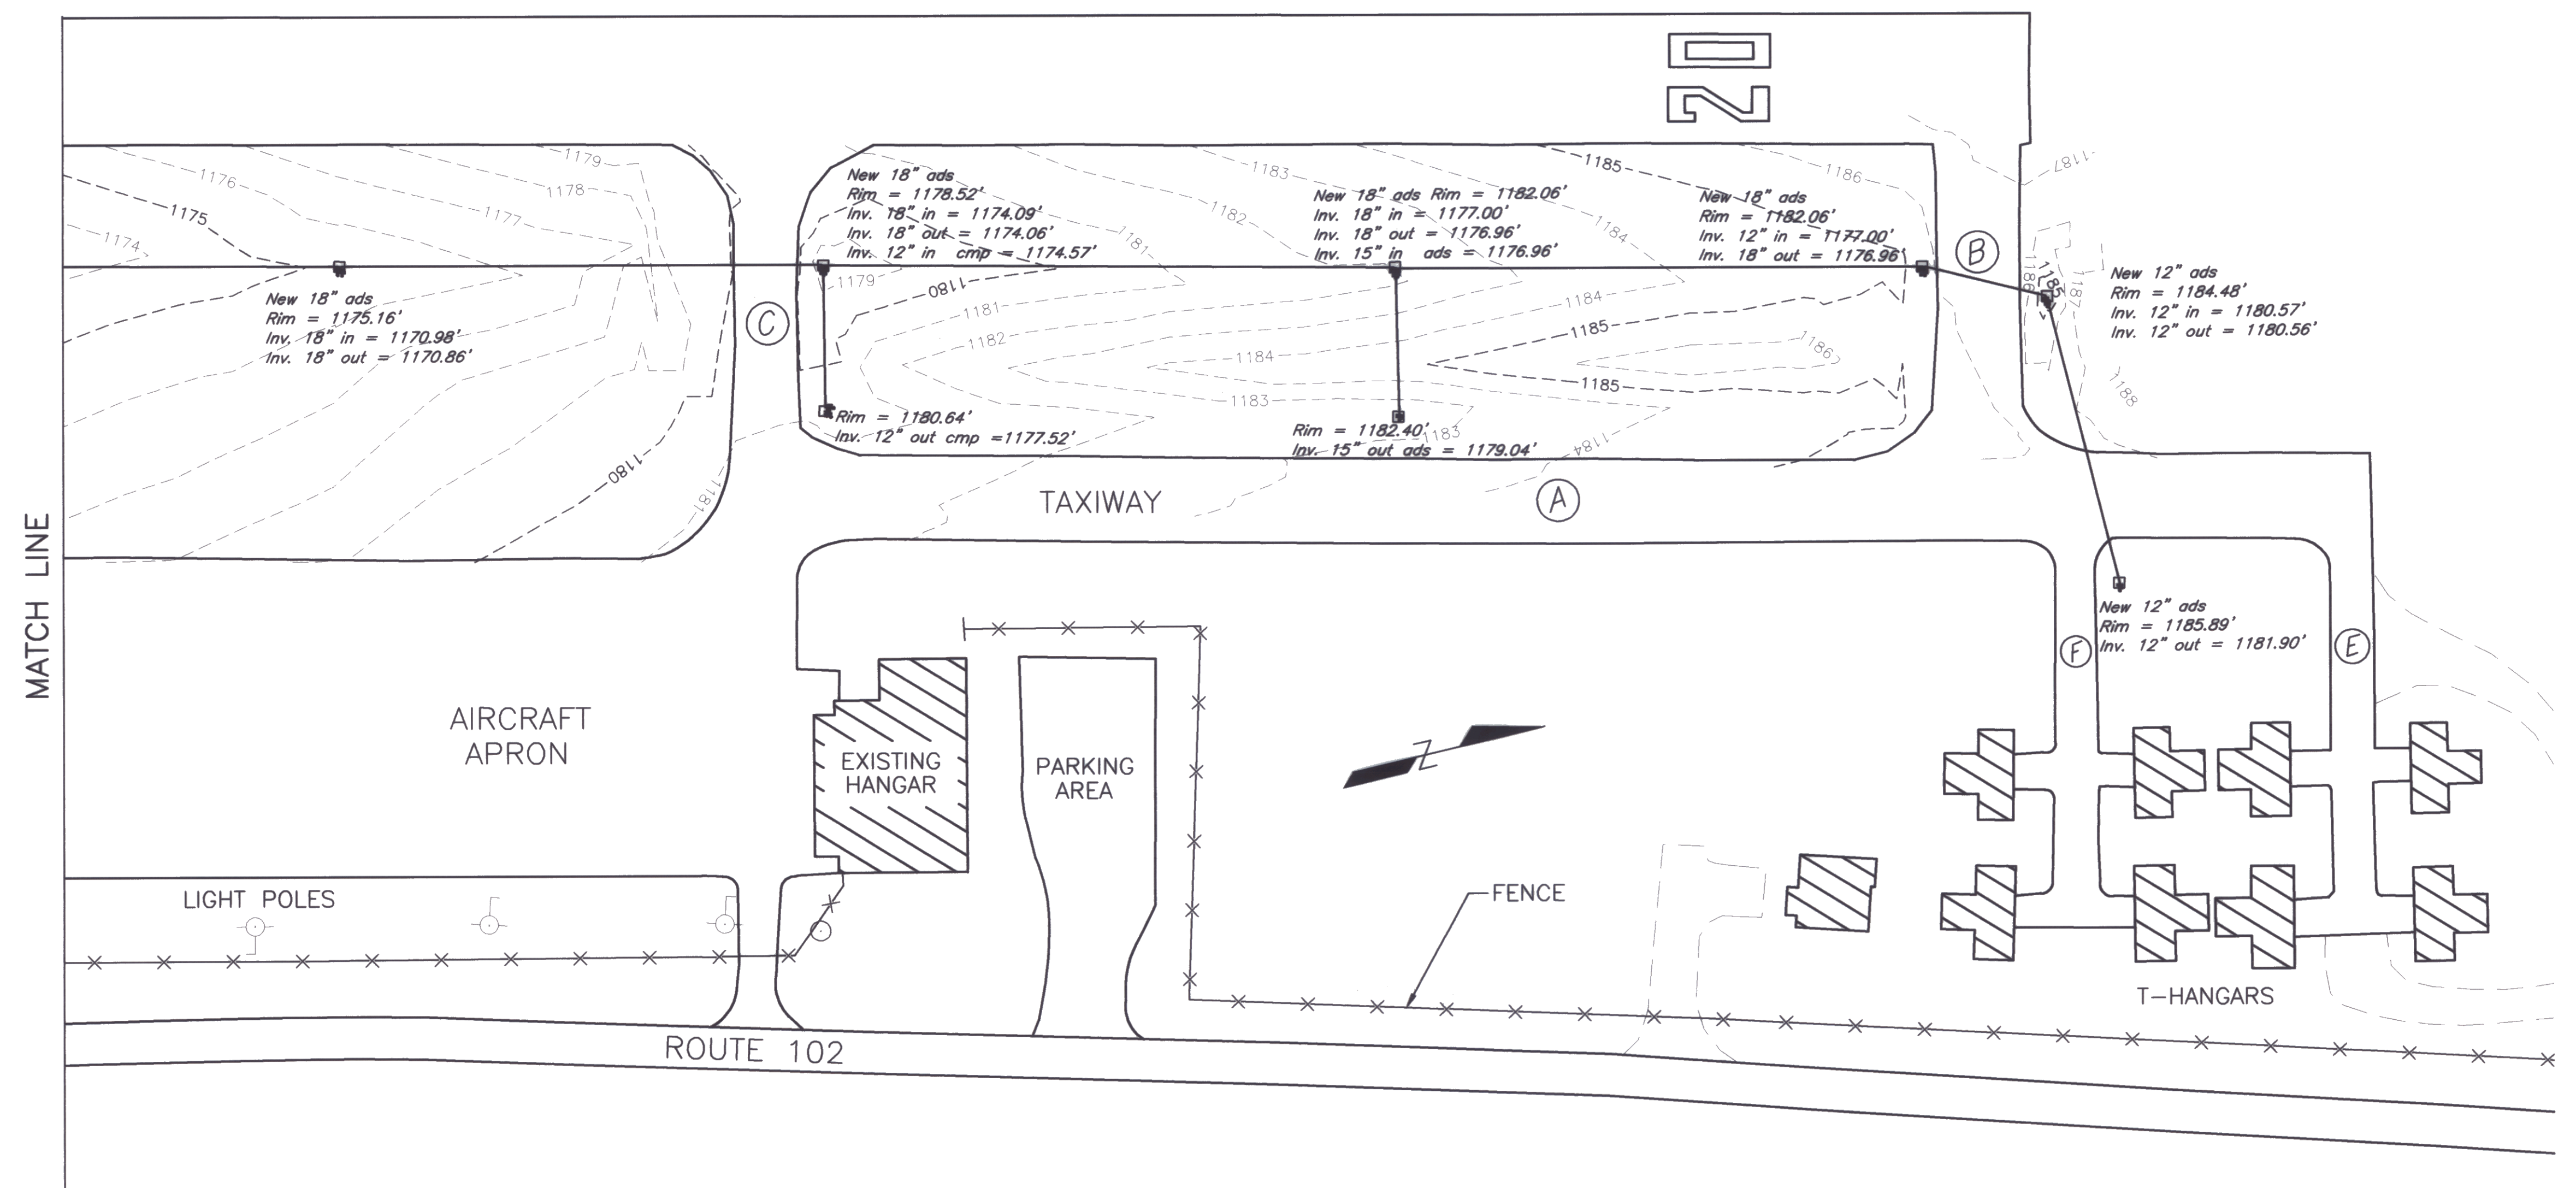


AS-BUILT TOPOGRAPHIC
INFORMATION FROM
FIELD OBSERVATIONS TAKEN
5/22/01 BY DUBOIS AND
KING, INC.

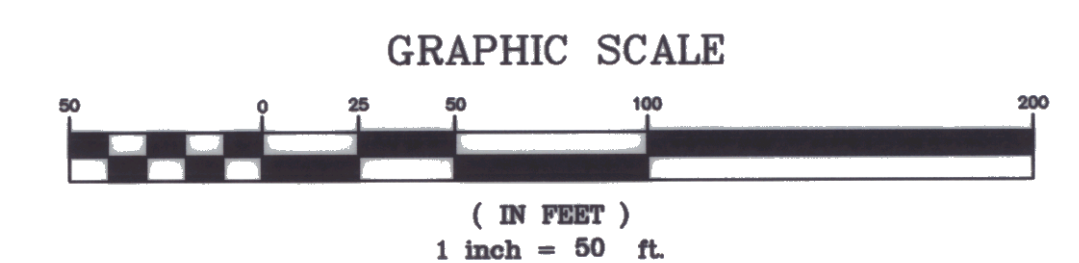

AS-BUILT

NO.	DATE	REVISIONS	BY	CHK

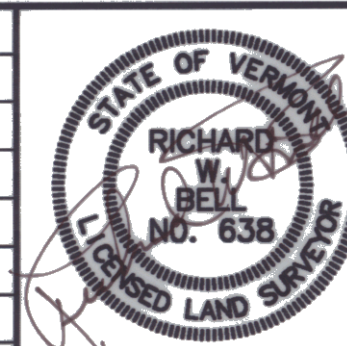

DuBois & King Inc.
engineering planning management development

STATE OF VERMONT
AGENCY OF TRANSPORTATION
CALEDONIA COUNTY STATE AIRPORT

TAXIWAY DRAINAGE
SITE PLAN

DRAWN BY SJW	DATE AUG. 2001
CHECKED BY	PROJ. NO. N17151
PROJ. ENG. JAA	DRAW. NO. C171510002
SHEET 1 OF 1	