

STATE OF VERMONT
AGENCY OF TRANSPORTATION
ELEVEN BAY MAINTENANCE GARAGE
DUMMERSTON, VERMONT


AGENCY OF ADMINISTRATION
DEPARTMENT OF STATE BUILDINGS
MONTPELIER, VERMONT
JOHN J. ZAMPIERI, COMMISSIONER

AGENCY OF TRANSPORTATION
MONTPELIER, VERMONT
SUSAN C. CRAMPTON, SECRETARY

ABBREVIATIONS:

AN	- Anchor Bolts
BLDG	- Building
BOT	- Bottom
BLK	- Blocking
CB	- Carriage Bolt
C	- Center Line or Column Line
CLS	- Columns
CONC	- Concrete
CONT	- Continues
ENT	- Entrance
DNS	- Downward Anchor Slot
DEL	- Double
DR	- Door
DN	- Down
EF	- Each Face
ELEV	- Elevation
EW	- Each Way
EXT	- Exterior
FCD	- Floor Clean Out
FD	- Floor Drain
FDIN	- Foundation
FE	- Fire Extinguisher
FF	- Face of Foundation
GAB	- Gypsum Wall Board
HCI	- Hotless Cast Iron

HEIZ	- Horizontal
INSUL	- Insulation
LB	- Lag Bolt
MAX	- Maximum
MIN	- Minimum
MR	- Moisture Resistant
NIC	- Not In Contact
OC	- On Center
OPP	- Opposite
OSB	- Oriented Strand Board
Ø	- Diameter
PEEP	- Perpendicular
PL	- Plate
PR	- Pair
R	- Riser
RO	- Rough Opening
ST	- Steel
T & B	- Top and Bottom
TYP	- Typical
VERT	- Vertical
VP	- Vapor Barrier
VTR	- Vent Through Roof
W/	- With
WD	- Wood

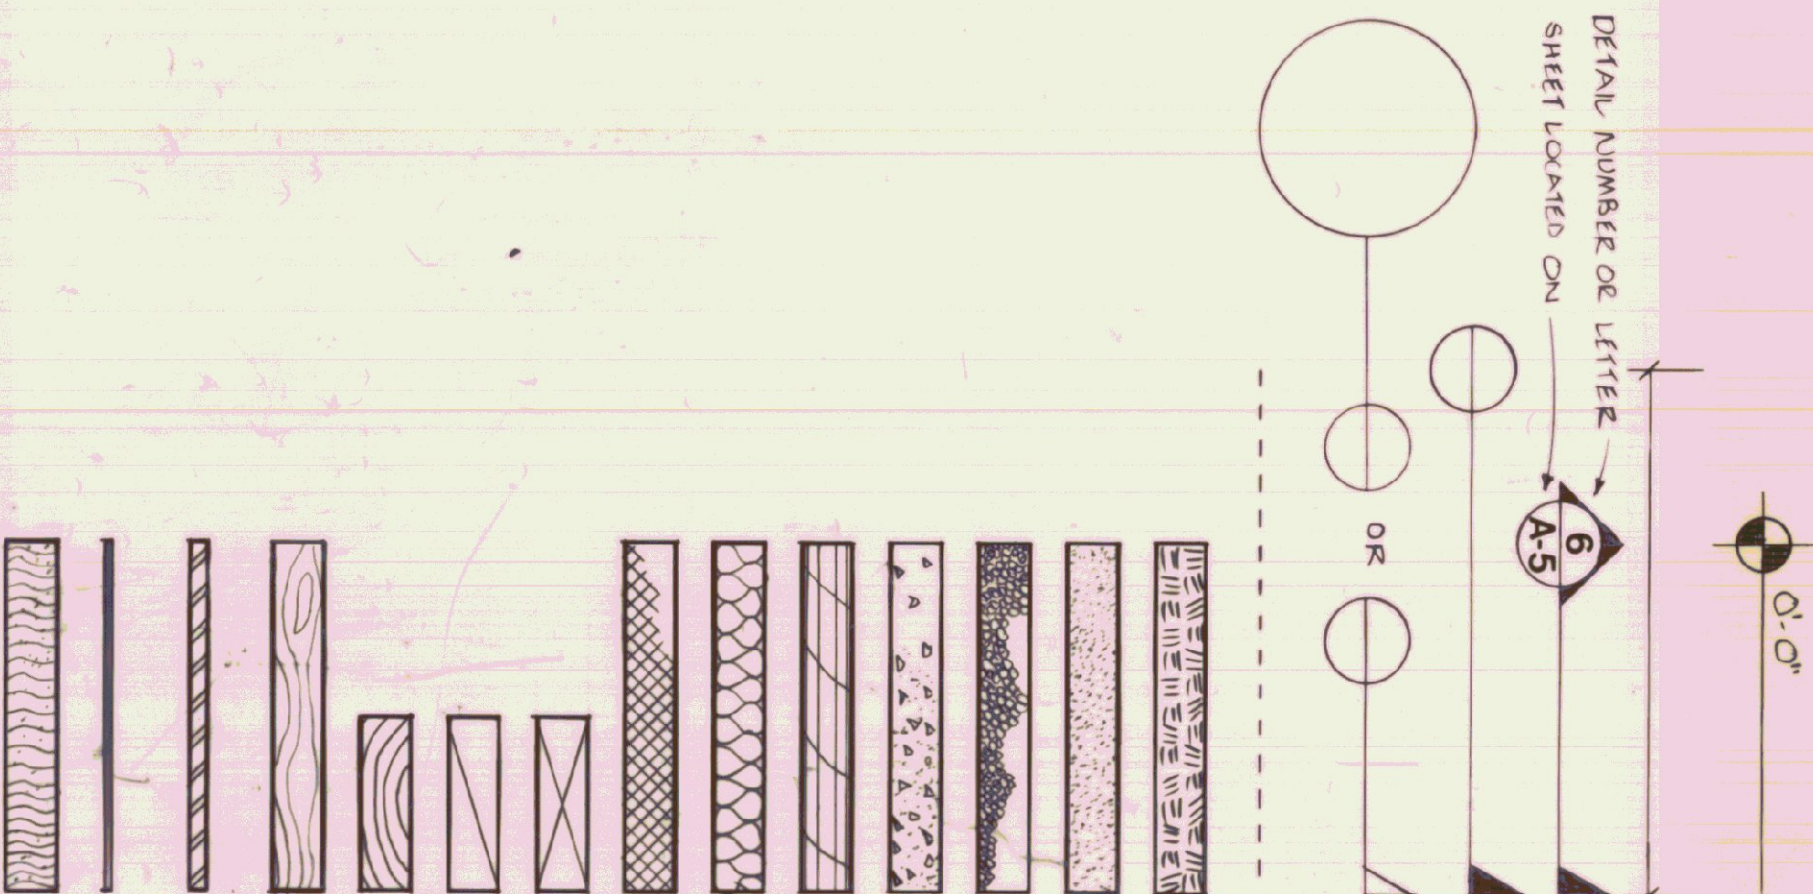

SYMBOLS:

STANDARD ELEVATIONS
DIMENSION TO FACE OF MATERIAL, OR CENTER LINE
1/8 SCALE SECTION THROUGH ENTIRE BUILDING
LARGE SCALE SECTION
DETAIL REFERENCE
MATERIAL IN A RELATED PLANE
SOIL
SAND OR GYPSUM WALL BOARD
COMPACTED GRANULAR FILL
CONCRETE
PLYWOOD OR OSB (Oriented Strand Board)
FIBERGLASS INSULATION
EXTRUDED POLYSTYRENE OR POLYISOCYANURATE INSUL.
CONTINUOUS STRUCTURAL WOOD FRAMING
DISCONTINUOUS WOOD FRAMING
BAD GRAIN WOOD (FINISHED MATERIAL)
FINE GRAIN WOOD (FINISHED MATERIAL)
LARGE SCALE STRUCTURAL STEEL CROSS SECTION
STEEL REINFORCING OR SMALL SCALE STRUCT. STEEL
CONCRETE BLOCK

DRAWING INDEX:

TITLE SHEET	SITE DESIGN	STRUCTURAL
1 T-1	2 SD-1 3 SD-2 4 SD-3 5 SD-4 6 SD-5	13 S-1 14 S-2 15 S-3 16 S-4
SITE PLAN SEWER PLAN CROSS SECTION CROSS SECTION WATER LINE PROFILE ARCHITECTURAL	GROUND FLOOR & MEZZANINE LEVEL, DOOR AND WINDOW SCHEDULES EXTERIOR ELEVATIONS AND SECTIONS ROOF PLAN, INTERIOR ELEVATIONS & SECTIONS 1/4 SCALE WALL SECTIONS WALL PLANS & SECTIONS WALL SECTIONS, CHIMNEY SECTIONS & WALL FINISH DETAILS DOOR, WINDOW, & STAIR DETAILS	FOUNDATION PLAN & WALL SECTIONS SLAB PLAN & DRAINAGE TRENCH DETAILS STRUCTURAL STEEL FRAMING & MEZZANINE & ROOF, MISC. DETAILS STEEL FRAMING SECTIONS AND DETAILS PLUMBING WATER AND SANITARY PLANS HEATING HEATING PLAN AND DETAILS ELECTRICAL ELECTRICAL SITE PLAN ELECTRICAL PLAN AND DETAILS STANDARD SHEETS D-6 REIN. CONC. DROP INLET D-11 CAST IRON GRATE, TYPE A D-16 CAST IRON GRATE, TYPE B D-22 SANITARY SEWER SYSTEMS B-71 RESIDENTIAL & COMMERCIAL DELIVER
	8 A-3 9 A-4 10 A-5 11 A-6 12 A-7	17 P-1 18 H-1 19 E-1 20 E-2 4-4-73 R 8-24-81 R 11-14-72 R 10-1-75 4-20-71

ISSUE RECORD:

ISSUE NO.	DATE	NO. PRINTS	DESCRIPTION	TO WHOM	BY
-----------	------	------------	-------------	---------	----

T-1 TEMPORARY EROSION CONTROL
T-2 TEMPORARY EROSION CONTROL

7-5-72
7-5-72

4-20-71

10-1-75

11-14-72 R

8-24-81 R

4-4-73 R

19 E-1

20 E-2

17 P-1

18 H-1

19 E-1

20 E-2

4-4-73 R

8-24-81 R

11-14-72 R

10-1-75

4-20-71

10-1-75

11-14-72 R

8-24-81 R

4-4-73 R

19 E-1

20 E-2

17 P-1

18 H-1

19 E-1

20 E-2

4-4-73 R

8-24-81 R

11-14-72 R

10-1-75

4-20-71

10-1-75

11-14-72 R

8-24-81 R

4-4-73 R

19 E-1

20 E-2

17 P-1

18 H-1

19 E-1

20 E-2

4-4-73 R

8-24-81 R

11-14-72 R

10-1-75

4-20-71

10-1-75

11-14-72 R

8-24-81 R

4-4-73 R

19 E-1

20 E-2

17 P-1

18 H-1

19 E-1

20 E-2

4-4-73 R

8-24-81 R



11-14-72 R

10-1-75

4-20-71

COMPACTION SPECIFICATIONS:

- 1) CLEAR AND GRUB THE BUILDING AREA.
- 2) REMOVE ANY TOPSOIL AND ORGANIC MATTER FROM THE BUILDING LOCATION.
- 3) REGRADE SITE SO THAT AT LEAST 2 FEET OF COMPACTED FILL WILL BE PLACED UNDER ALL PARTS OF THE BUILDING.
- 4) COMPACT THE EXISTING SOIL 1 FT. DEEP IN THE BUILDING AREA TO AT LEAST 95% OF THE MAXIMUM UNIT WEIGHT OBTAINED BY LABORATORY MOISTURE DENSITY TEST RESULTS FROM AASHTO T180, METHOD C.
- 5) PROVIDE GRANULAR FILL IN NOT OVER 6" LIFTS WITH COMPACTION TO AT LEAST 95% OF AASHTO T180, METHOD C, UP TO FINAL GRADE, IN THE AREA WHICH INCLUDES THE BUILDING PLUS A 10 FT. PERIMETER STRIP OUTSIDE THE BUILDING.
- 6) GRANULAR FILL SHALL HAVE 100% PASSING THE 1 1/2" SIEVE AND NOT OVER 10% PASSING THE NO. 200 SIEVE.
- 7) COMPACT THE BOTTOMS OF FOOTING AND UTILITY EXCAVATIONS TO AT LEAST 95% OF MAX. UNIT WEIGHT BY AASHTO T180, METHOD C.
- 8) COMPACT ALL BACKFILL INSIDE THE BUILDING TO 95% OF AASHTO T180, METHOD C.
- 9) COMPACT EXTERIOR BACKFILL TO 90% OF AASHTO T180, METHOD C.
- 10) COMPACT TEST COSTS WILL BE PAID BY THE OWNER.

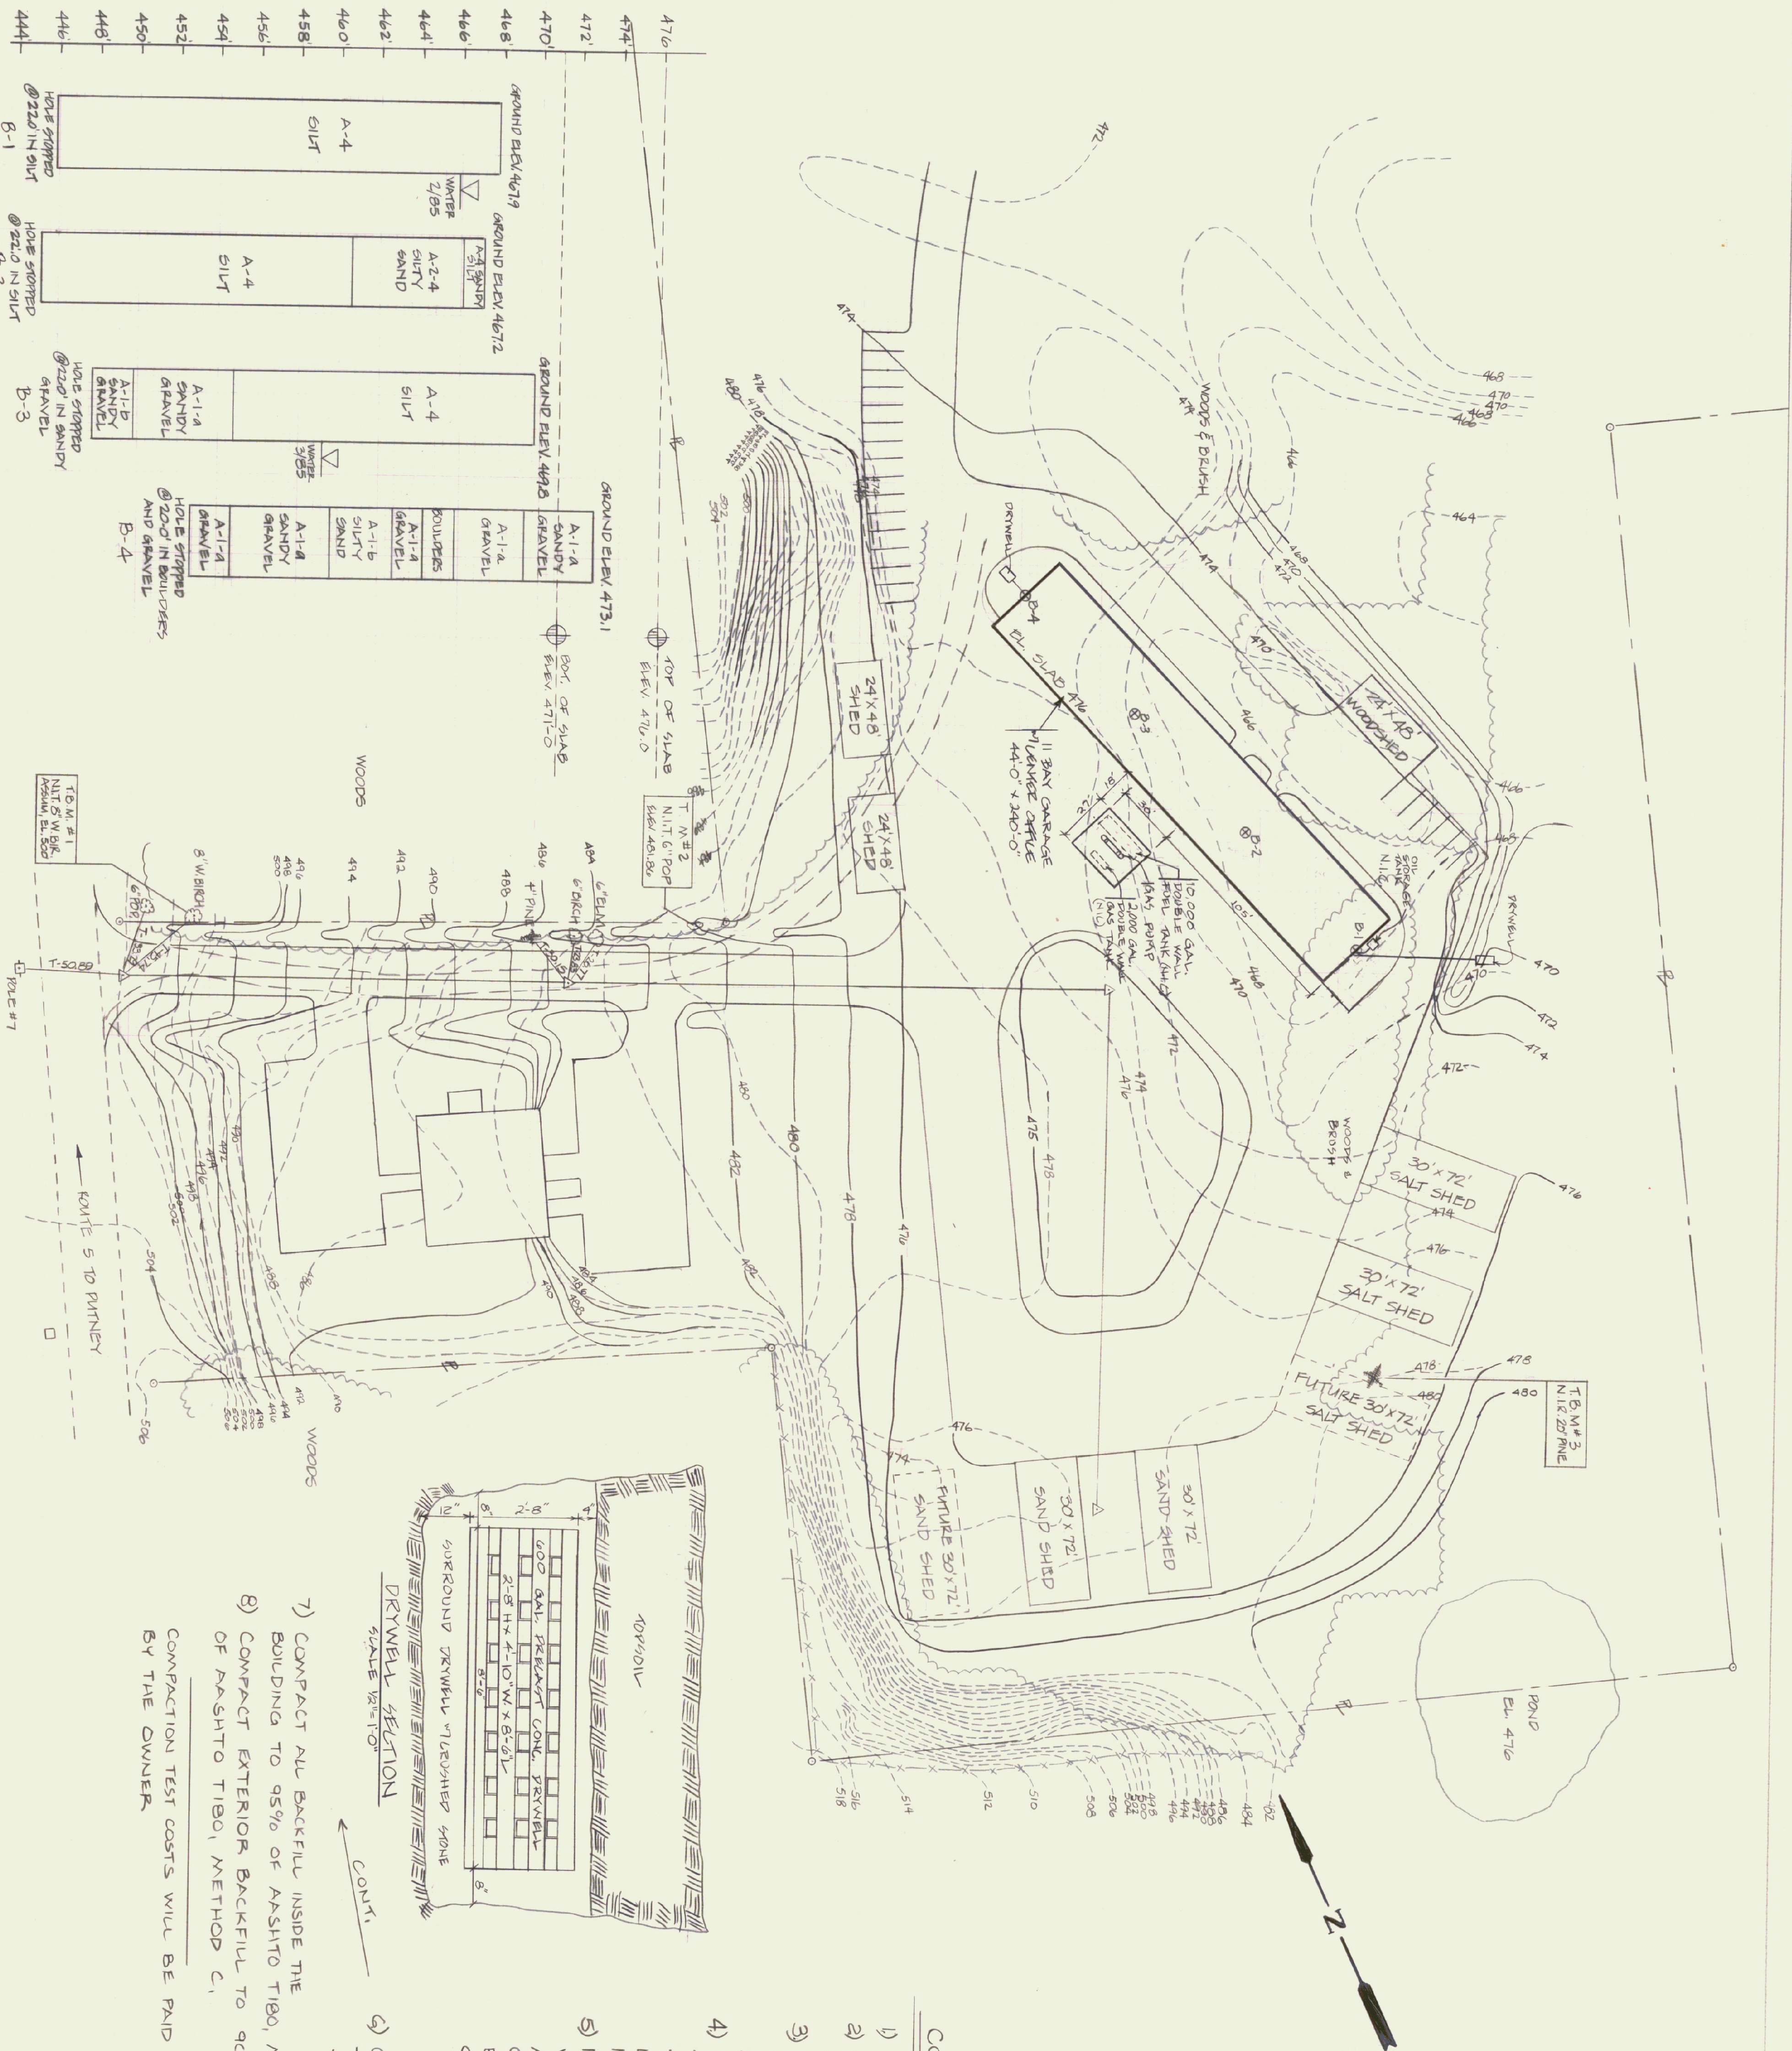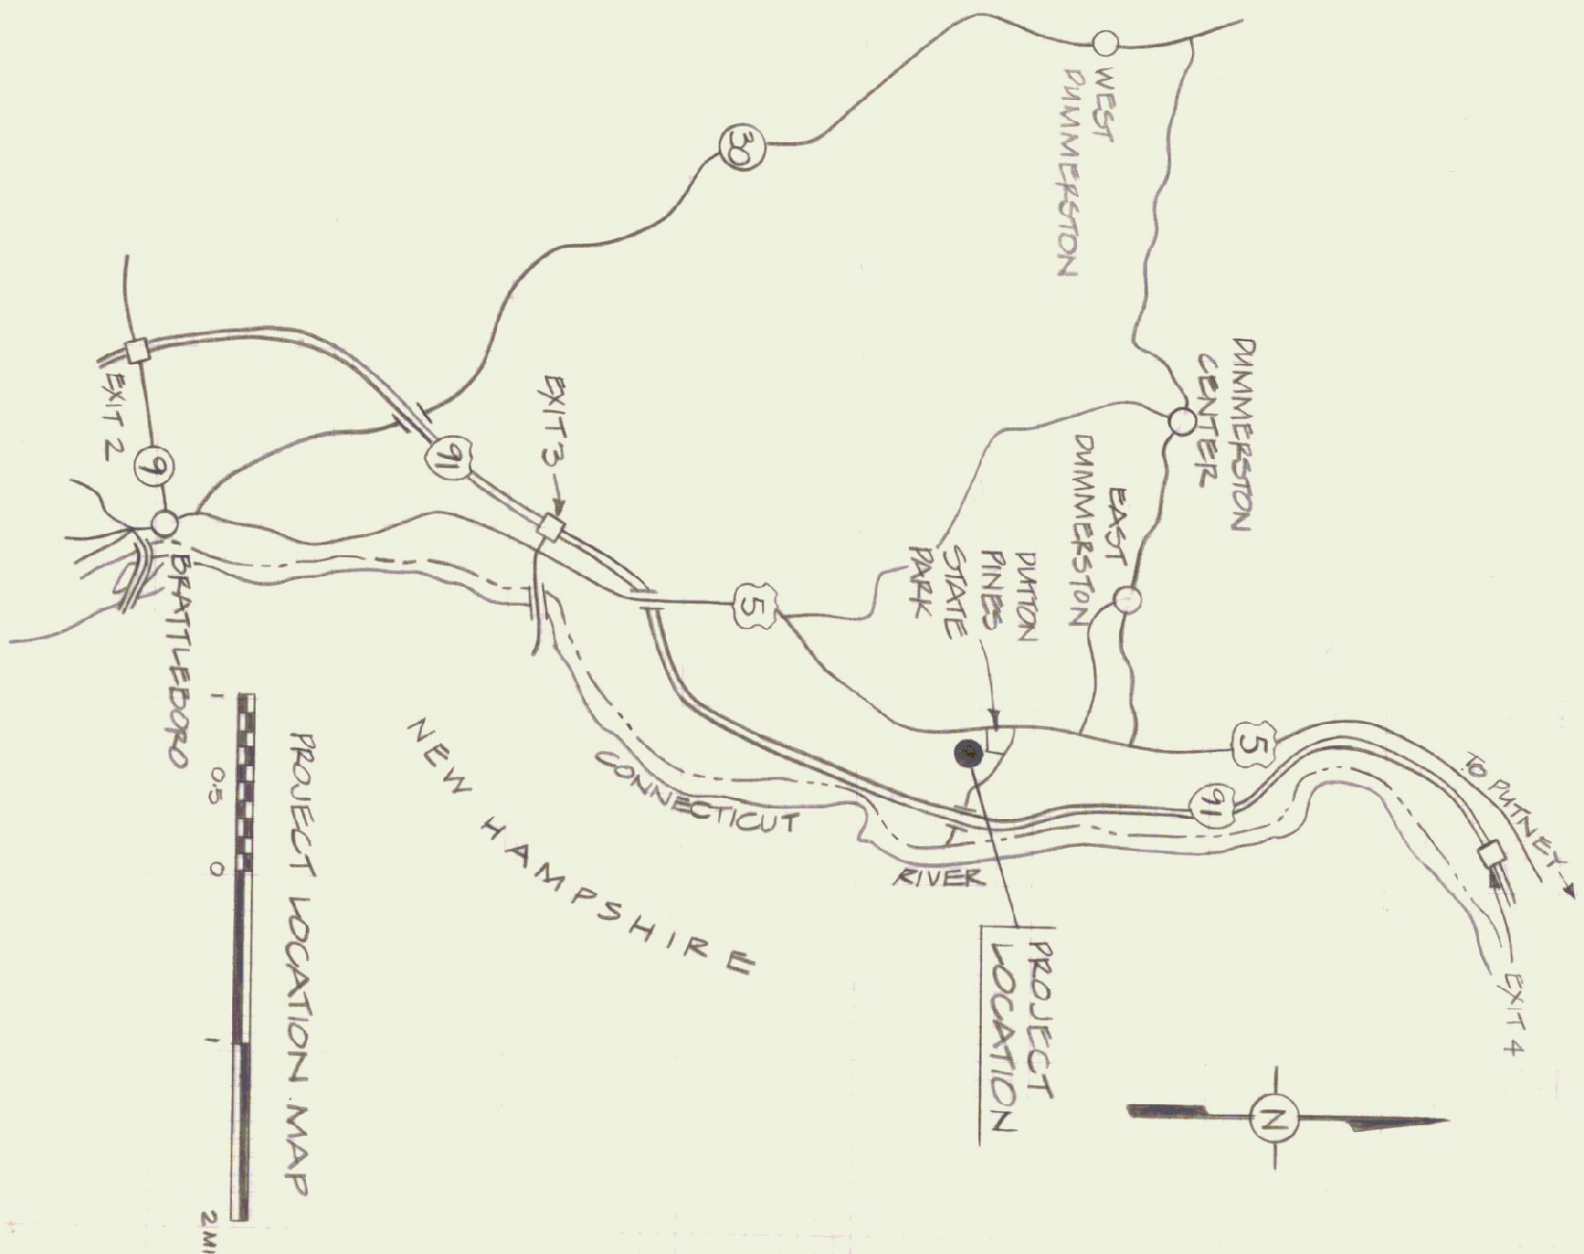

18' MIN.
4DNE FILL, TYPE II
7.5'






NOTE
BAKE, SEED, AND MOLT ALL
AREAS DISORDERED BY CONSTRUCTION.
USE URBAN MIX ON AREAS TO RECEIVE
TOPSOIL AND CONSERVATION MIX
ON ALL OTHER AREAS.

GARAGE - 25 EMPLOYEES (SUMMERTIME MAX.)
OFFICE - 7 EMPLOYEES (WINTER TIME MAX.)
INCIDENT FIELD OFFICE - 20 PEOPLE (5-7 TIMES A YEAR)
PERCUSSION TEST - #1 - 30 MIN./INCH
#2 - 5 MIN./INCH } 30" DEEP HOLES

DESIGN FLOW

$25 \times 15 = 375$	GPD
$7 \times 15 = 105$	GPD
$20 \times 5 = 100$	GPD
580	GPD

   
APPLICATION RATE (≤ 5 MIN./INCH = 1.34 GAL./FT.²/DAY
AREA OF TRENCH REQ. = $\frac{580}{1.34} = 433$ SQ.FT.
FIELD SIZE: 4 TRENCHES 50 FT. LONG X 3 FT. WIDE.
600 SQ.FT./433 = FACTOR SAFETY = 1.3

 DALED HAY LOCATIONS (SEE SHEET FOR DETAILS)
 EXISTING CONTOURS
 NEW CONTOURS
 NEW PAVED AREA
 NEW GRAVEL AREA





10750 LIL

STATE OF VERMONT

WATER LINE TRENCH DETAIL

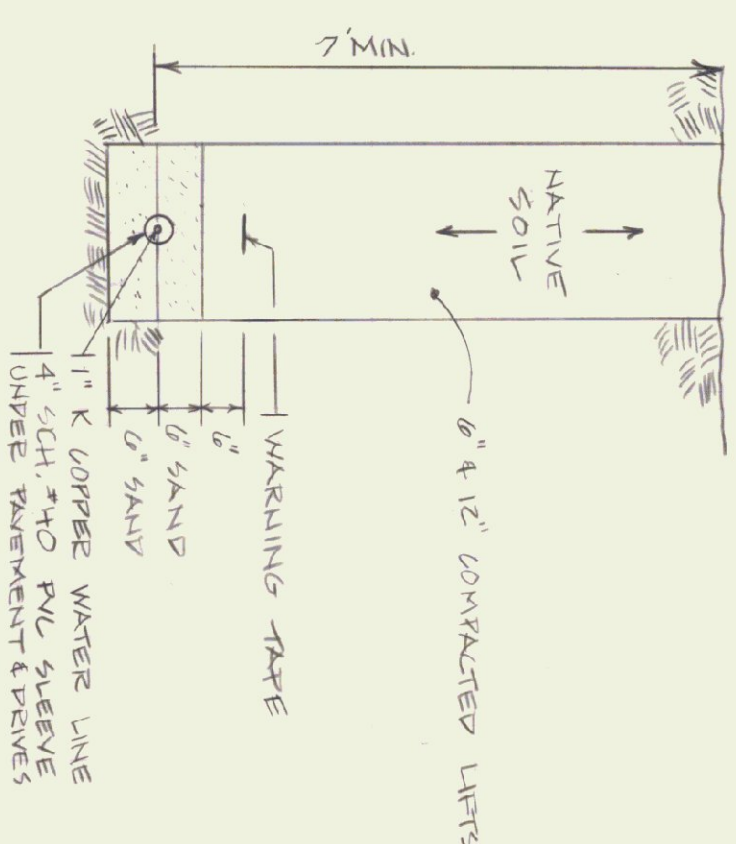


STATE OF VERMONT	
DEPARTMENT OF STATE BUILDINGS	
AGENCY OF ADMINISTRATION	
MONTPELIER.	
VERMONT	
SEWER PLAN	
AGENCY OF TRANSPORTATION	
DISTRICT #2 OFFICES &	
GARAGE COMPLEX	
VERMONT	
DATE	SCALE
2-10-85	1" = 40'
DRAWN BY	REVISIONS
K.B.T.	12-23-85
	2-20-86
	3-10-86 TEST
APPROVED BY:	
T. KRAIT	
DWG. NO	
SD-2	
3	
OF	
21	

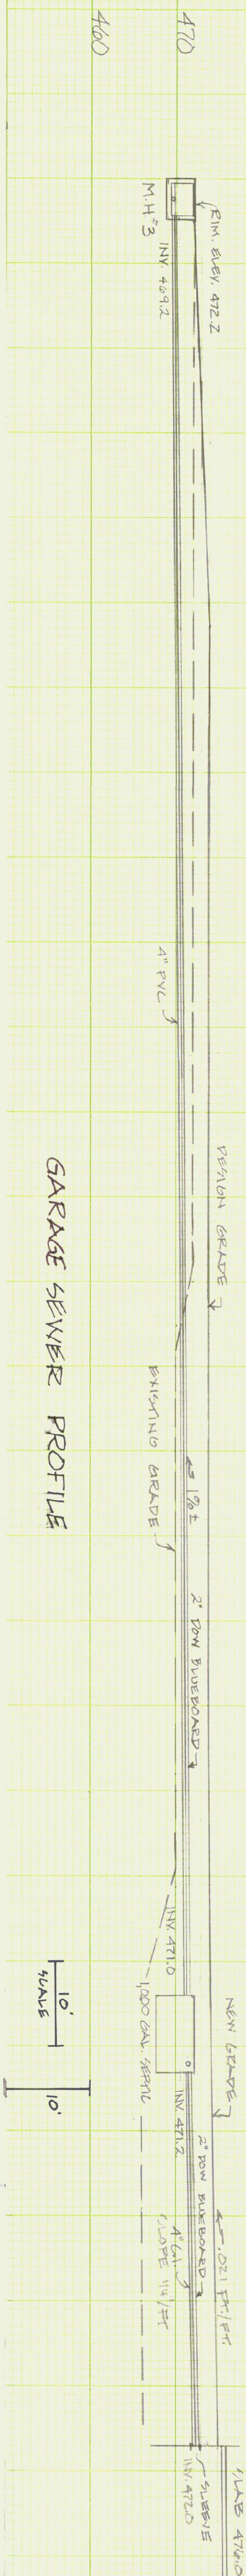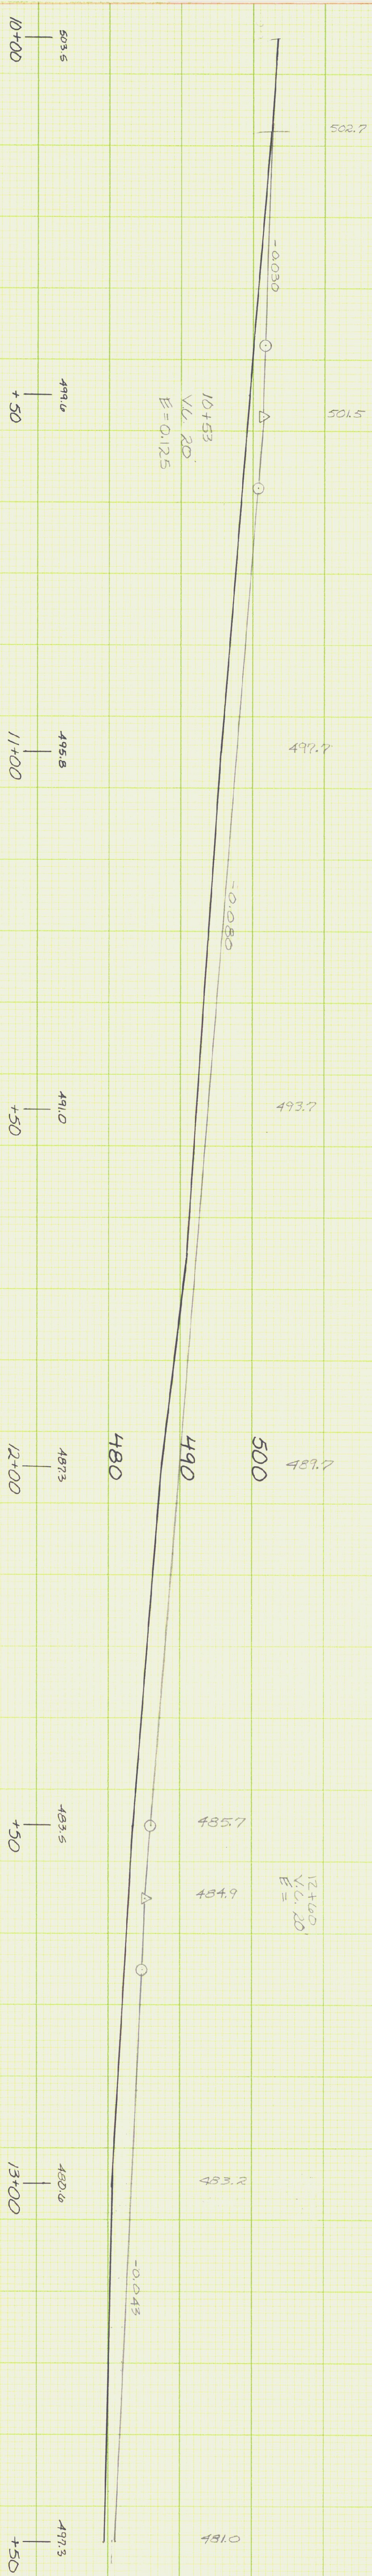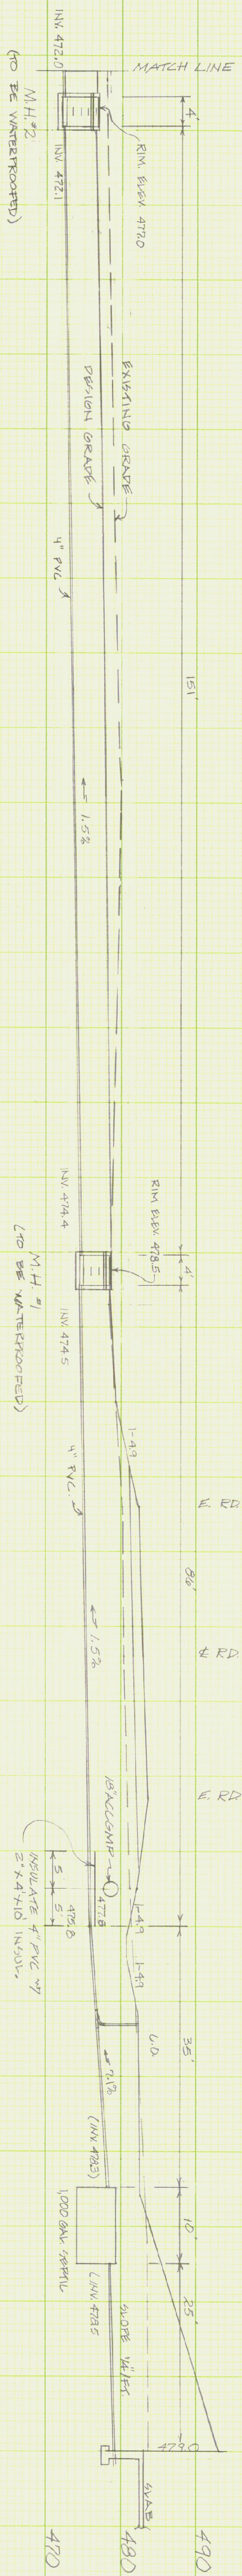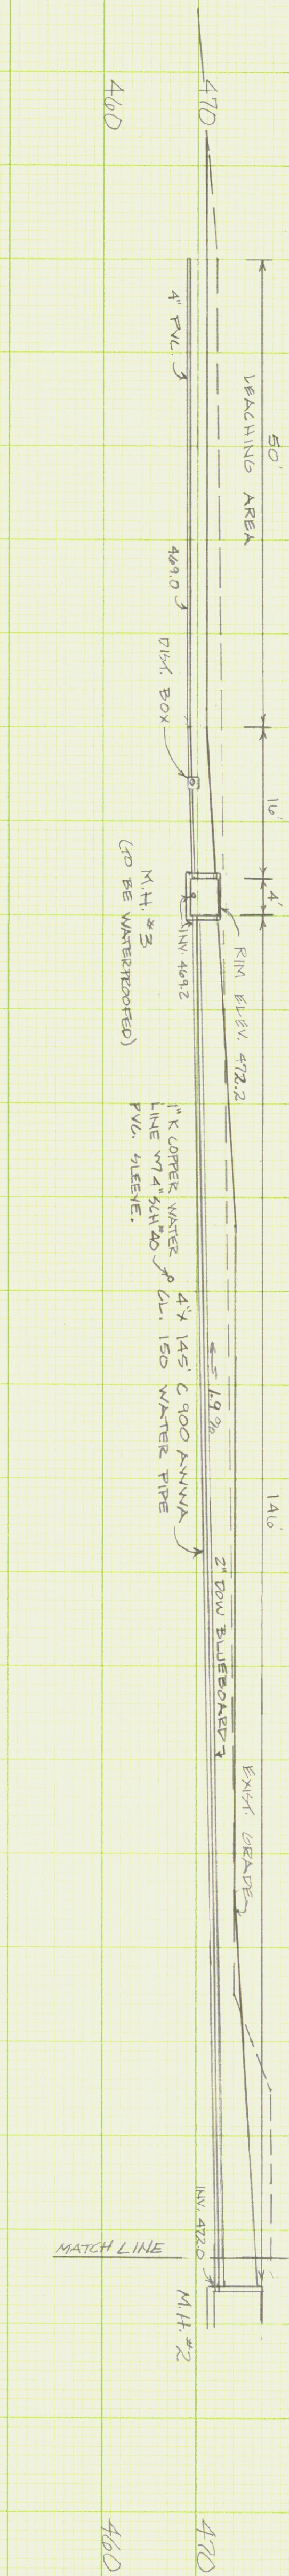






WATER LINE PROFILE
OFFICE BLDG. TO WELL

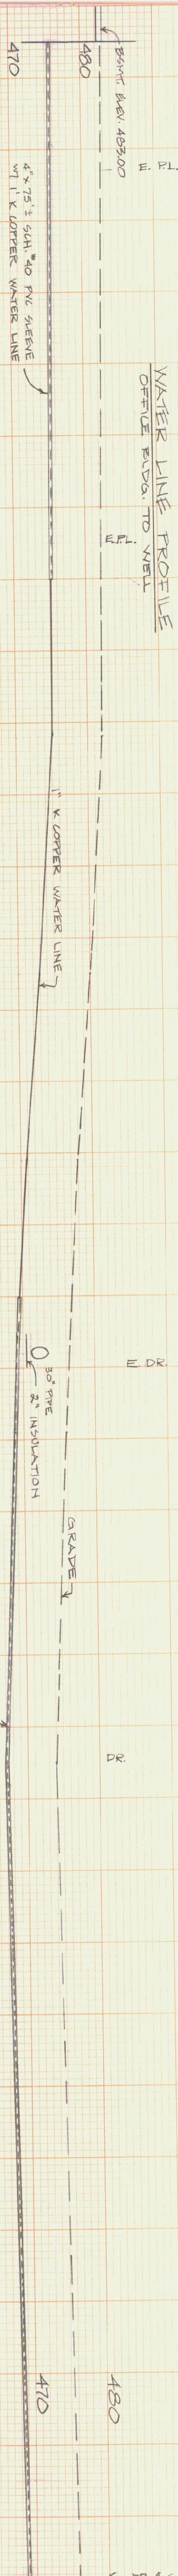

WATER LINE PROFILE
OFFICE BLDG. TO GARAGE

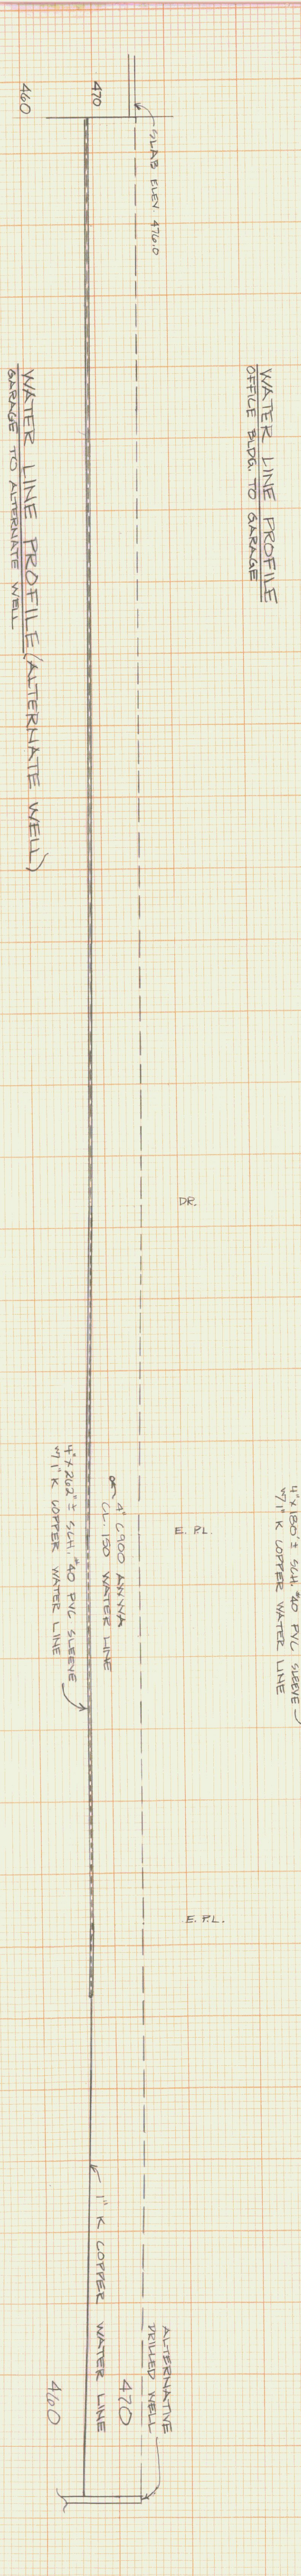

WATER LINE PROFILE (ALTERNATE WELL)
GARAGE TO ALTERNATE WELL

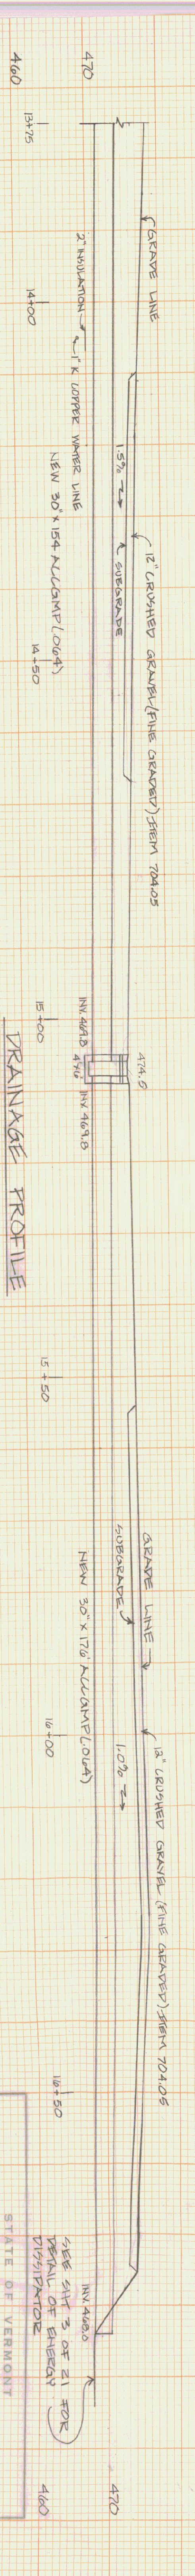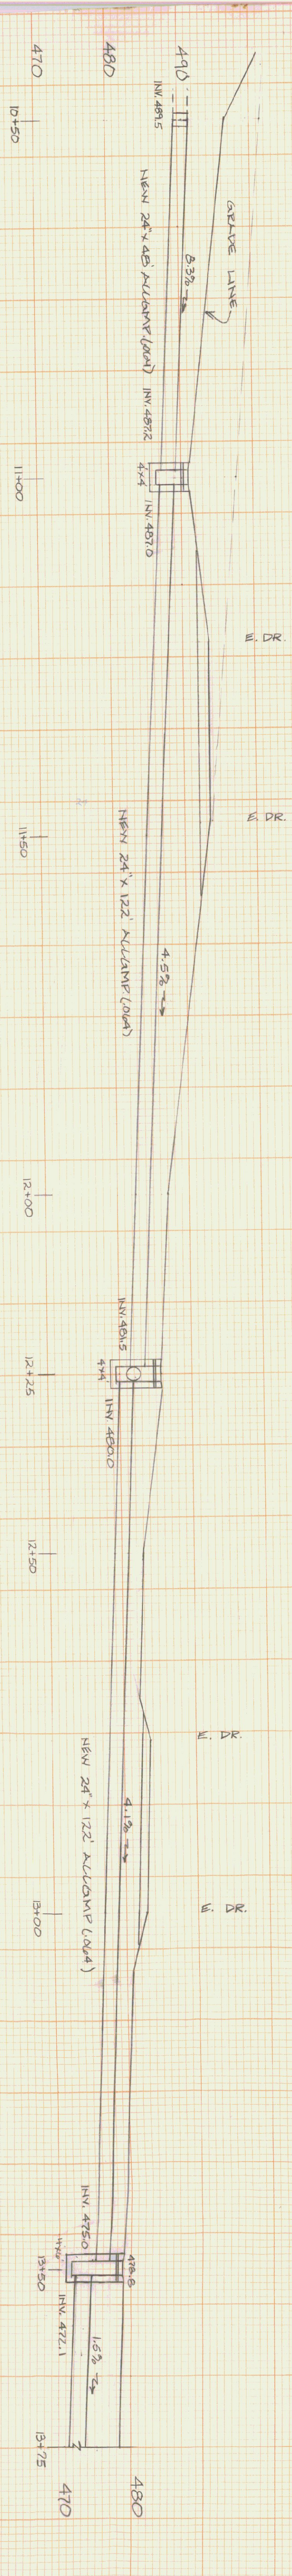

DRAINAGE PROFILE

STATE OF VERMONT

DEPARTMENT OF STATE BUILDINGS

AGENCY OF ADMINISTRATION

MONTPELIER

VERMONT

AGENCY OF TRANSPORTATION

11 BAY MAINTENANCE GARAGE

WATER LINE PROFILE

DIVISION OF TRANSPORTATION

VERMONT

DATE: 03-10-88

SCALE: 1"=10'



REVISIONS: 4-1-86










DWG. NO: 5D-5

DRAWN BY: K. TENDERLOTT

CHECKED BY: F. TENDERLOTT

5-A OF 21

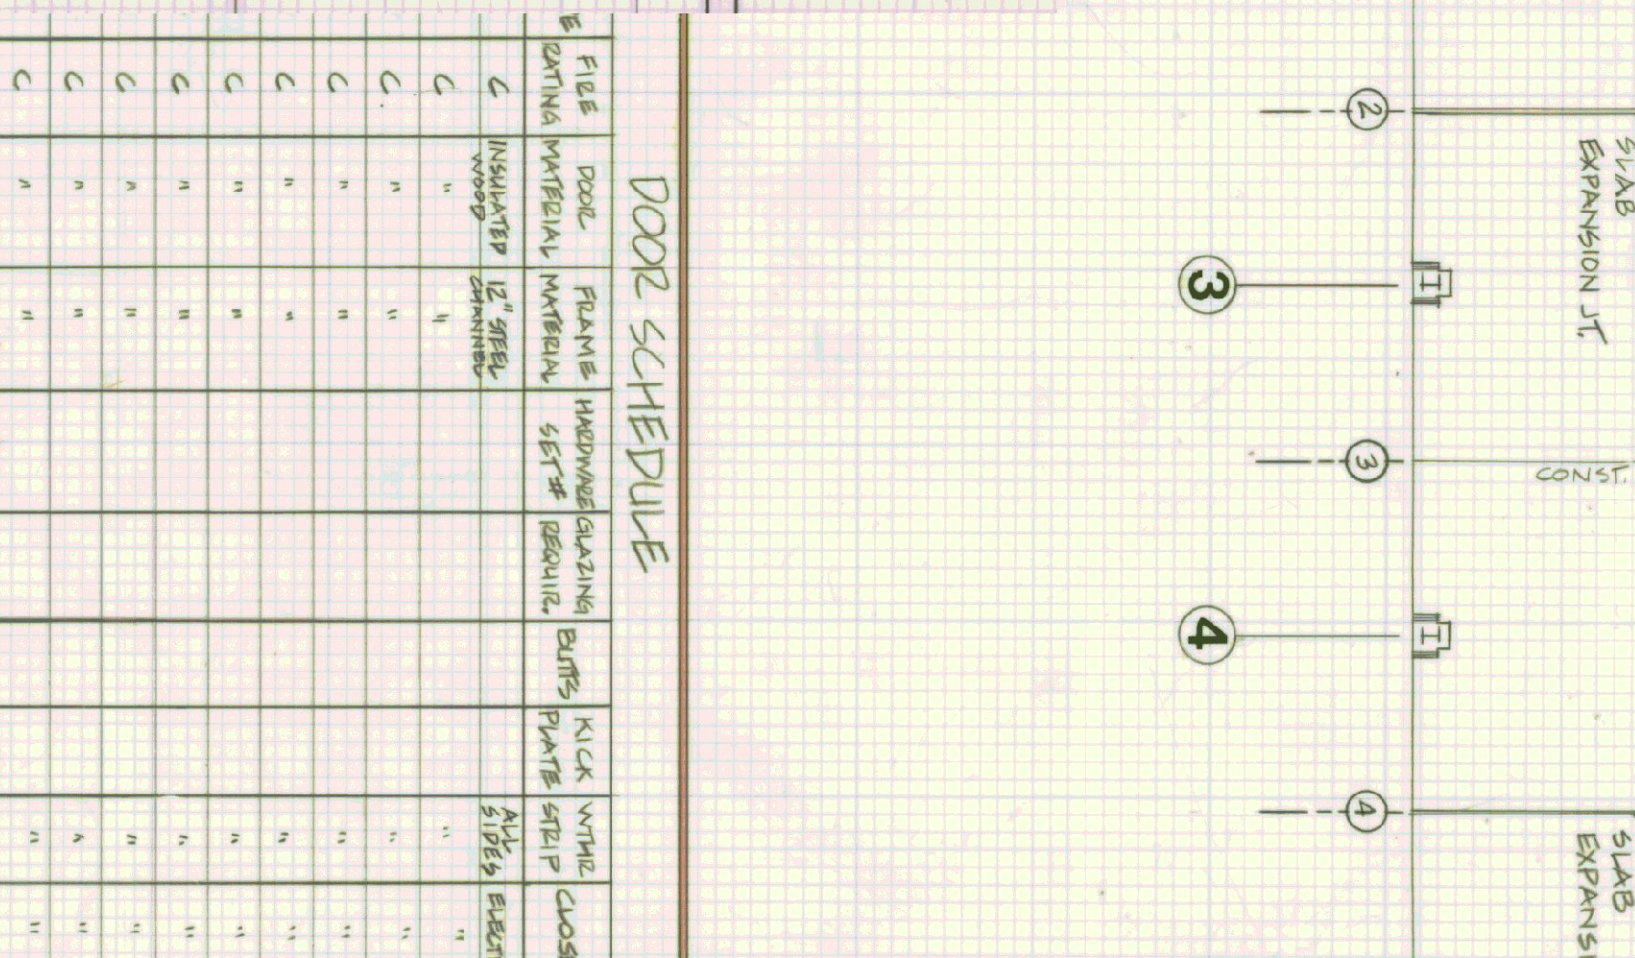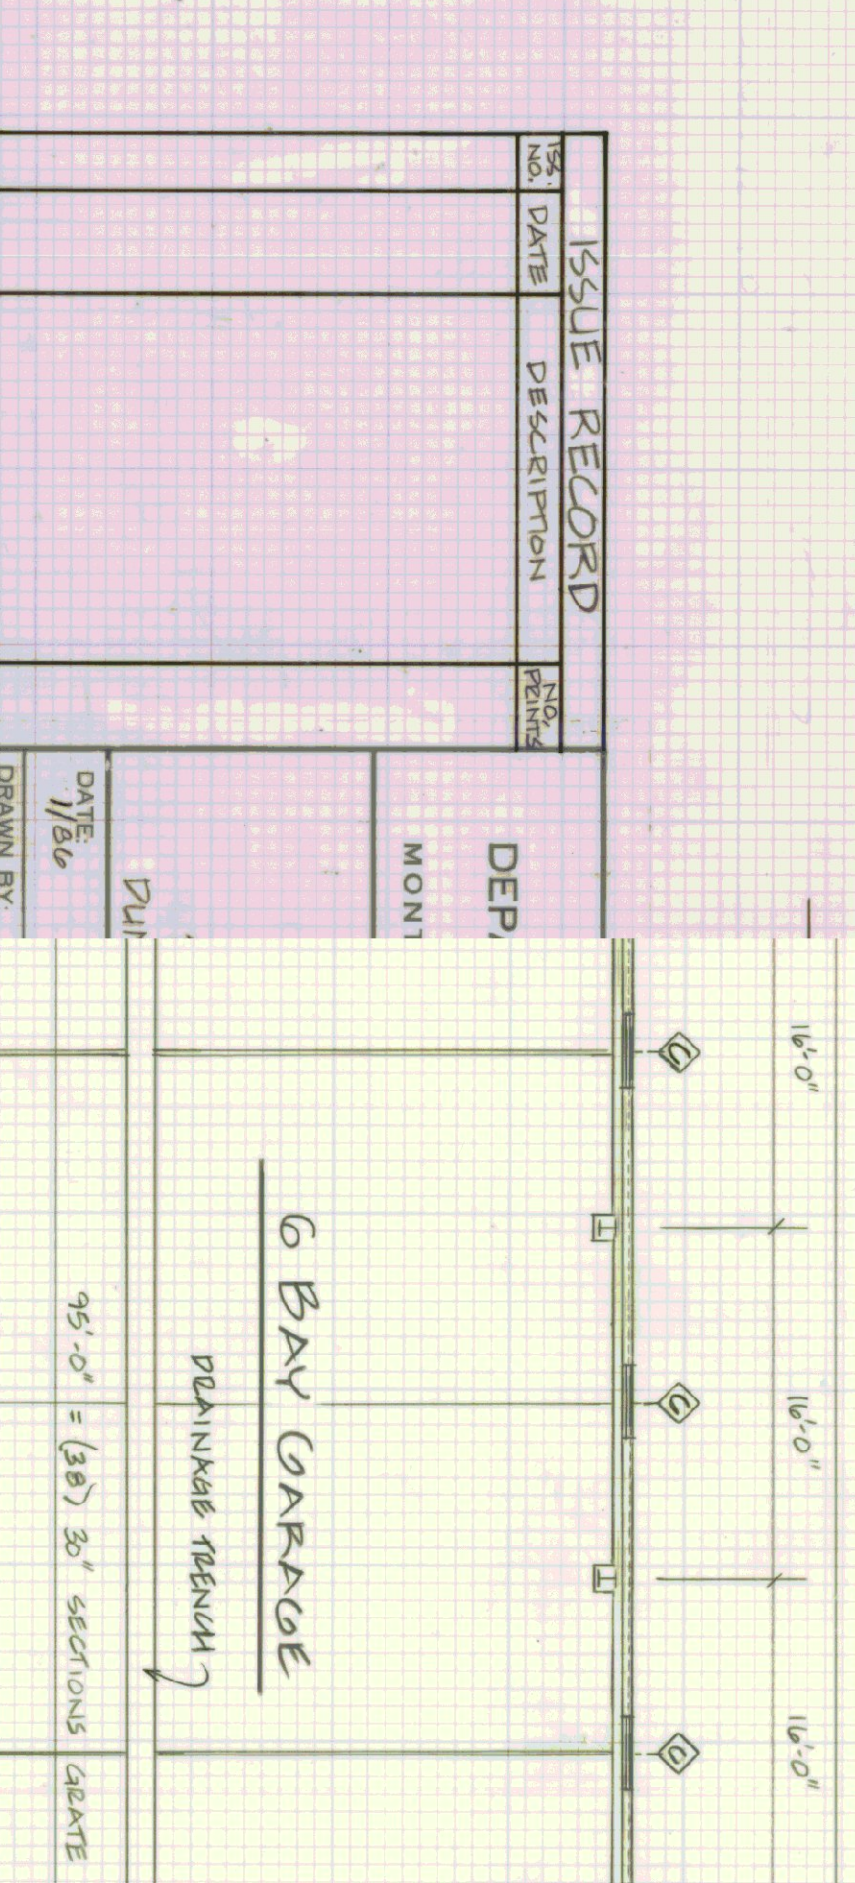[illegible]

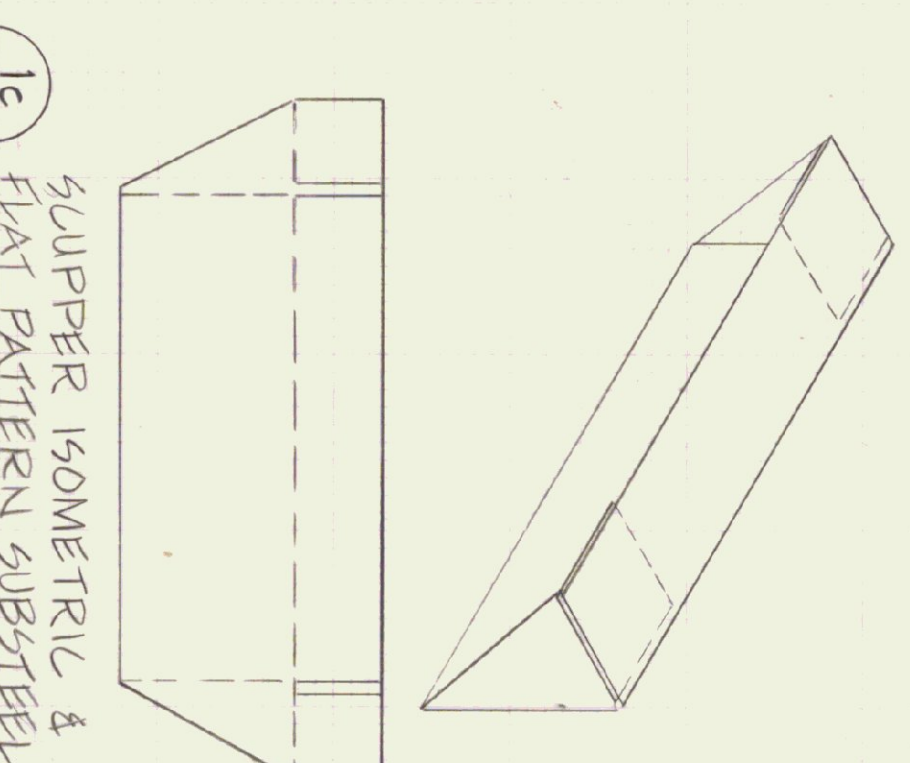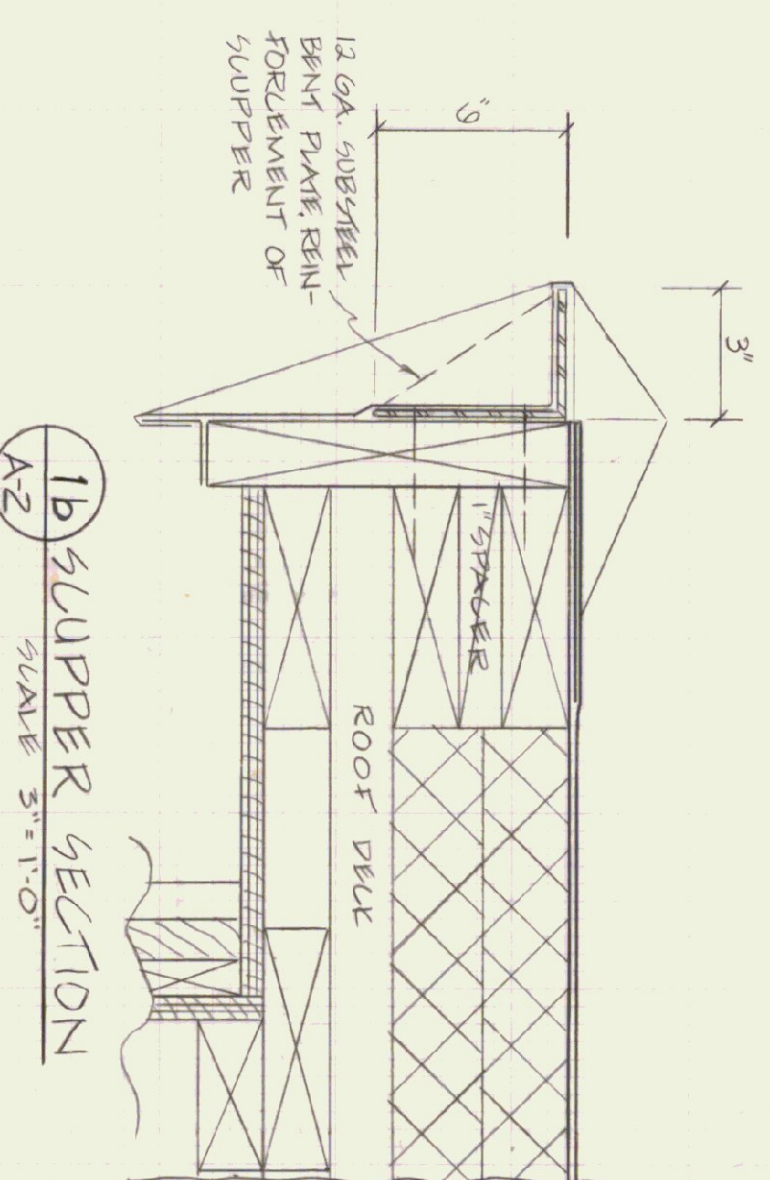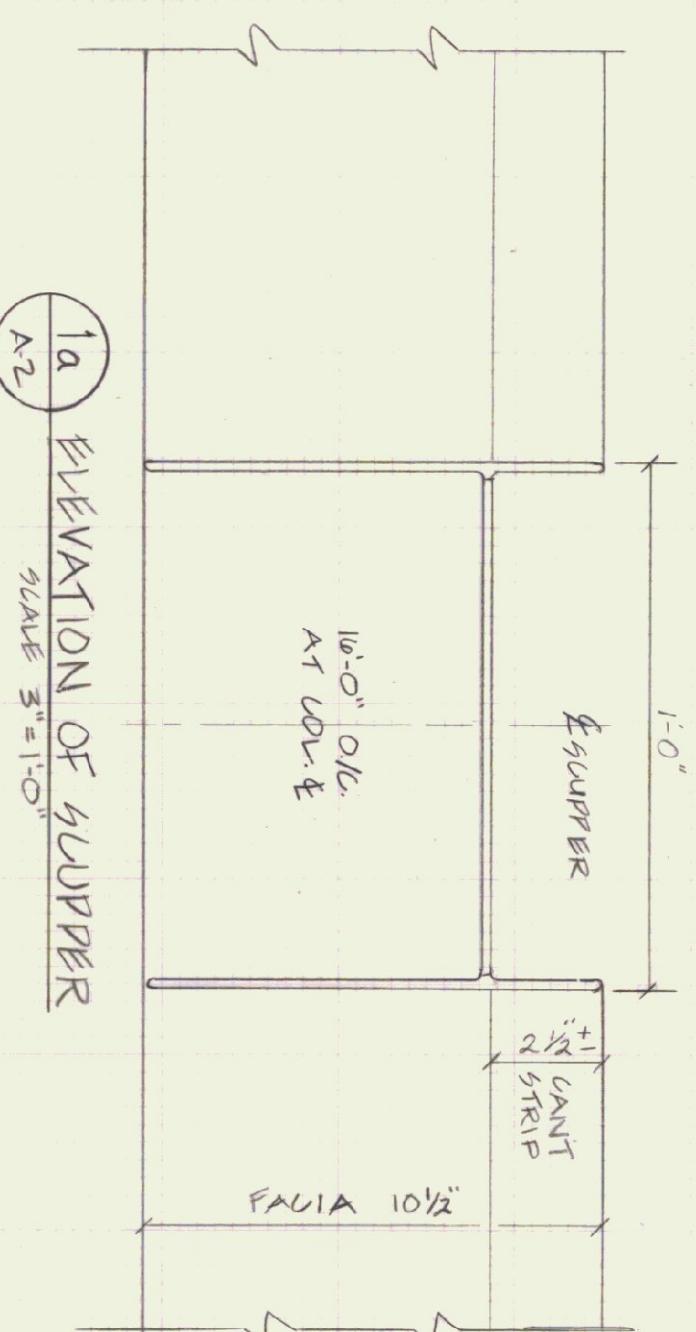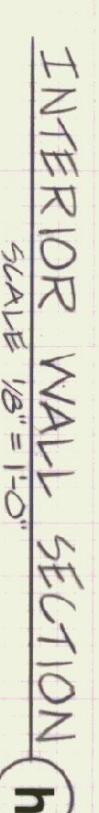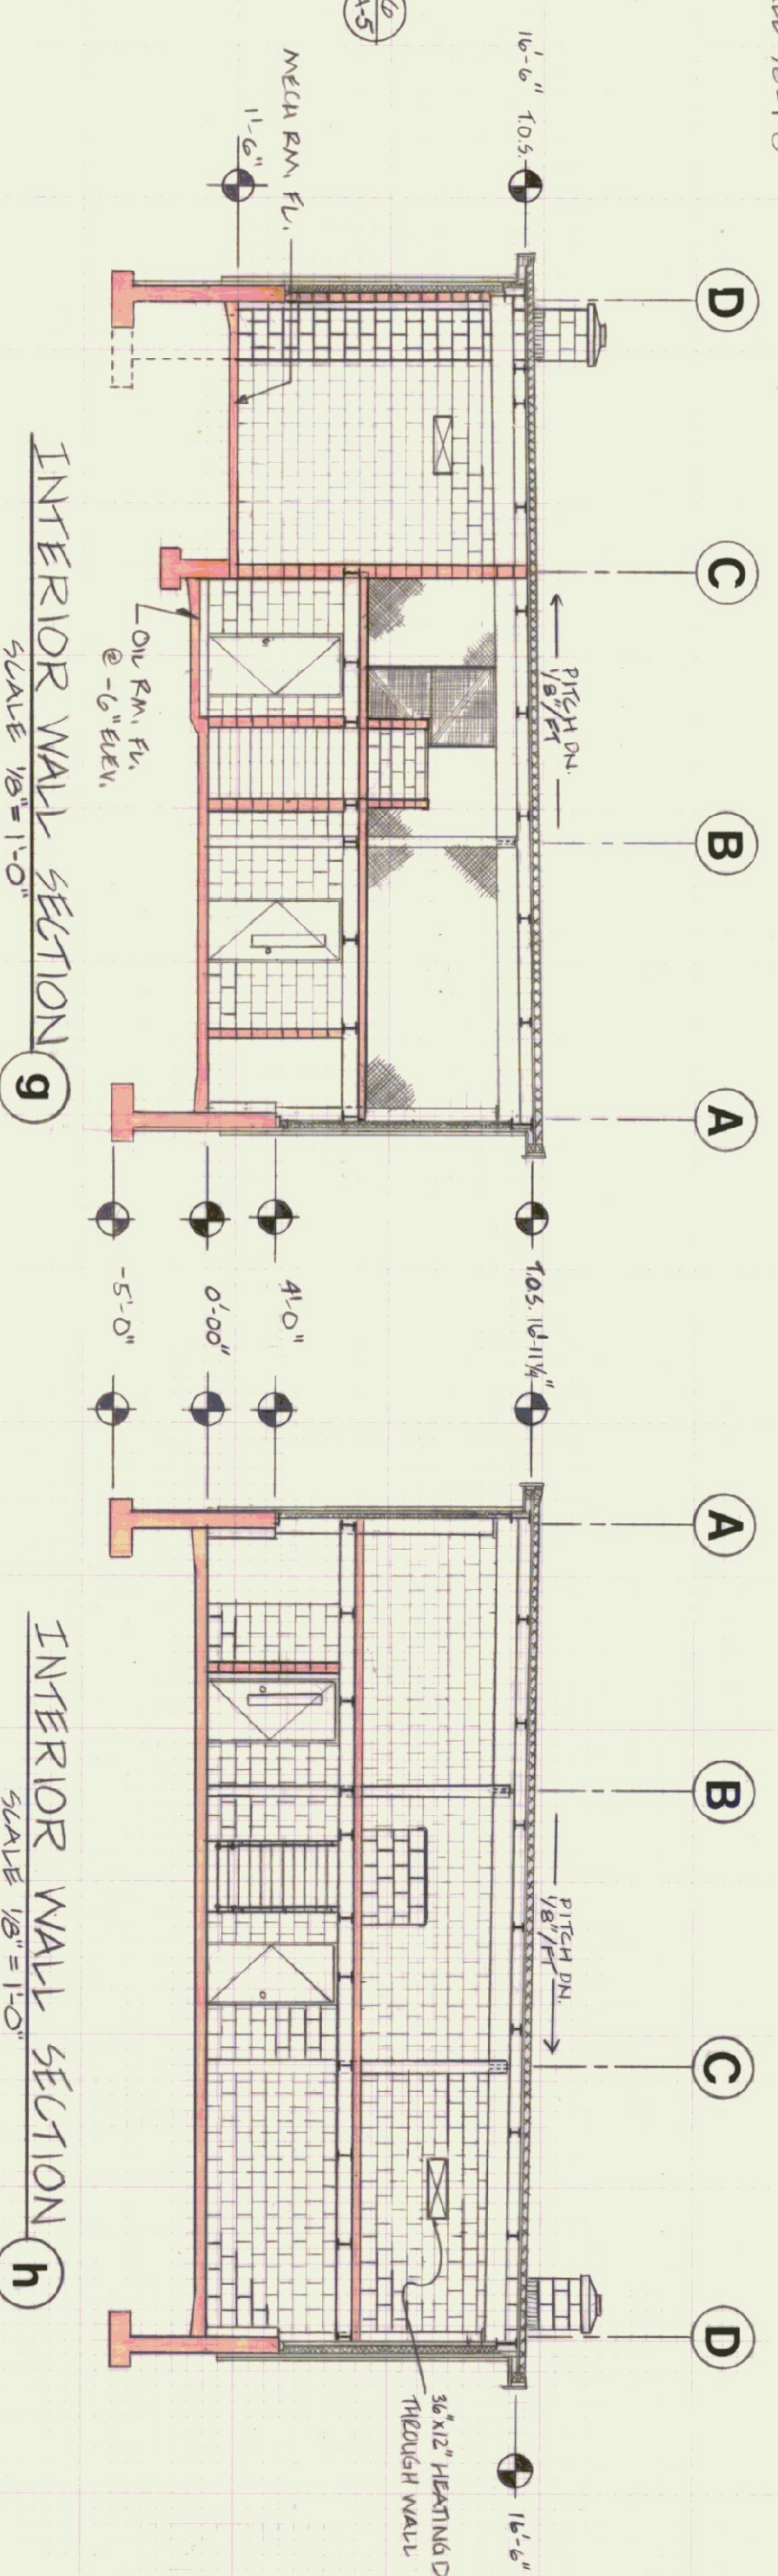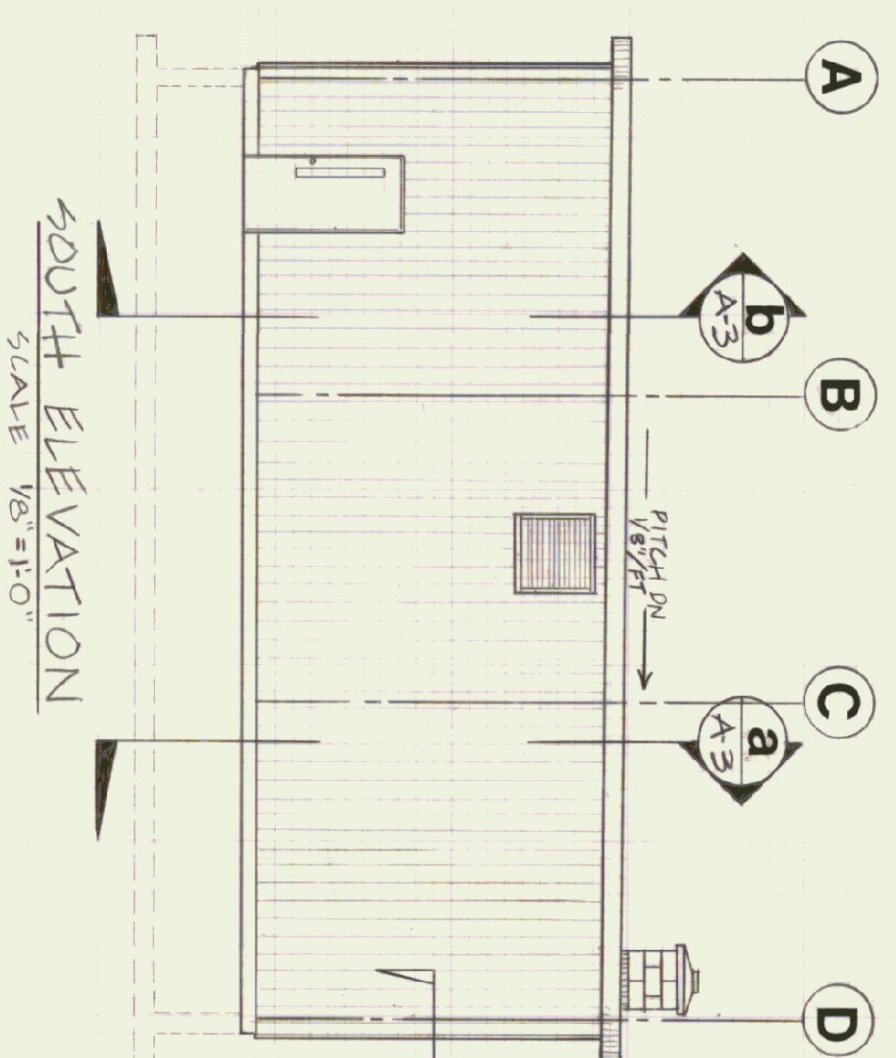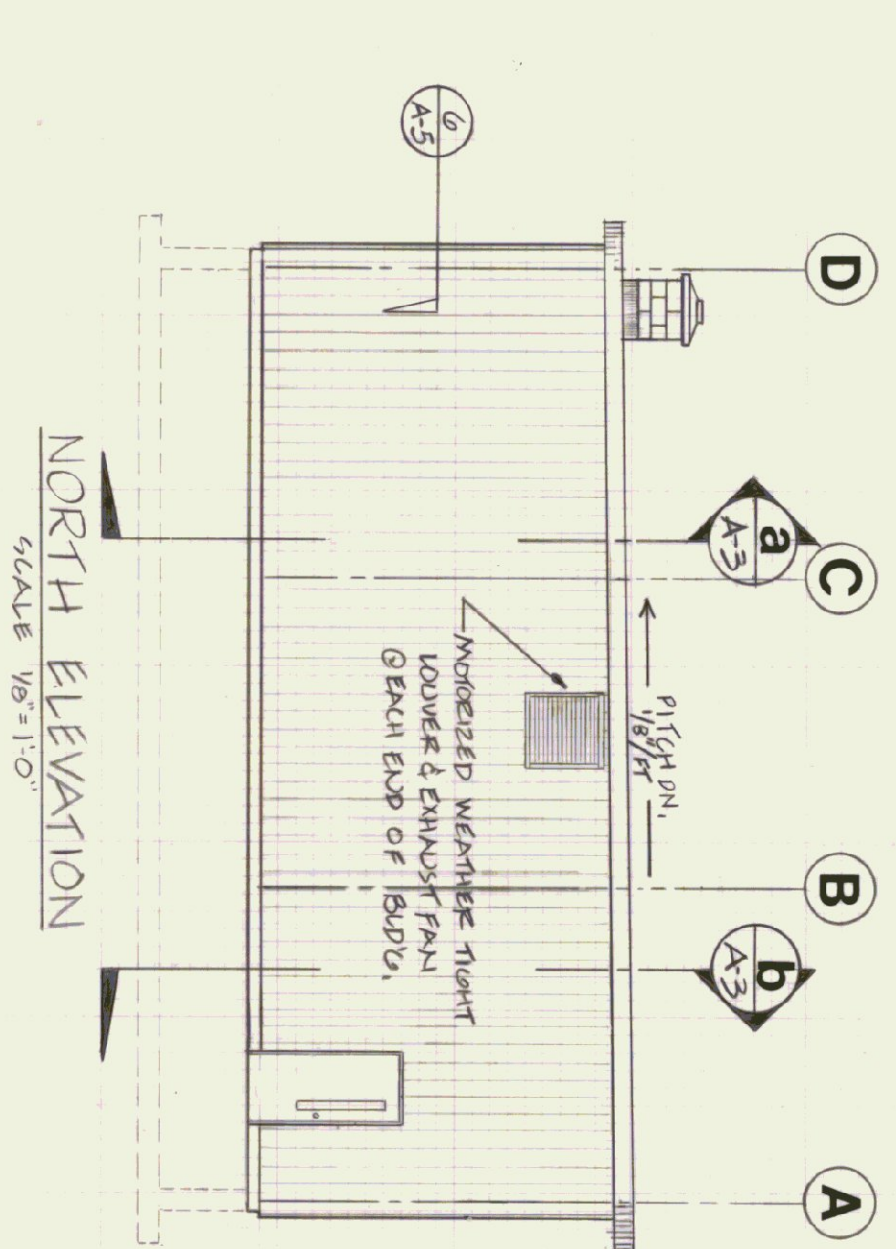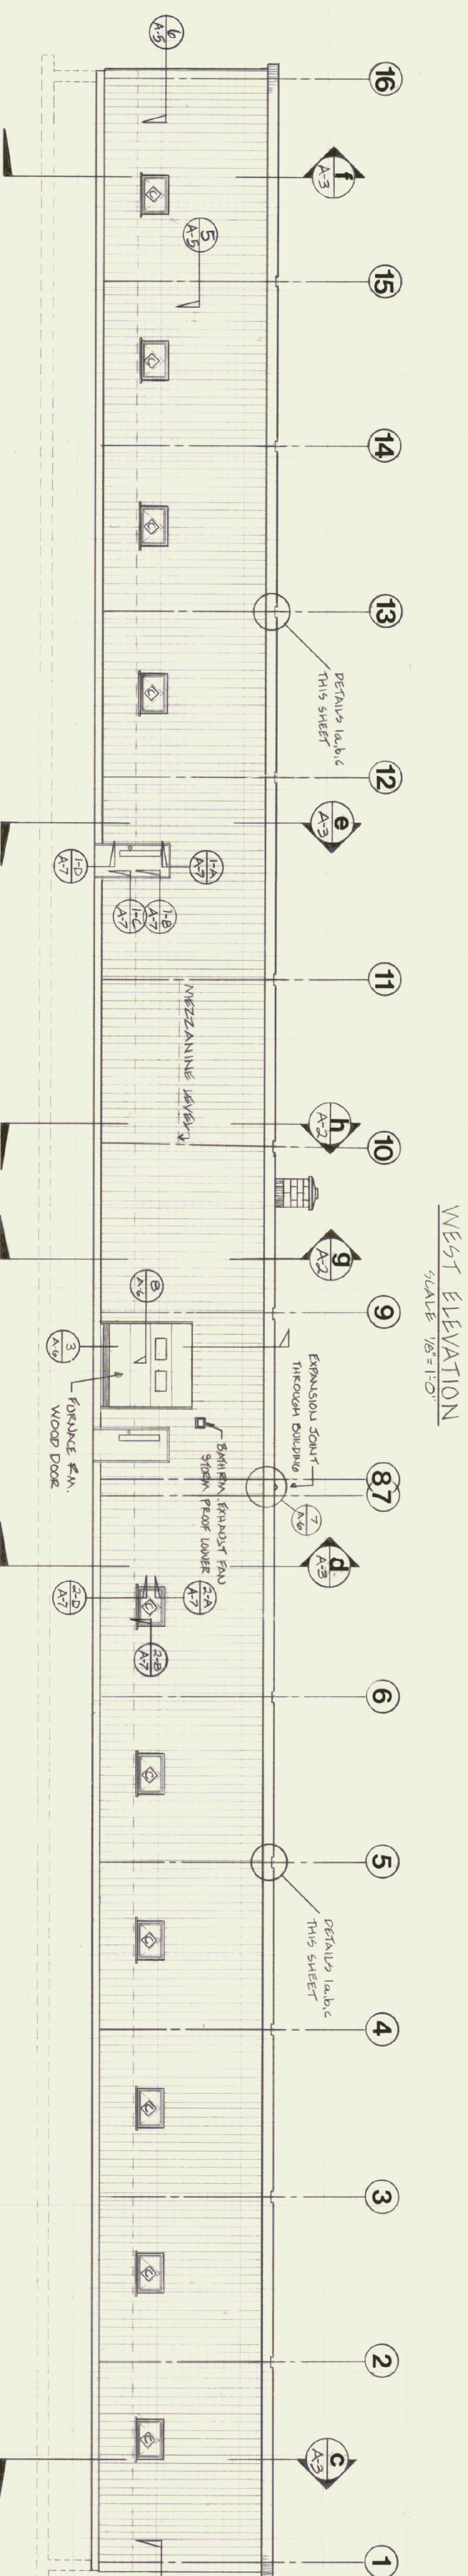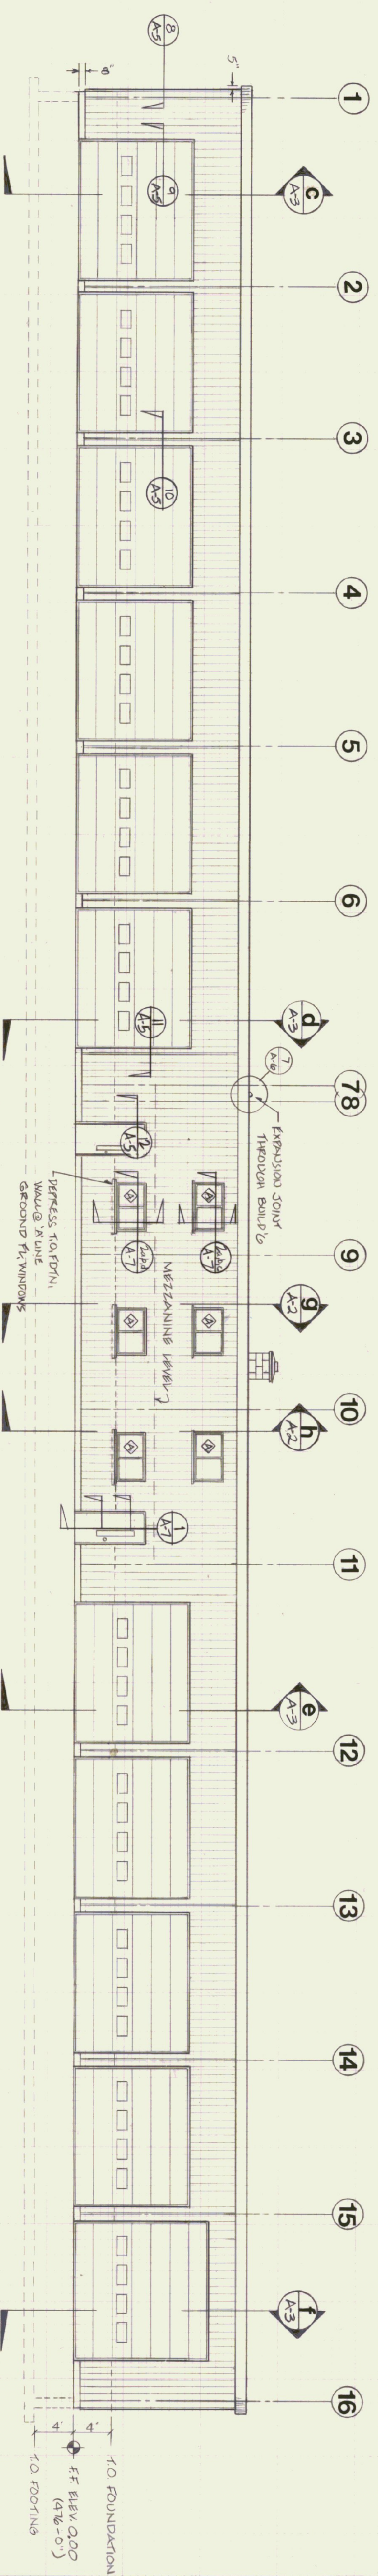


ISSUE RECORD			
ISS. NO.	DATE	DESCRIPTION	NO. PRINT.



STATE OF VERMONT
DEPARTMENT OF STATE BUILDINGS
AGENCY OF ADMINISTRATION
MONTPELIER, VERMONT


EXTERIOR ELEVATIONS & SECTIONS

AGENCY OF TRANSPORTATION 11 BAY MAINTENANCE GARAGE DUMMESTON, VERMONT PISTOLCT 2	
DATE 1/8/60	SCALE AS NOTED
DRAWN BY T. TREVAILL	APPROVED BY T. TREVAILL
REVISIONS:	
DWG. NO. A-2	
7 OF 21	

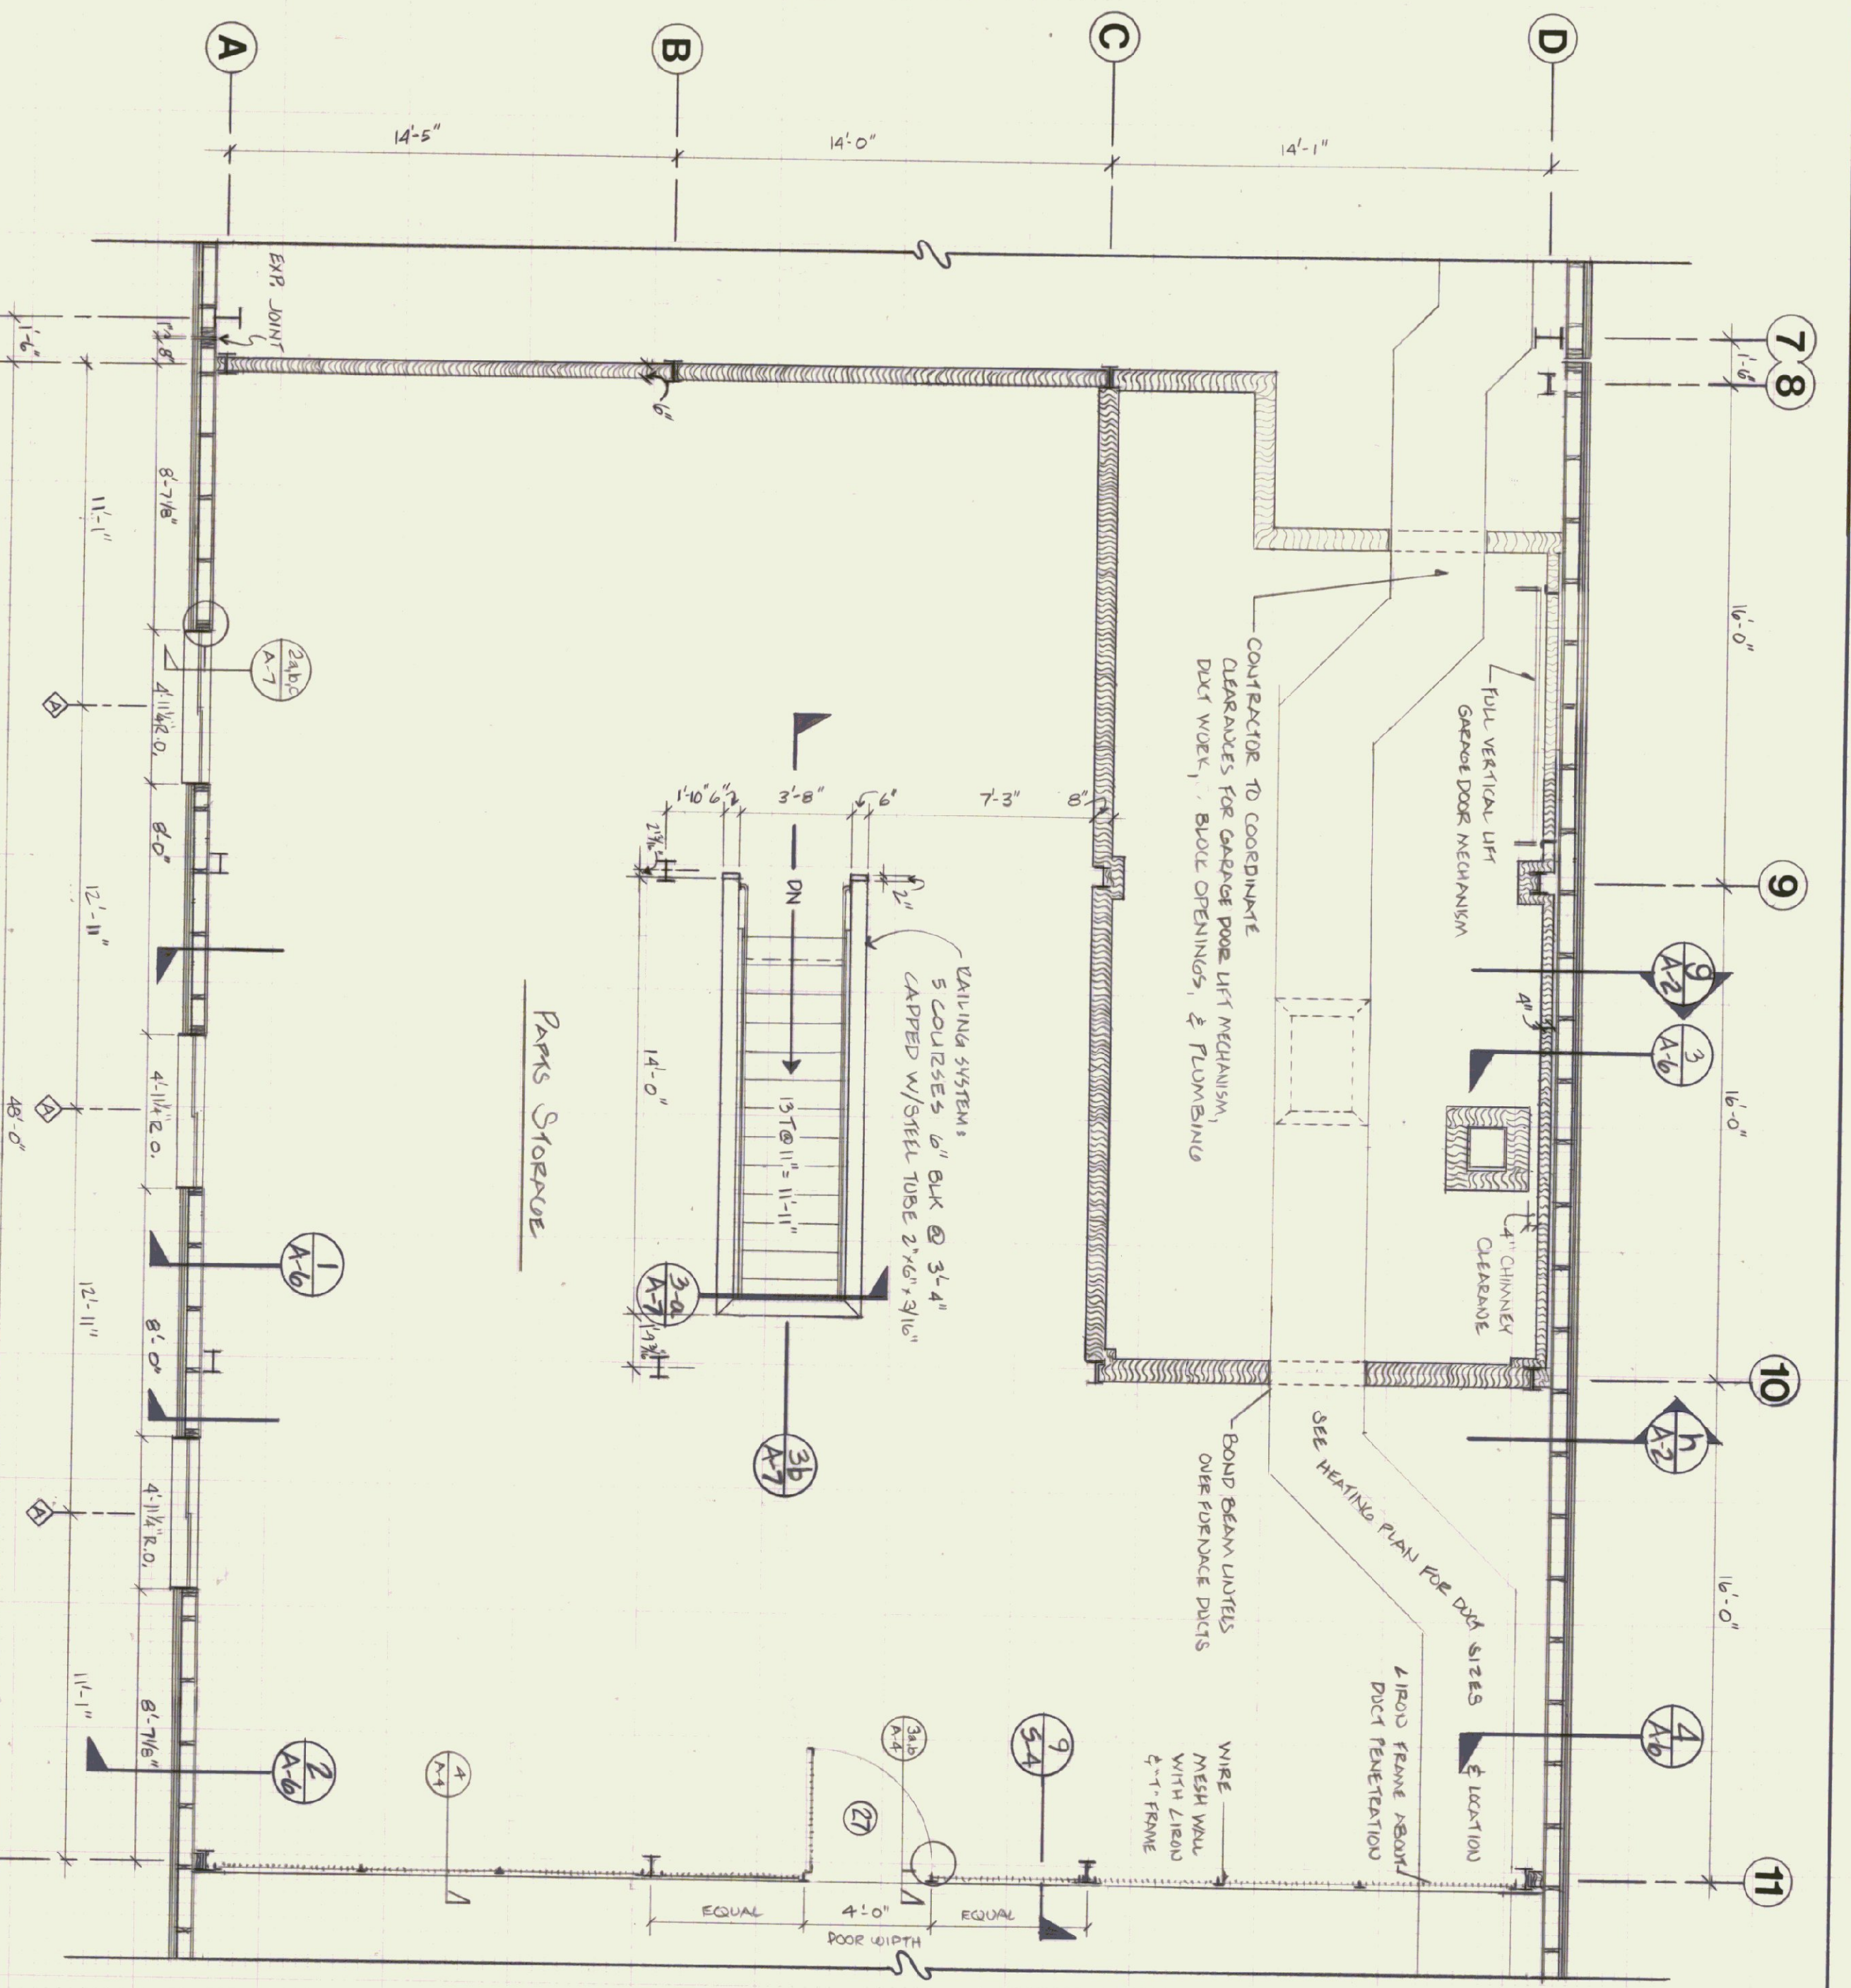
















CORE PLAN - MEZZANINE LEVEL

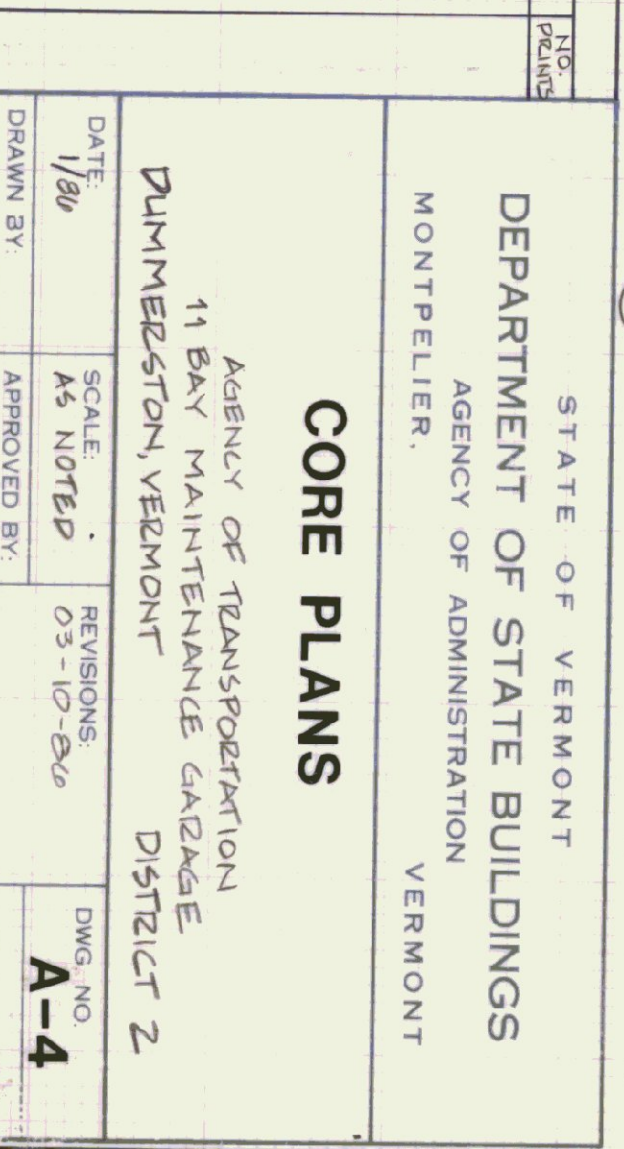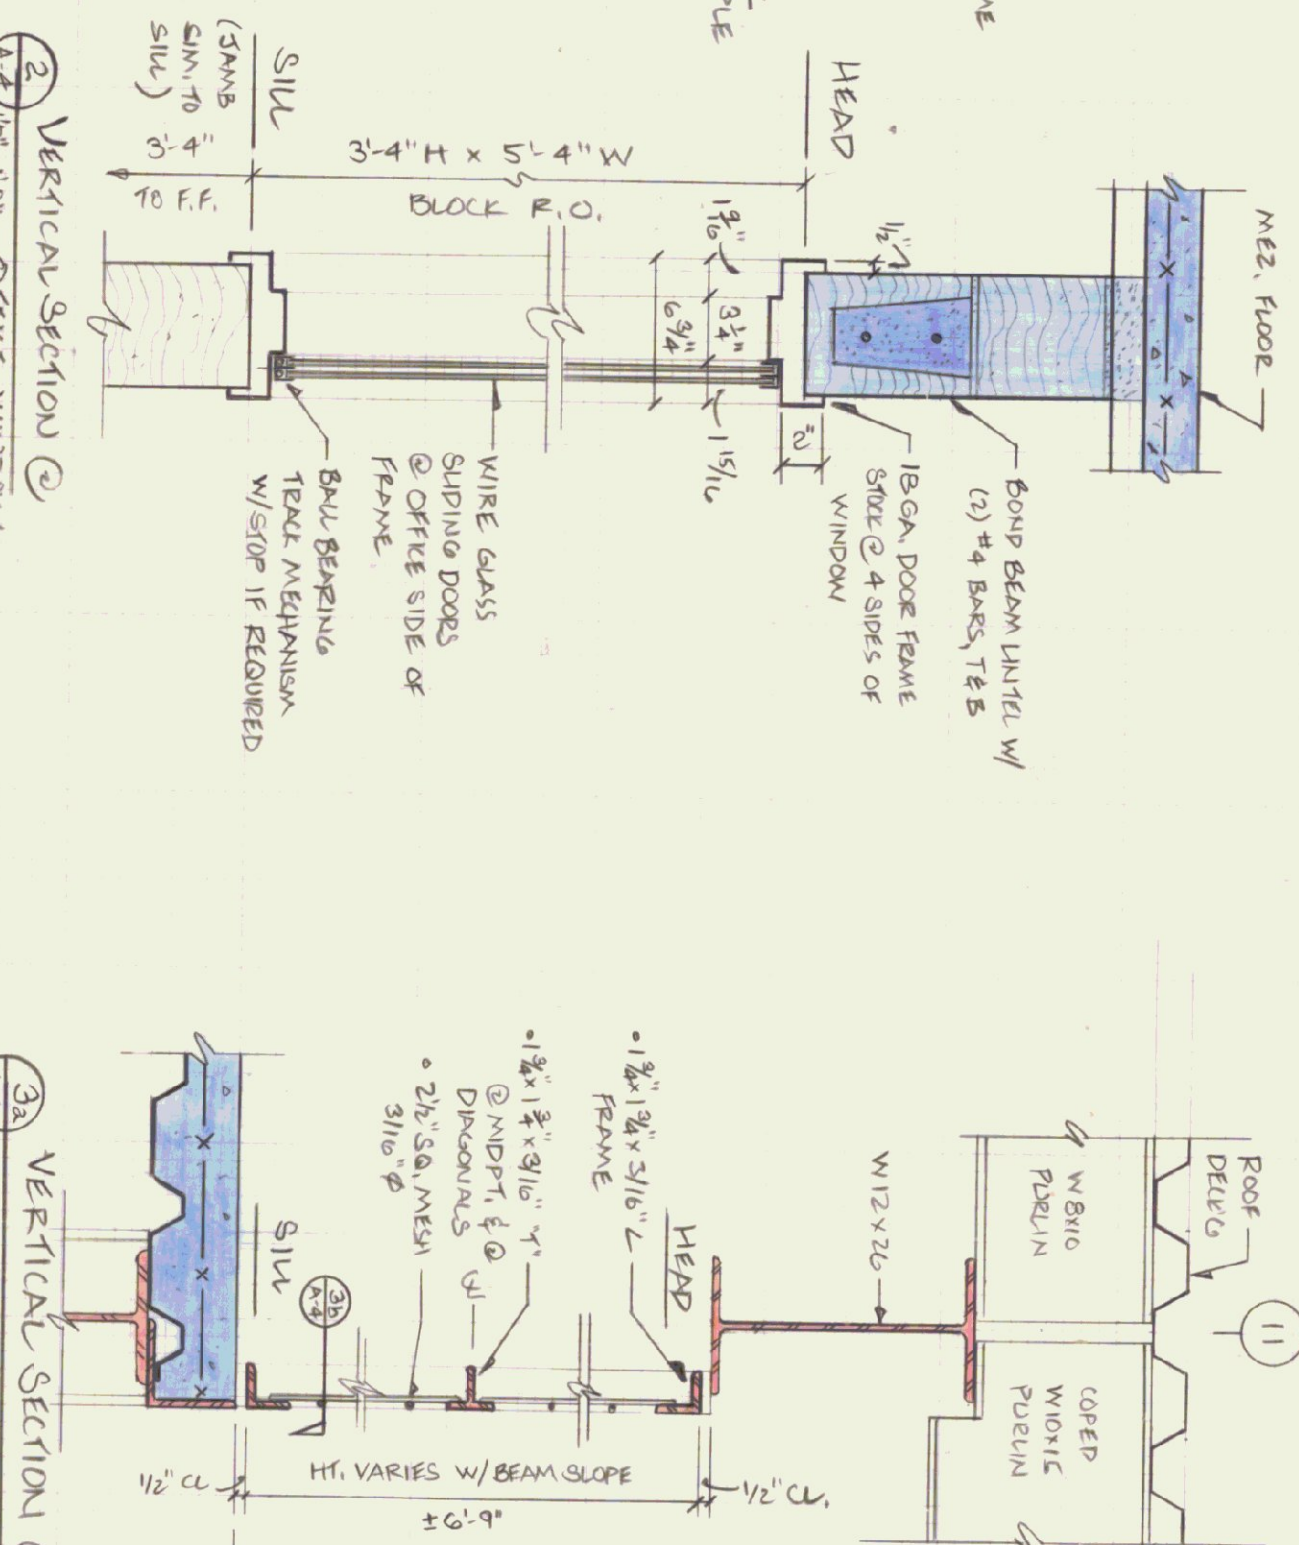

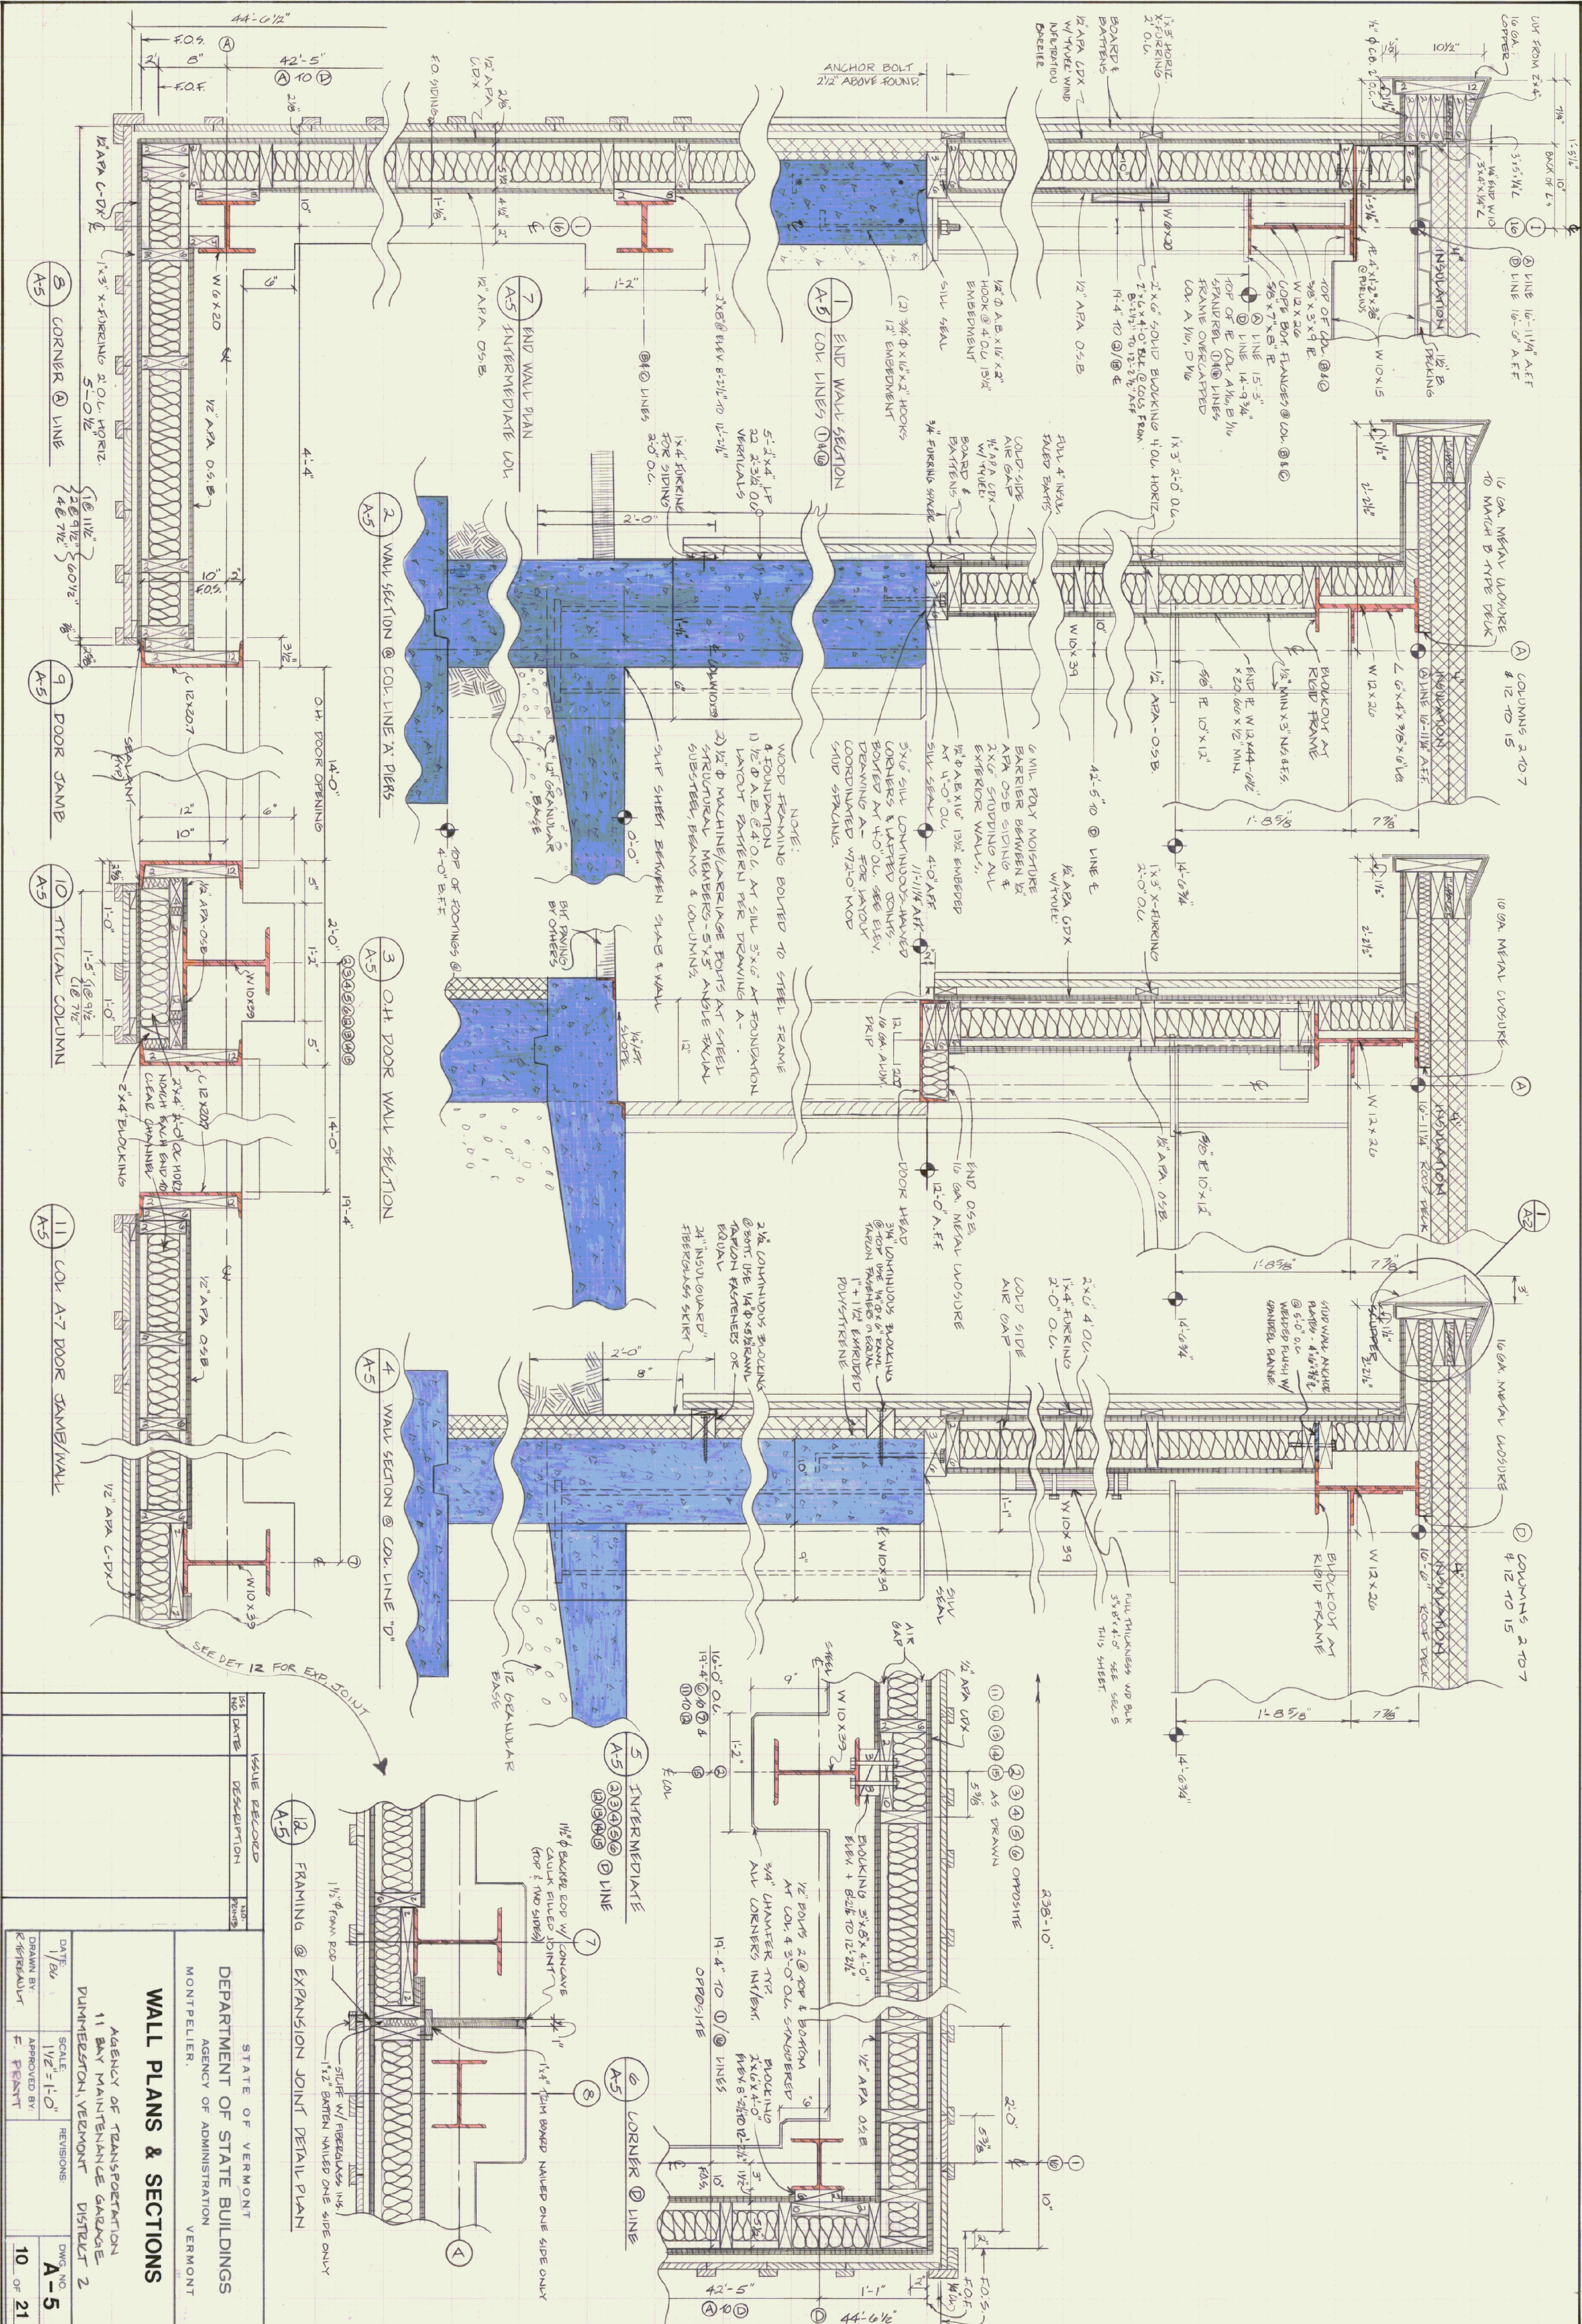

ISSUE RECORDED		NO. REVISIONS	
NO.	DATE	DESCRIPTION	REVISIONS
1	1/1/00	11 BAY MAINTENANCE GARAGE	1
2	1/1/00	11 BAY MAINTENANCE GARAGE	2


STATE OF VERMONT	DEPARTMENT OF STATE BUILDINGS
AGENCY OF ADMINISTRATION	VERMONT
WALL PLANS & SECTIONS	
AGENCY OF TRANSPORTATION	
11 BAY MAINTENANCE GARAGE	
DISTRICT 2	
DATE: 1/1/00	SCALE: 1/2" = 1'-0"
DRAWN BY: R. F. FENNT	APPROVED BY: F. FENNT
DWG. NO. A-5	10 OF 21

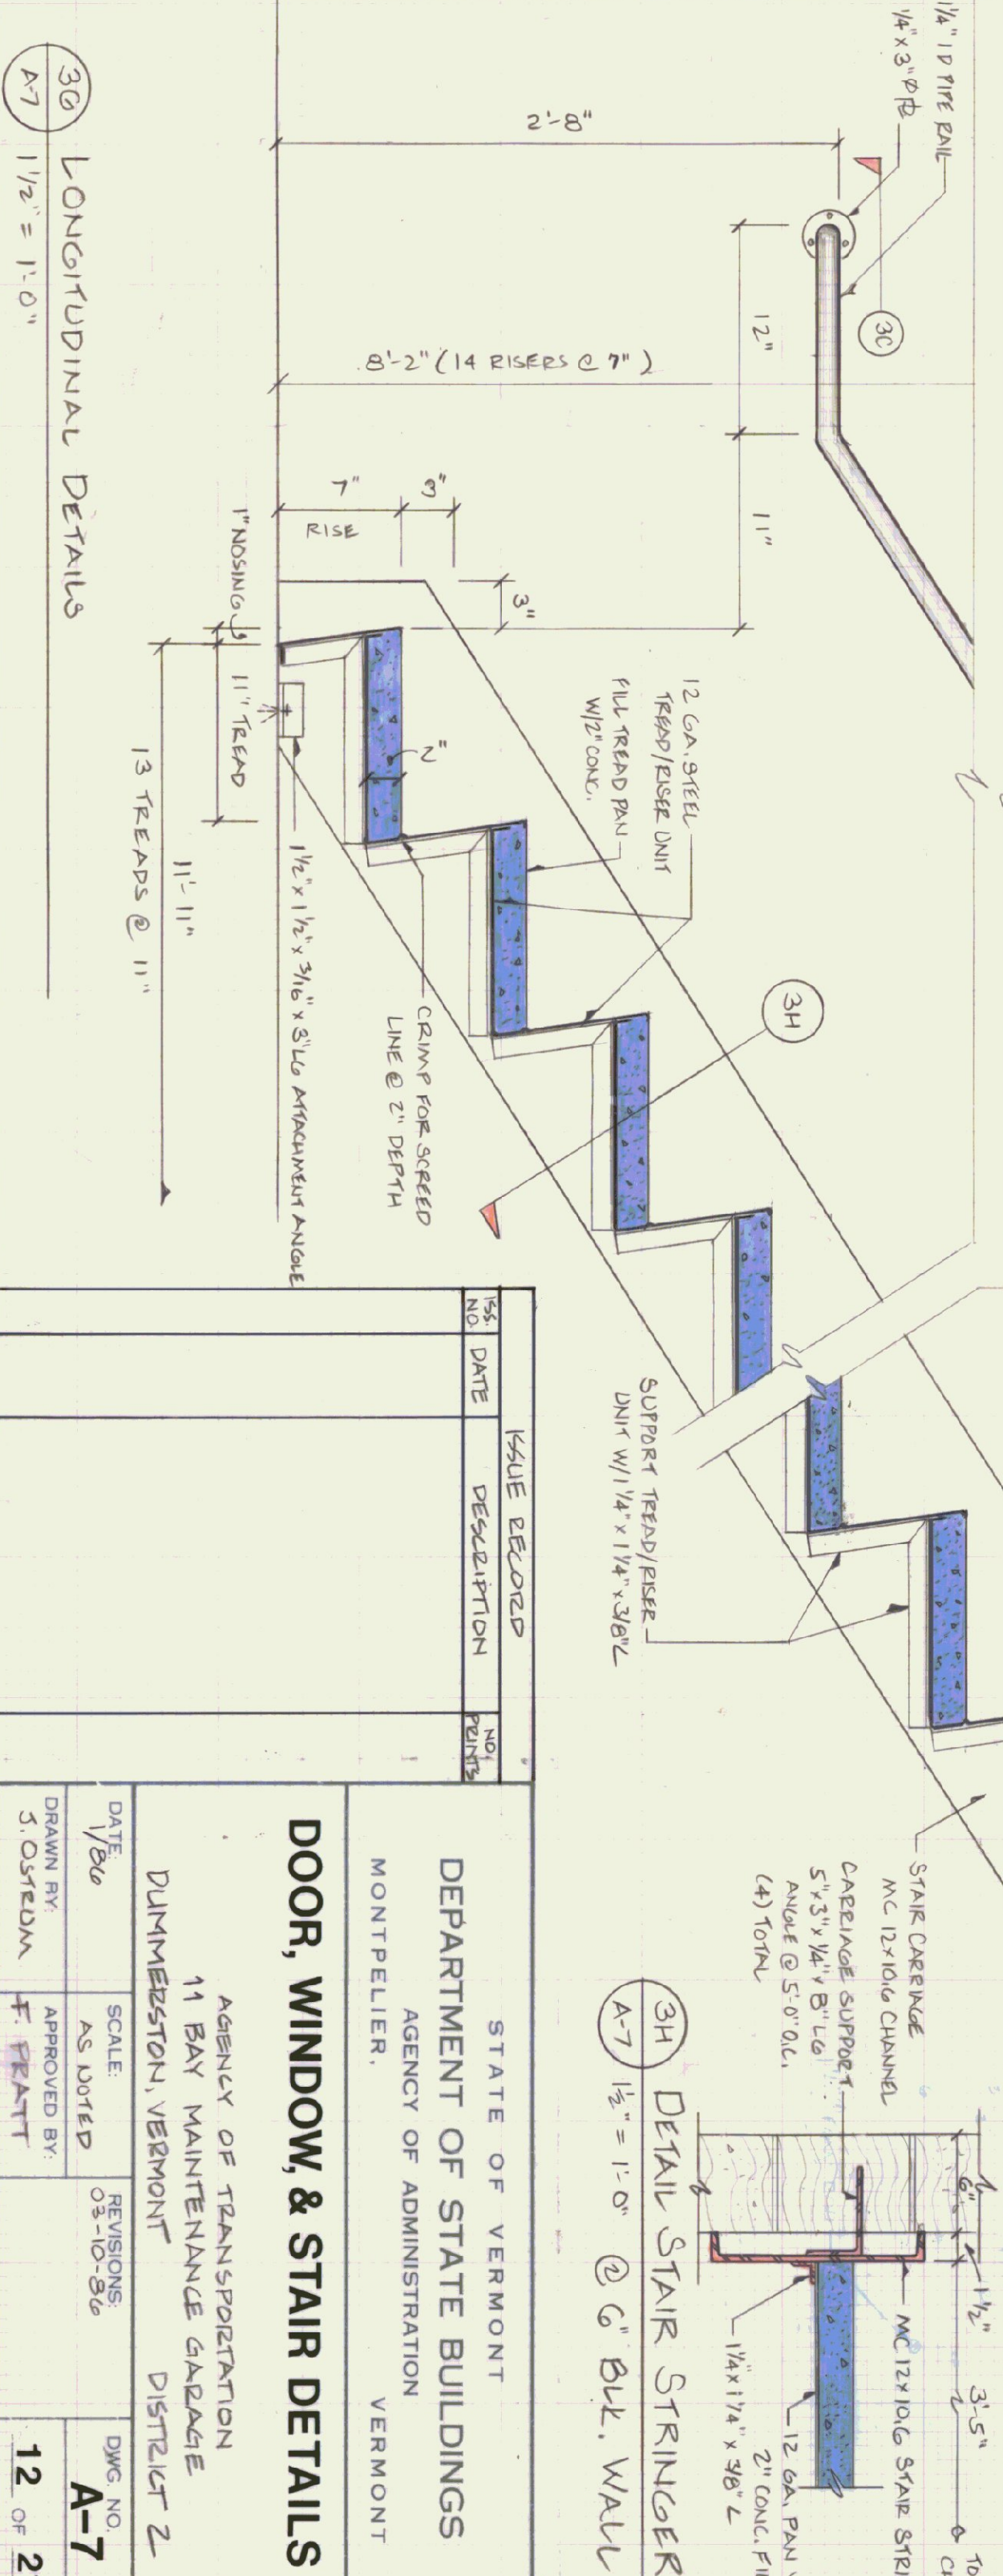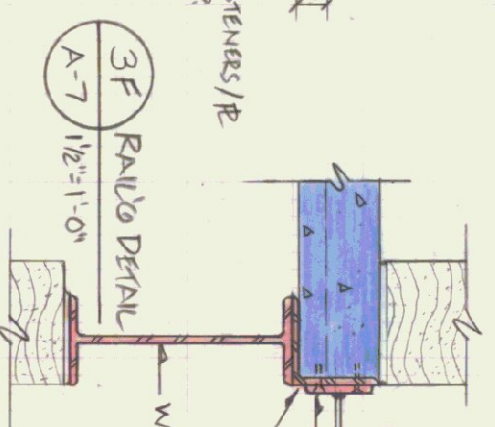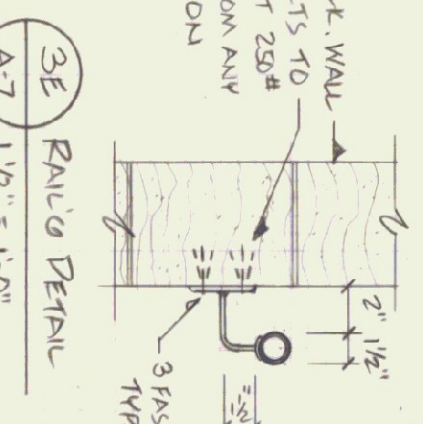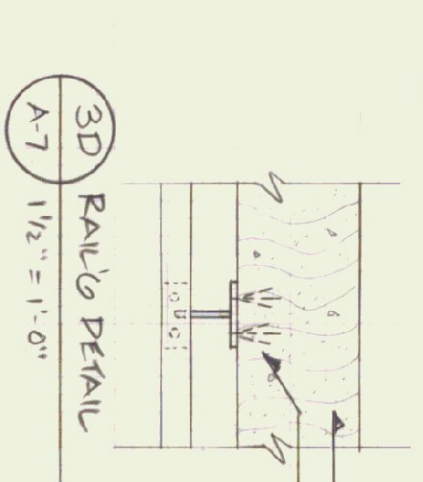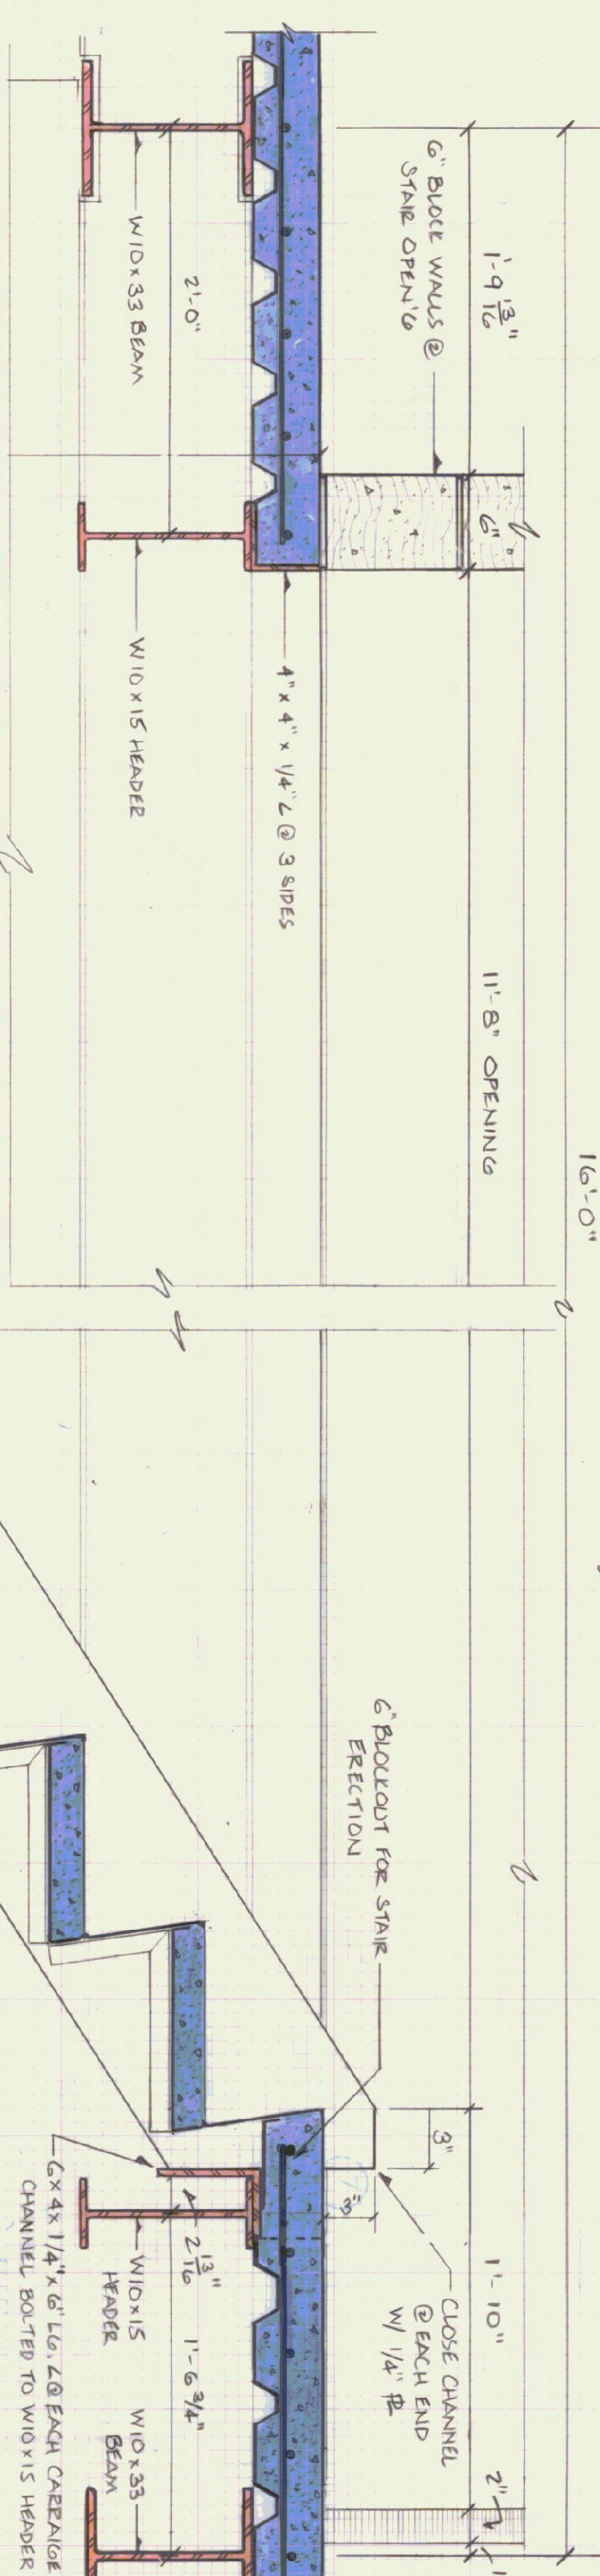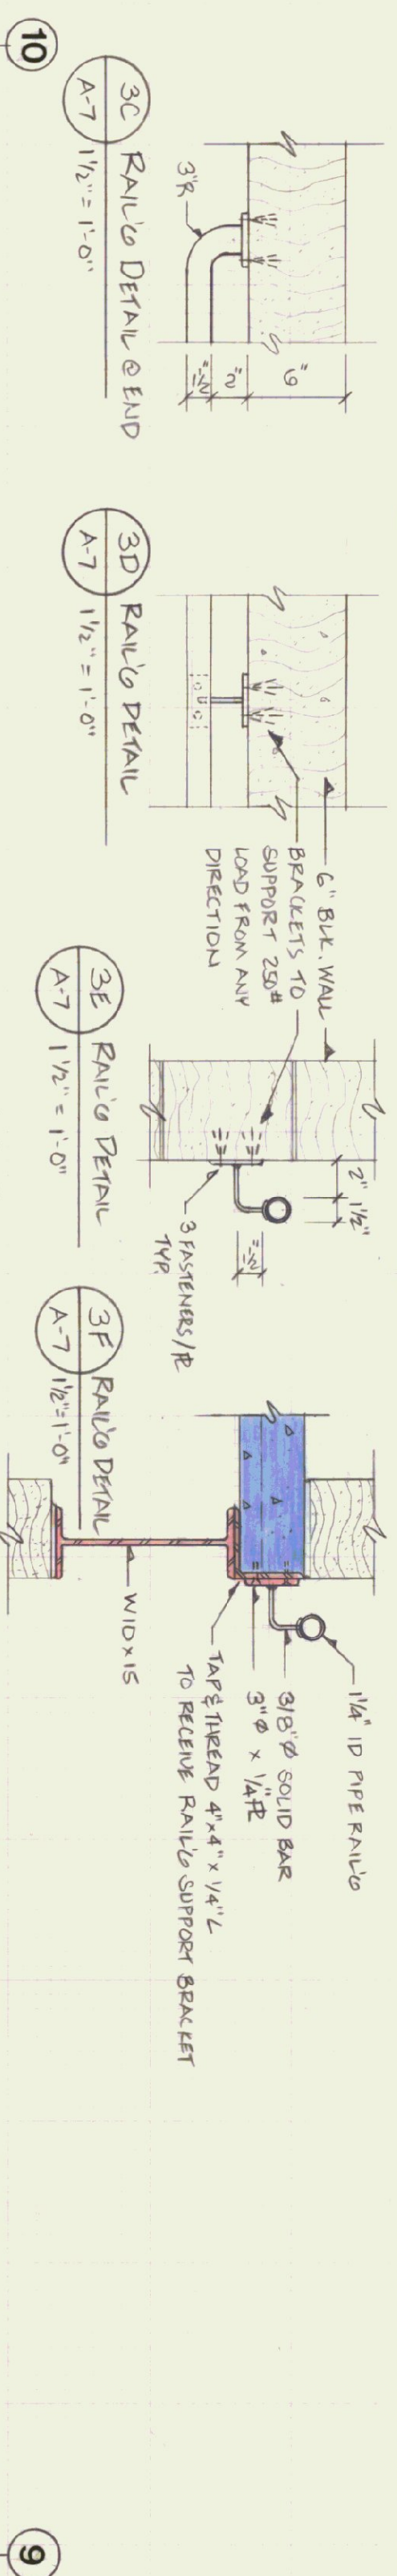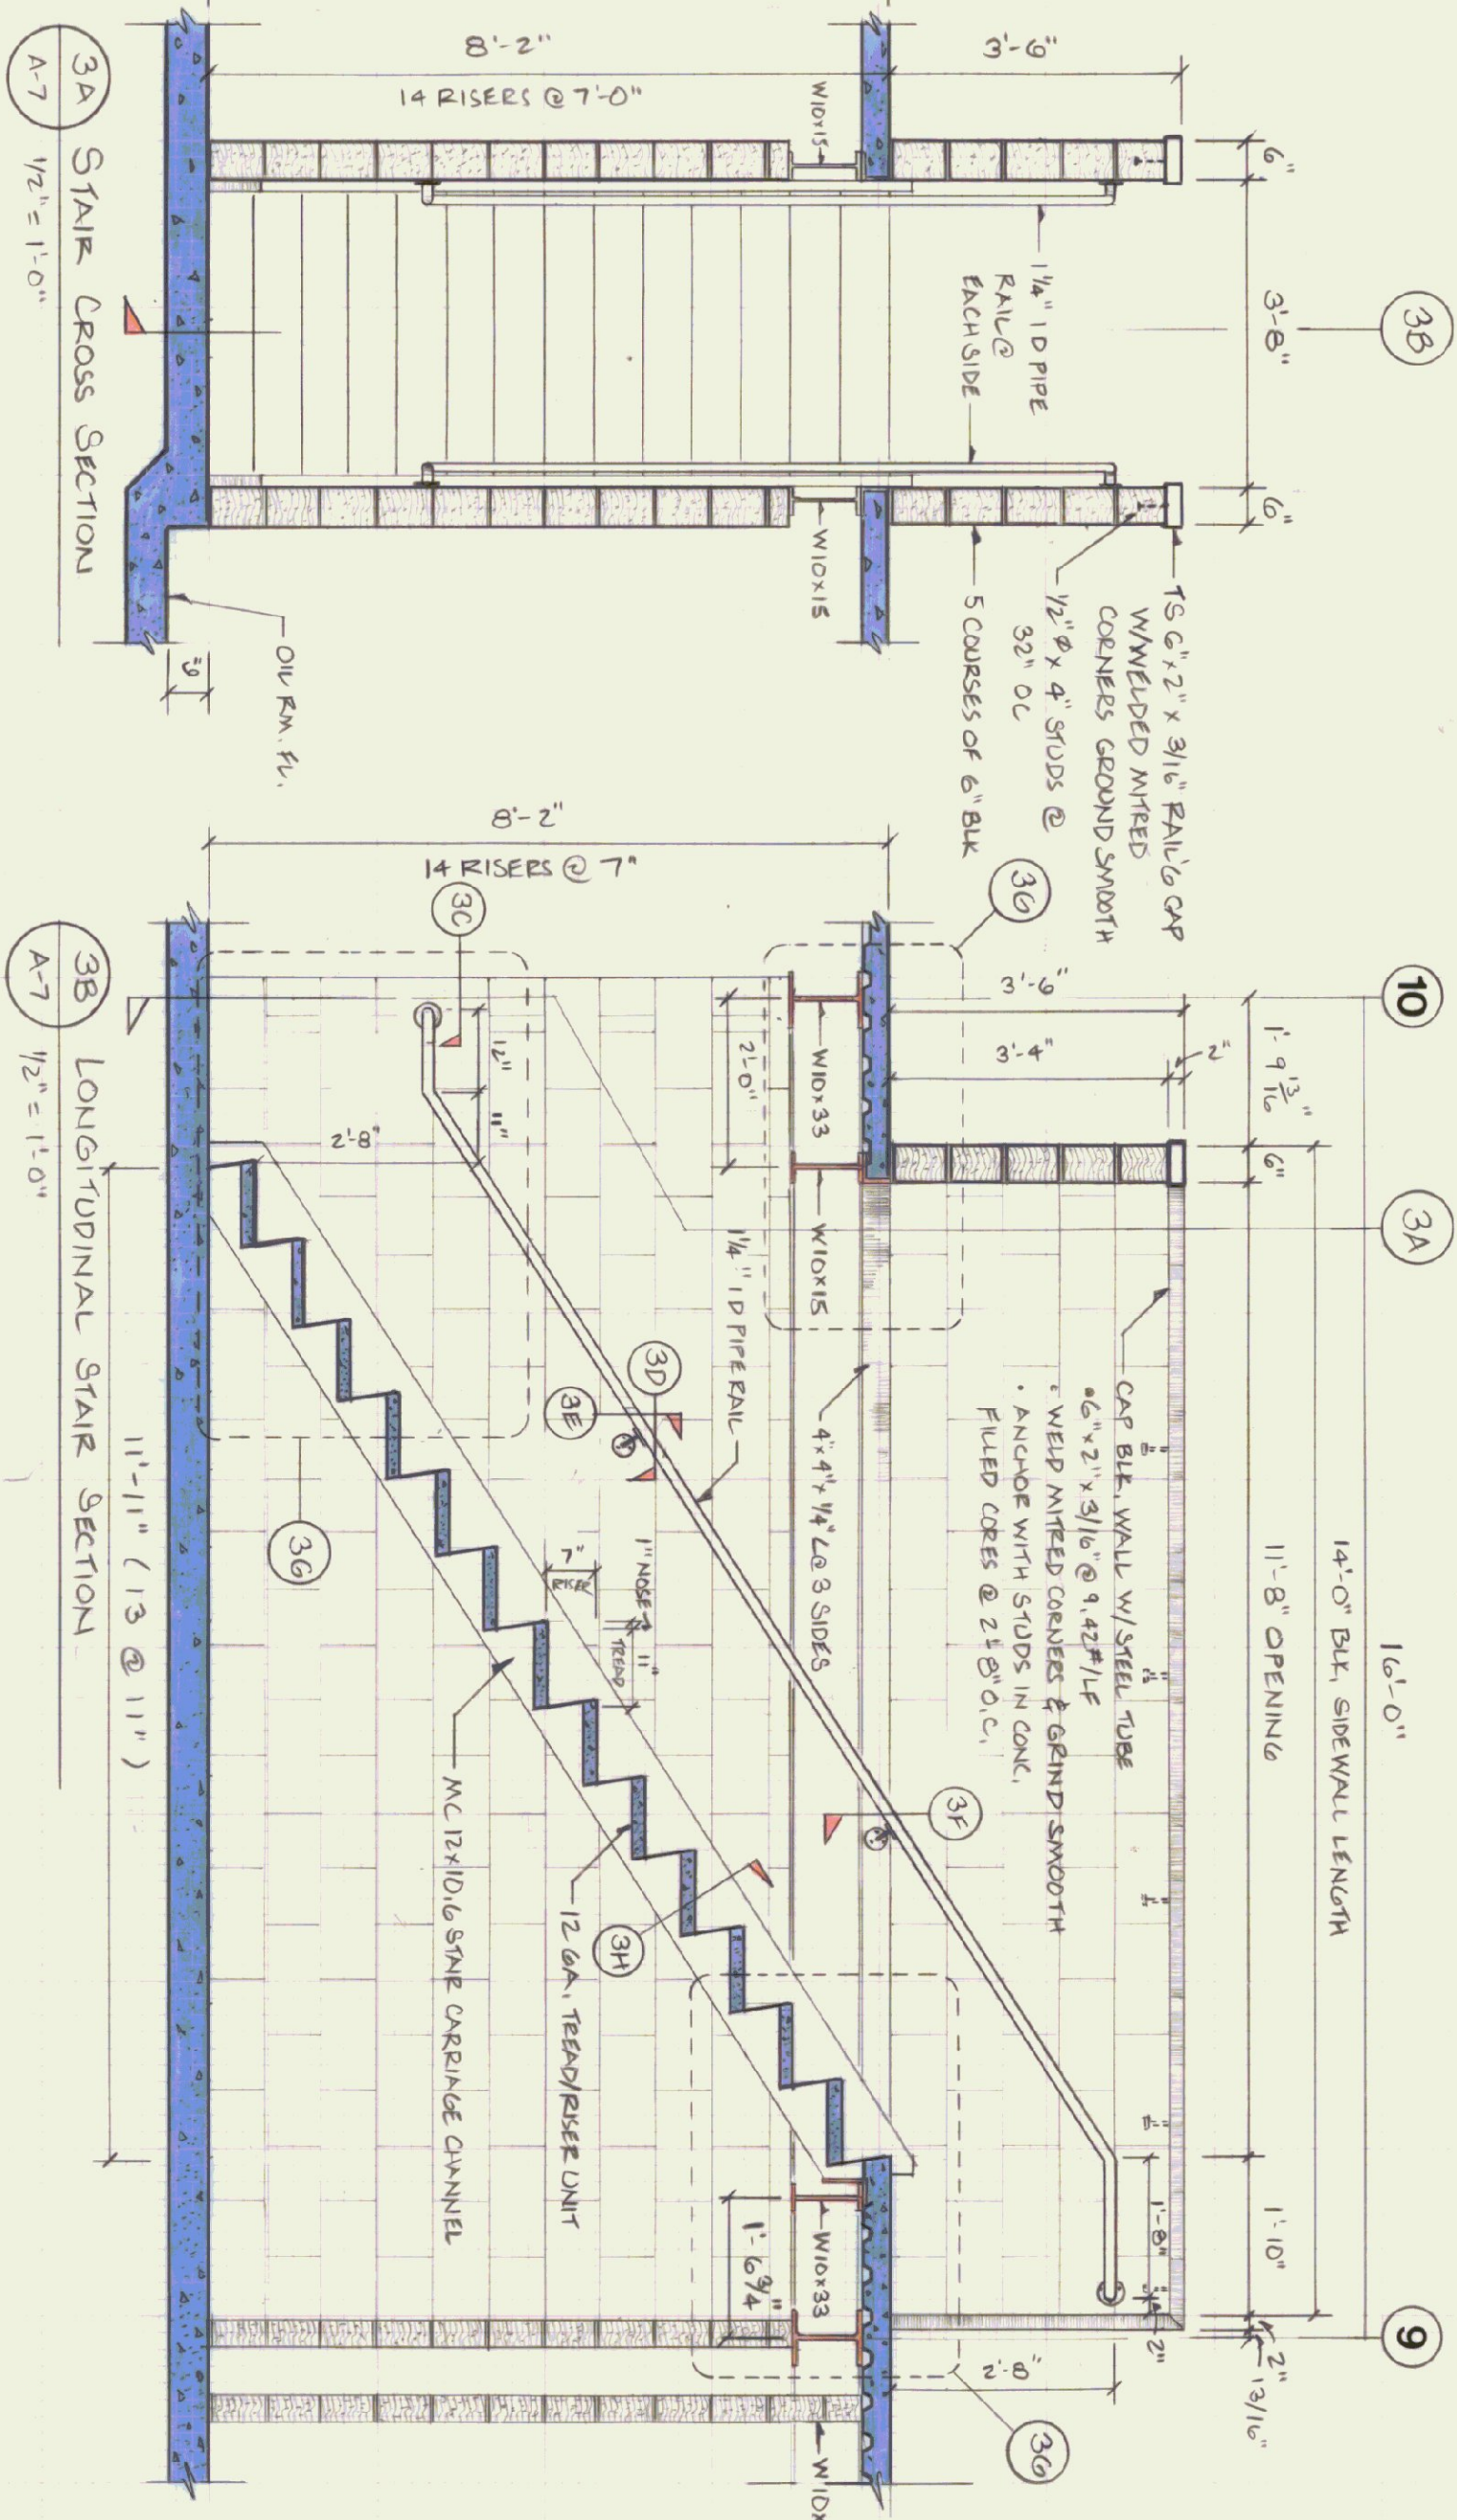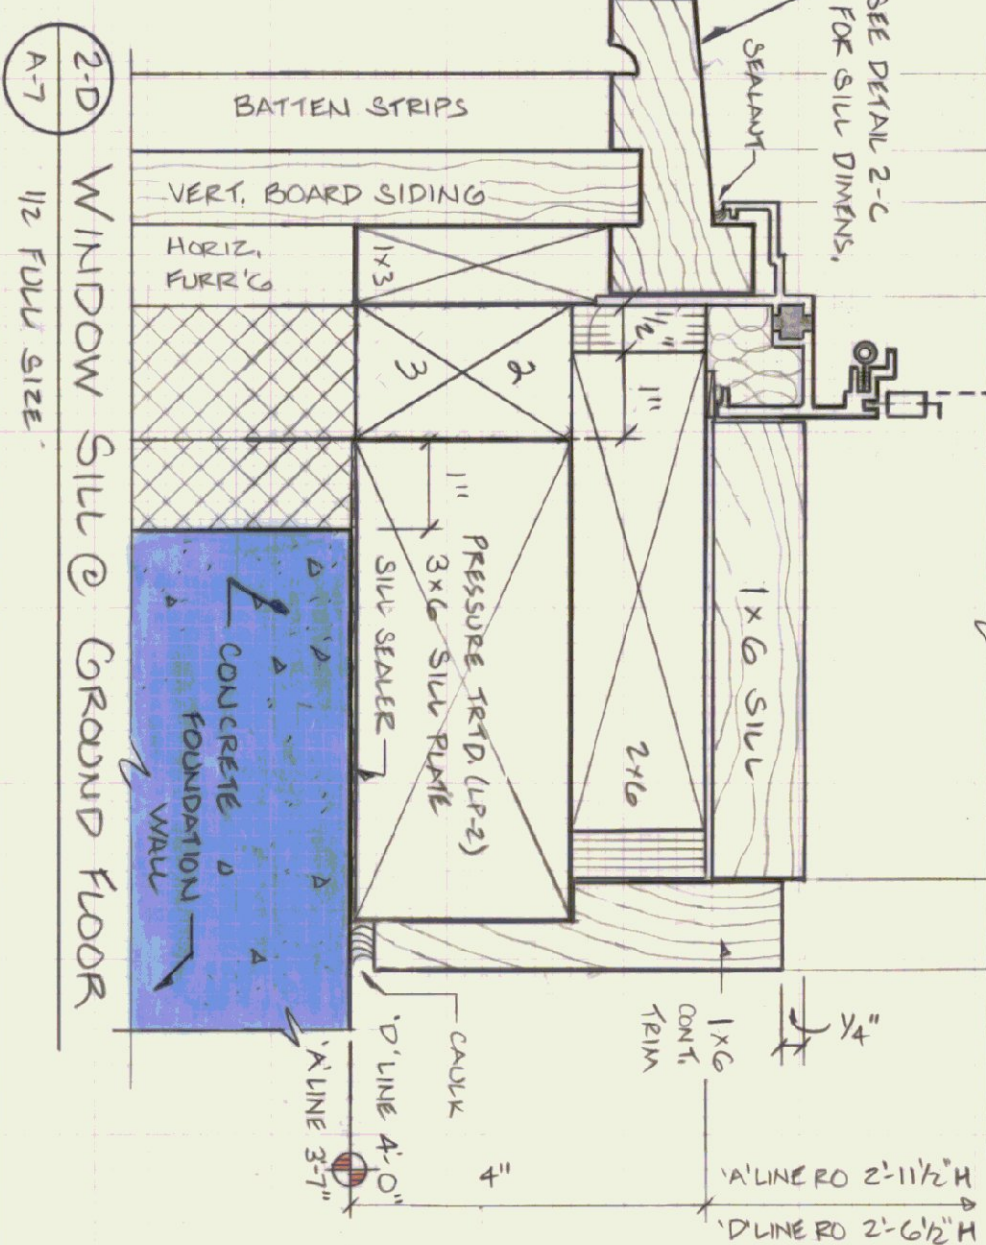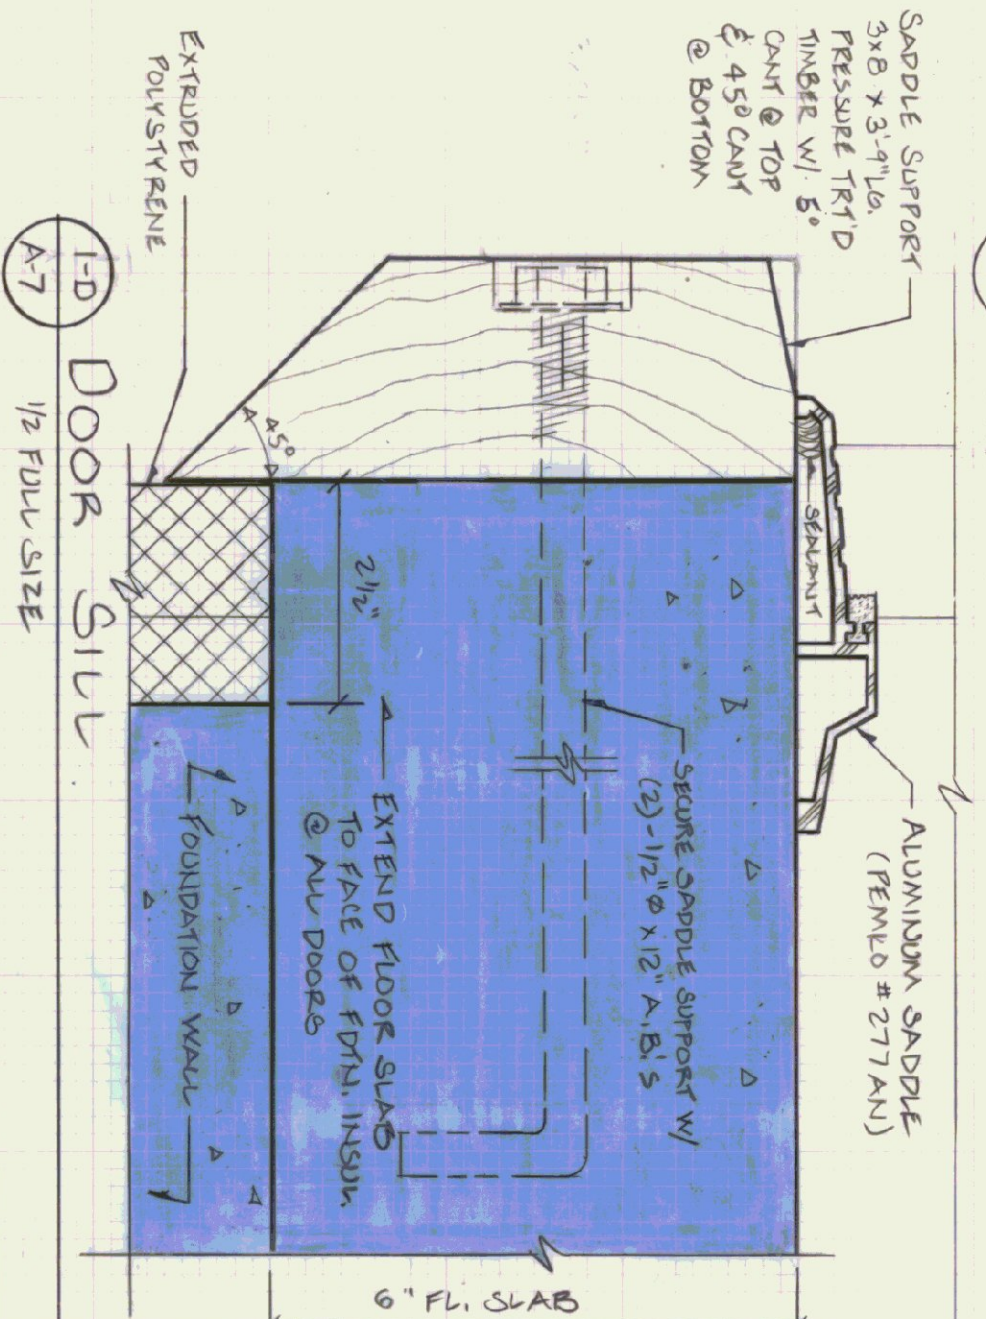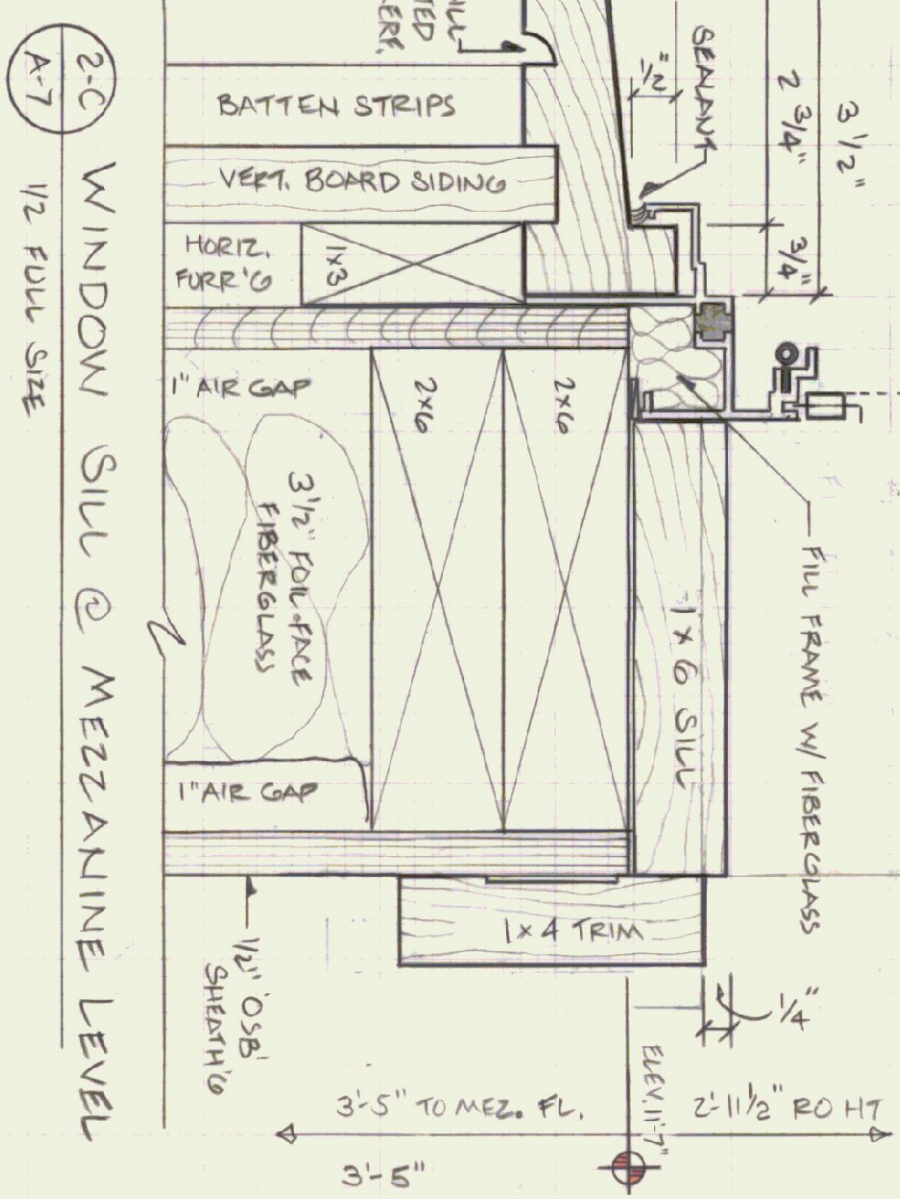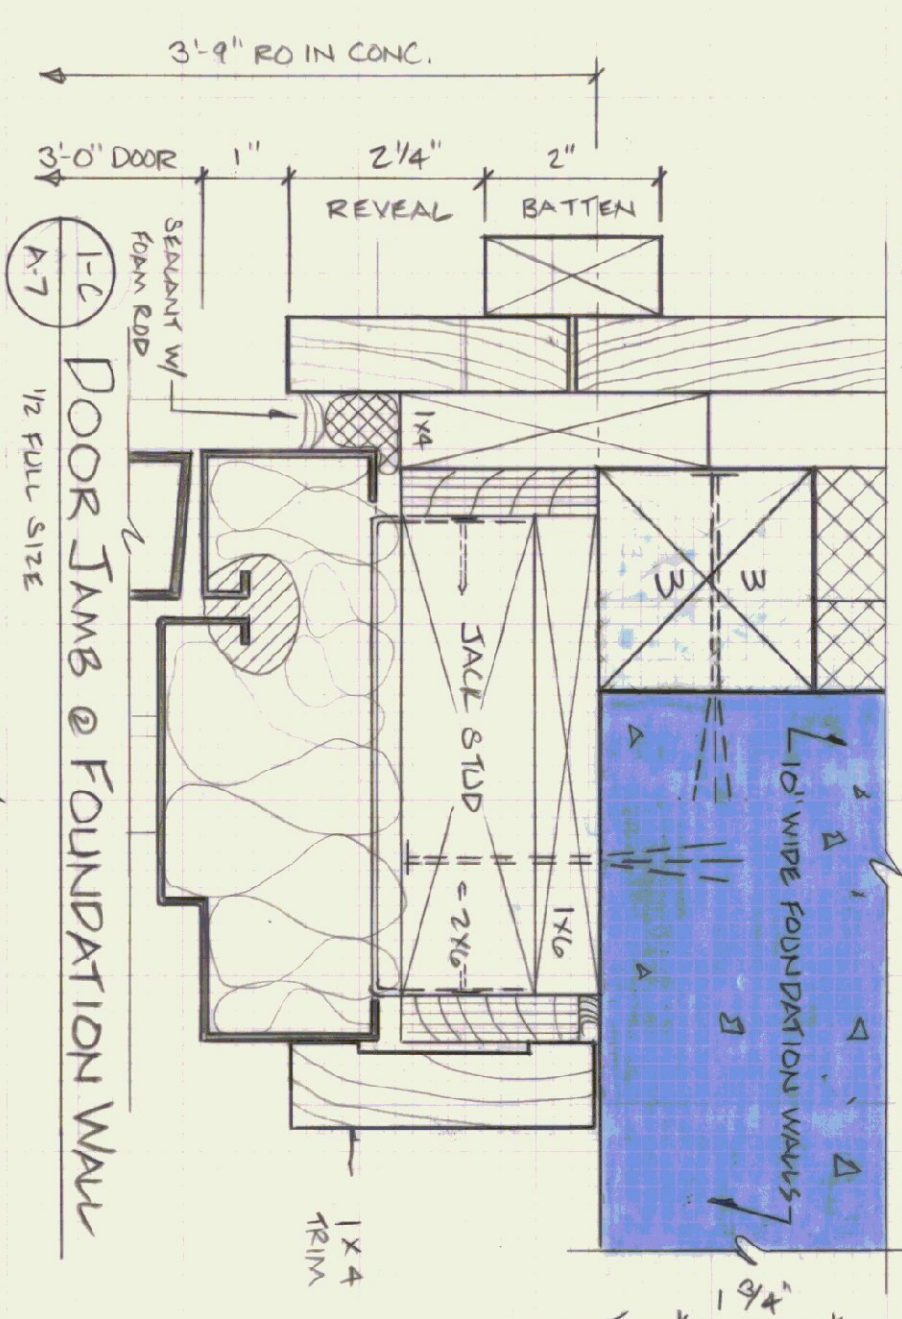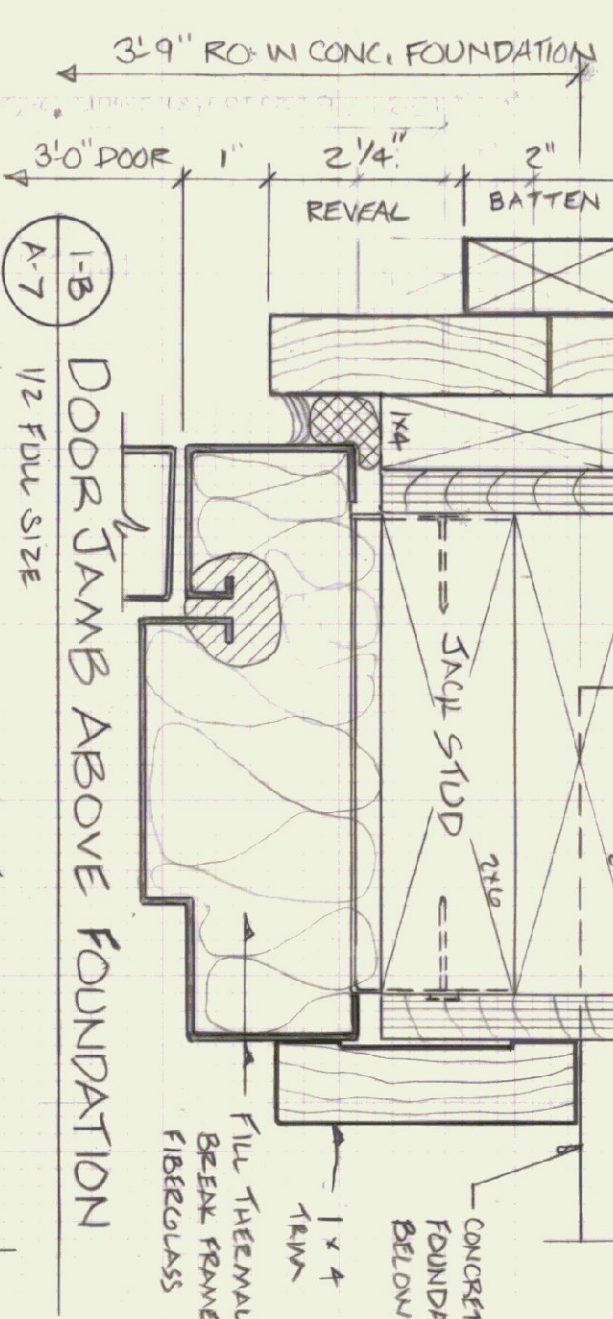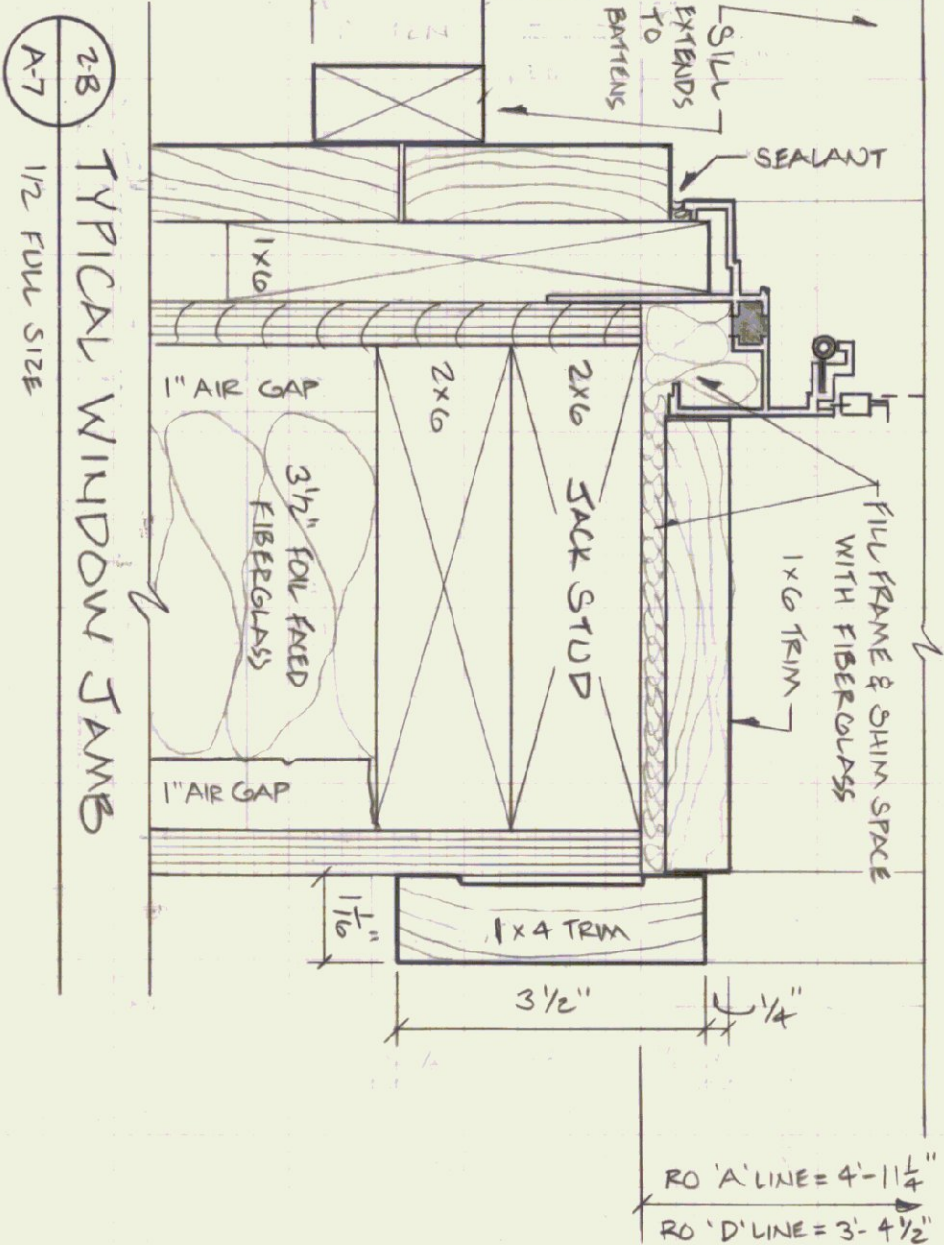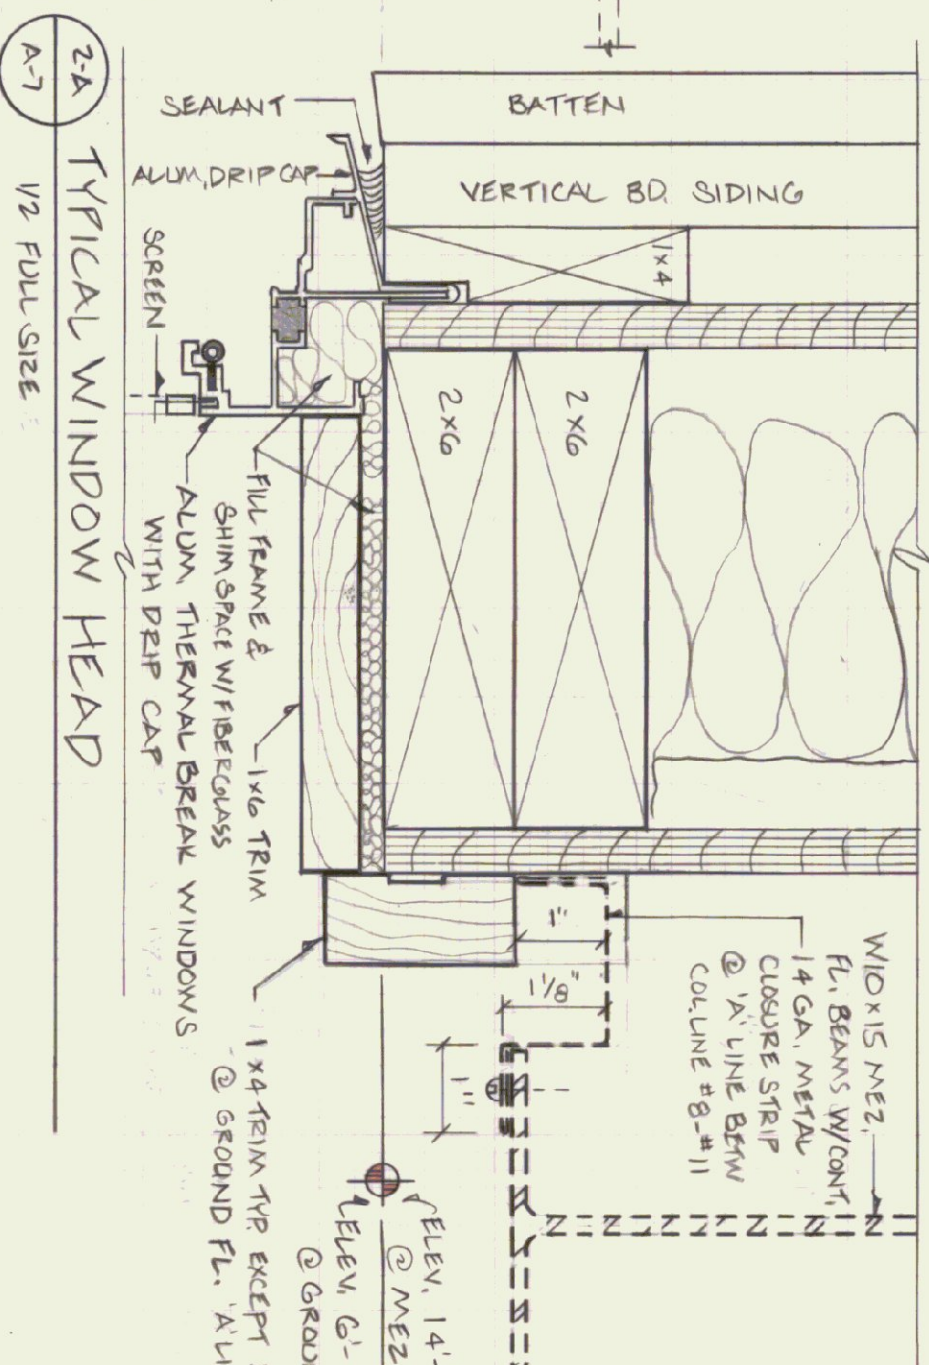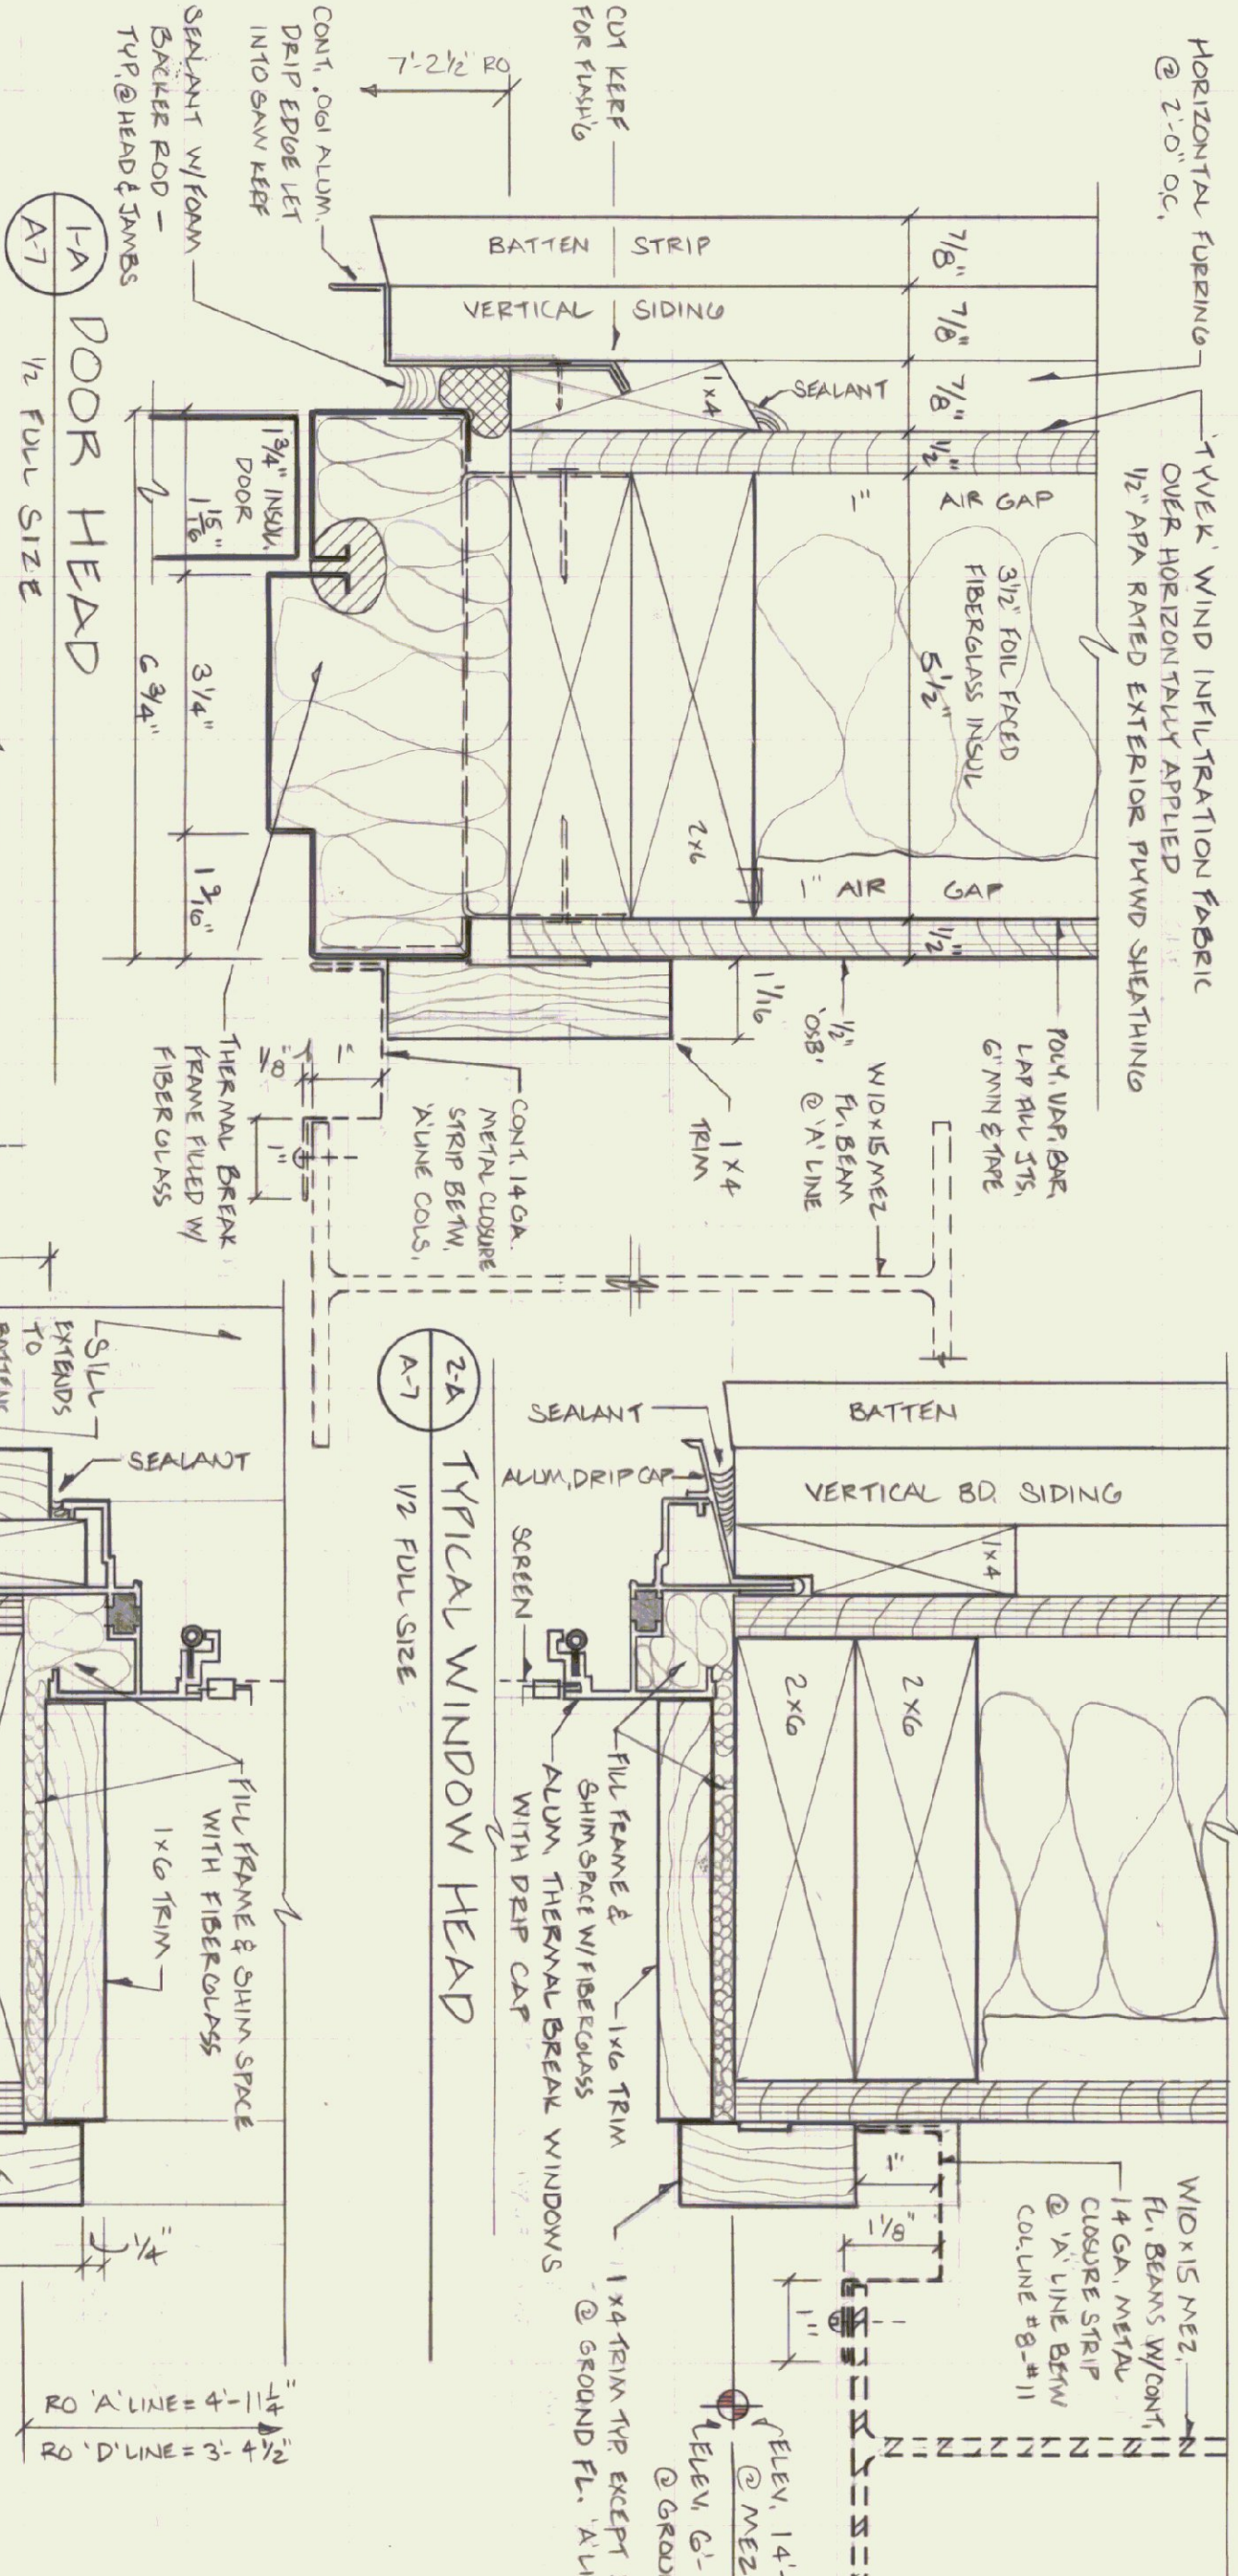[illegible]

STATE OF VERMONT
DEPARTMENT OF STATE BUILDINGS
AGENCY OF ADMINISTRATION
MONTPELIER, VERMONT

DOOR, WINDOW, & STAIR DETAILS

AGENCY OF TRANSPORTATION 11 BAY MAINTENANCE GARAGE DUMMERTON, VERMONT DISTRICT 2	
DATE	1/26
DRAWN BY	
APPROVED BY:	SCALE:
3. OSTERMAN	AS BUILT
12 OF 2	REVISIONS: 03-10-96
	DWG NO. A-7

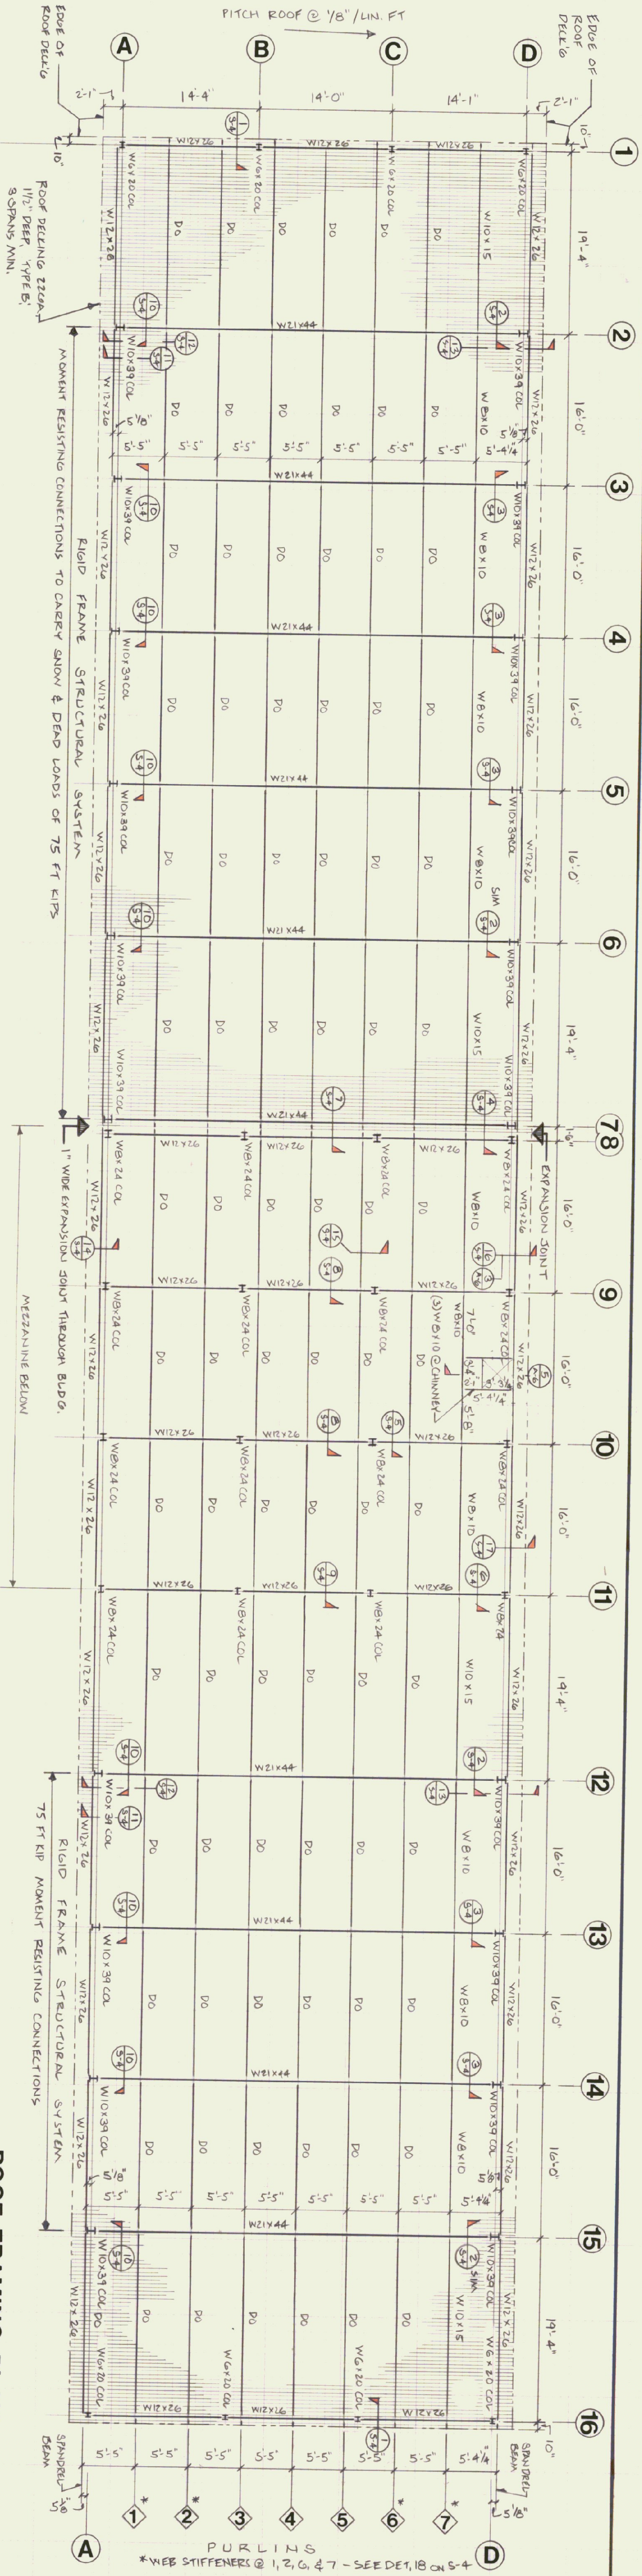

ROOF FRAMING PLAN

SCALE 1/8" = 1'-0"

BASE PLATE NOTES:

- @ COL. LINES #1, 8, 11, & 16 BOT. OF BASE PL. @ +4'-0 3/4"
- @ " " #2, 3, 4, 5, 6, 7, " " @ -2'-1 1/4"
- @ " " #12, 13, 14, & 15 " " @ -2'-1 1/4"
- @ @ COLUMNS # A-9, A-10 BOT. OF BASE PL. @ +4'-0 3/4"
- @ @ COLUMNS # B-9, B-10, BOT. " " @ +1'-0 3/4"
- @ @ C-9, C-10 " " @ +1'-0 3/4"
- @ @ COLUMNS # D-9, D-10 BOT. OF BASE PL. @ +4'-0 3/4"

MISC. NOTES


- CHANNELS FOR GARAGE DOORS (12 DOORS TOTAL) ARE NOT SHOWN ON FRAMING PLAN, SEE A-5, A-6, & S-4

LOADING NOTES

- 1) SNOW LOAD = 50#/SF REDUCED/CODE FOR FLAT ROOF
- 2) DEAD LOAD = 20#/SF FOR ROOF @ WALLS
- 3) WIND LOAD = 20#/SF
- 4) MEZZANINE = 100#/SF FLOOR

MEZZANINE FRAMING PLAN

SCALE 1/8" = 1'-0"

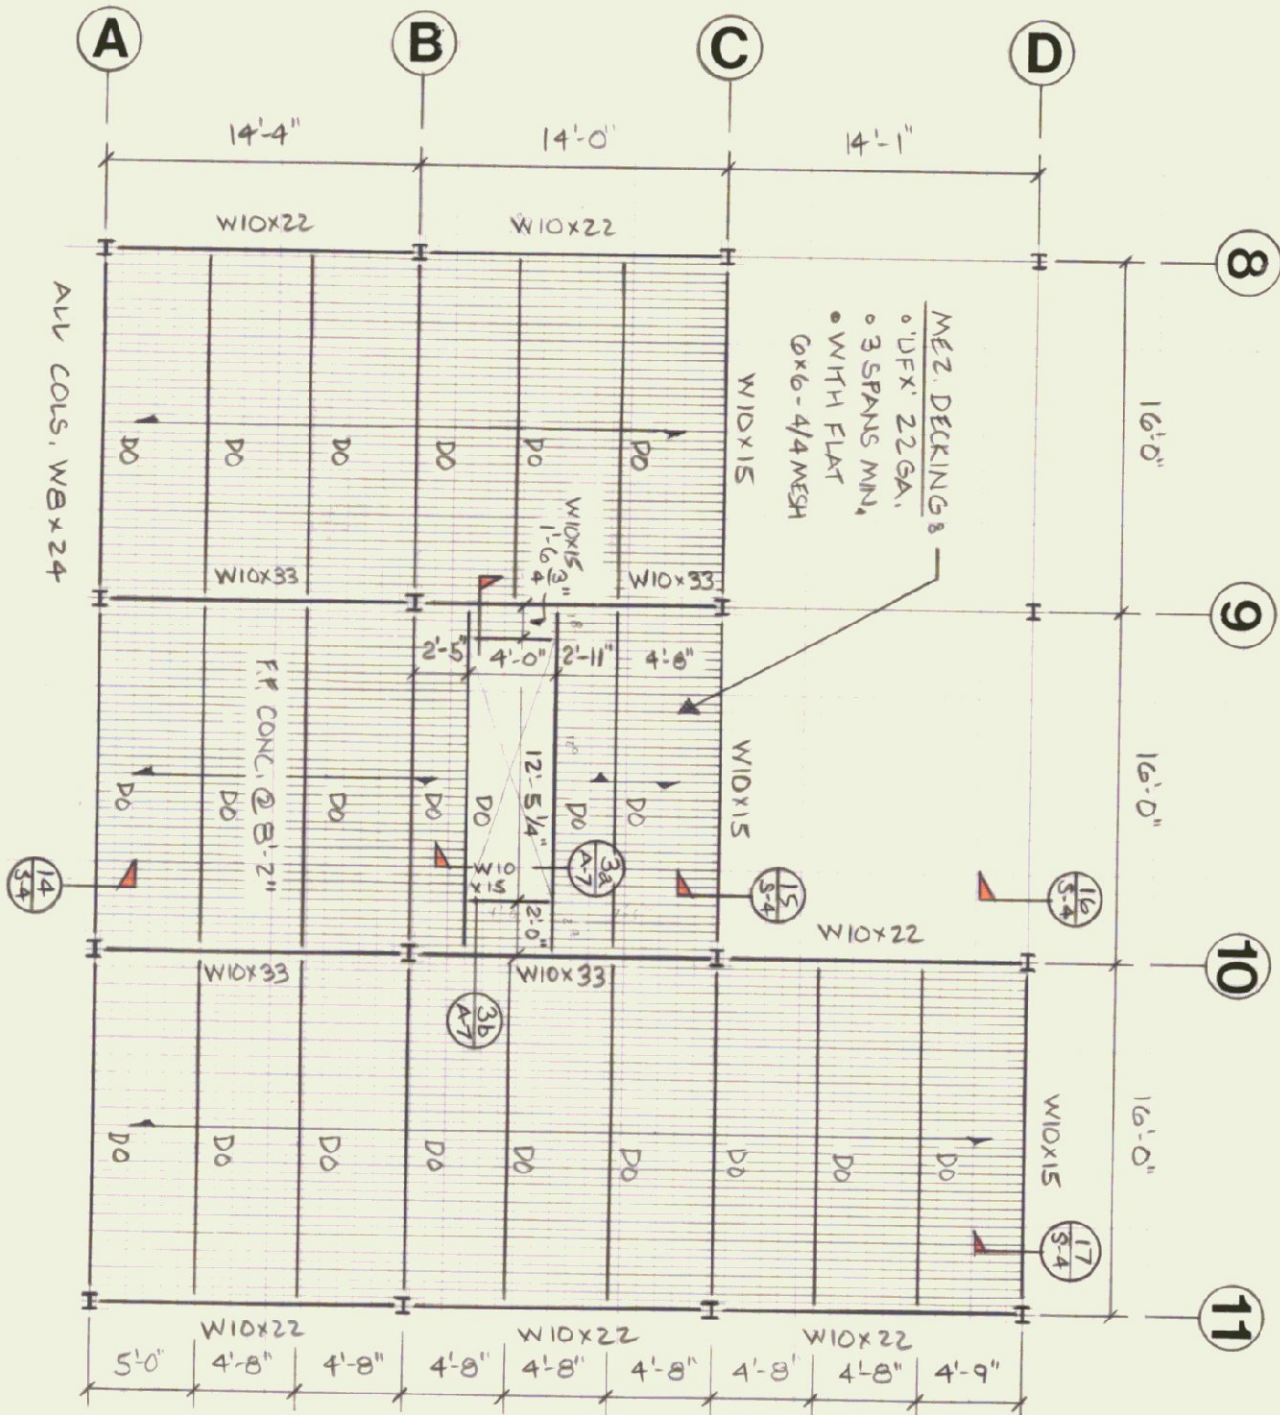

NO.	DATE	ISSUE	RECORD
1		DESCRIPTION	NO.



STATE OF VERMONT
DEPARTMENT OF STATE BUILDINGS
AGENCY OF ADMINISTRATION
MONTPELIER.

STRUCTURAL STEEL FRAMING @



MEZZANINE & ROOF
AGENCY OF TRANSPORTATION
11 BAY MAINTENANCE GARAGE
DUMMERSTON, VERMONT

DISTRICT 2

DATE	SCALE	REVISIONS	DWG. NO.
1/60	AS NOTED		S-3
DRAWN BY:	APPROVED BY:		
U. OSTROM	F. FRANK		

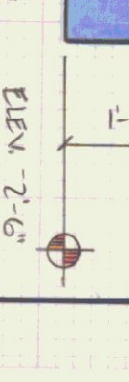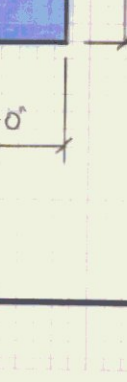

15 NO.	DATE	ISSUE RECORDED
16 NO.	DESCRIPTION	
STATE OF VERMONT DEPARTMENT OF STATE BUILDINGS AGENCY OF ADMINISTRATION MONTPELIER, VERMONT		
STEEL SECTIONS. & MISC. DETAILS		
AGENCY OF TRANSPORTATION 11 BAY MAINTENANCE GARAGE DUMMERSTON, VERMONT DIST/CT 2		
DATE	SCALE	REVISIONS
1-20	3/4" = 1'-0"	
DRAWN BY	APPROVED BY:	
ST. O'NEILL		
DWG NO.		
S-4		

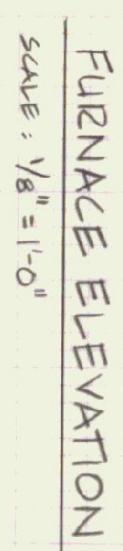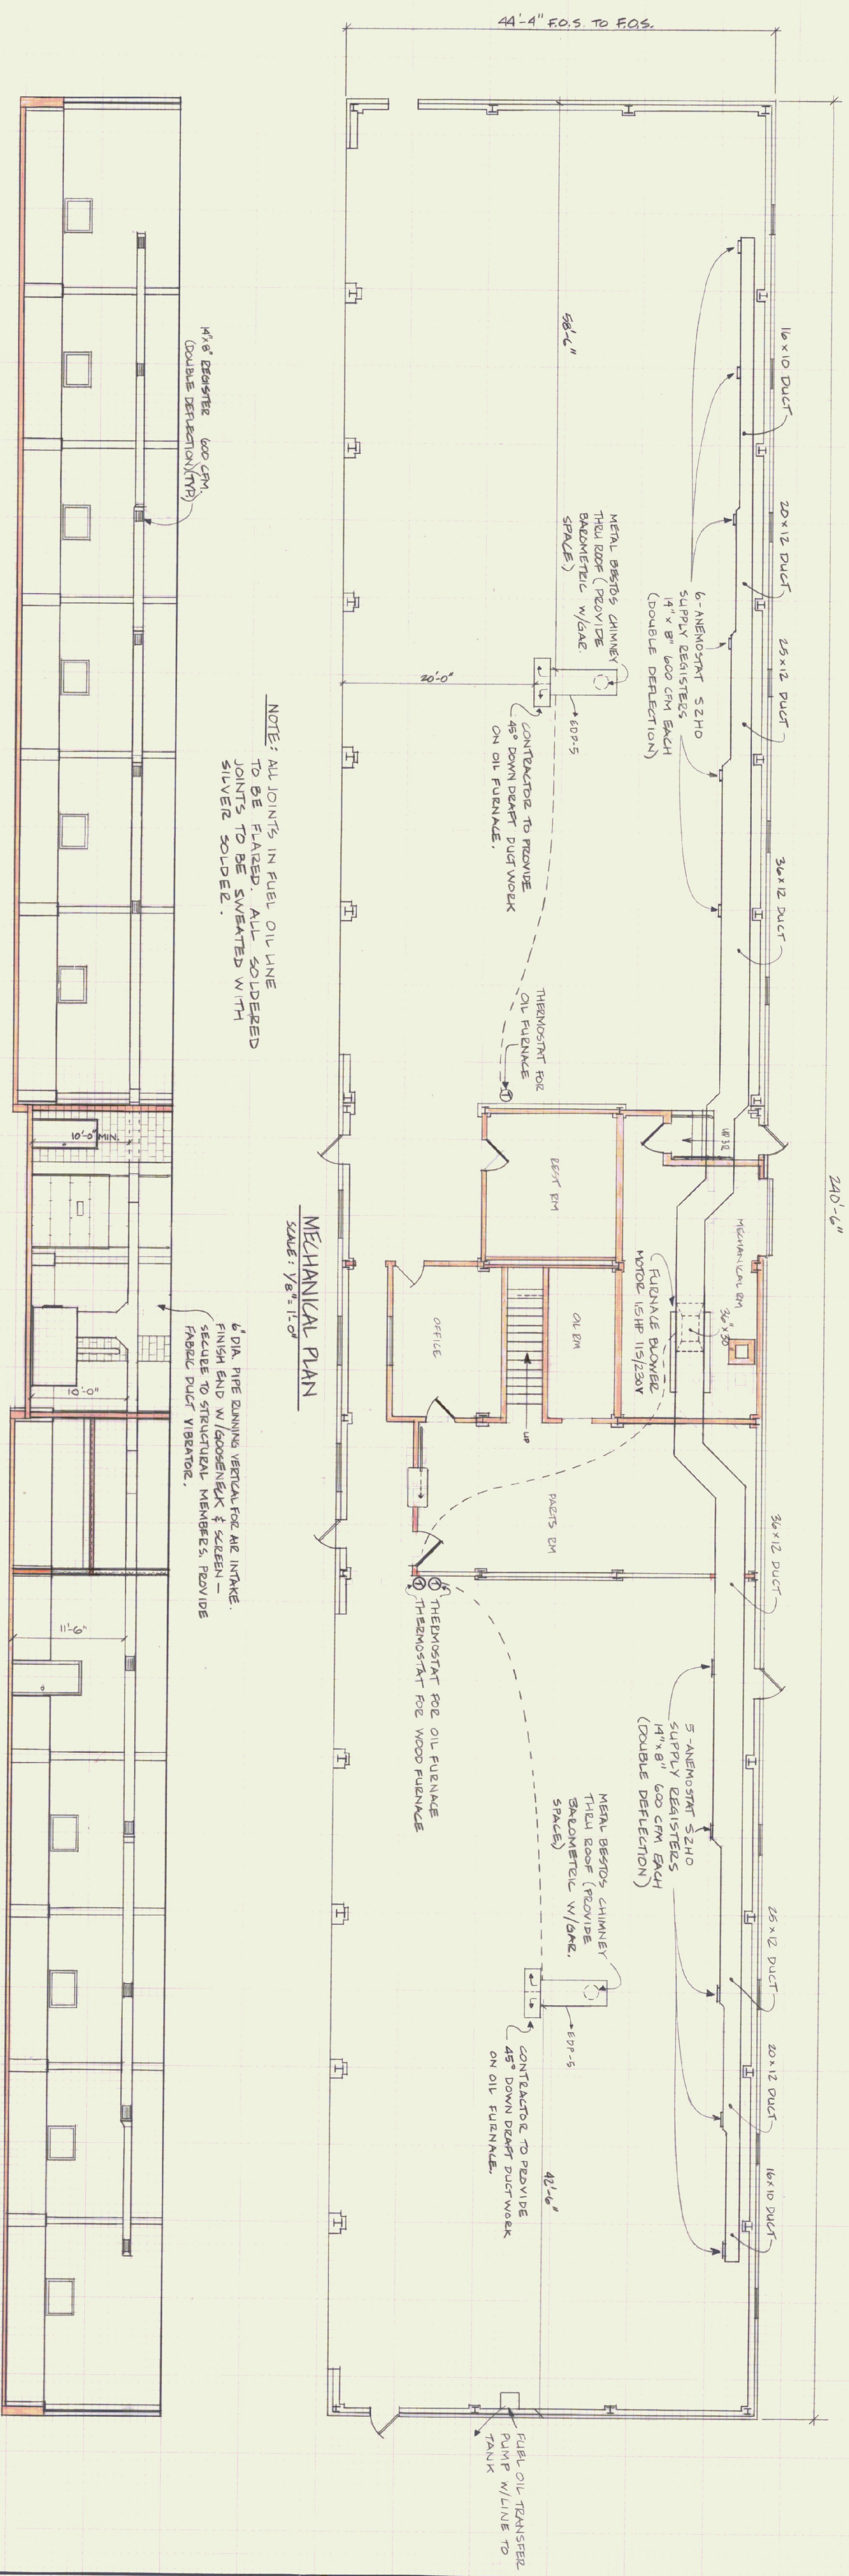
[illegible]

STATE OF VERMONT
DEPARTMENT OF STATE BUILDINGS
AGENCY OF ADMINISTRATION
MONTPELIER, VERMONT

HEATING PLAN




AGENCY OF TRANSPORTATION
11 BAY MAINTENANCE GARAGE
CHAMBERS STREET

DATE: 1-8-66	SCALE: AS NOTED	REVISIONS:	DWG. NO H-1
DRAWN BY: J.E. WINTER	APPROVED BY: F. TRATT		18 OF 21

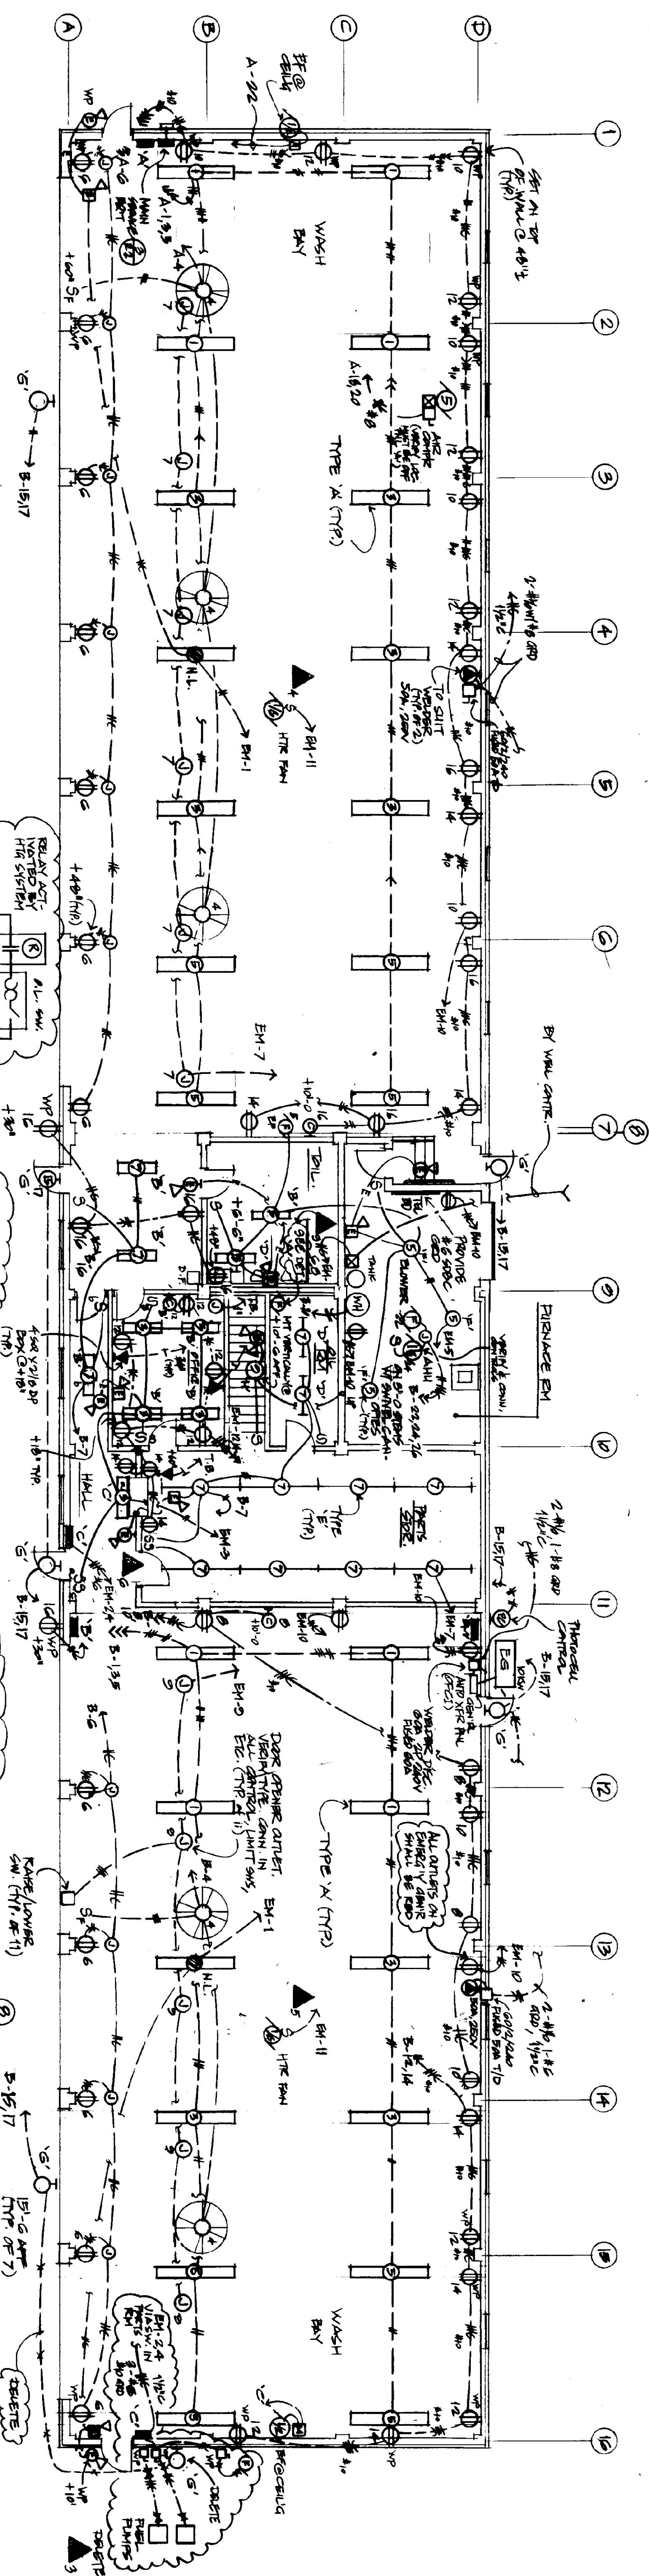[illegible]

WOLFE 122040										MAIN BRK		FEED BOTTOM		TOP	
PHASE										LASS ONLY		MSE SURFACE		FLUSH	
NEUTRAL										BRK TYPE		TYPE: LOAD CIR			
BRK										BRK A.I.C.		DOOR: WHT		MATERIAL	
1224										1224		1224		1224	
EXT	NO.	LOAD	LT	P	BR	LT	P	BR	LT	LOAD	CR	NO.	EXT	NO.	LOAD
1	1	LT'S	4	122		20	1		2	2	2	2	2	2	2
2	2		4			2	2		2	2	2	2	2	2	2
3	3		4			2	2		2	2	2	2	2	2	2
4	4		4			2	2		2	2	2	2	2	2	2
5	5		4			2	2		2	2	2	2	2	2	2
6	6		4			2	2		2	2	2	2	2	2	2
7	7		4			2	2		2	2	2	2	2	2	2
8	8		4			2	2		2	2	2	2	2	2	2
9	9	LT'S MISC.	4			2	2		2	2	2	2	2	2	2
10	10		4			2	2		2	2	2	2	2	2	2
11	11	SPRINK	4			2	2		2	2	2	2	2	2	2
12	12		4			2	2		2	2	2	2	2	2	2
13	13	BATT'L LT'S	4			2	2		2	2	2	2	2	2	2
14	14		4			2	2		2	2	2	2	2	2	2
15	15		4			2	2		2	2	2	2	2	2	2
16	16		4			2	2		2	2	2	2	2	2	2
17	17		4			2	2		2	2	2	2	2	2	2
18	18		4			2	2		2	2	2	2	2	2	2
19	19		4			2	2		2	2	2	2	2	2	2
20	20		4			2	2		2	2	2	2	2	2	2
21	21		4			2	2		2	2	2	2	2	2	2
22	22		4			2	2		2	2	2	2	2	2	2
23	23		4			2	2		2	2	2	2	2	2	2
24	24		4			2	2		2	2	2	2	2	2	2
25	25		4			2	2		2	2	2	2	2	2	2
26	26		4			2	2		2	2	2	2	2	2	2
27	27		4			2	2		2	2	2	2	2	2	2
28	28		4			2	2		2	2	2	2	2	2	2
29	29		4			2	2		2	2	2	2	2	2	2
30	30		4			2	2		2	2	2	2	2	2	2
SUM-TOTAL										4550		3620	3150	4739	
CONNECTED LOAD / PHASE										7789			7800		
DEMAND LOAD / PHASE										5300			5310		
UTIL. DEMAND LOAD										5300			5310		
										11-12-12					
										HIGH LEG					
										CURRENT		493 A			
										REMARKS					
										* SEE PAGE					
										* 1. PHASE UNBALANCE (VOLTAGE)					
										* 2. PHASE UNBALANCE (CURRENT)					
										* 3. PHASE UNBALANCE (WATTAGE)					
										* 4. PHASE UNBALANCE (WATTAGE)					
PANEL 'EM'										FEED - BOTTOM		TOP	
										MIS. SURFACE		FLUSH	
										TYPE: BURN BO		LOAD C/R	
										DOOR: WITH		MITROL	
NO.	LOAD	BR	LB	PA	L1	L2	L3	A	P	BR	LB	LOAD	CCT
1	LT-5	2	1	80	500	1500		500	1	1	500	1	2
2	"	2	1	80									4
3	" + BM	2	1	80	750	800		500	1	1	500	1	2
4	2.0A. PROTECT	2	1	80	1100	1100		500	1	1	500	1	2
5	3.5A. PROTECT	2	1	80	1100	1100		500	1	1	500	1	2
6	3.5A. PROTECT	2	1	80	1100	1100		500	1	1	500	1	2
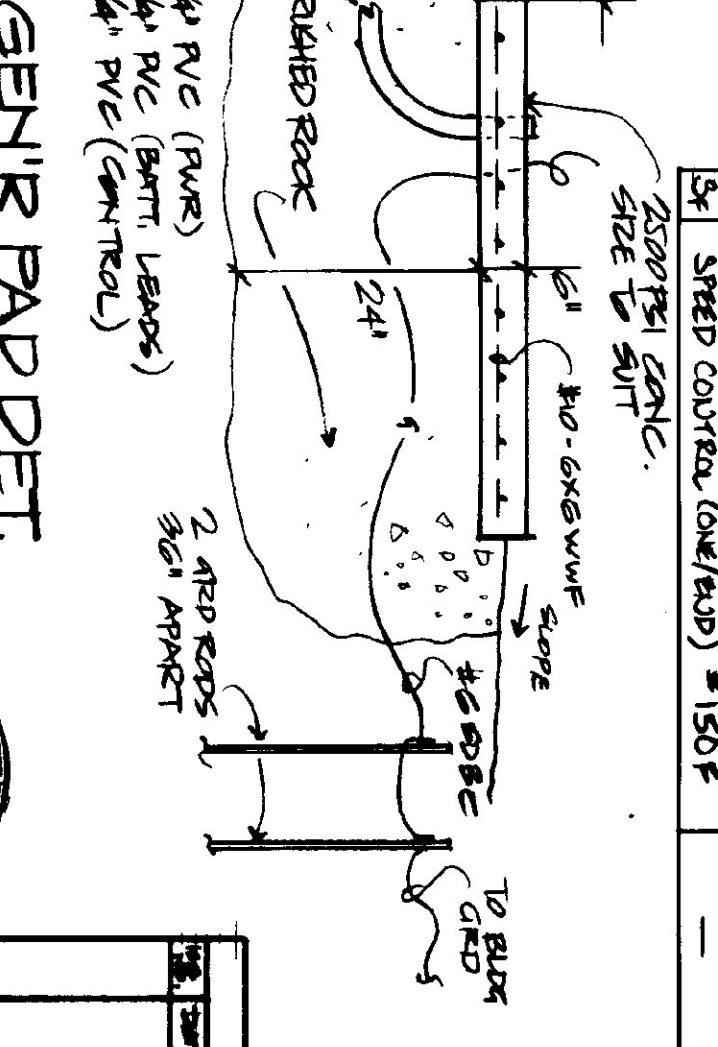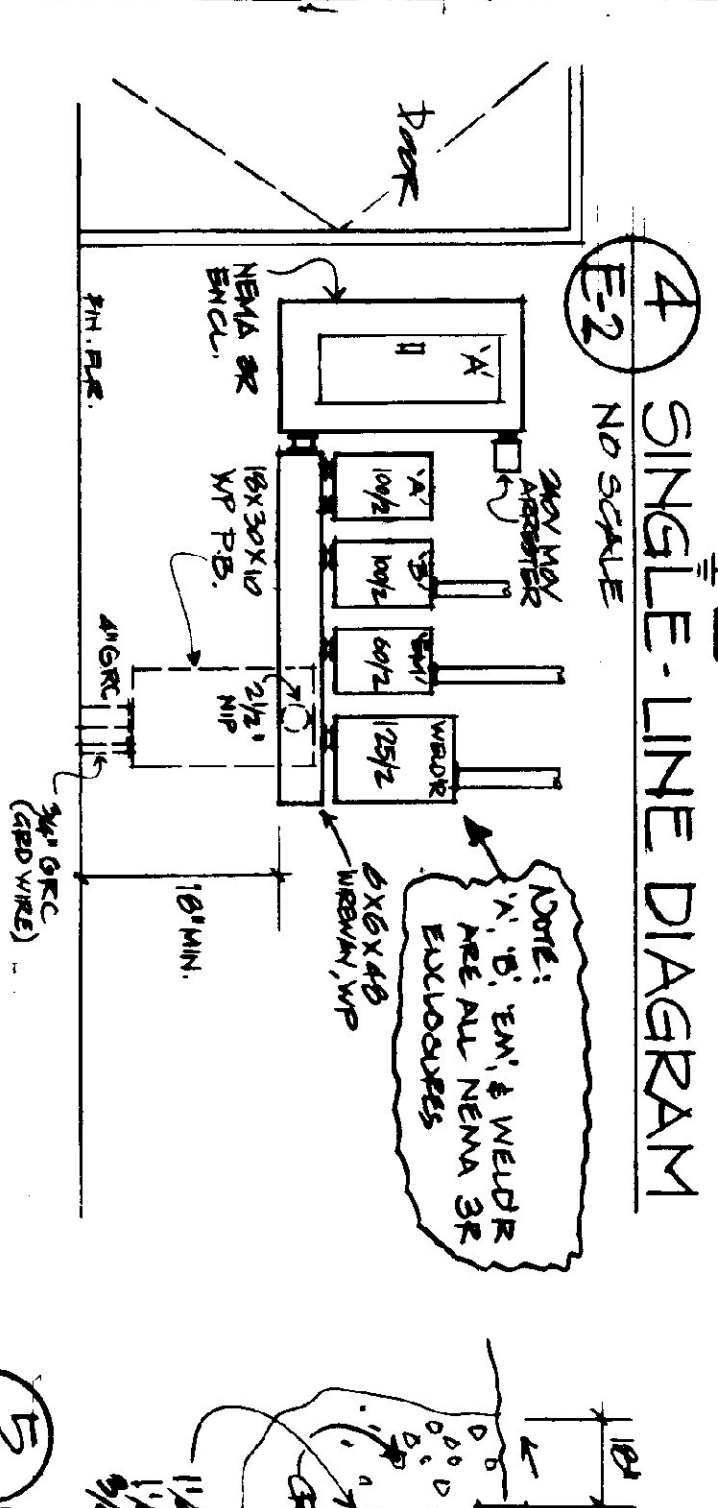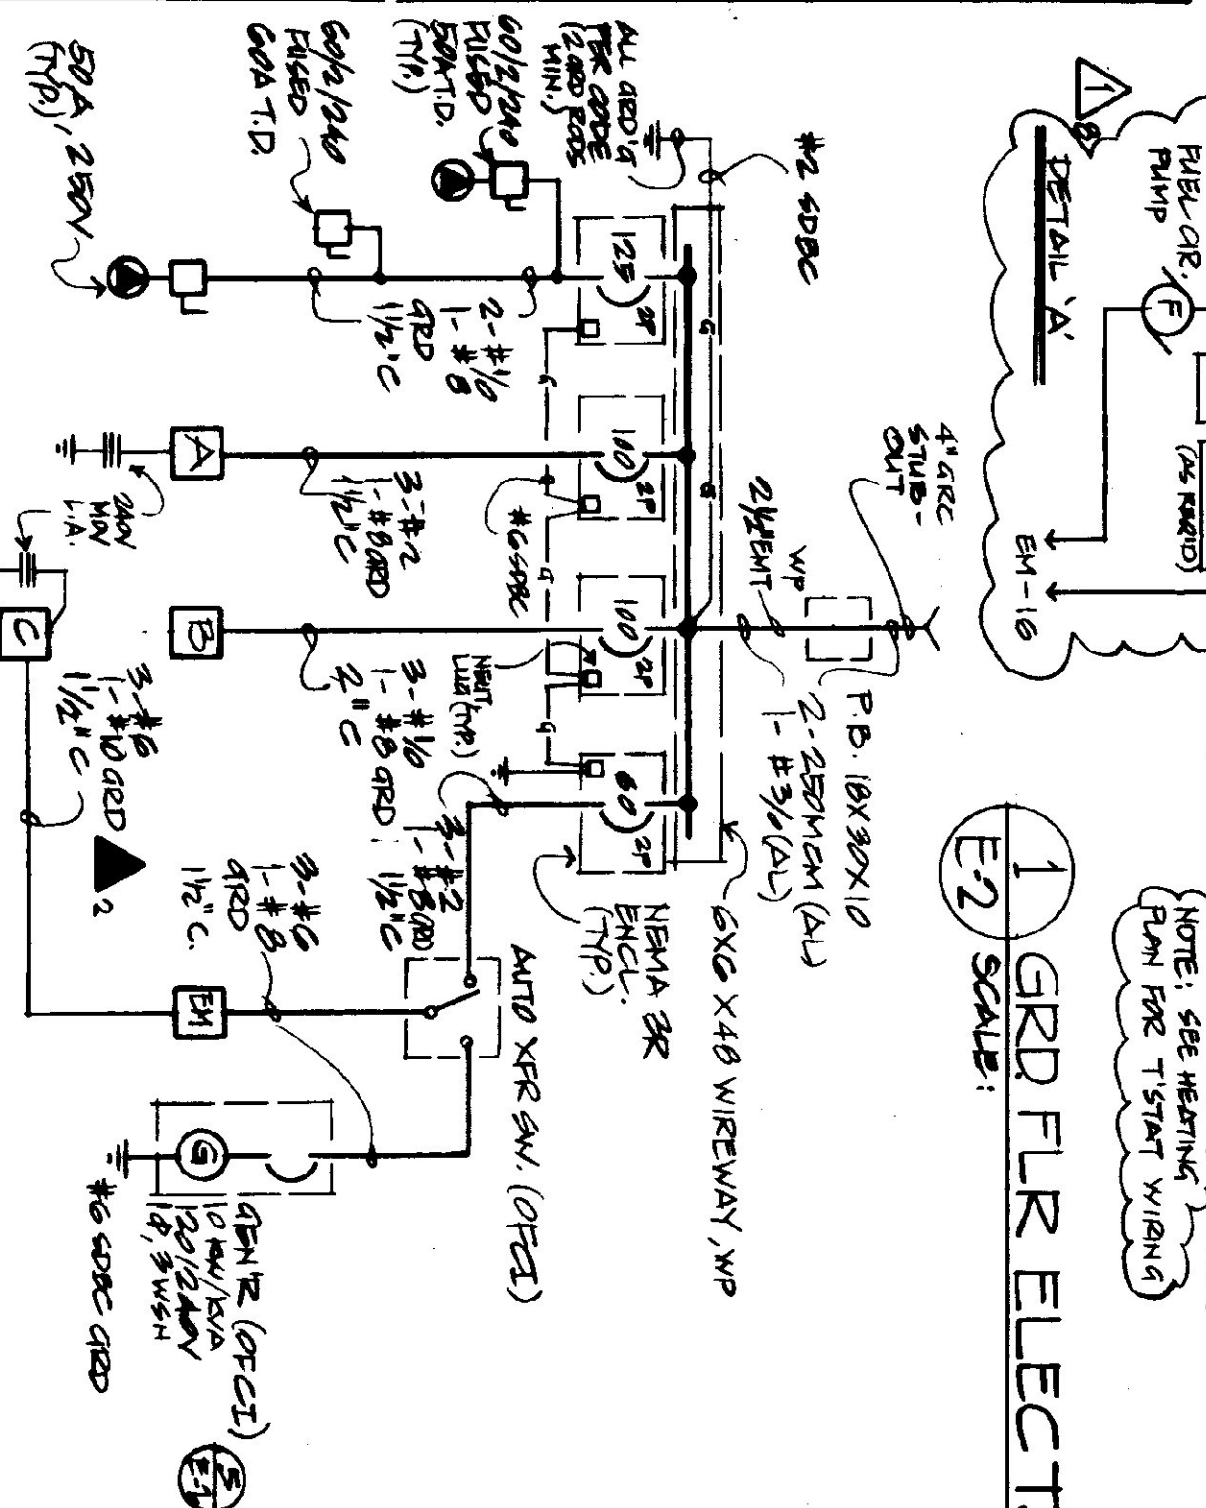

TIME	LIGHTING FIXTURE SCHEDULE	REL. TO
A	800 MA FLUORE. INDUSTRIAL, 10% UP LIGHT, 120V W/ST-2 LAMPS	LITHONIA 400-200-10
B	2-LAMP 40W RS W/ST-2 ACROB 21 ACROB FRESH WHITE, 150W BULBET	LITHONIA 210-200-100
C	1-LAMP 40W FLUORE. VANDAL- PROOF	ACME-DIMMER 511-140
D	SIMILAR TO 'C', 2 LAMPS	ACME-DIMMER 511-240
E	2-LAMP TANDEN 80-1T 40W RS STRIPE FLUORE., 120V 4-LAMP BULBET	LITHONIA (250-210-10)
F	INDUSTRIAL FLUORE., 100W LAMP, 120V FLUORE. 150W LAMP, 40W DOME	RESEARCH 100-2
G	HD YAL BULBET, 150W 4-1/2'S, ACME-DIMMER, 200W BULBET	ACME-DIMMER 140-200
H	INDUCL W/ST BULBET, 200W LAMP, VANDAL-PROOF, 120V ACROB'S	ACME-DIMMER 200
I	150W RS 100W RS W/ST FLUORE. 150W LAMP	-

CELLING FAN SCHEDULE	
5	'E' (EAVES) FAN *100-P
ST	STEEP CONTROL (*100/400) *150P
	—
	—

3 SER. EXT ELEV.
E-2 H.T.S.

5 GEN'R PADDET.
E-2 NTS.

Wakefield Ward & Associates

A circular professional engineer seal for the State of Vermont. The outer ring contains the text "STATE OF VERMONT" at the top and "PROFESSIONAL ENGINEER" at the bottom, separated by two stars. The inner circle contains the name "ROBERT WAKEFIELD WARD" and the number "No. 3641" in the center.

COLE RECORD		DATE		SUBSCRIPTION		NAME	
STATE OF VERMONT DEPARTMENT OF STATE BUILDINGS AGENCY OF ADMINISTRATION MONTPELIER, VERMONT							
ELECTRICAL PLANS AND DETAILS AGENCY OF TRANSPORTATION 11 BAY MAINTENANCE GARAGE RUMFERTON, VERMONT DISTRICT 2							
DATE	SCALE	REVISIONS	STAFF	DWG NO			
5-22-85	AS NOTED		Δ 6 2-24-81 RWV	E-2			
DRAWN BY:	APPROVED BY:						
XXXXXX	E. TRANT						
				20	OF 21		