


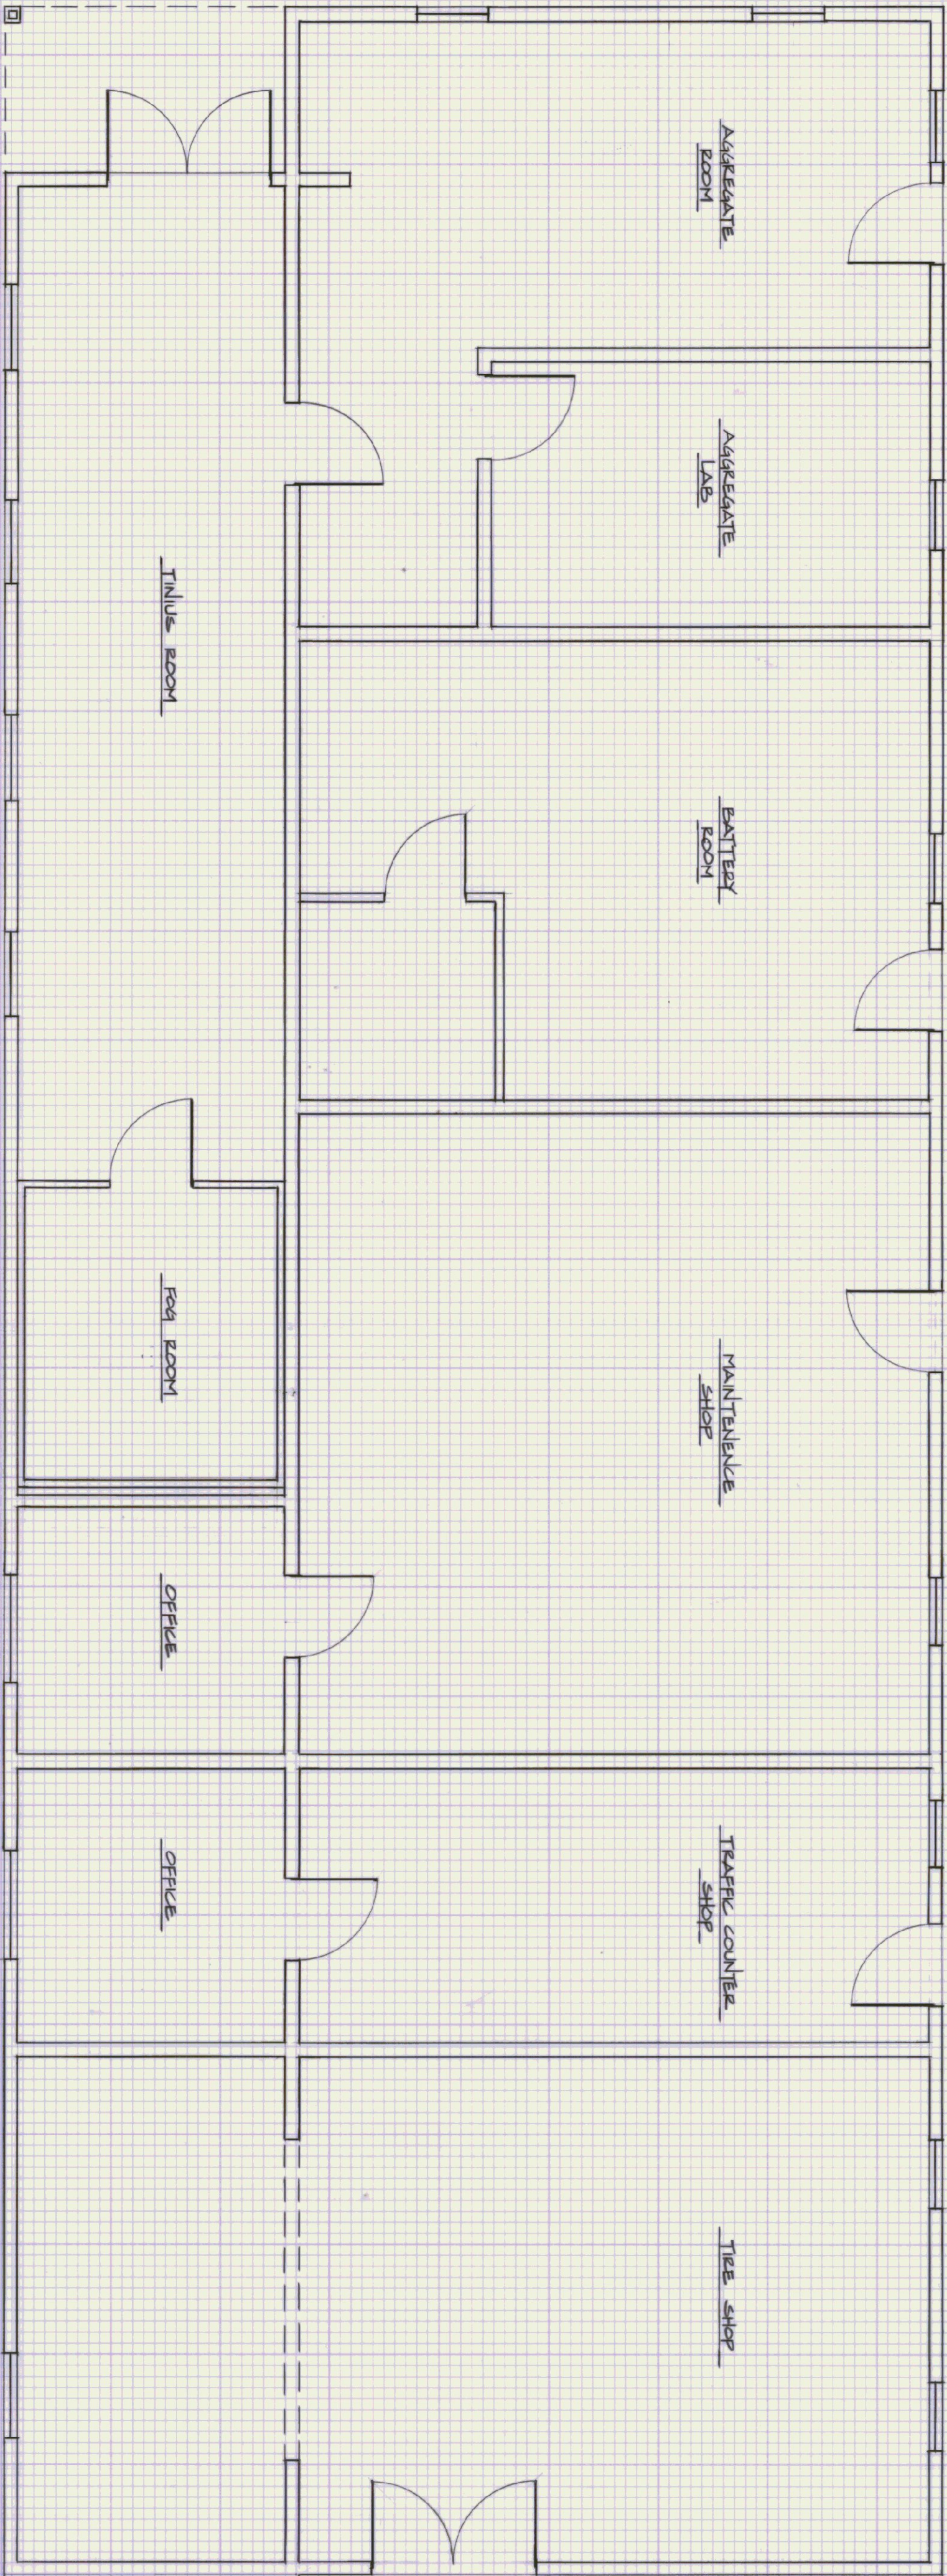

FLOOR PLAN  
SCALE: 1/4" = 1'-0"

"AS BUILT"

STATE OF VERMONT  
DEPARTMENT OF STATE BUILDINGS  
AGENCY OF ADMINISTRATION  
MONTPELIER, VERMONT

MATERIALS  
RESEARCH & LABORATORY  
ANNEX

|           |            |              |              |
|-----------|------------|--------------|--------------|
| BERLIN,   |            | VERMONT      |              |
| DATE:     | MARCH 1992 | SCALE:       | 1/4" = 1'-0" |
| DRAWN BY: | J. GILES   | APPROVED BY: |              |
|           |            | REVISIONS:   | DWG. NO.     |
|           |            |              | OF           |