



NORTHBOUND
REST AREA

LEGEND NOTE: FOR ALL SHEETS	
	EXISTING YARD LIGHTING
	EXISTING PEDESTAL TRANSFORMER
	EXISTING HARDWOOD TREE
	TRAFFIC FLOW DIRECTION
	NEW SEWER MANHOLE
	EXISTING ELECTRICAL HANDHOLE
	EXISTING SHRUBS
	EXISTING FLAG POLES
	SIGNAGE
	EXISTING MONUMENT
	EXISTING WELL
	EXISTING MANHOLE PIERS
	CATCH BASIN
	EXISTING UTILITY POLE
	EXISTING TELEPHONE SERVICE
	EXISTING ELECTRICAL SERVICE
	NEW ELECTRICAL SERVICE
	EXISTING CONTOUR
	EXISTING CHAIN LINK/WOVEN WIRE FENCE
	EXISTING TREE LINE
	EXISTING RIGHT-OF-WAY
	EXISTING PROPERTY LINE
	EXISTING DRAINAGE SWALE
	CENTERLINE OF ROAD
	NEW SANITARY SEWER
	NEW PRESSURE SEWER
	EXISTING WATER LINE
	EXISTING STORM DRAIN
	NEW SILT FENCE
	GRANITE CURBING

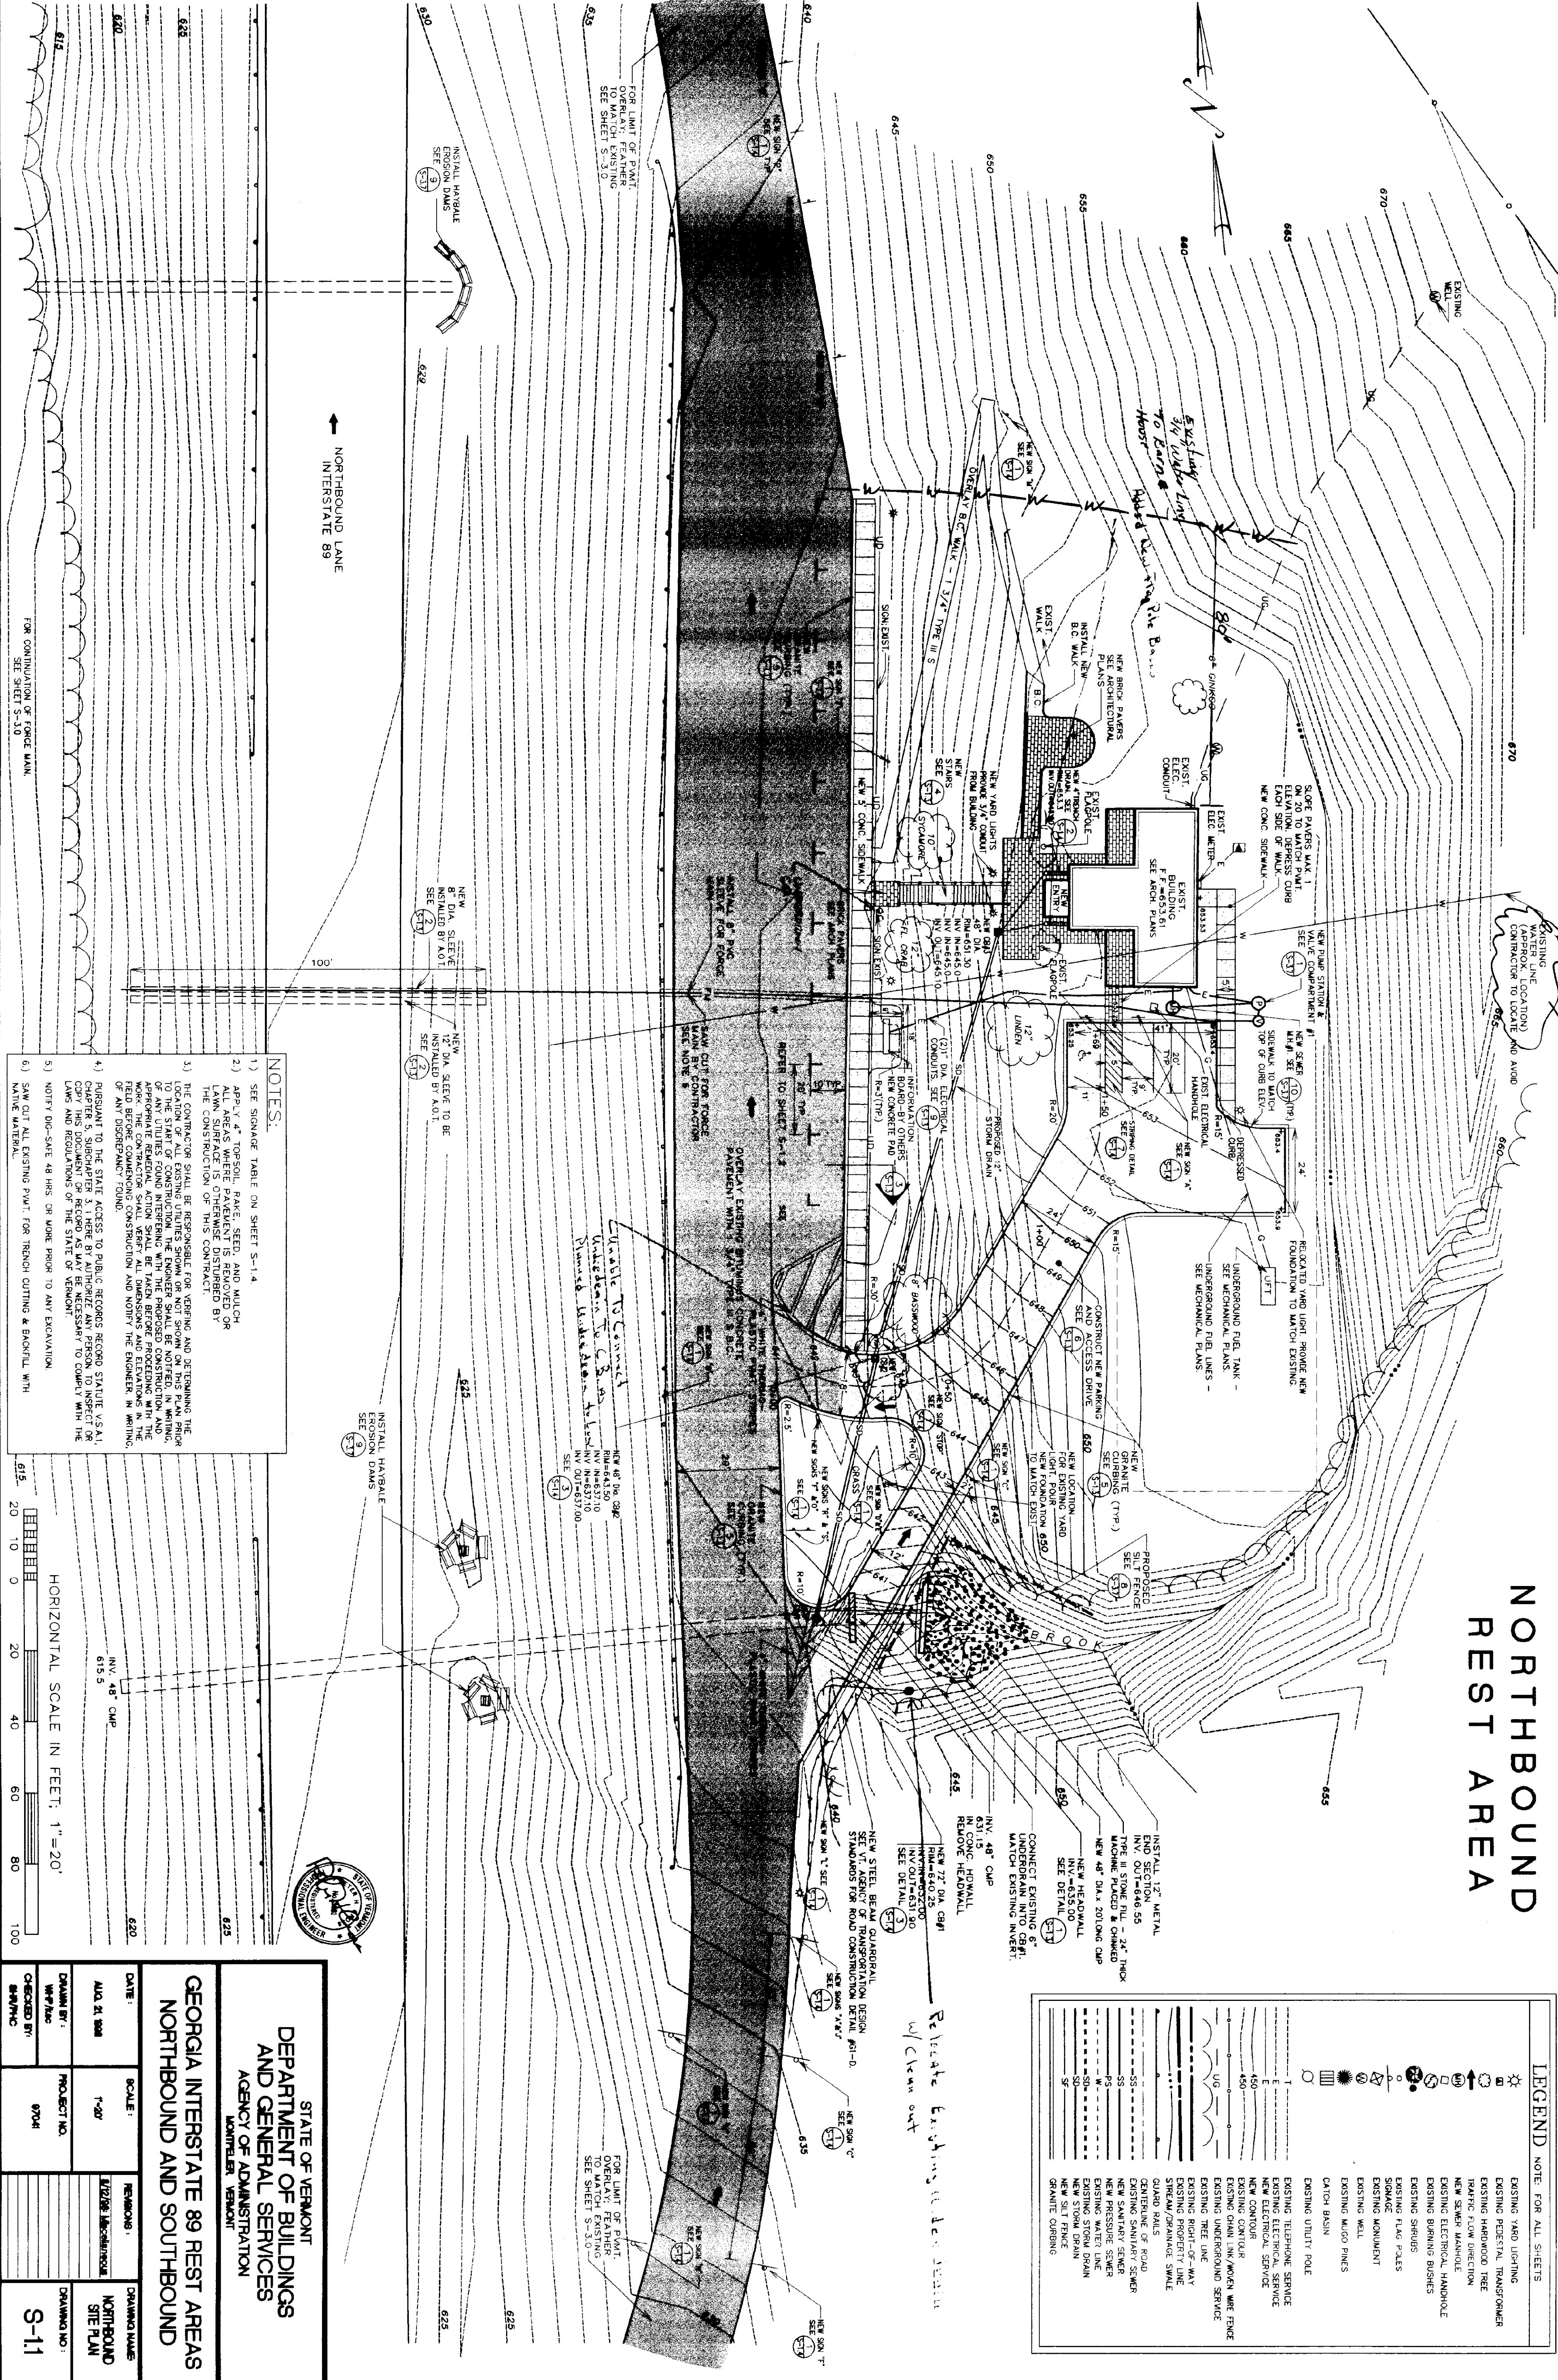

- NOTES:
- 1) SEE SIGNAGE TABLE ON SHEET S-1.4
 - 2) APPLY 4" TOP-SOIL, FERTILIZER, SEED, AND MULCH. MAINTAINING AREAS ARE OTHERWISE DISTURBED BY THE CONSTRUCTION OF THIS CONTRACT.
 - 3) THE CONTRACTOR SHALL BE RESPONSIBLE FOR OBTAINING AND DETERMINING THE LOCATION OF ALL EXISTING UTILITIES SHOWN OR NOT SHOWN ON THIS PLAN PRIOR TO THE START OF CONSTRUCTION. THE ENGINEER SHALL BE NOTIFIED IN WRITING OF ANY UTILITIES FOUND INTERFERING WITH THE PROPOSED CONSTRUCTION, AND WORK. THE CONTRACTOR SHALL VERIFY ALL DIMENSIONS AND ELEVATIONS IN THE FIELD BEFORE COMMENCING CONSTRUCTION AND NOTIFY THE ENGINEER IN WRITING OF ANY DISCREPANCY FOUND.
 - 4) PURSUANT TO THE STATE ACCESS TO PUBLIC RECORDS RECORD STATUTE V.S.A. CHAPTER 5, SUBCHAPTER 3, I HEREBY AUTHORIZE ANY PERSON TO INSPECT OR COPY THIS DOCUMENT OR RECORD AS MAY BE NECESSARY TO COMPLY WITH THE LAWS AND REGULATIONS OF THE STATE OF VERMONT.
 - 5) NOTIFY DOW-SAFE 48 HRS. OR MORE PRIOR TO ANY EXCAVATION.
 - 6) SAW CUT ALL EXISTING PAVT. FOR TRENCH CUTTING & BACKFILL WITH SAME MATERIAL.

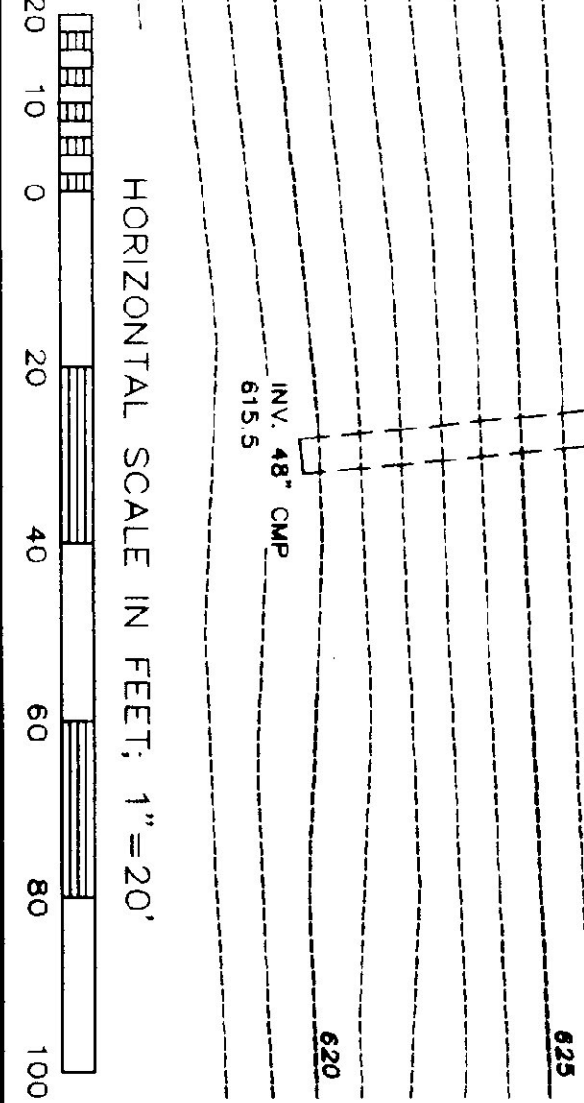

STATE OF VERMONT DEPARTMENT OF BUILDINGS AND GENERAL SERVICES AGENCY OF ADMINISTRATION NORTHVERMONT			
GEORGIA INTERSTATE 89 REST AREAS NORTHBOUND AND SOUTHBOUND			
DATE:	SCALE:	REVISIONS:	DRAWING NAME:
AUG. 21, 1998	1"=20'	1. 2/24/99 AS BUILT	NORTHBOUND SITE PLAN
DRAWN BY: WJF/lac	PROJECT NO. 87041	CHECKED BY: BWW/MC	DRAWING NO.: S-1.1