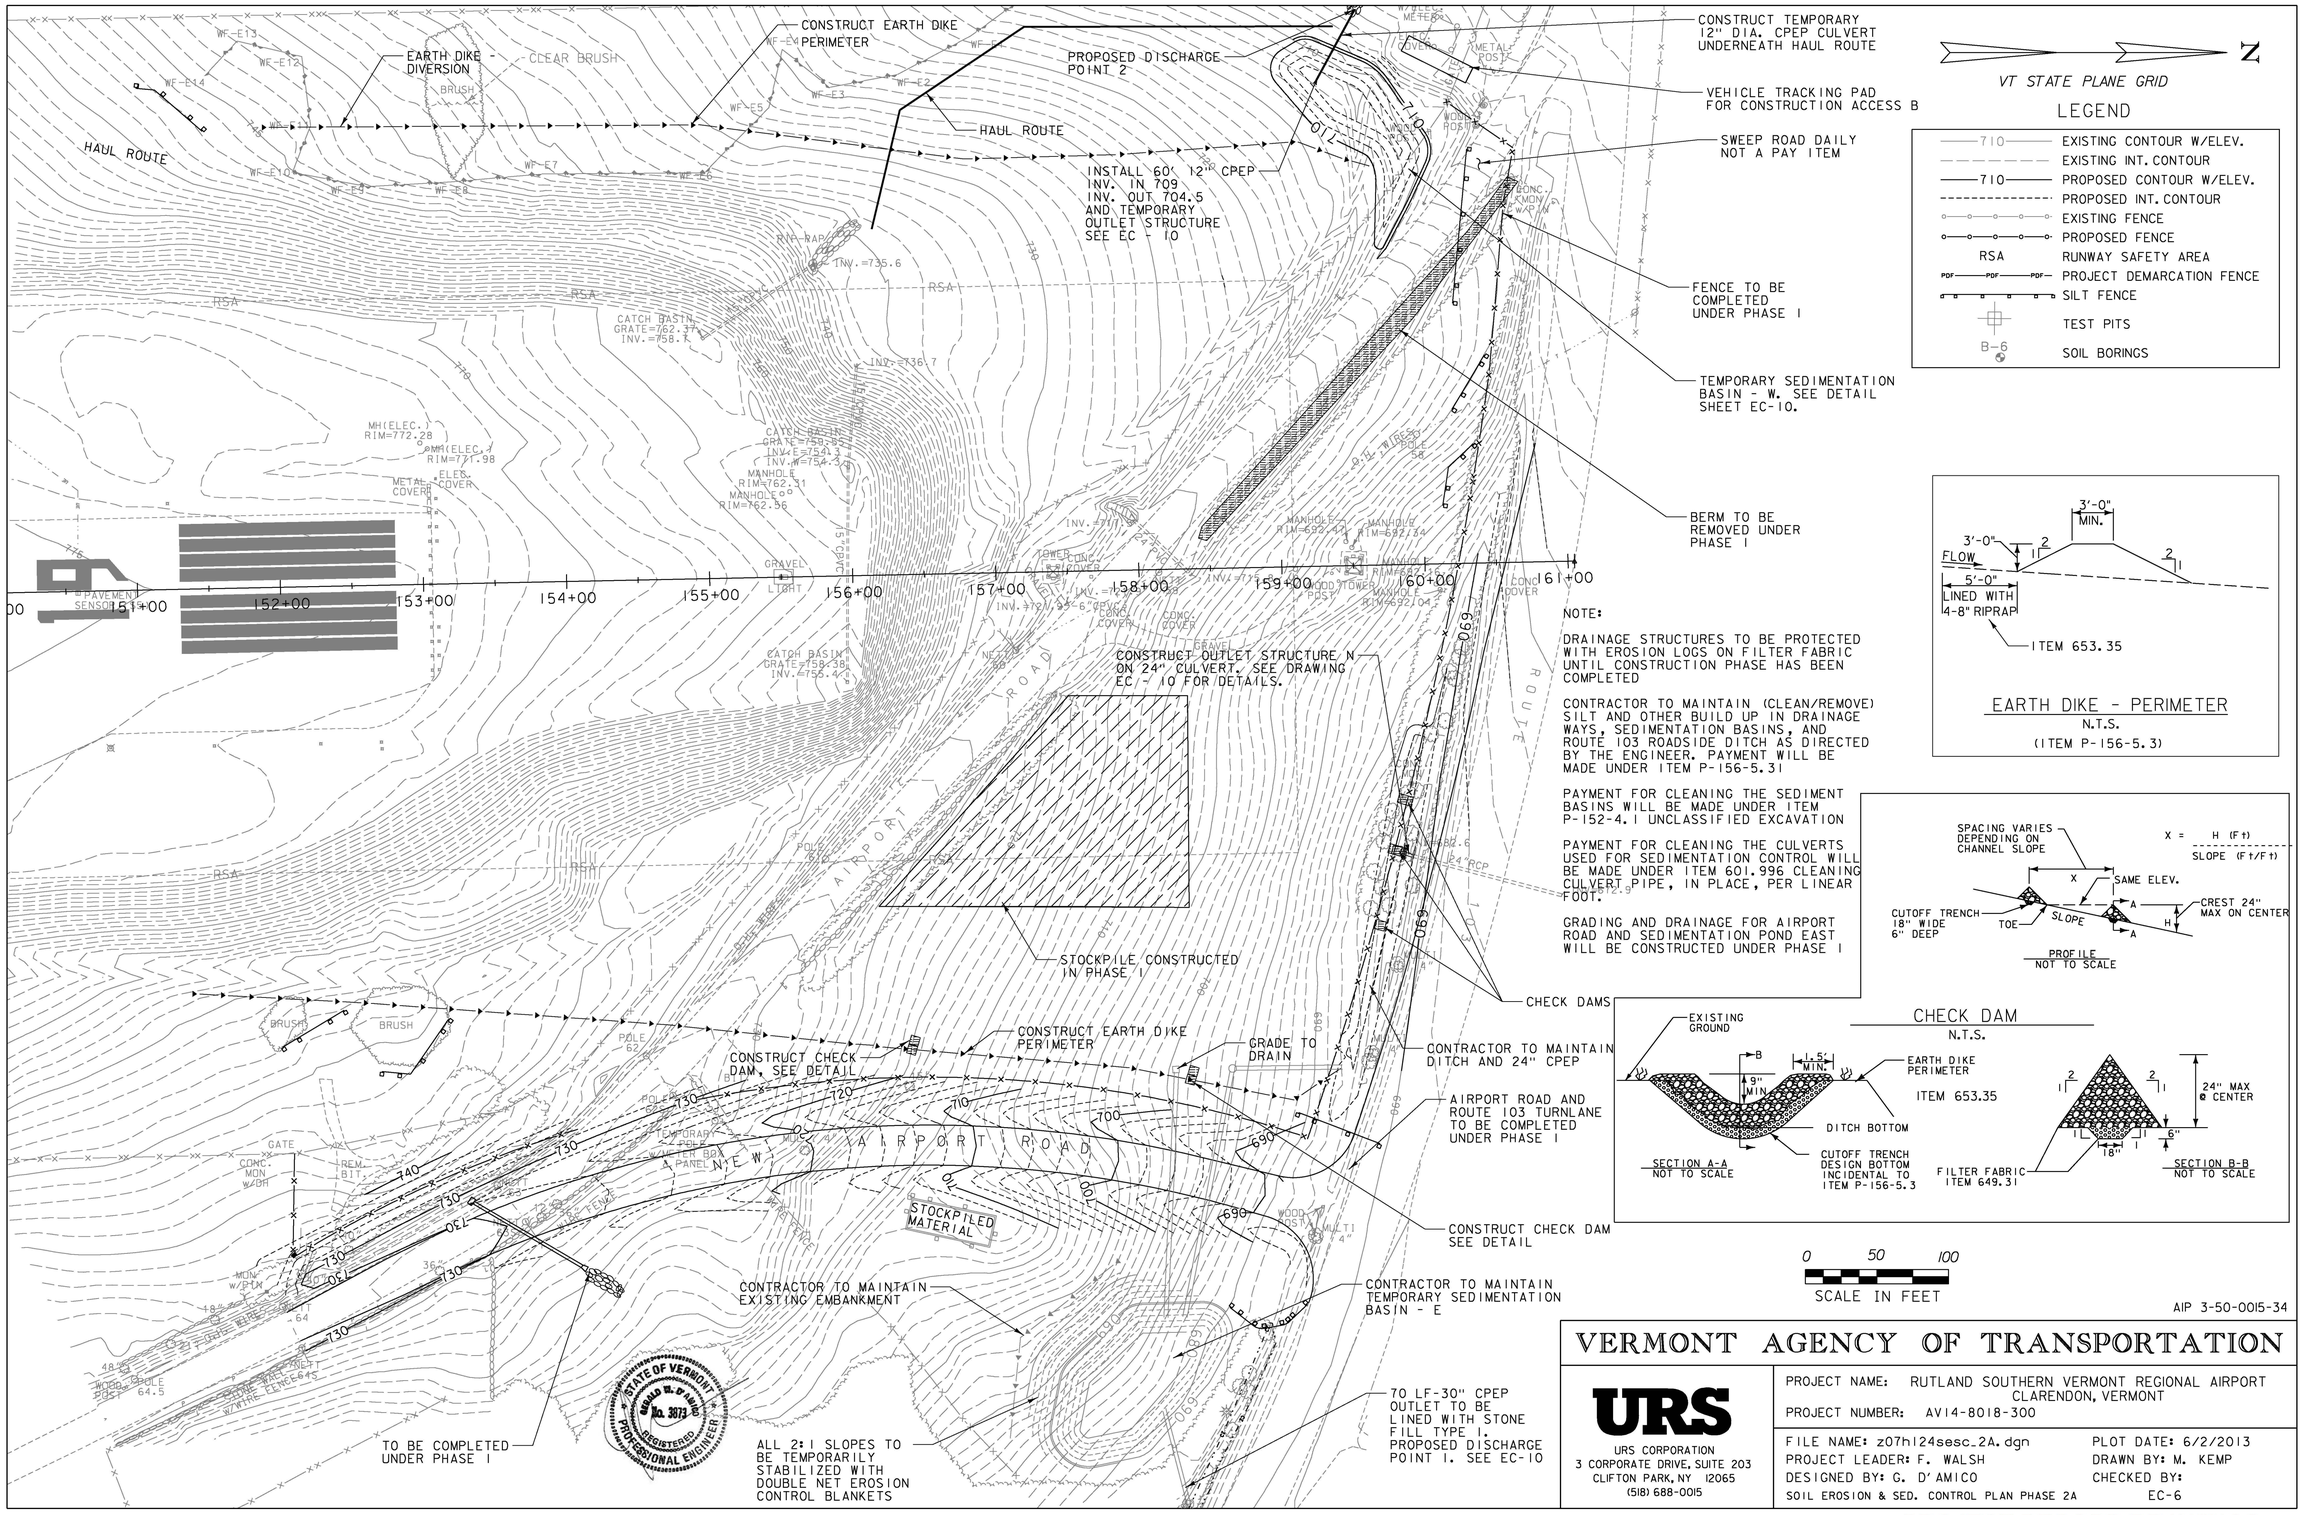

NOTE:

DRAINAGE STRUCTURES TO BE PROTECTED WITH EROSION LOGS ON FILTER FABRIC UNTIL CONSTRUCTION PHASE HAS BEEN COMPLETED

CONTRACTOR TO MAINTAIN (CLEAN/REMOVE) SILT AND OTHER BUILD UP IN DRAINAGE WAYS, SEDIMENTATION BASINS, AND ROUTE 103 ROADSIDE DITCH AS DIRECTED BY THE ENGINEER. PAYMENT WILL BE MADE UNDER ITEM P-156-5.31

PAYMENT FOR CLEANING THE SEDIMENT BASINS WILL BE MADE UNDER ITEM P-152-4.1 UNCLASSIFIED EXCAVATION

PAYMENT FOR CLEANING THE CULVERTS USED FOR SEDIMENTATION CONTROL WILL BE MADE UNDER ITEM 601.996 CLEANING CULVERT PIPE, IN PLACE, PER LINEAR FOOT.

GRADING AND DRAINAGE FOR AIRPORT ROAD AND SEDIMENTATION POND EAST WILL BE CONSTRUCTED UNDER PHASE I

VERMONT AGENCY OF TRANSPORTATION

URS

URS CORPORATION
3 CORPORATE DRIVE, SUITE 203
CLIFTON PARK, NY 12065
(518) 688-0015

PROJECT NAME: RUTLAND SOUTHERN VERMONT REGIONAL AIRPORT
CLARENDON, VERMONT

PROJECT NUMBER: AV14-8018-300

FILE NAME: z07h124sesc_2A.dgn
PLOT DATE: 6/2/2013
PROJECT LEADER: F. WALSH
DRAWN BY: M. KEMP
DESIGNED BY: G. D'AMICO
CHECKED BY:
SOIL EROSION & SED. CONTROL PLAN PHASE 2A
EC-6

6/2/2013
P:\CADD\Consultants\z07h124sesc_2A.dgn

PROJECT RECORD DRAWINGS