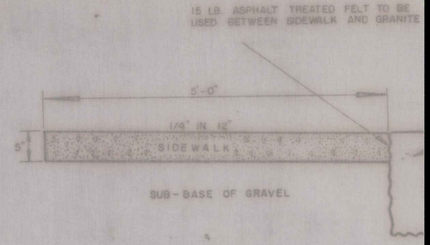

ONE COURSE CEMENT CONCRETE SIDEWALK,
(WITH GRANITE CURB)

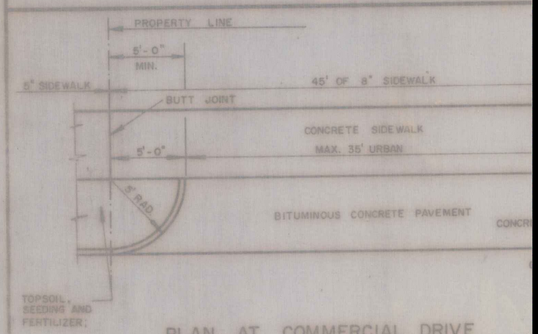

PLAN AT COMMERCIAL DRIVE

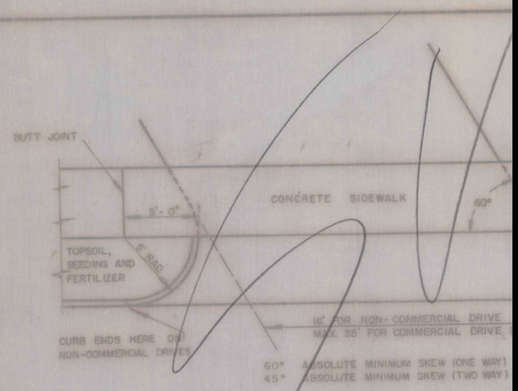

PLAN AT ASKEW DRIVE

REVISIONS AND CORRECTIONS

THIS SHEET AND C-2-a, SUPERCEDE SHEET C-2 APPROVED MAY 26, 1958
DETAILS OF GRANITE CURB ENDS CHANGED JUNE 16, 1959
DIMENSIONS FOR COMMERCIAL DRIVES CHANGED FROM 30' TO 35' URBAN SEPT 25, 1959.
DIMENSION 'F' FOR SKEW DRIVE MADE PARALLEL TO ROAD CENTERLINE AND DISTANCE TO PROPERTY LINE AND BETWEEN DRIVES, NOTED OCT. 13, 1959

APPROVED