PLAN	SURVEYED	BY	DATE
	PLOTTED		
NOTE BOOK	ALIGNMENT CHECKED		
No.	RT. OF WAY CHECKED		
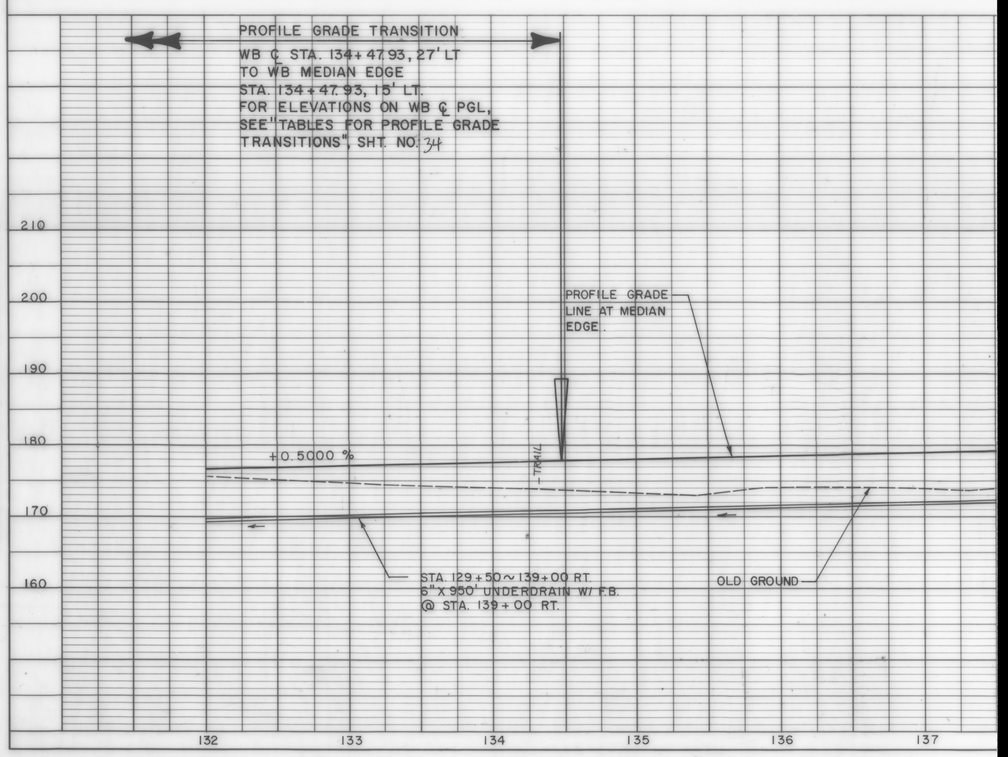
PROFILE	SURVEYED	BY	DATE
	PLOTTED		
NOTE BOOK	GRADES CHECKED		
	B. M. & NOTED		
No.	STRUCTURE NOTATIONS CHECKED