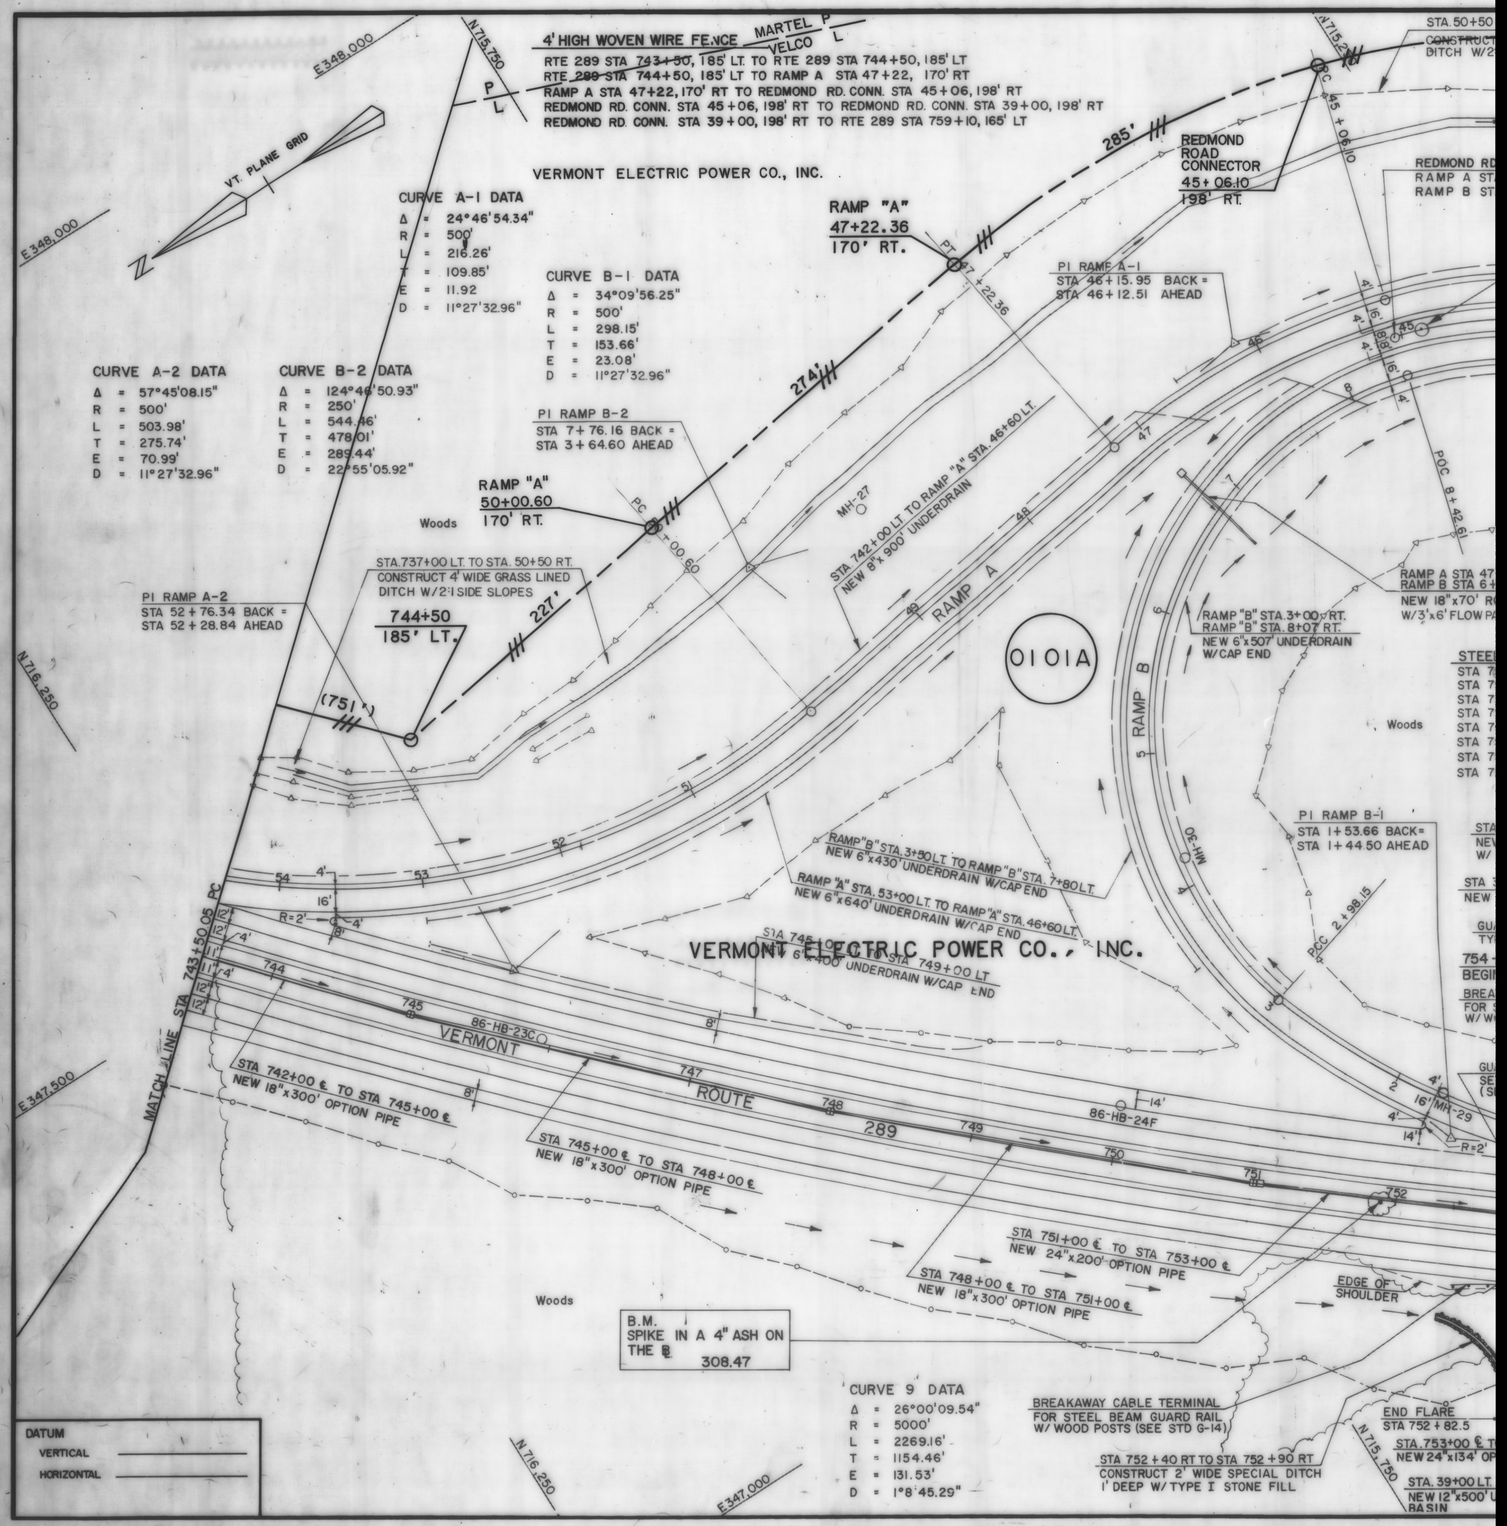

4' HIGH WOVEN WIRE FENCE
MARTEL P
VELCO L
RTE 289 STA 743+50, 185' LT. TO RTE 289 STA 744+50, 185' LT
RTE 289 STA 744+50, 185' LT TO RAMP A STA 47+22, 170' RT
RAMP A STA 47+22, 170' RT TO REDMOND RD. CONN. STA 45+06, 198' RT
REDMOND RD. CONN. STA 45+06, 198' RT TO REDMOND RD. CONN. STA 39+00, 198' RT
REDMOND RD. CONN. STA 39+00, 198' RT TO RTE 289 STA 759+10, 165' LT
VERMONT ELECTRIC POWER CO., INC.
VT. PLANE GRID
E 348,000
N 715,750
CURVE A-1 DATA
Δ = 24°46'54.34"
R = 500'
L = 216.26'
T = 109.85'
E = 11.92
D = 11°27'32.96"
CURVE B-1 DATA
Δ = 34°09'56.25"
R = 500'
L = 298.15'
T = 153.66'
E = 23.08'
D = 11°27'32.96"
CURVE A-2 DATA
Δ = 57°45'08.15"
R = 500'
L = 503.98'
T = 275.74'
E = 70.99'
D = 11°27'32.96"
CURVE B-2 DATA
Δ = 124°46'50.93"
R = 250'
L = 544.46'
T = 478.01'
E = 289.44'
D = 22°55'05.92"
RAMP "A"
47+22.36
170' RT.
285'
274'
227'
REDMOND ROAD CONNECTOR
45+06.10
198' RT.
PI RAMP A-1
STA 46+15.95 BACK =
STA 46+12.51 AHEAD
PI RAMP B-2
STA 7+76.16 BACK =
STA 3+64.60 AHEAD
RAMP "A"
50+00.60
170' RT.
Woods
STA 737+00 LT. TO STA. 50+50 RT.
CONSTRUCT 4' WIDE GRASS LINED DITCH W/2:1 SIDE SLOPES
PI RAMP A-2
STA 52+76.34 BACK =
STA 52+28.84 AHEAD
744+50
185' LT.
(751')
STA 742+00 LT. TO RAMP "A" STA. 46+60 LT.
NEW 8"x900' UNDERDRAIN
RAMP A
RAMP B
0101A
RAMP "B" STA. 3+00 RT.
RAMP "B" STA. 8+07 RT.
NEW 6"x507' UNDERDRAIN W/CAP END
RAMP "B" STA. 3+50 LT. TO RAMP "B" STA. 7+80 LT.
NEW 6"x430' UNDERDRAIN W/CAP END
RAMP "A" STA. 53+00 LT. TO RAMP "A" STA. 46+60 LT.
NEW 6"x640' UNDERDRAIN W/CAP END
STA 745+00 LT. TO STA 749+00 LT
NEW 6"x400' UNDERDRAIN W/CAP END
PI RAMP B-1
STA 1+53.66 BACK=
STA 1+44.50 AHEAD
VERMONT ELECTRIC POWER CO., INC.
MATCH LINE STA 743+50.05 PC
VERMONT ROUTE 289
86-HB-23C
86-HB-24F
STA 742+00 ℄ TO STA 745+00 ℄
NEW 18"x300' OPTION PIPE
STA 745+00 ℄ TO STA 748+00 ℄
NEW 18"x300' OPTION PIPE
STA 751+00 ℄ TO STA 753+00 ℄
NEW 24"x200' OPTION PIPE
STA 748+00 ℄ TO STA 751+00 ℄
NEW 18"x300' OPTION PIPE
EDGE OF SHOULDER
B.M. SPIKE IN A 4" ASH ON THE ℄ 308.47
CURVE 9 DATA
Δ = 26°00'09.54"
R = 5000'
L = 2269.16'
T = 1154.46'
E = 131.53'
D = 1°8'45.29"
BREAKAWAY CABLE TERMINAL FOR STEEL BEAM GUARD RAIL W/ WOOD POSTS (SEE STD G-14)
STA 752+40 RT TO STA 752+90 RT
CONSTRUCT 2' WIDE SPECIAL DITCH 1' DEEP W/ TYPE I STONE FILL
END FLARE
STA 752+82.5
STA. 39+00 LT.
NEW 12"x500' U
BASIN
DATUM
VERTICAL
HORIZONTAL
N 716,250
E 347,000
E 347,500