
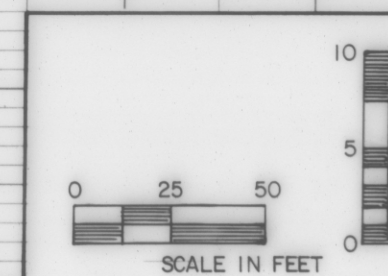


PLAN	DATE	BY	NO.
NOTE BOOK			

PROFILE	DATE	BY	NO.
NOTE BOOK			

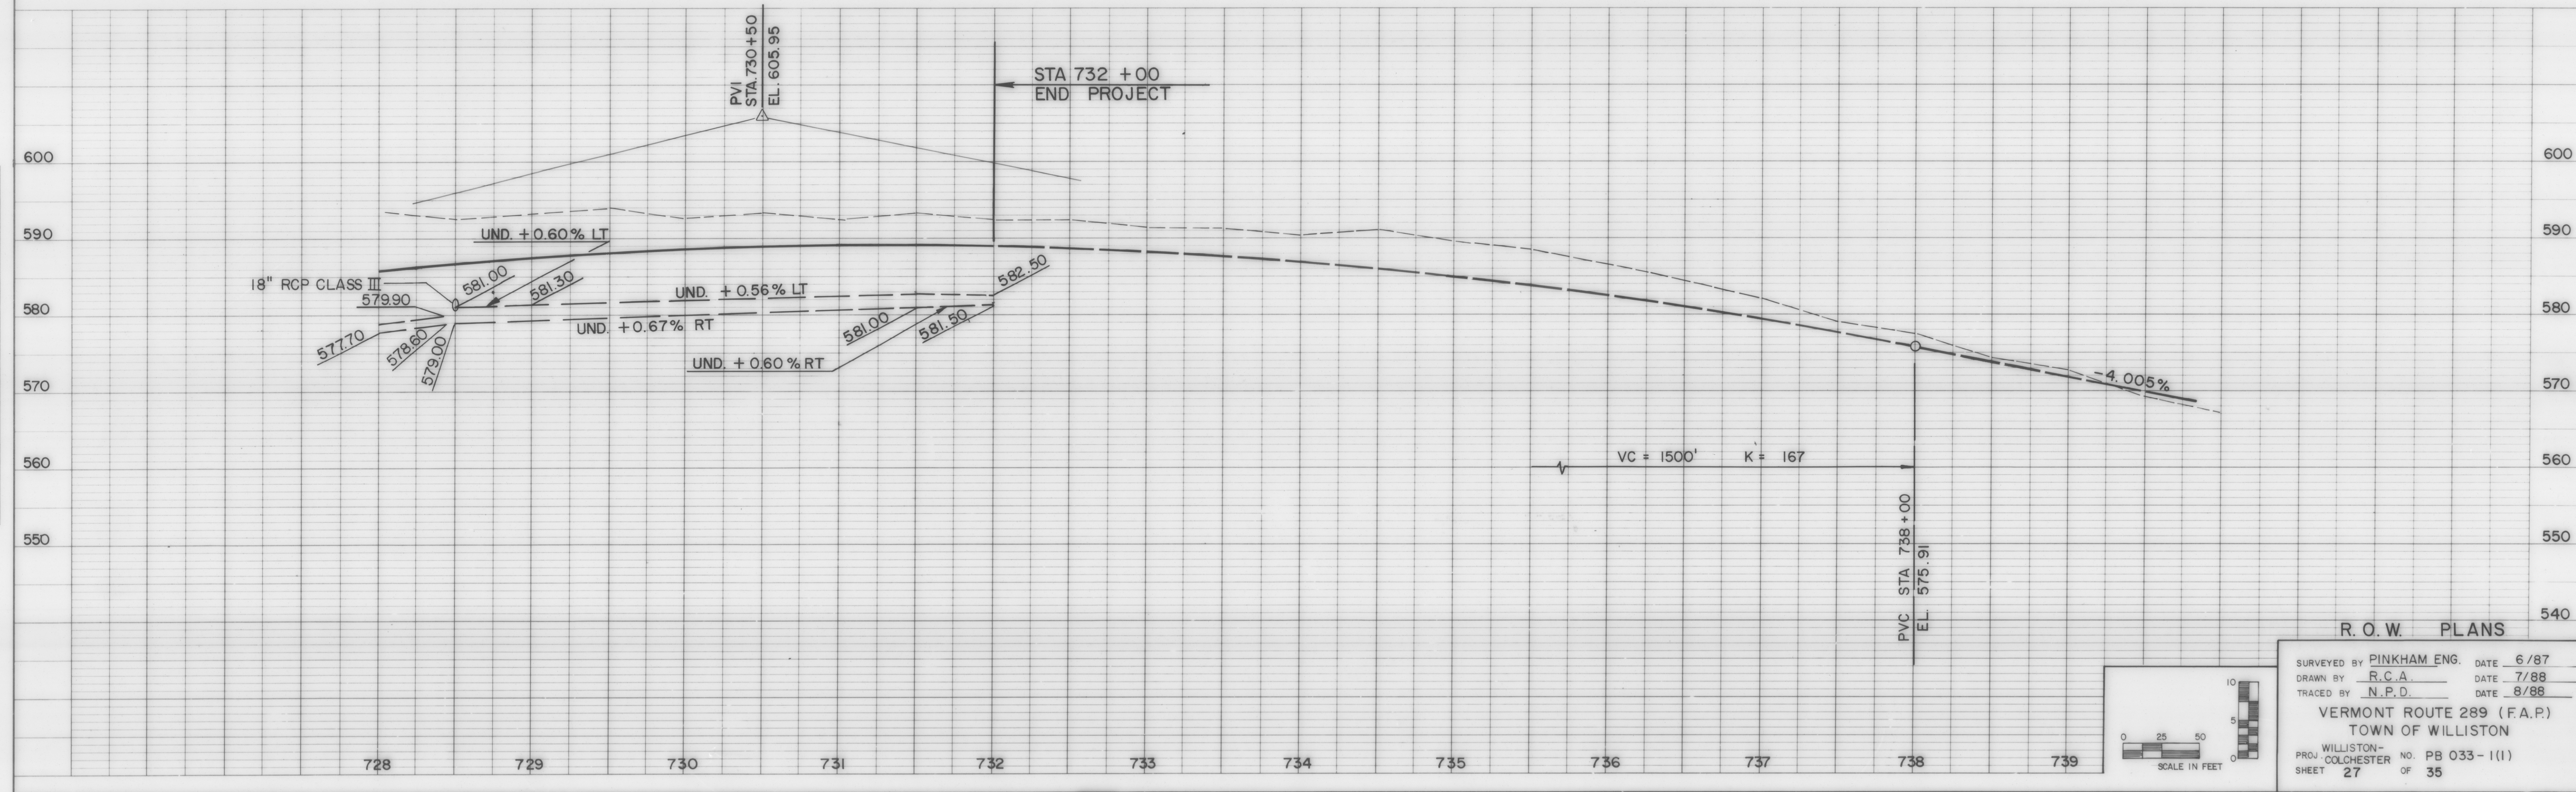

R. O. W. PLANS

SURVEYED BY PINKHAM ENG. DATE 6/87
 DRAWN BY R.C.A. DATE 7/88
 TRACED BY N.P.D. DATE 8/88
 VERMONT ROUTE 289 (F.A.P.)
 TOWN OF WILLISTON
 PROJ. COLCHESTER NO. PB 033-1(1)
 SHEET 27 OF 35