


PLAN	DATE	BY
	SURVEYED	
	NOTED	
	ALIGNED CHECKED	
NOTE BOOK	No.	

PROFILE	DATE	BY
	SURVEYED	
	NOTED	
	GRADES CHECKED	
NOTE BOOK	No.	

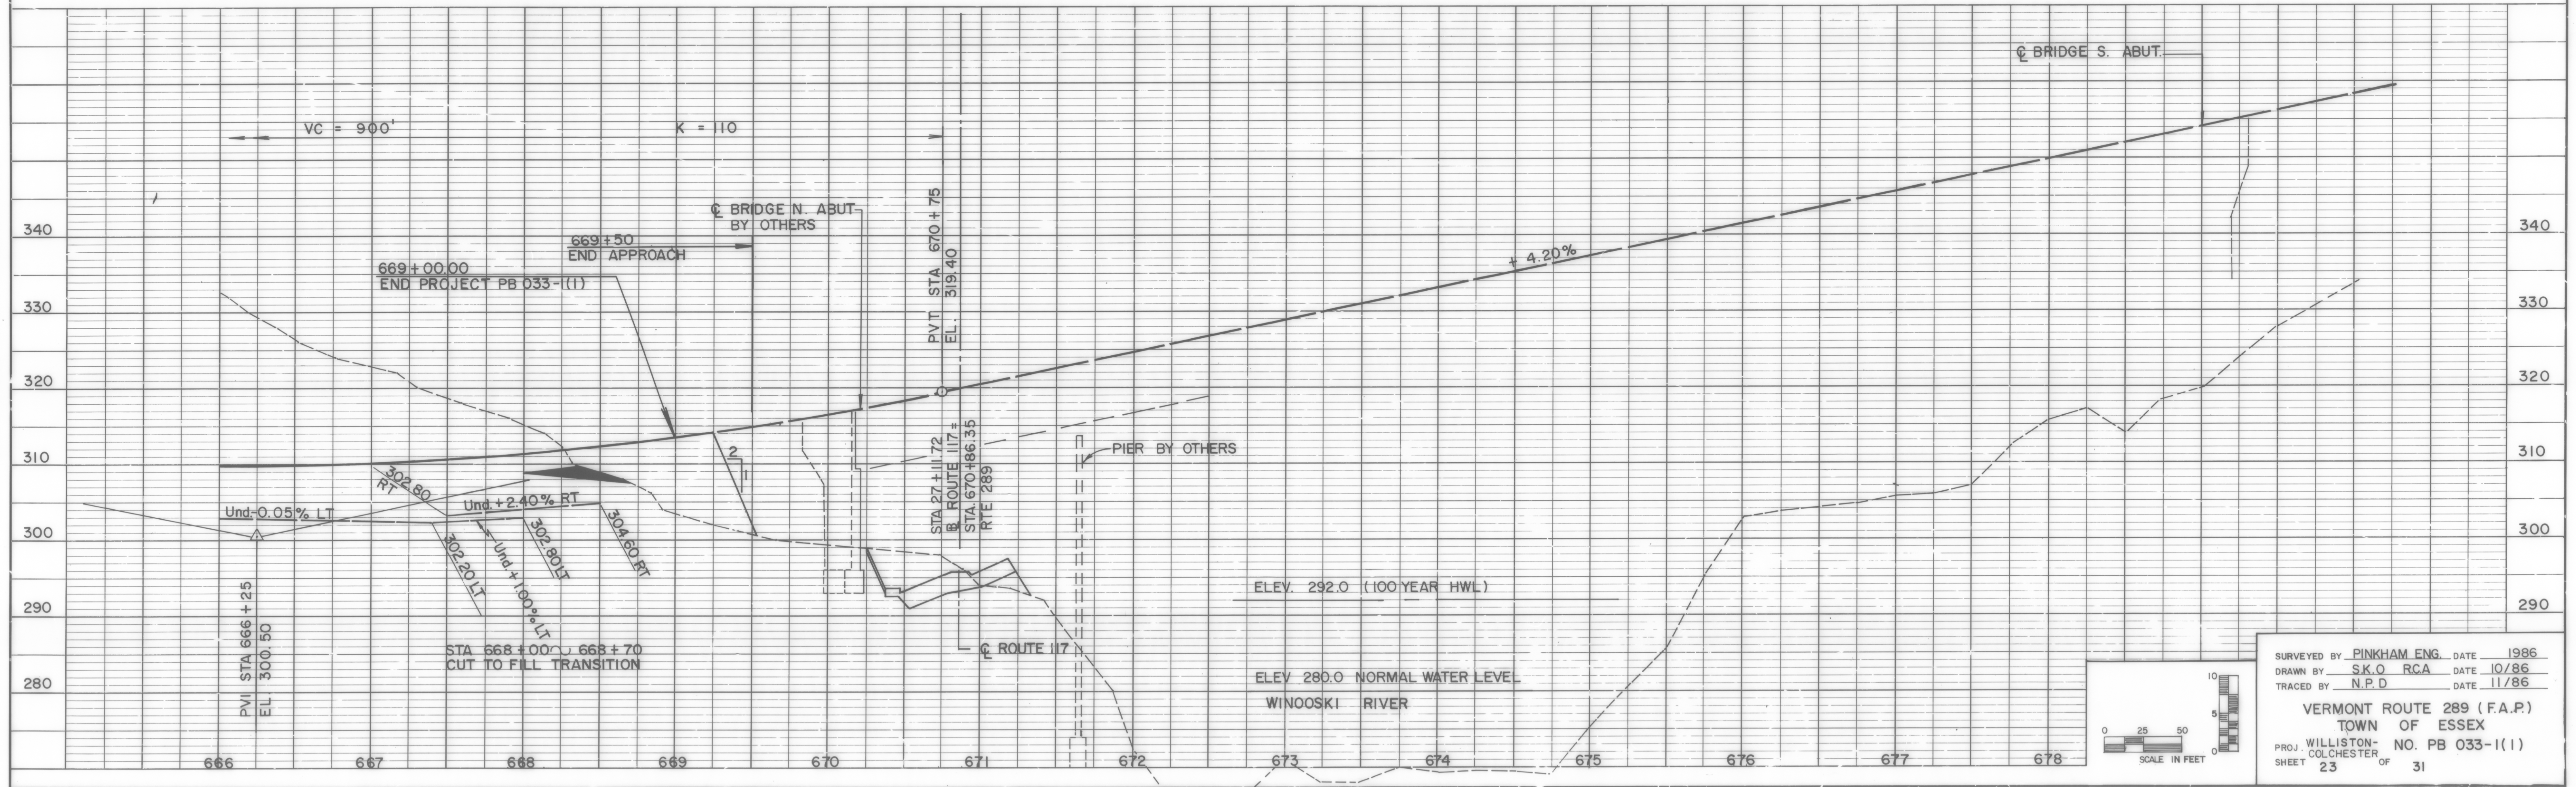

SURVEYED BY PINKHAM, ENG. DATE 1986
 DRAWN BY S.K.O. RCA DATE 10/86
 TRACED BY N.P.D. DATE 11/86
 VERMONT ROUTE 289 (F.A.P.)
 TOWN OF ESSEX
 PROJ. WILLISTON- COLCHESTER NO. PB 033-1(1)
 SHEET 23 OF 31