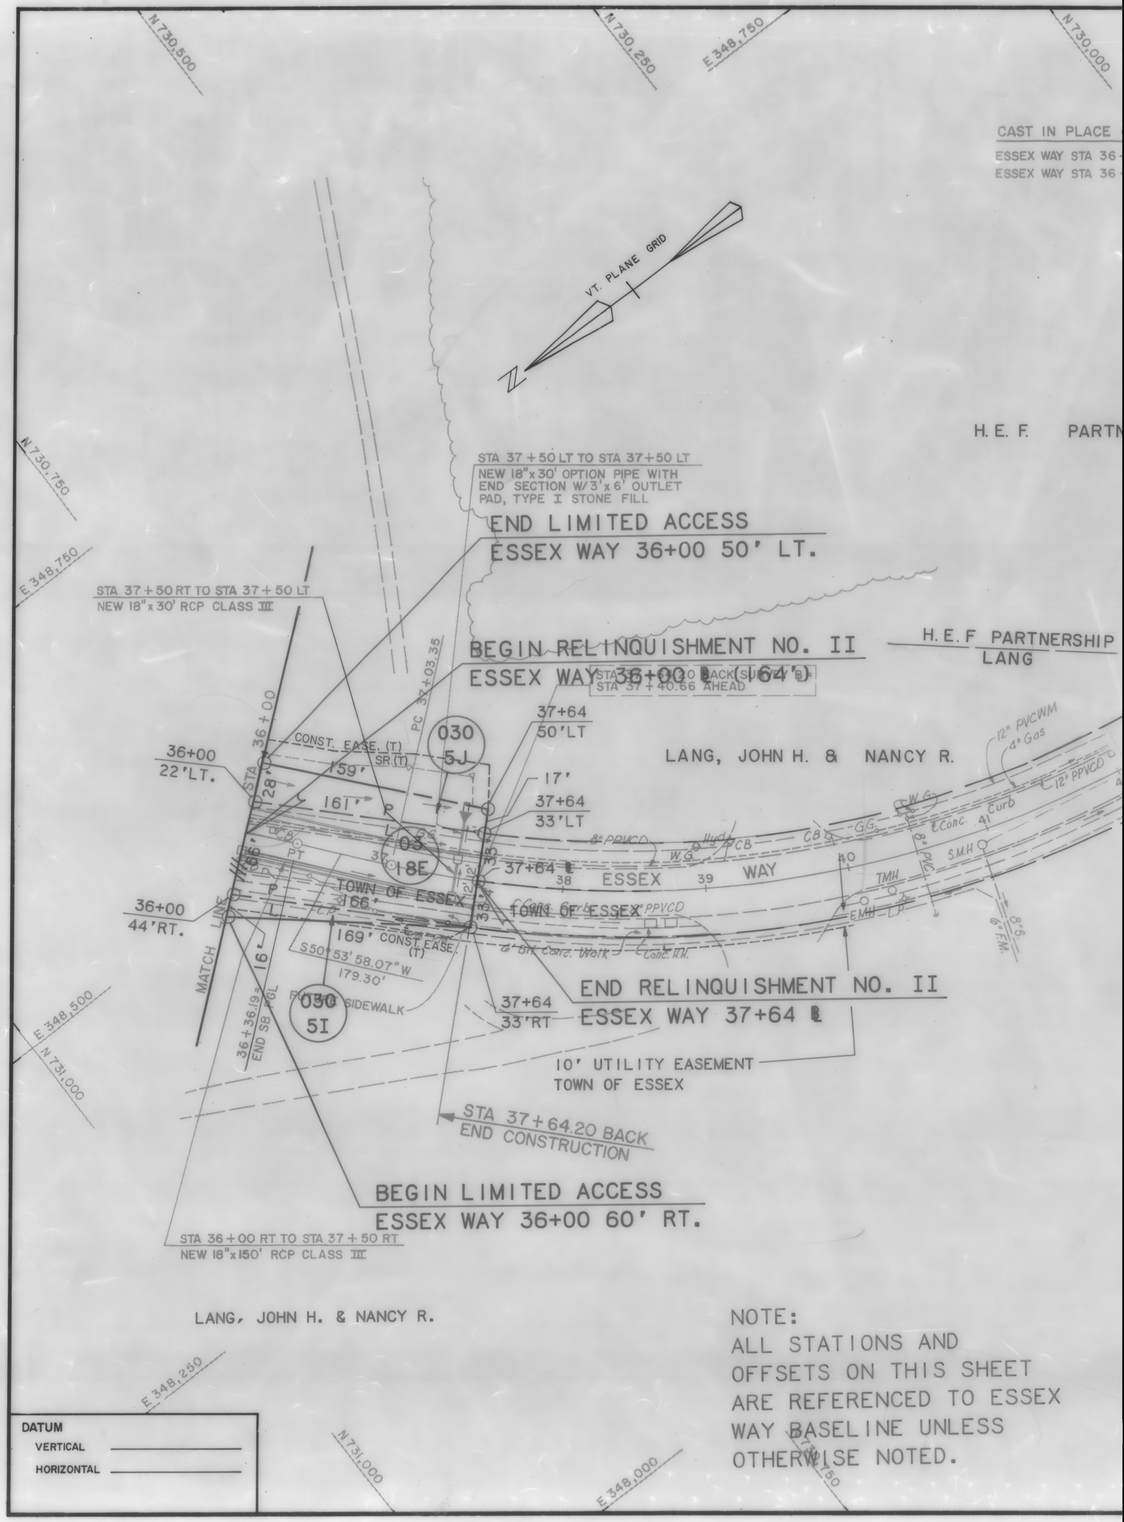

NOTE:
ALL STATIONS AND
OFFSETS ON THIS SHEET
ARE REFERENCED TO ESSEX
WAY BASELINE UNLESS
OTHERWISE NOTED.

DATUM
VERTICAL _____
HORIZONTAL _____