

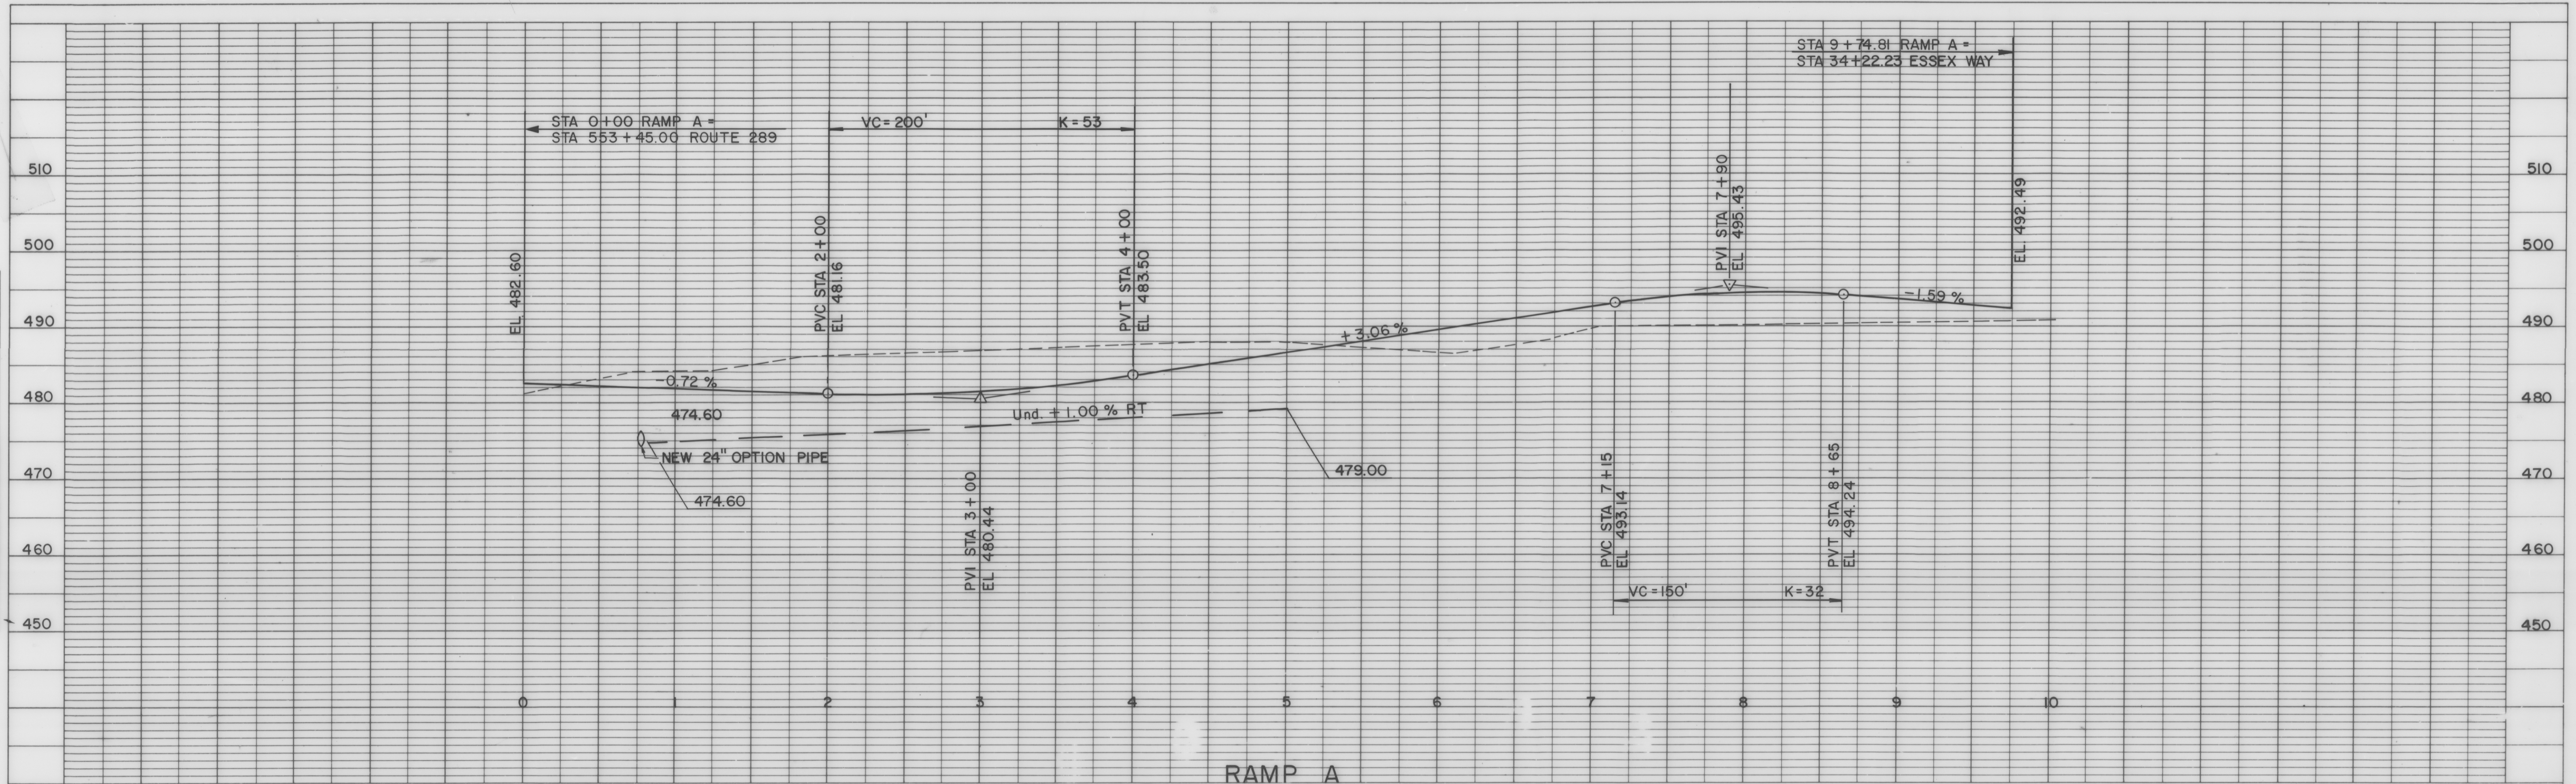


PROFILE	SURVEYED	DATE
	NOTED	
	GRADES CHECKED	
	B.M. # NOTED	
NO. _____		

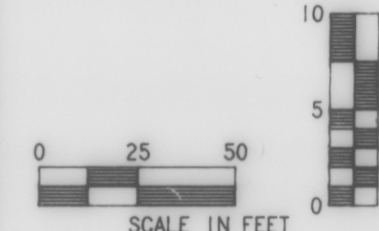

PROFILE	SURVEYED	DATE
	NOTED	
	GRADES CHECKED	
	B.M. # NOTED	
NO. _____		

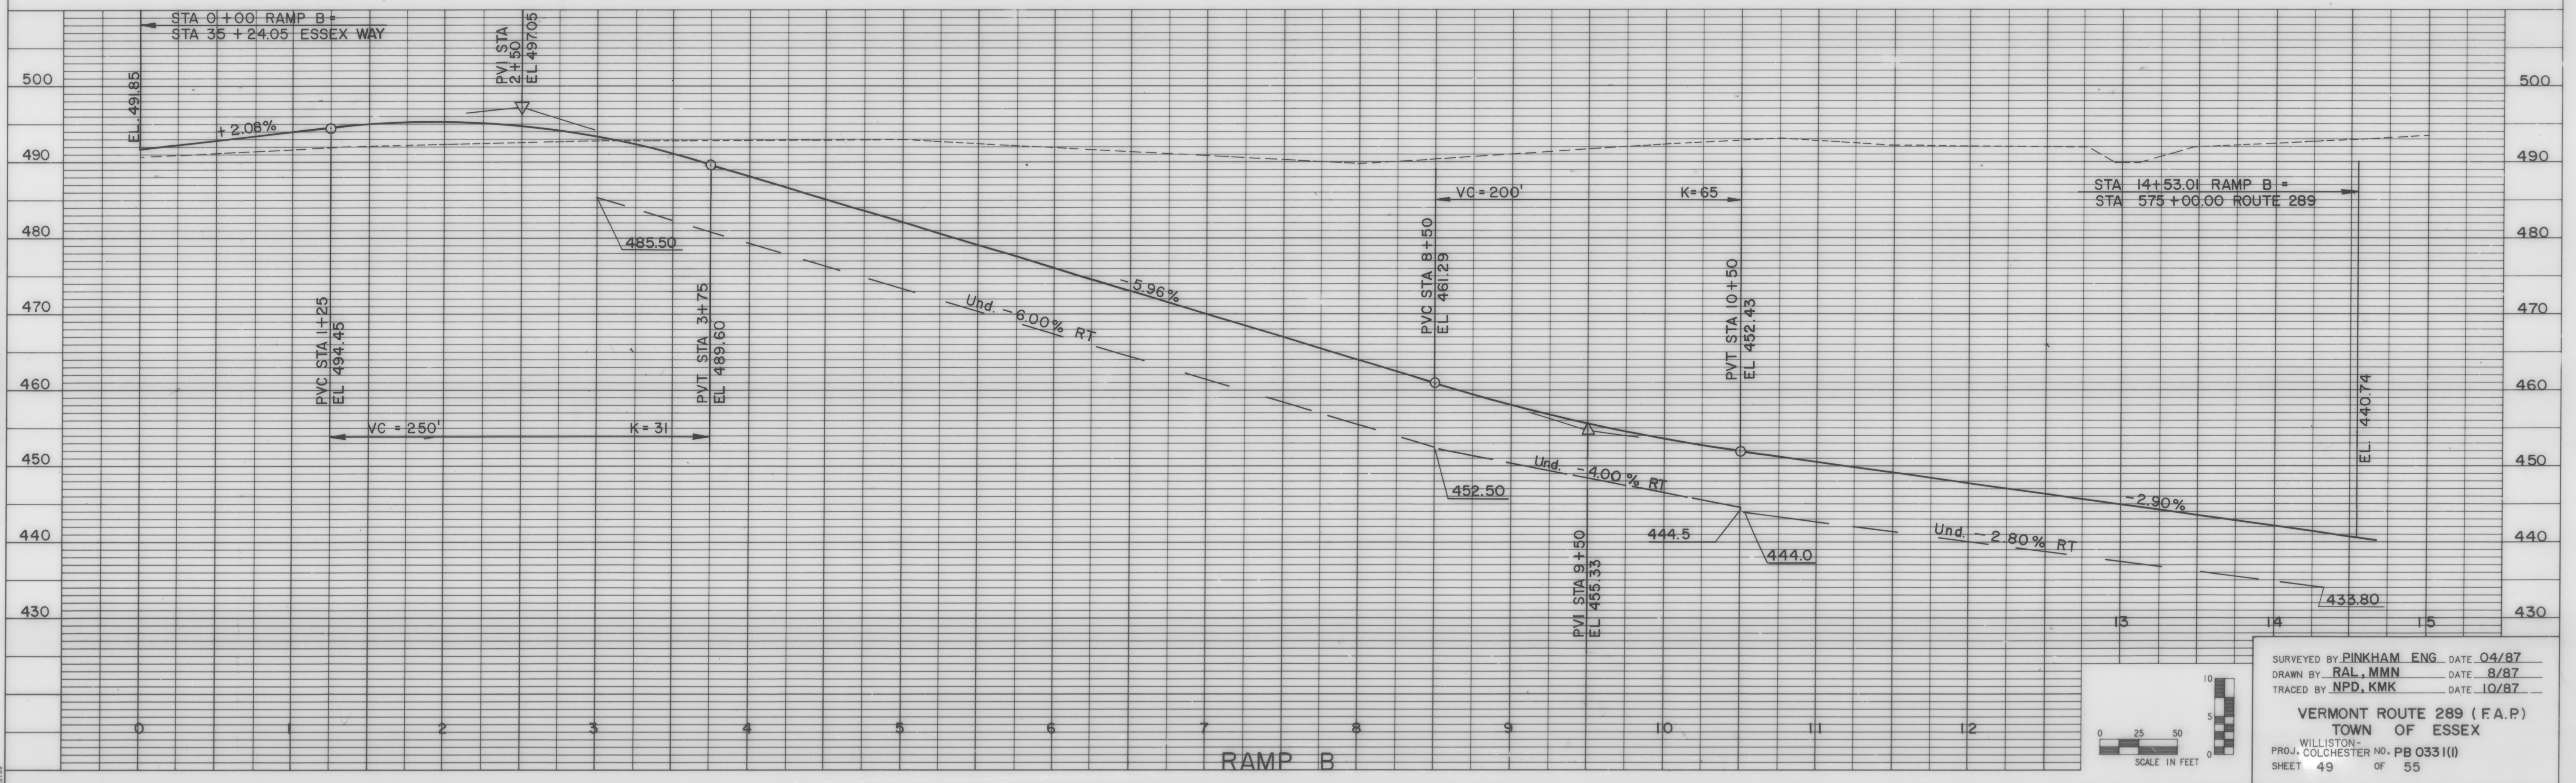

SURVEYED BY PINKHAM, ENG. DATE 04/87
 DRAWN BY RAL. MMN DATE 8/87
 TRACED BY NPD, KMK DATE 10/87
 VERMONT ROUTE 289 (F.A.P.)
 TOWN OF ESSEX
 WILLISTON-
 PROJ. COLCHESTER NO. PB 0331(I)
 SHEET 49 OF 55

ESSEX WAY INTERCHANGE