
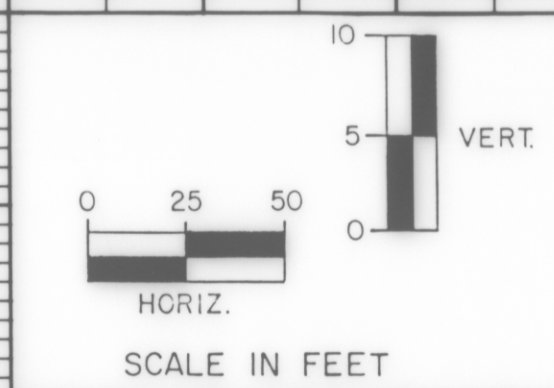


PLAN	SURVEYED	BY	DATE
	NOTE BOOK	ALIGNED	CHECKED
	NO.	RT.	OF WAY
	CHECKED		

PROFILE	SURVEYED	BY	DATE
	NOTE BOOK	ALIGNED	CHECKED
	NO.	RT.	OF WAY
	CHECKED		

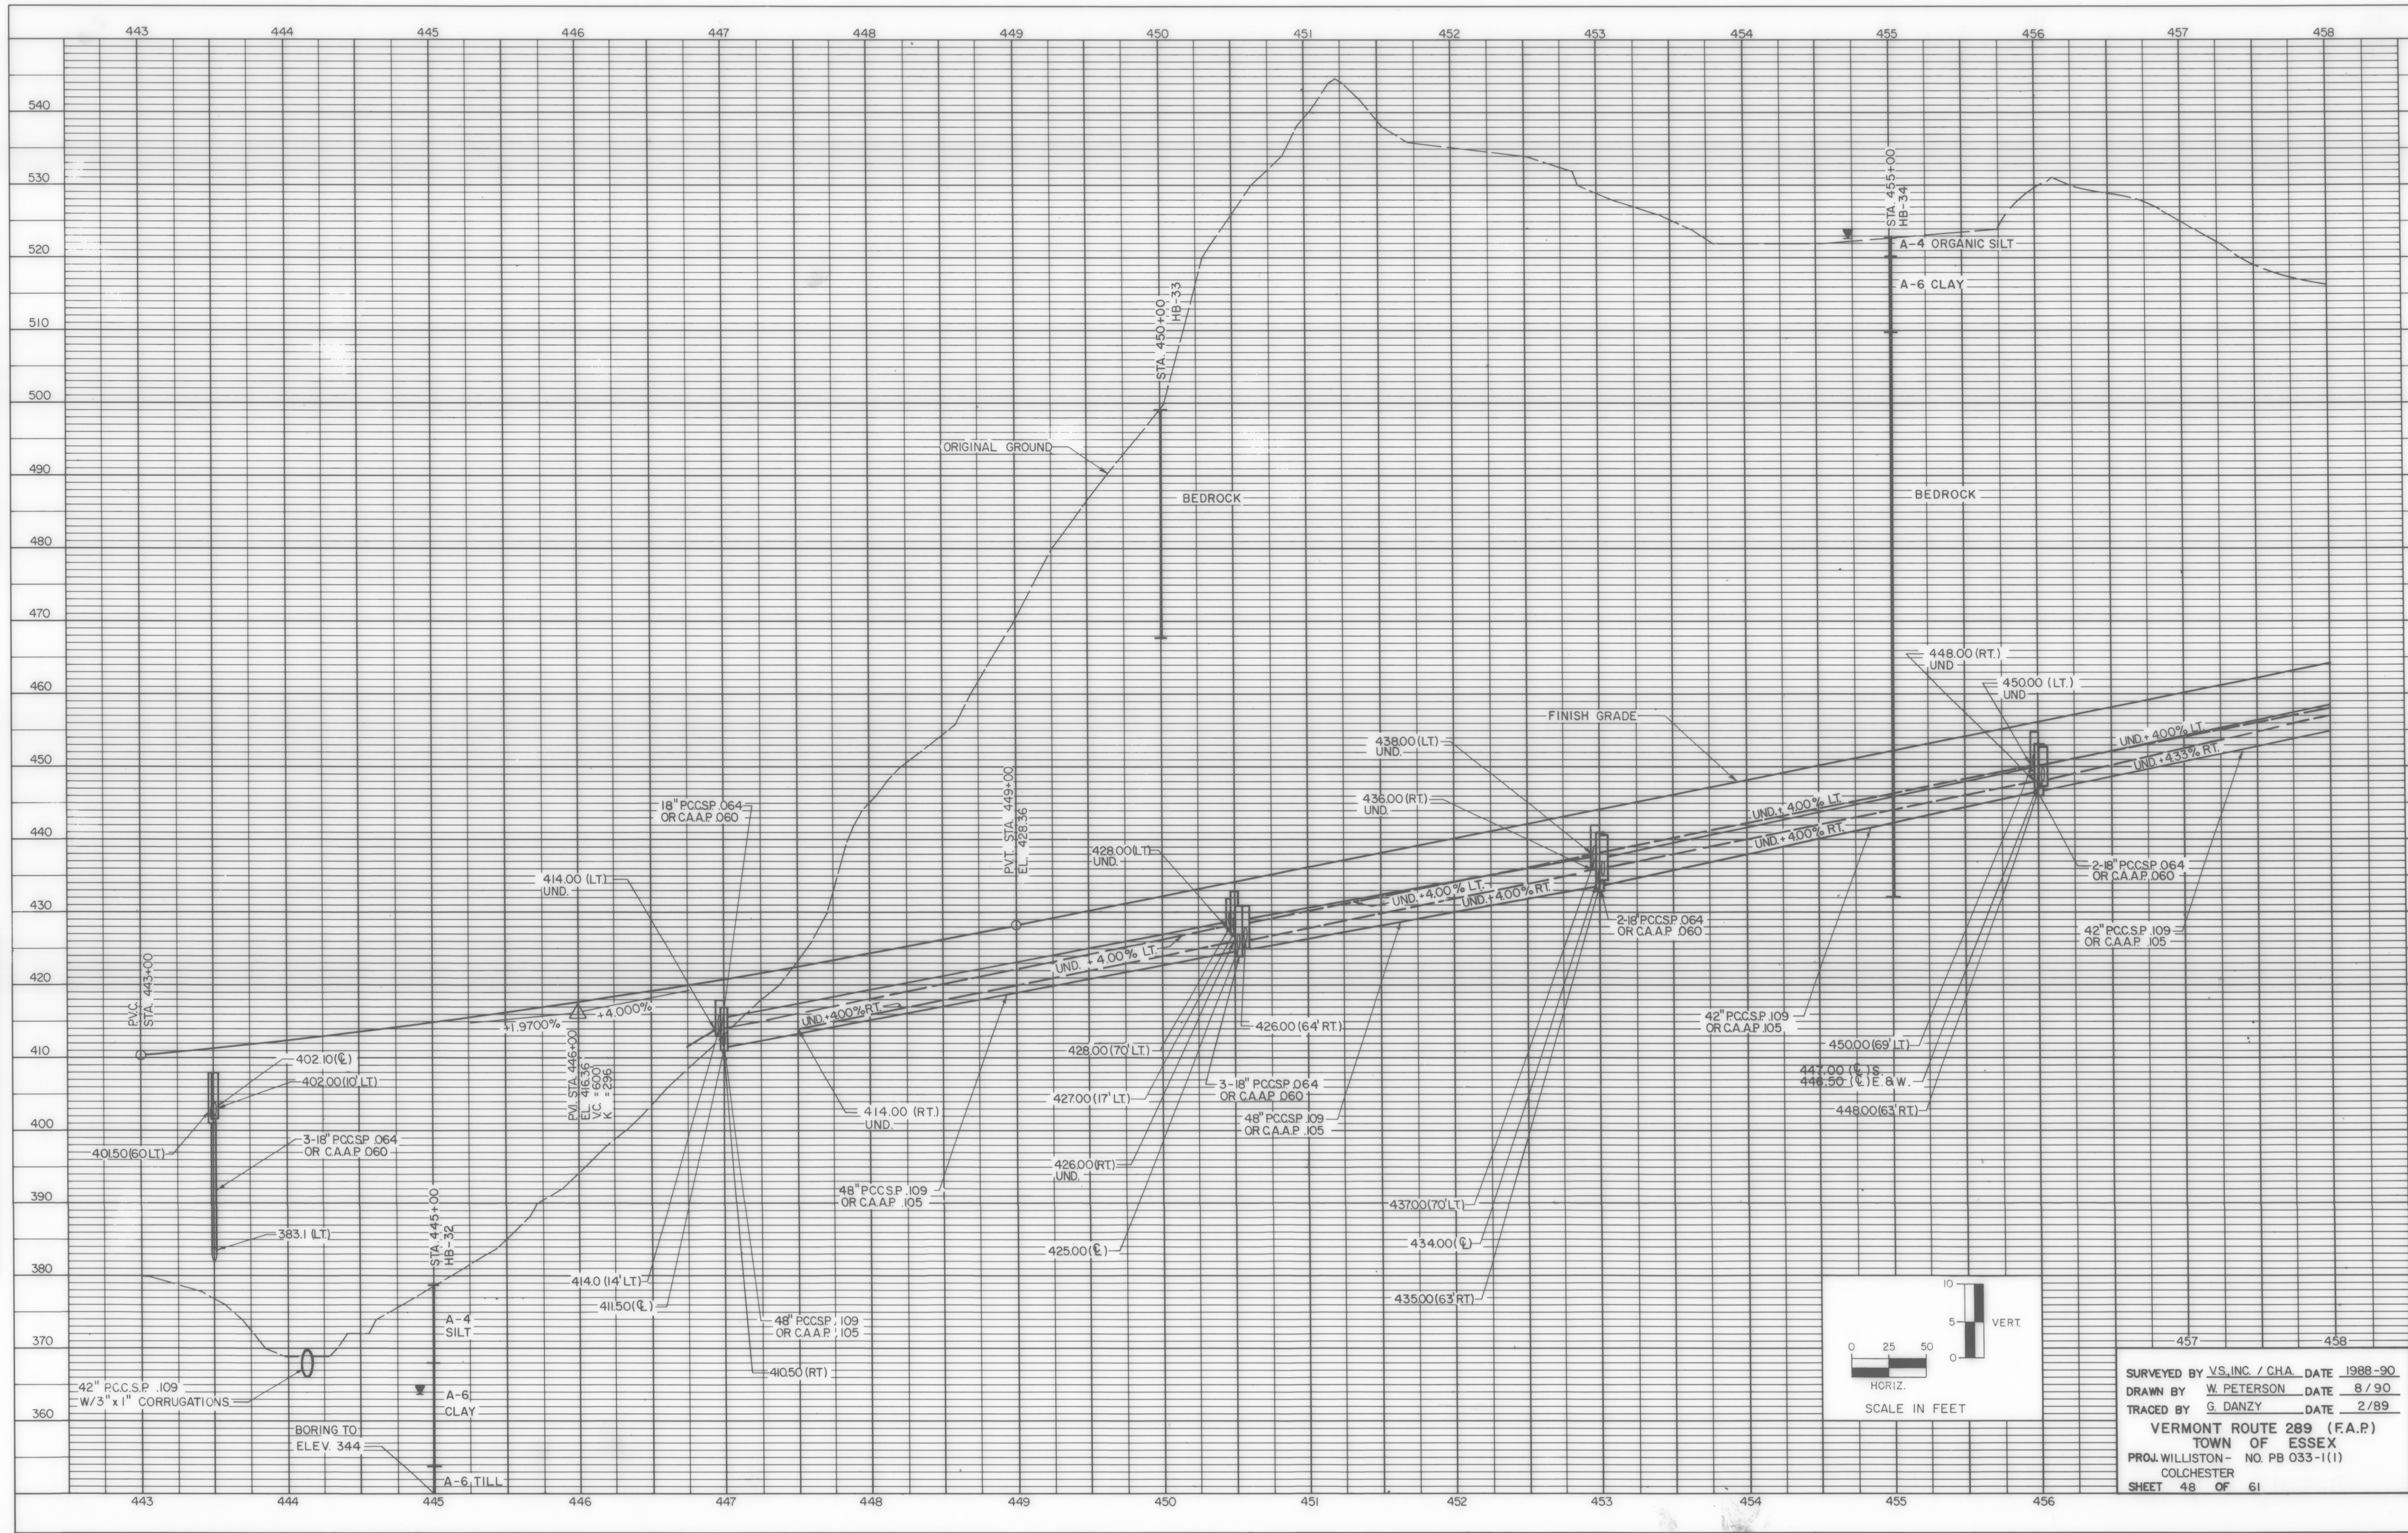

SURVEYED BY VS, INC. / CHA. DATE 1988-90
 DRAWN BY W. PETERSON DATE 8/90
 TRACED BY G. DANZY DATE 2/89
 VERMONT ROUTE 289 (F.A.P.)
 TOWN OF ESSEX
 PROJ. WILLISTON- NO. PB 033-1(1)
 COLCHESTER
 SHEET 48 OF 61