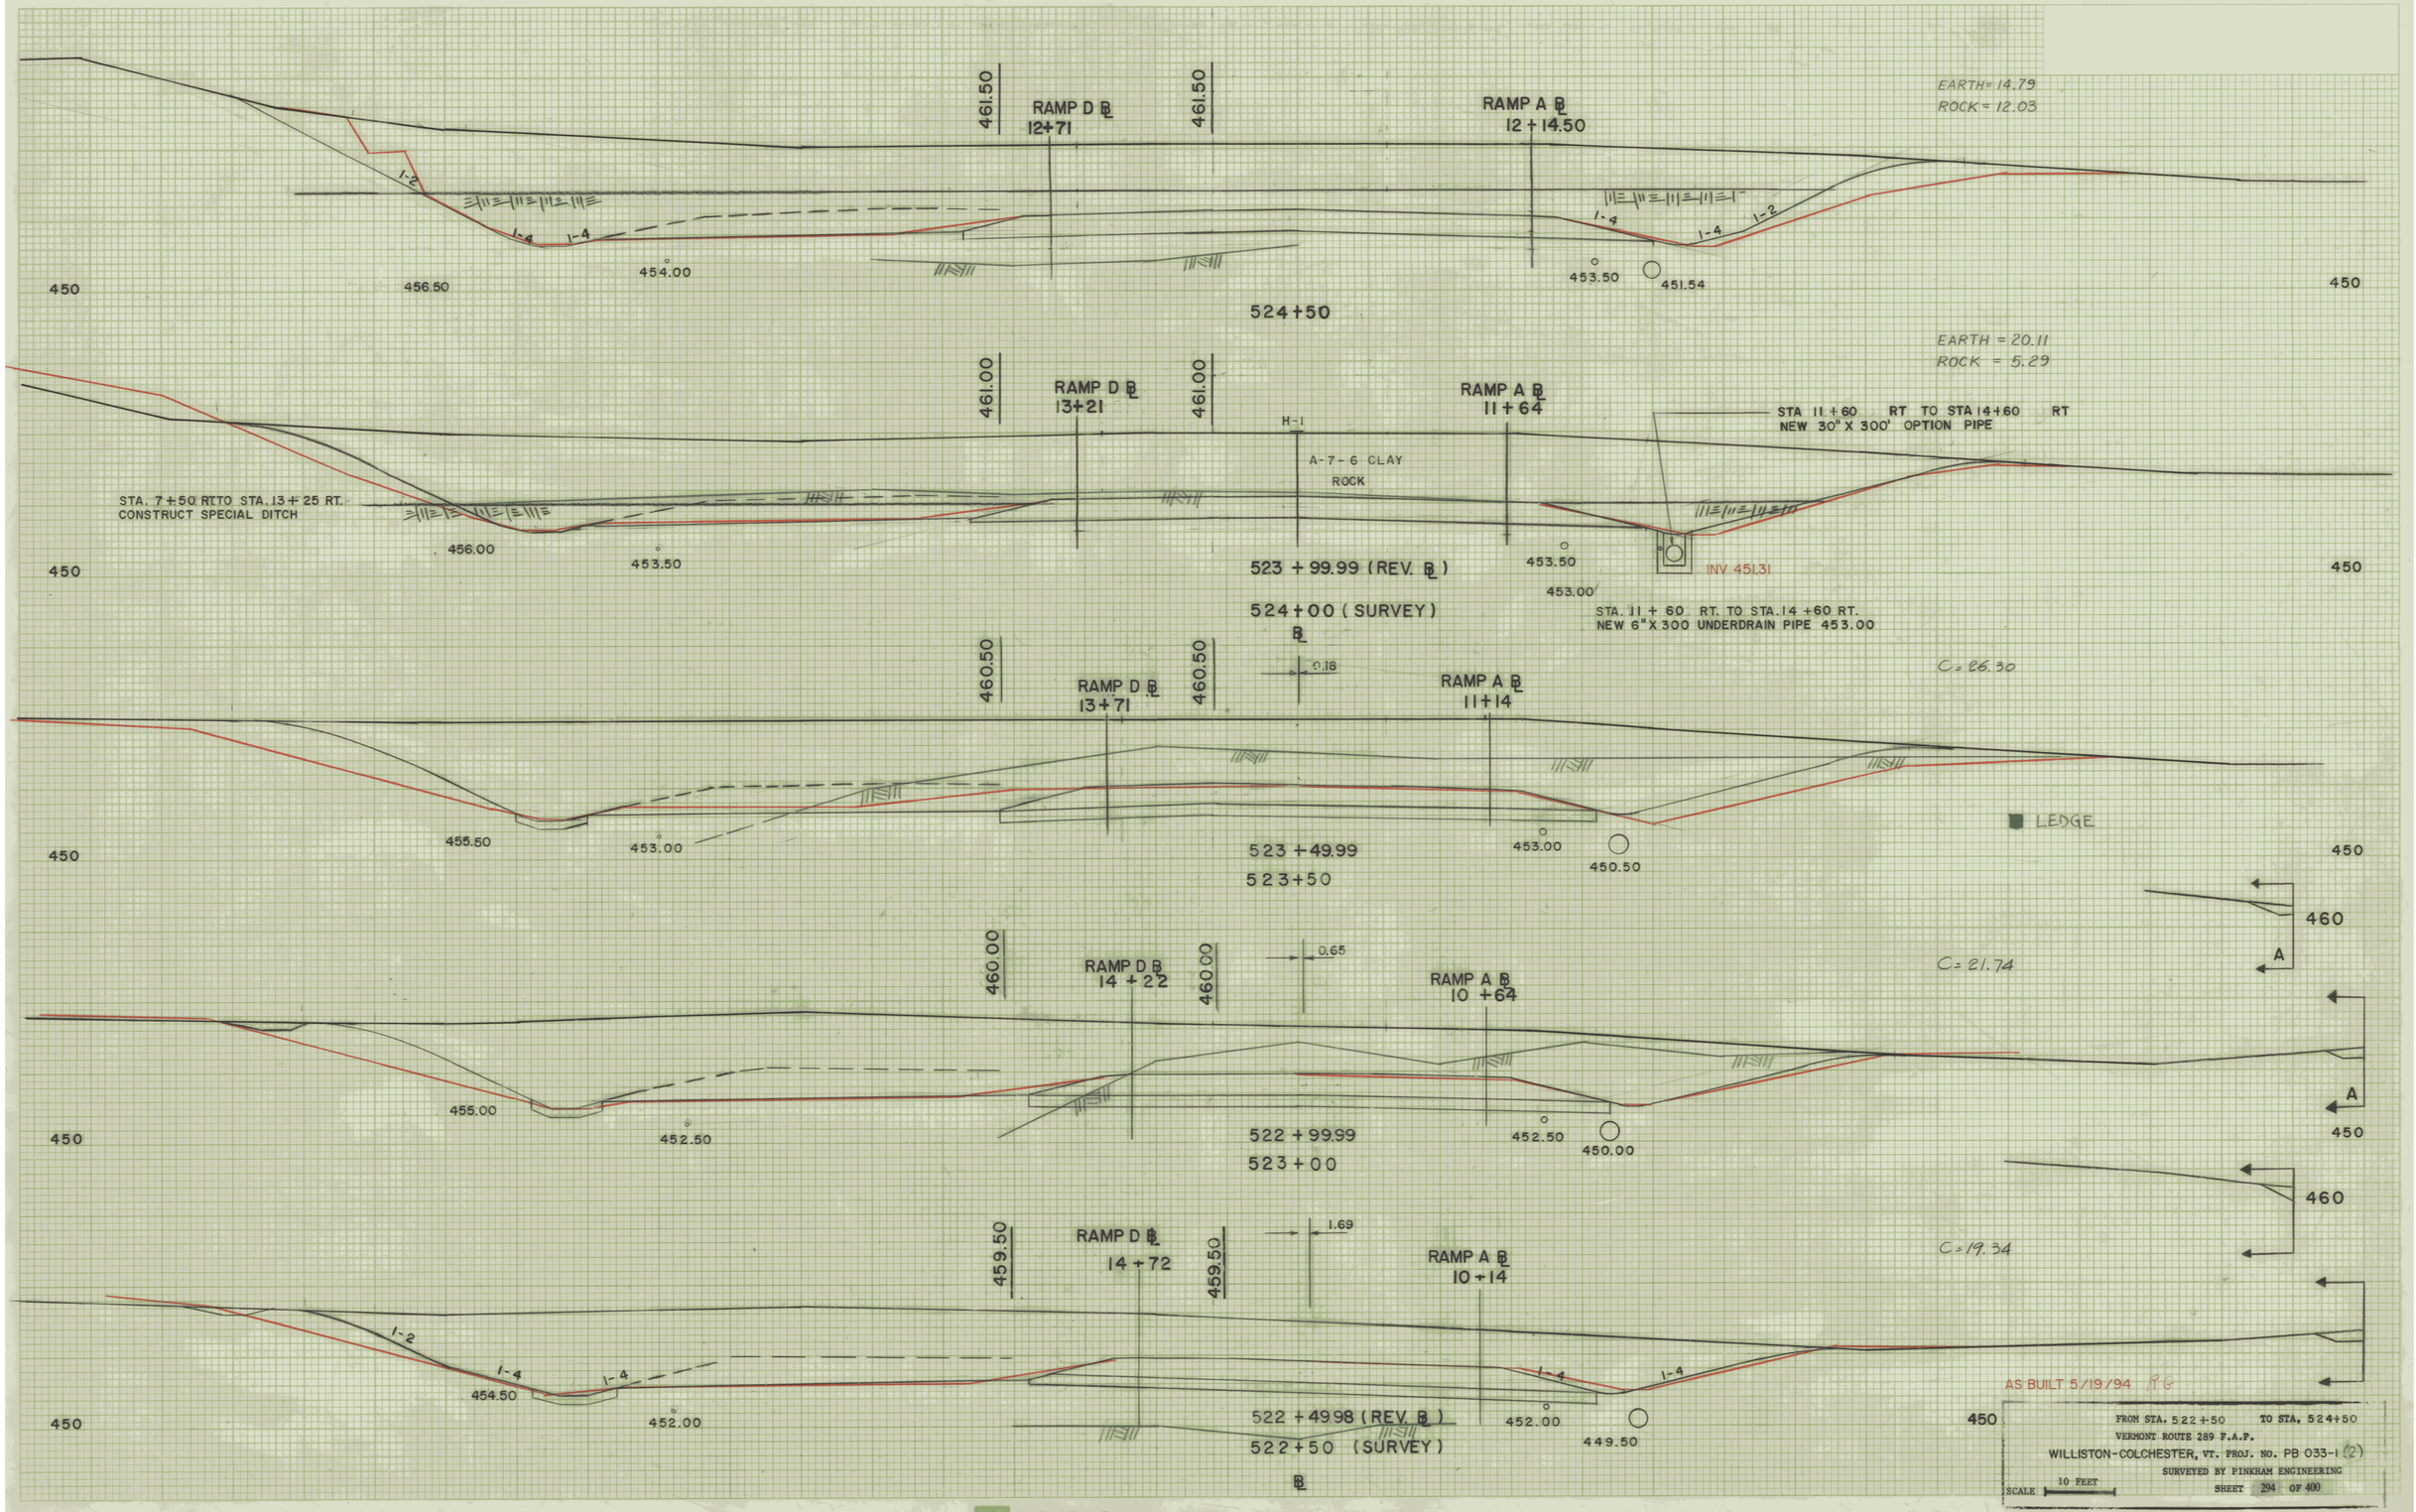
RAMP D ℄ 12+71
461.50
RAMP A ℄ 12+14.50
EARTH= 14.79
ROCK= 12.03
1-2
1-4
454.00
453.50
451.54
450
456.50
524+50
RAMP D ℄ 13+21
461.00
RAMP A ℄ 11+64
EARTH = 20.11
ROCK = 5.29
H-1
A-7-6 CLAY
ROCK
STA 11+60 RT TO STA 14+60 RT
NEW 30" X 300' OPTION PIPE
STA. 7+50 RT TO STA. 13+25 RT.
CONSTRUCT SPECIAL DITCH
456.00
453.50
523 + 99.99 (REV. ℄)
524+00 (SURVEY)
453.00
INV 451.31
STA. 11+60 RT. TO STA. 14+60 RT.
NEW 6" X 300 UNDERDRAIN PIPE 453.00
RAMP D ℄ 13+71
460.50
0.18
RAMP A ℄ 11+14
C= 26.30
455.50
453.00
523 + 49.99
523+50
450.50
LEDGE
460
A
RAMP D ℄ 14+22
460.00
0.65
RAMP A ℄ 10+64
C= 21.74
455.00
452.50
522 + 99.99
523+00
450.00
RAMP D ℄ 14+72
459.50
1.69
RAMP A ℄ 10+14
C= 19.34
454.50
452.00
522 + 49.98 (REV. ℄)
522+50 (SURVEY)
449.50
450
AS BUILT 5/19/94
FROM STA. 522+50 TO STA. 524+50
VERMONT ROUTE 289 F.A.P.
WILLISTON-COLCHESTER, VT. PROJ. NO. PB 033-1 (2)
SURVEYED BY PINKHAM ENGINEERING
SCALE 10 FEET
SHEET 294 OF 400
Keuffel & Esser Company
Made in U.S.A.
PLATE 3 CROSS SECTION 487072

185 of 270