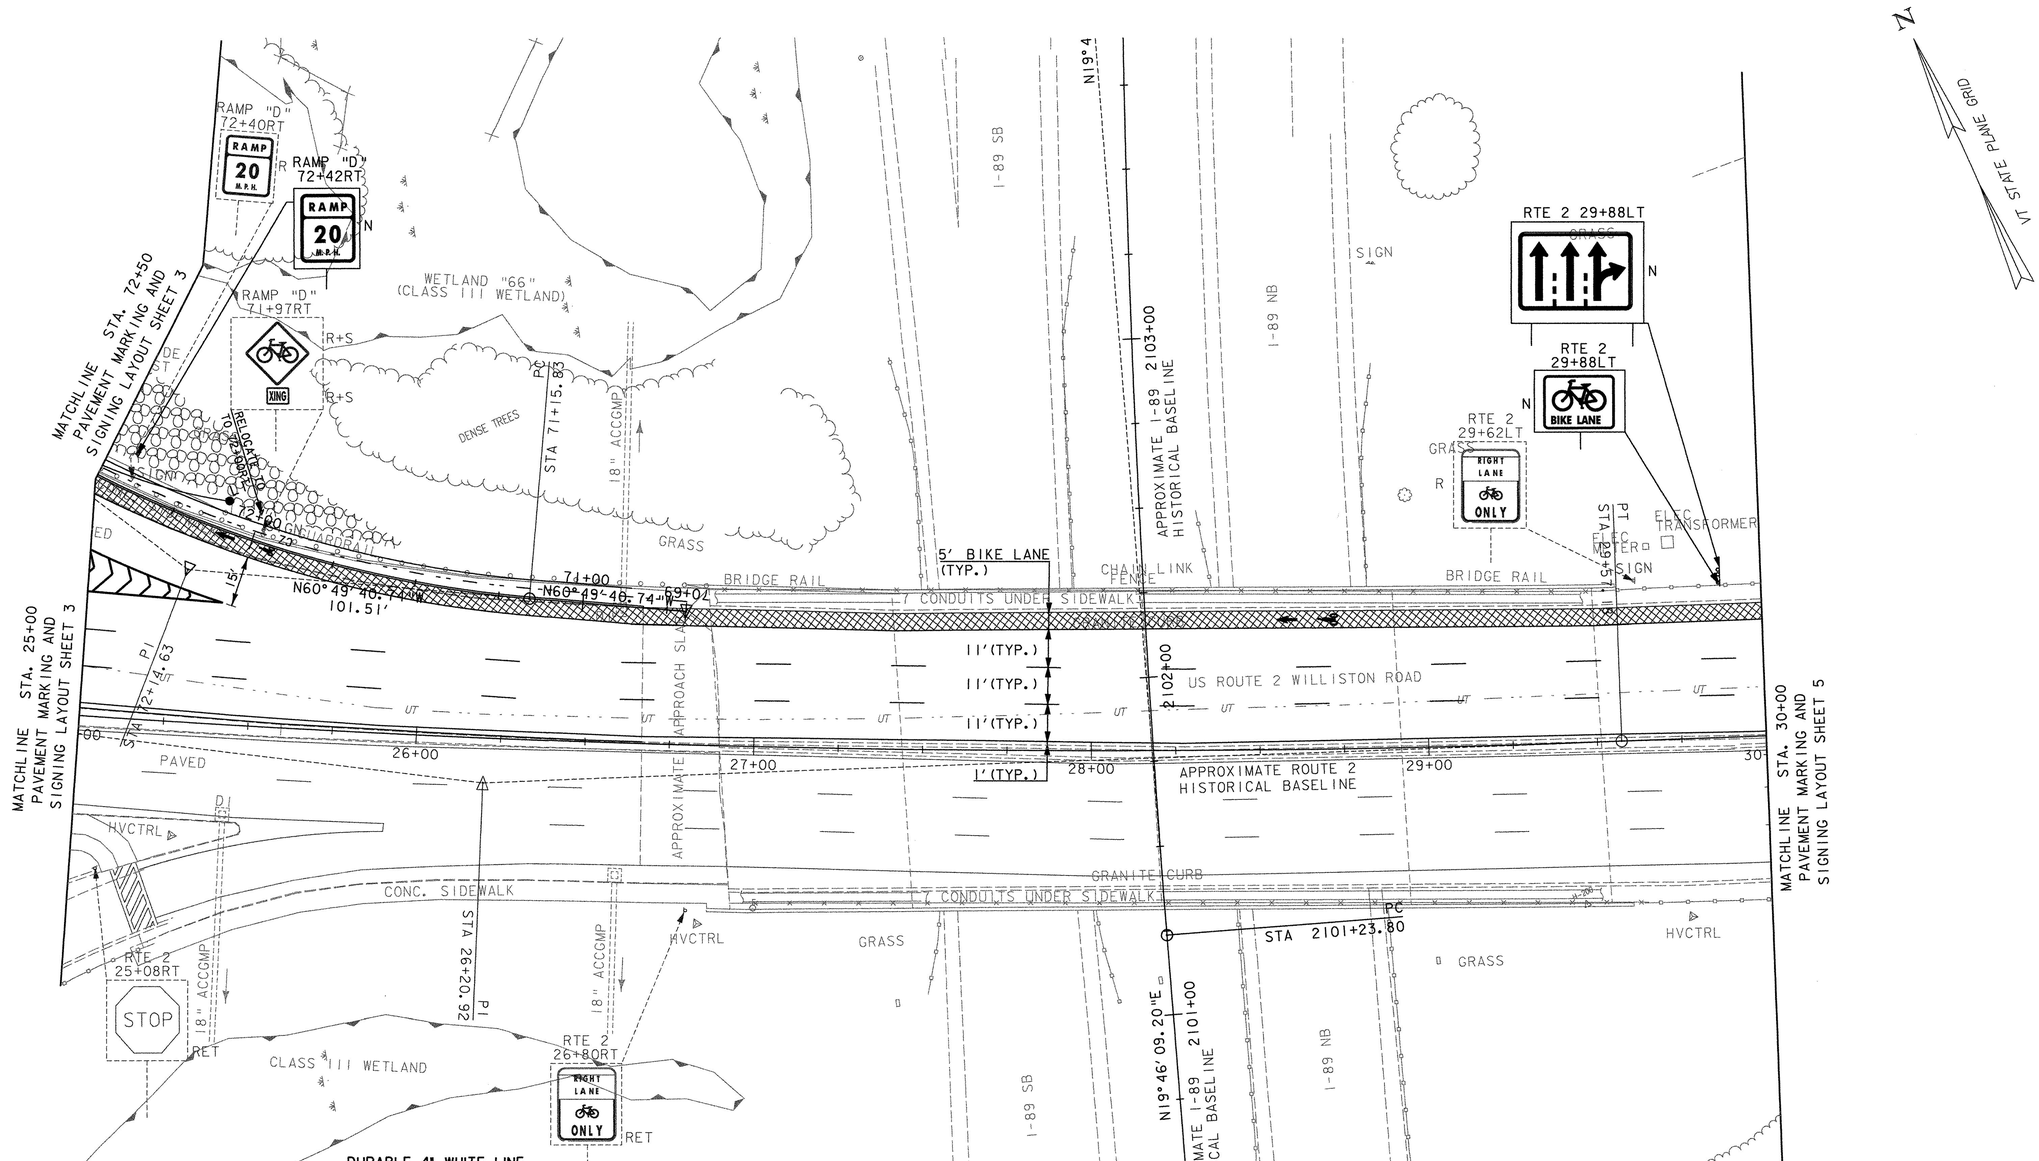

0 20 40
SCALE IN FEET

DATUM

VERTICAL	NAVD 88
HORIZONTAL	NAD 83 (1996)

SIGN LEGEND

- = EXISTING SIGN
- = NEW SIGN
- R = REMOVE EXISTING SIGN AND POST
- R+S = SALVAGE SIGN AND RELOCATE TO NOTED LOCATION WITH NEW SIGN POST. REMOVE AND DISPOSE EXISTING SIGN POST
- N = NEW
- RET = RETAIN AT EXISTING LOCATION
- B-B = BACK TO BACK

DURABLE 4" WHITE LINE
US ROUTE 2 25+00 ~ 30+00 LT, 13 X 10' = 130 LF
US ROUTE 2 25+00 ~ 30+00 LT, 13 X 10' = 130 LF
US ROUTE 2 25+00 ~ 25+40 LT, 40 LF
US ROUTE 2 26+81 ~ 30+00 LT, 333 LF
RAMP "D" 70+69 ~ 72+48, 183 LF
RAMP "D" 72+02 ~ 72+42, 40 LF

TEMPORARY 4" WHITE LINE
US ROUTE 2 25+00 ~ 26+75 LT, 5 X 10' = 50 LF
US ROUTE 2 25+00 ~ 26+75 LT, 5 X 10' = 50 LF
US ROUTE 2 25+00 ~ 25+40 LT, 40 LF
RAMP "D" 70+69 ~ 72+48, 183 LF
RAMP "D" 72+02 ~ 72+42, 40 LF

DURABLE 4" YELLOW LINE
US ROUTE 2 25+00 ~ 30+00, 500 LF

TEMPORARY 4" YELLOW LINE
US ROUTE 2 25+00 ~ 26+75, 175 LF

DURABLE 12" WHITE LINE
US ROUTE 2 CHEVRON MARKINGS 25+00 ~ 25+40, 81LF

TEMPORARY 12" WHITE LINE
US ROUTE 2 CHEVRON MARKINGS 25+00 ~ 25+40, 81LF

DURABLE LETTER OR SYMBOL
RAMP "D" 71+96, BIKE SYMBOL, 1EA
RAMP "D" 72+08, BIKE THRU ARROW, 1EA.
US ROUTE 2 27+76, BIKE THRU ARROW, 1EA
US ROUTE 2 27+88, BIKE SYMBOL, 1EA

TEMPORARY LETTER OR SYMBOL
RAMP "D" 71+96, BIKE SYMBOL, 1EA
RAMP "D" 72+08, BIKE THRU ARROW, 1EA.

PAINTED ISLAND
(MOD. - GREEN BIKE PATH)
RAMP "D" 72+50 RT ~ ROUTE 2 30+00 LT
(5' WIDTH) ~ 2450 SF

REMOVING SIGNS
2 EACH

ERECTING SALVAGED SIGNS
2 EACH

REMOVAL OF EXISTING PAVEMENT MARKINGS
US ROUTE 2 26+75 ~ 30+00 LT

PAVEMENT MARKING AND SIGNING LAYOUT SHEET 4

PROJECT NAME:	SOUTH BURLINGTON
PROJECT NUMBER:	IM 089-3(37)

FILE NAME: z03a178pmbdr.dgn	PLOT DATE: 5/22/2006
PROJECT LEADER: KEN UPMAL	DRAWN BY: V.KACOYANNAKIS
DESIGNED BY: V.KACOYANNAKIS	CHECKED BY: J.FORD
	SHEET 57 OF 99