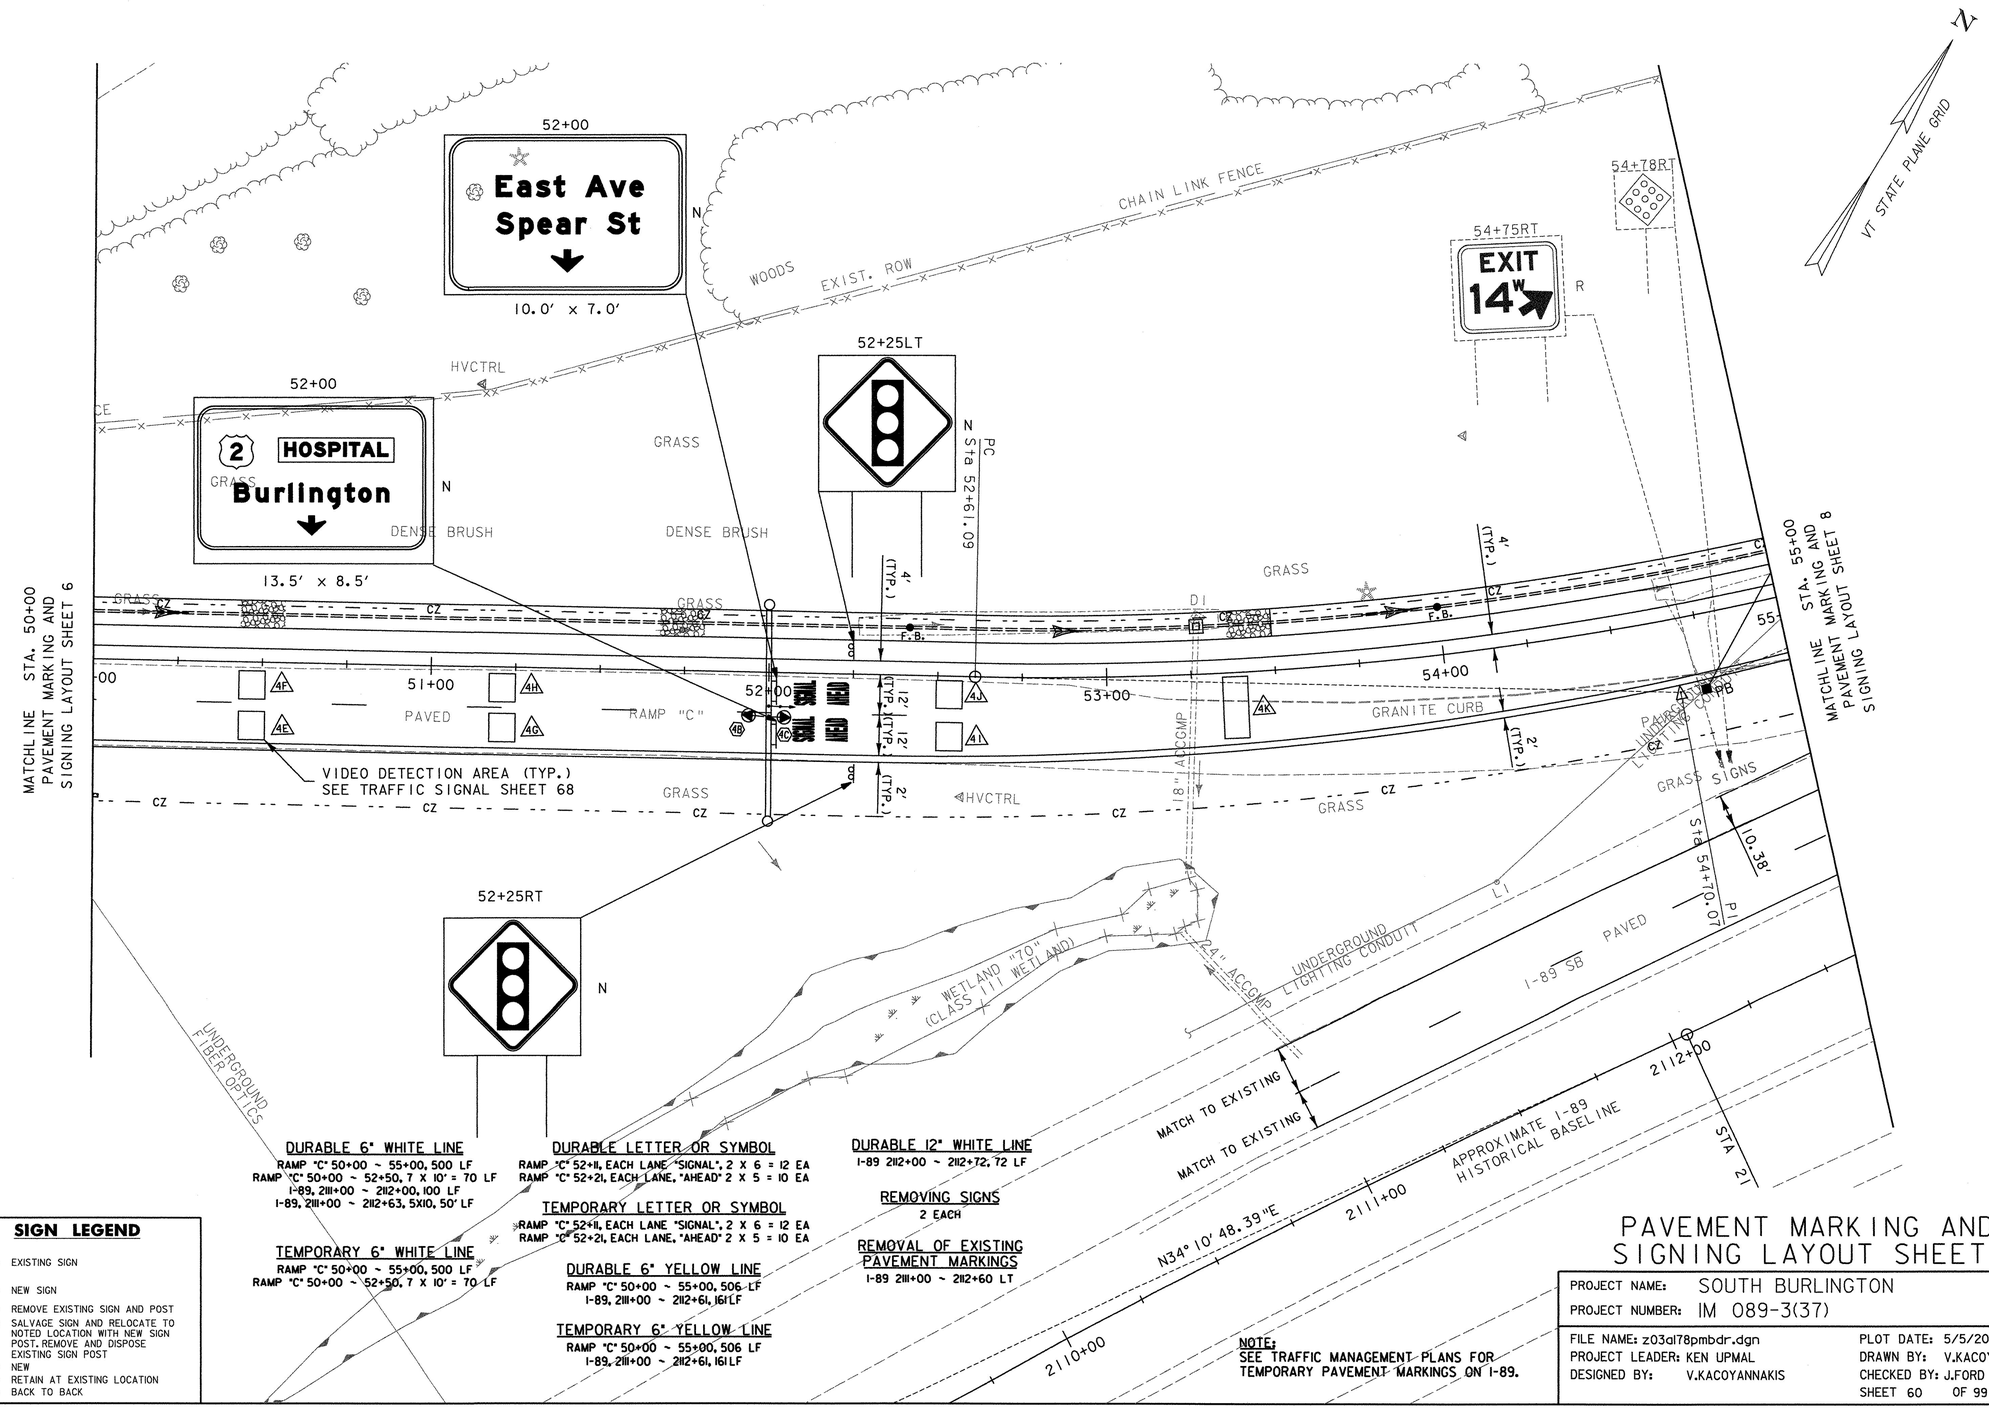

DURABLE 6" WHITE LINE
RAMP "C" 50+00 ~ 55+00, 500 LF
RAMP "C" 50+00 ~ 52+50, 7 X 10' = 70 LF
I-89, 2111+00 ~ 2112+00, 100 LF
I-89, 2111+00 ~ 2112+63, 5X10, 50' LF

TEMPORARY 6" WHITE LINE
RAMP "C" 50+00 ~ 55+00, 500 LF
RAMP "C" 50+00 ~ 52+50, 7 X 10' = 70 LF

DURABLE LETTER OR SYMBOL
RAMP "C" 52+11, EACH LANE "SIGNAL", 2 X 6 = 12 EA
RAMP "C" 52+21, EACH LANE, "AHEAD" 2 X 5 = 10 EA

TEMPORARY LETTER OR SYMBOL
RAMP "C" 52+11, EACH LANE "SIGNAL", 2 X 6 = 12 EA
RAMP "C" 52+21, EACH LANE, "AHEAD" 2 X 5 = 10 EA

DURABLE 6" YELLOW LINE
RAMP "C" 50+00 ~ 55+00, 506 LF
I-89, 2111+00 ~ 2112+61, 161LF

TEMPORARY 6" YELLOW LINE
RAMP "C" 50+00 ~ 55+00, 506 LF
I-89, 2111+00 ~ 2112+61, 161LF

DURABLE 12" WHITE LINE
I-89 2112+00 ~ 2112+72, 72 LF

REMOVING SIGNS
2 EACH

REMOVAL OF EXISTING PAVEMENT MARKINGS
I-89 2111+00 ~ 2112+60 LT

NOTE:
SEE TRAFFIC MANAGEMENT PLANS FOR TEMPORARY PAVEMENT MARKINGS ON I-89.

0 20 40
SCALE IN FEET

DATUM
VERTICAL NAVD 88
HORIZONTAL NAD 83 (1996)

SIGN LEGEND

[ ]	= EXISTING SIGN
[ ]	= NEW SIGN
R	= REMOVE EXISTING SIGN AND POST
R+S	= SALVAGE SIGN AND RELOCATE TO NOTED LOCATION WITH NEW SIGN POST. REMOVE AND DISPOSE EXISTING SIGN POST
N	= NEW
RET	= RETAIN AT EXISTING LOCATION
B-B	= BACK TO BACK

PAVEMENT MARKING AND SIGNING LAYOUT SHEET 7

PROJECT NAME: SOUTH BURLINGTON
PROJECT NUMBER: IM 089-3(37)

FILE NAME: z03al78pmbdr.dgn
PROJECT LEADER: KEN UPMAL
DESIGNED BY: V.KACOYANNAKIS
PLOT DATE: 5/5/2006
DRAWN BY: V.KACOYANNAKIS
CHECKED BY: J.FORD
SHEET 60 OF 99