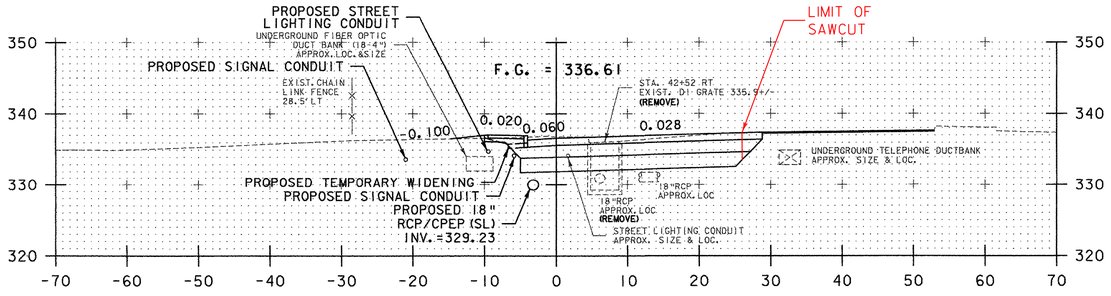

42+50

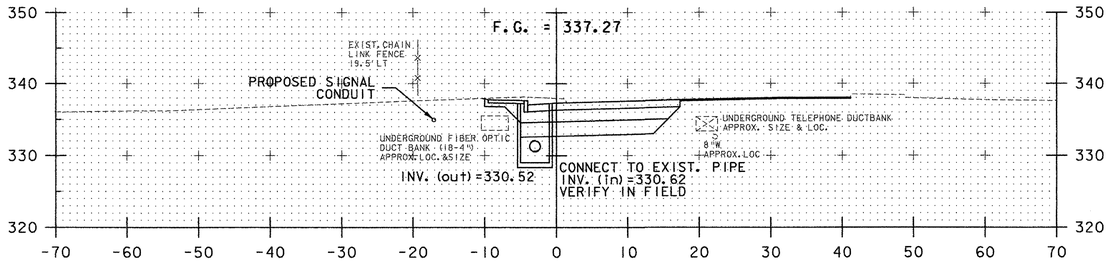

42+14 DI

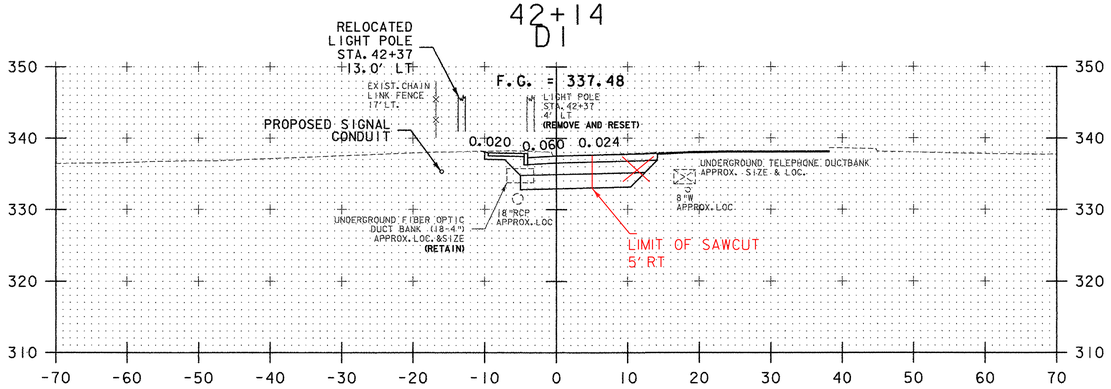

42+00

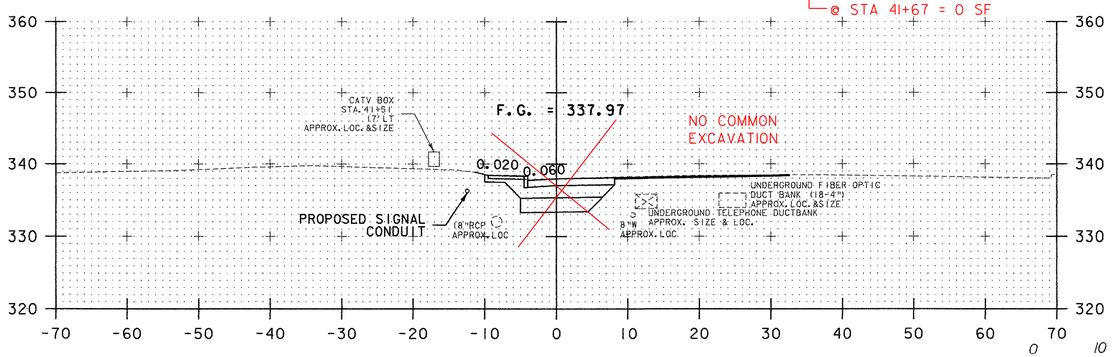

41+50

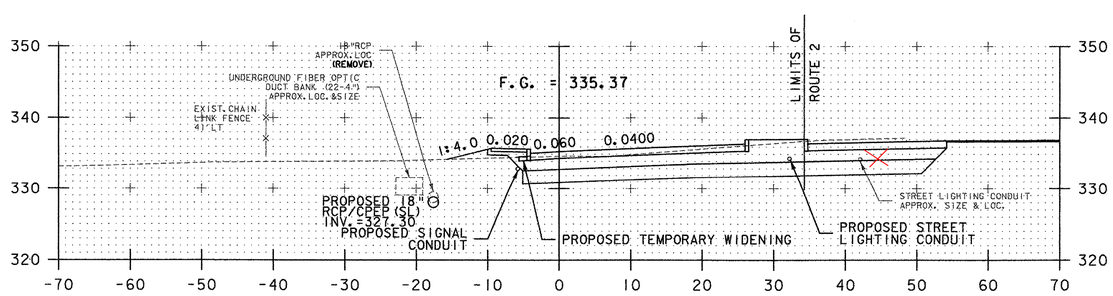

43+00

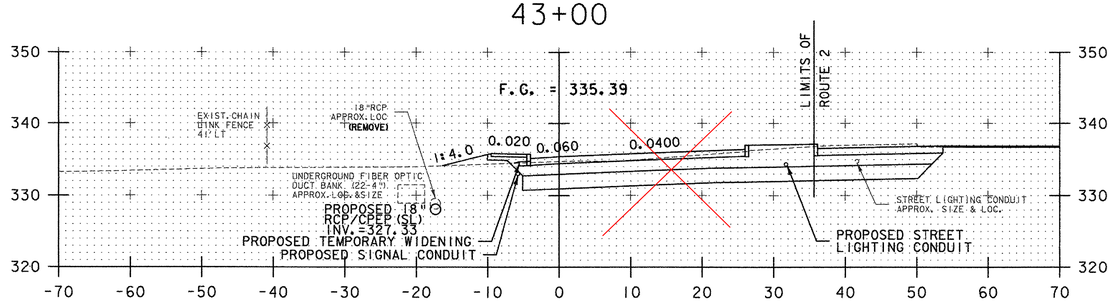

42+~~99~~.24 PCC

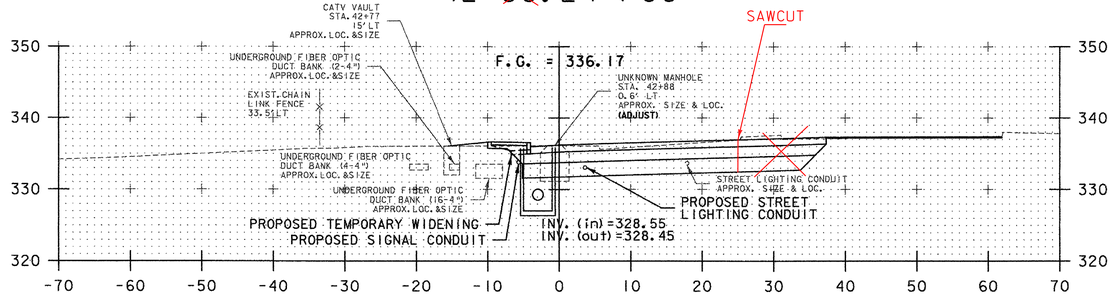

67.00
42+~~69~~.64 DI

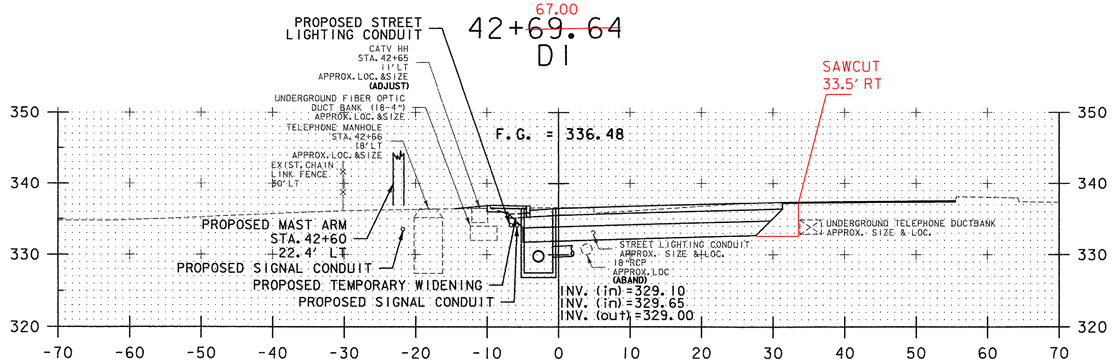

63.00
42+~~56~~.20 MH

RAMP "C" SECTIONS SHEET 2

0 10 20
SCALE IN FEET

DATUM

VERTICAL NAVD 88
HORIZONTAL NAD 83 (1996)

NOTE: REFER TO RAMP "C" TRAFFIC MANAGEMENT PLANS FOR TEMPORARY WIDENING WORK.

STA. 41+50 TO STA. 43+00

PROJECT NAME: SOUTH BURLINGTON
PROJECT NUMBER: IM 089-3(37)

FILE NAME: z03al78xs.dgn
PROJECT LEADER: KEN UPMAL
DESIGNED BY: E. ATKINS
PLOT DATE: 5/5/2006
DRAWN BY: E. ATKINS
CHECKED BY: K. ISHIKURA
SHEET 83 OF 99