INDEX OF SHEETS

SHEET NO. 1		TITLE PAGE
2		ALIGNMENT SHEET
3-4		TYPICAL CROSS-SECTION OF IMPROVEMENT (3" BIT. CONC. PAVT. ITEM 351-B MOD.)
5		TYPICAL CROSS-SECTION - ONE WAY RAMP
6		TYPICAL CROSS-SECTION - TWO WAY RAMP, SPEED CHANGE LANE
7		QUANTITY SHEET (ITEMS)
8		R.O.W. DETAIL SHEET
9-10		QUANTITY SHEETS (DRAINAGE)
11-16		EARTHWORK SHEET
17		BLANK
18-35		PLAN AND PROFILE SHEETS
36-40		RAMP TERMINAL DETAILS
41		BLANK
42-44		BLANK
45	A-61	SOLID ROCK EXCAVATION
46	B-1	BANKING TABLES
47	B-5	SLOPE ROUNDING
48	B-6	MUCK EXCAVATION
49		BLANK
50	D-2	HEADWALLS AND UNDERDRAIN
51	D-3	TREATED GUTTERS
52	D-4	MISC. METAL PIPE DETAILS
53	D-8	DROP INLETS
54	D-10	DROP INLET TOPS
55	D-11	TYPE A GRATE
56	D-13	CONC. CATCH BASIN
57		BLANK
58	D-16	PRECAST CURB D.I. TYPE B GRATE
59		BLANK
60	E-31	CONSTRUCTION IDENTIFICATION SIGNS
61	F-1	PROPERTY LINE FENCE
62	G-3a	DEAD END ANCHORAGE AT BRIDGE APPROACH
63	J-1	BOUNDARY MARKERS
64	J-4	FIELD OFFICE
65		DETAILS OF 84" CGMPP AT N.B. STA 3717+65
66-67		BLANK
68-90		DETAILS OF I 91 BRIDGE OVER RAMP C AT STA 3702+54.90, BR. 100-122
91		SCB-38-62
92-94		SCWPG-30-62 (SHEET 1, 2, 4)
95-119		DETAILS OF I 91 BRIDGE OVER I 89 AT STA 3709+70.57, BR. 200-224
120		SCB-42-62
121-132		DETAILS RAMP C BRIDGE OVER I 89 AT RAMP C 27+07.15, BR. 300-311
133		BLANK
134-139		SCB-D1, D2, D4, D6, D8, D9, -62
140-141		SB-59-62
142		BLANK
143-146		BLANK
147-179		CROSS SECTIONS, INTERSTATE
180-260		CROSS SECTIONS, RAMPS
261-262		BLANK
263		CROSS SECTIONS - CHANNEL LINE RAMP A 25+17.19
264-265		BLANK

7 Final Earth Work Sheets
Structural Steel
Extended Weights
22 Drainage Sheets

9 Sheets Revised (Section)
21 Drainage Sheets
28 Prints of Bridge Steel

STATE OF VERMONT
DEPARTMENT OF HIGHWAYS

PROPOSED IMPROVEMENT

INTERSTATE PROJECT

TOWN OF HARTFORD
COUNTY OF WINDSOR
INTERSTATE ROUTE 91

BELLOWS FALLS-WHITE RIVER JCT. ROAD

PROJECT I 91-1 (25)

BEGINNING AT A POINT 1.707 MILES NORTHERLY OF THE HARTLAND-HARTFORD TOWN LINE AND EXTENDING NORTHERLY 0.793 MILE

LENGTH OF ROADWAY 3,746.06 FEET = 0.709 MILE
LENGTH OF BRIDGE 441.90 FEET = 0.084 MILE
LENGTH OF PROJECT 4,187.96 FEET = 0.793 MILE

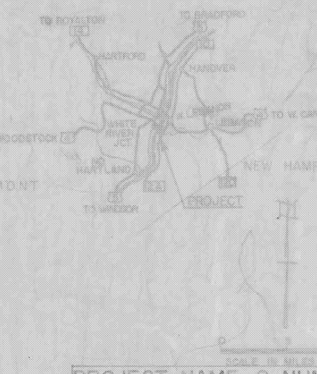

PROJECT NAME & NUMBER	TYPE	STAGE
HARTFORD I 91-1(25)	GRADING & DRAINAGE	I

RECORD PLANS
MATERIALS
SUBBASE OF SAND — LUCE PIT — HARTFORD, VT.
SUBBASE OF CRUSHED ROCK-TWIN STATE SAND & GRAVEL CO., INC. — WEST LEBANON, N.H.
CONCRETE CLASS AA & B — MILLER TRANSIT MIX CONC.-W.LEBANON, N.H.
STRUCTURAL STEEL & STEEL PILING — WEST END IRON WORKS — - CAMBRIDGE, MASS.
REINFORCING STEEL-REPUBLIC STEEL CORP — BUFFALO, N.Y.
ASPHALTIC ASBESTOS COATING-CONSTRUCTORS INC.-LEXINGTON, MASS.
GRANITE BRIDGE CURB-FLETCHER GRANITE CO.-CHELMSFORD, MASS.
BRIDGE RAILING — WARD WELLER CO. INC.-NEEDHAM HEIGHTS, MASS.
JOINT SEALER (PREFORMED)-TOCH BROTHERS-PATERSON, N.J.
BRIDGE PAINT-AMSTERDAM COLOR WORKS-NEW YORK, N.Y.
REINF. CONC. PIPE, PREC. R.C. CURB DROP INLETS, BOUNDARY MARKERS & PROPERTY LINE FENCE W/STEEL POSTS — S.T. GRISWOLD & CO., INC. — ESSEX JUNCTION, VT.
METAL CULVERT PIPE-NEW ENGLAND METAL CULVERT CO.-WHITE RIVER JUNCTION, VT.
CAST IRON GRATES-E.L. LEBARON FOUNDRY CO.-BROCKTON, MASS.
CONTRACTOR — LANDERS & GRIFFIN INC., MORRISON KNUDSEN CO., INC. PORTSMOUTH, N.H.
CHIEF RESIDENT ENGINEER - ROY F. NICHOLSON.
RESIDENT ENGINEERS - A.B. DELANO, G. ABAIR & A.J. DAVIS.
INSPECTORS - S. MURRAY, A. NEWTON, D. SARGENT, J. WILMOTT & H. DAVIS.
RECORD PLANS - GEORGE ABAIR.

CONTRACT — DATED - SEPTEMBER 9, 1964.
STARTED - SEPTEMBER 14, 1964.
COMPLETED & ACCEPTED - FEBRUARY 9, 1966.

HARTFORD-SHARON
IM MEMB(15)

SHEET 23 OF 47
BRIDGE 42N&S
FOR REFERENCE ONLY

NOTE: ANY FURTHER INFORMATION CONCERNING FINAL QUANTITIES AMOUNTS OR OTHER DETAILS RELATIVE TO THIS PROJECT MAY BE FOUND IN EITHER THE FIELD BOOKS OR THE RESIDENT'S FILE.

U.S. 5 AND ALL TOWN ROADS ARE NOT IN THE CONSTRUCTION AREA EXCEPT AS INDICATED ABOVE

HARTFORD I 91-1(25) STAGE I
CONTRACTOR-LANDERS & GRIFFIN & MORRISON KNUDSEN CO., INC.
PORTSMOUTH, N.H.
CONSTRUCTION COMPLETED-FEBRUARY 9, 1966.
RECORD PLANS — GEORGE ABAIR.

RD
25) Stage I. LENGTH 0.793 MI.
DRAINAGE
SEE HARTFORD I 91-1(13) FOR STAGE 2.
CONTRACTOR LANDERS & GRIFFIN INC. MORRISON KNUDSEN CO., INC.
PORTSMOUTH, N.H. YEAR 1964-66.
LOCATION Beginning at a point 1.707 miles northerly of the Hartland-Hartford Town Line and extending northerly 0.793 mile.

91-1 (25)
265