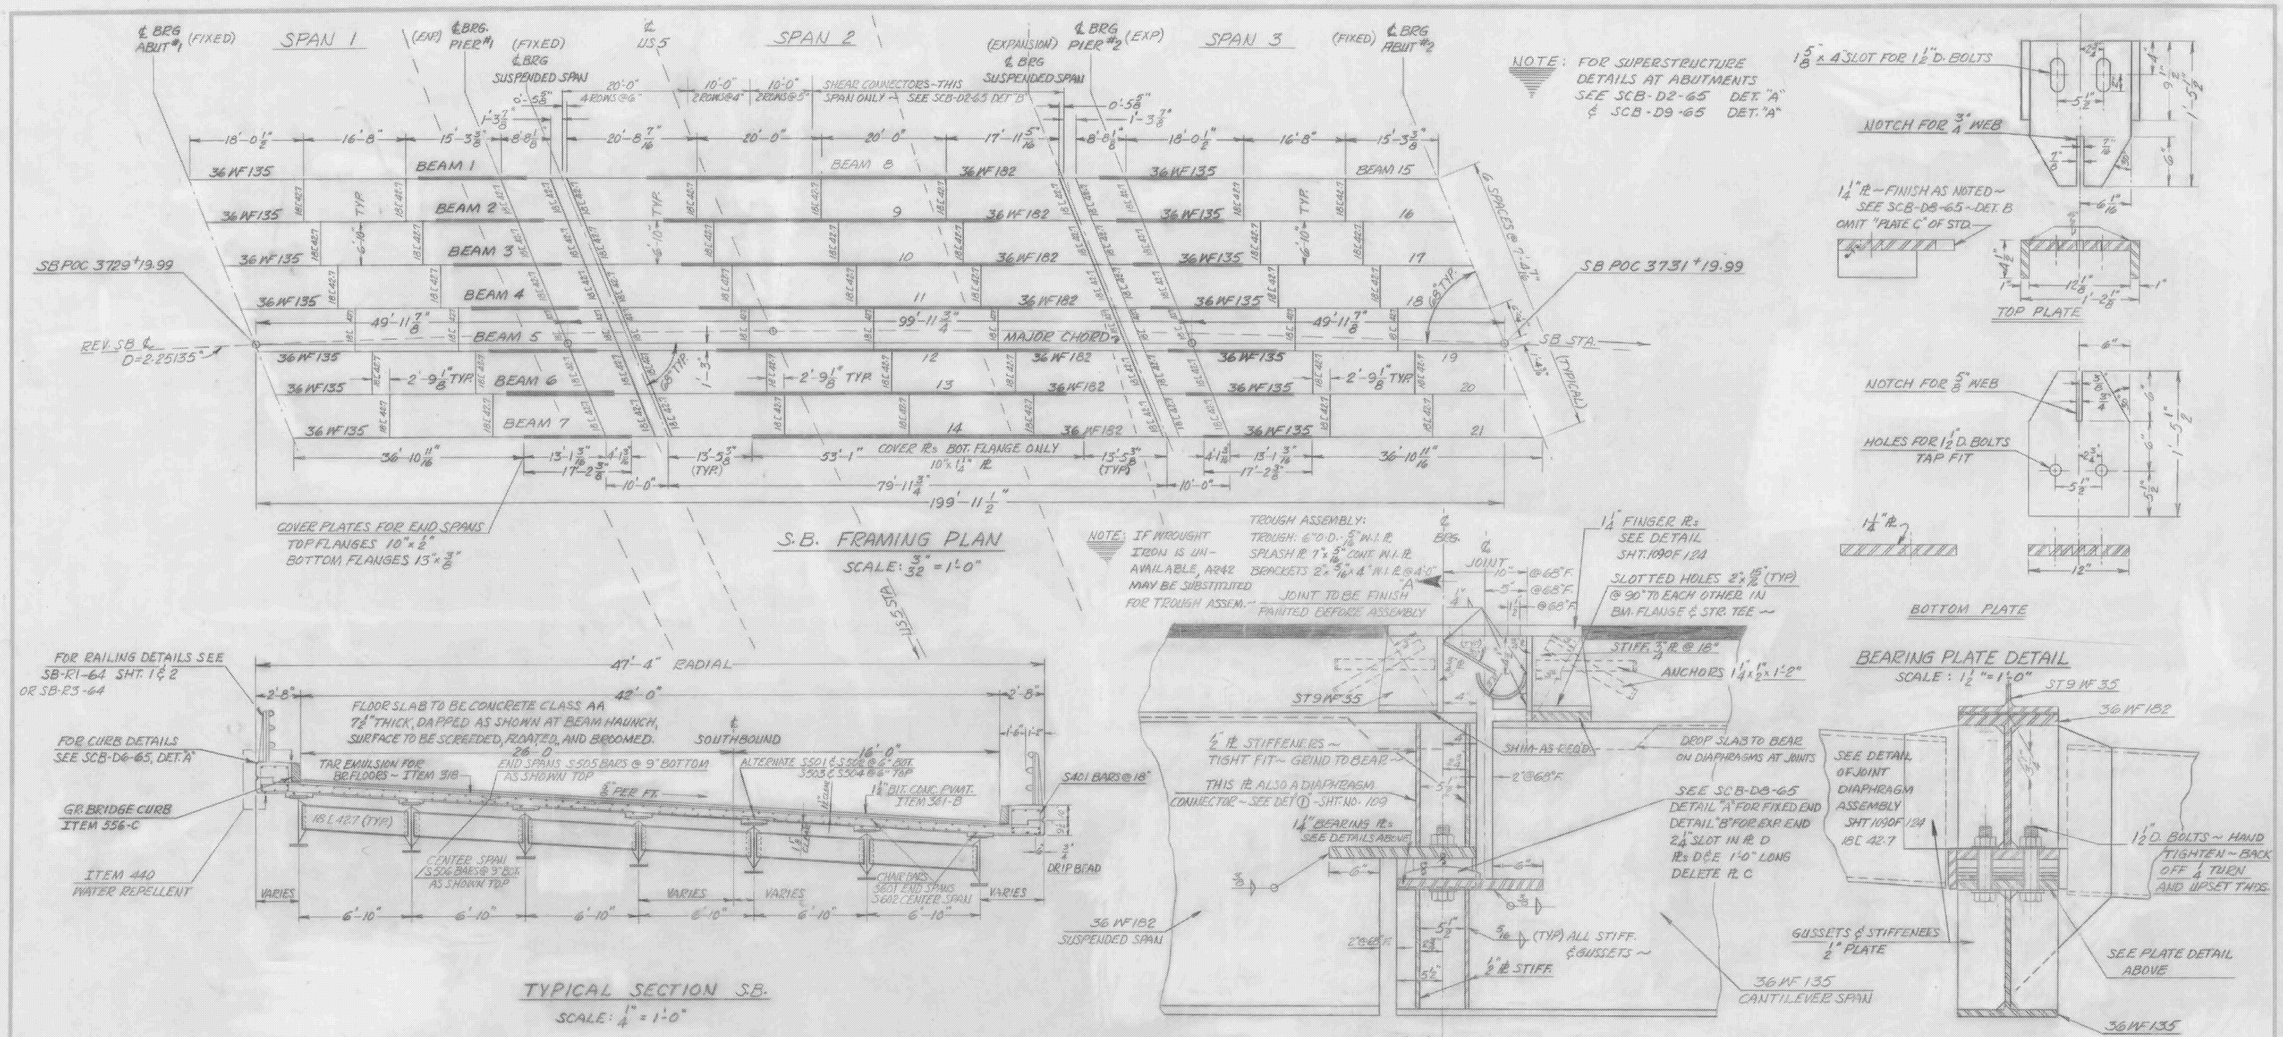

ITEM NO.	ITEM	UNIT	NET		TOTAL	FINAL
	CHAN. EXCAV. OF EARTH	C.Y.				
	CHAN. EXCAV. OF ROCK	C.Y.				
	UNCLASS. CHAN. EXCAV.	C.Y.				
	STRUCT. EXCAV.	C.Y.				
	CONC. CLASS AA (MOD.)	C.Y.				
	CONC. CLASS B (MOD.)	C.Y.				
	REINF. STEEL	LBS.				
	ASPHALTIC-ASB. COATING	S.Y.				
	TREATED TIMBER PILING	L.F.				
	SPLICES FOR STEEL PILING	EA.				
	STEEL PILING	L.F.				
	UNTREATED TIMBER PILING	L.F.				

STATE OF VERMONT
DEPARTMENT OF HIGHWAYS

TOWN OF HARTFORD URBAN - SOUTH
ROAD NO. I 91 BRIDGE NO.
S.B. FRAMING PLAN - TYPICAL SECTION
SOUTHBOUND I 91 OVER US 5
SCALE AS SHOWN
SURVEYED BY
DRAWN BY RHW CHECKED BY RWD SNA
PROJECT NO. I 91-2 (2) (22)
SHEET 94 OF 219 118 of 175

BR 106 OF 124

HARTFORD-SHARON
IM MEMB(15)

SHEET 32 OF 47
BRIDGE 43S
FOR REFERENCE ONLY