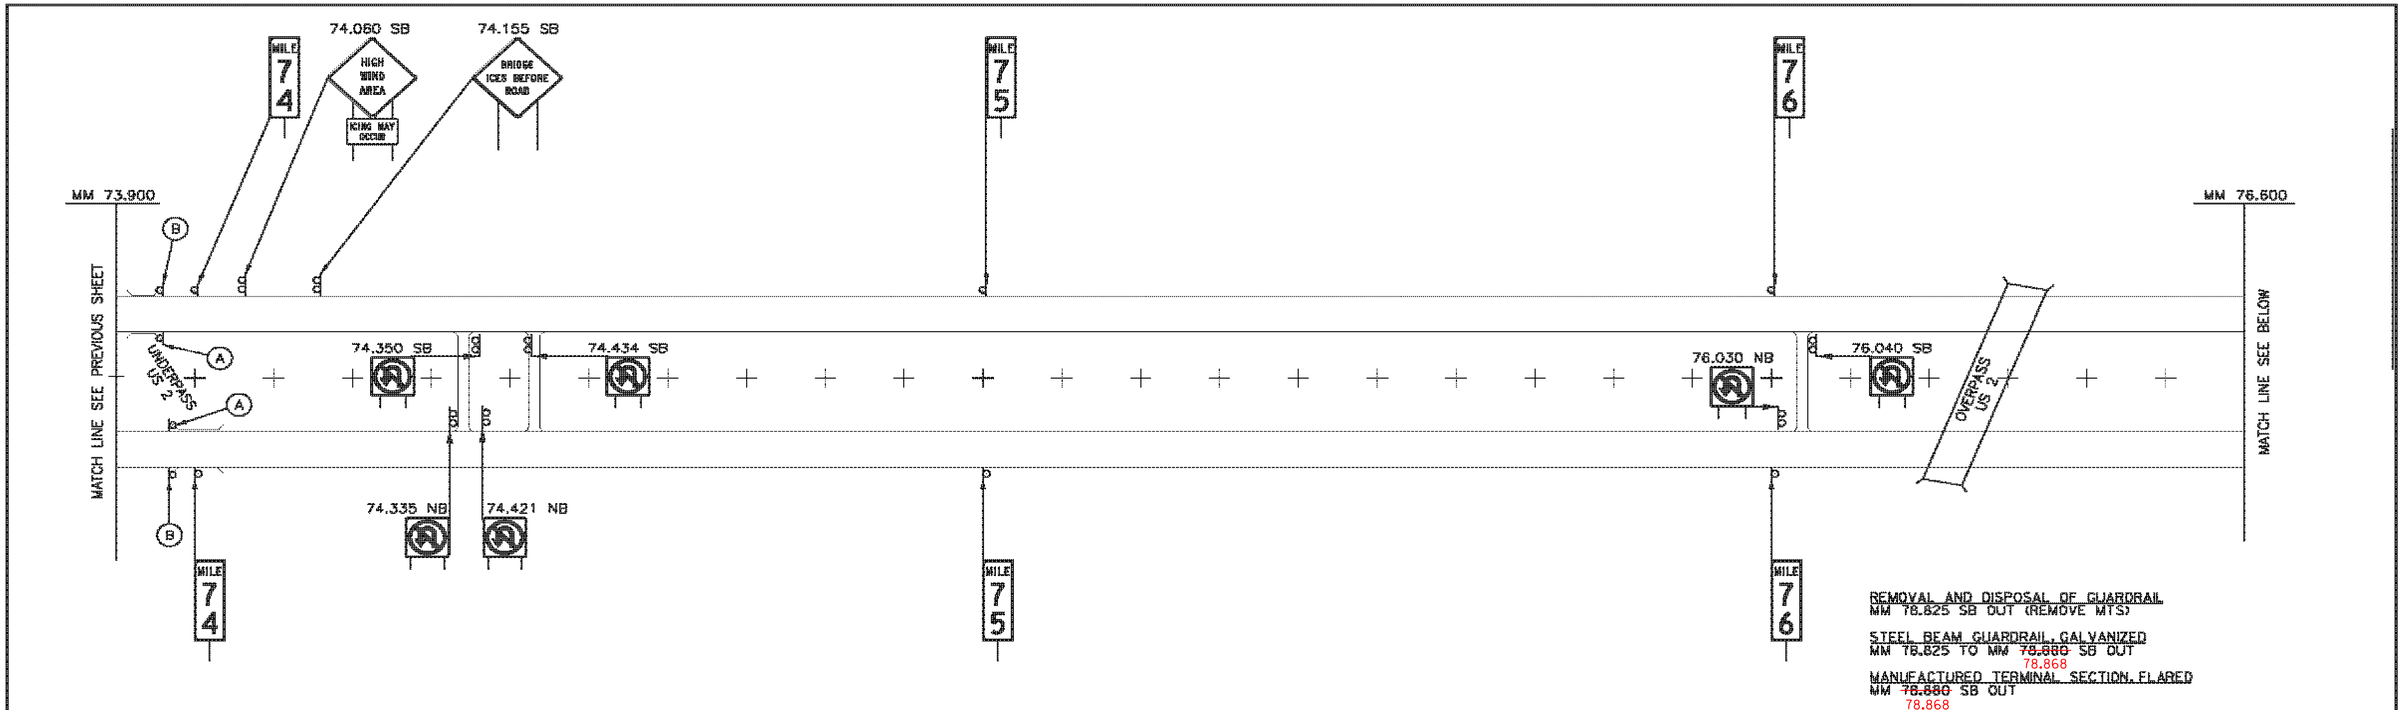

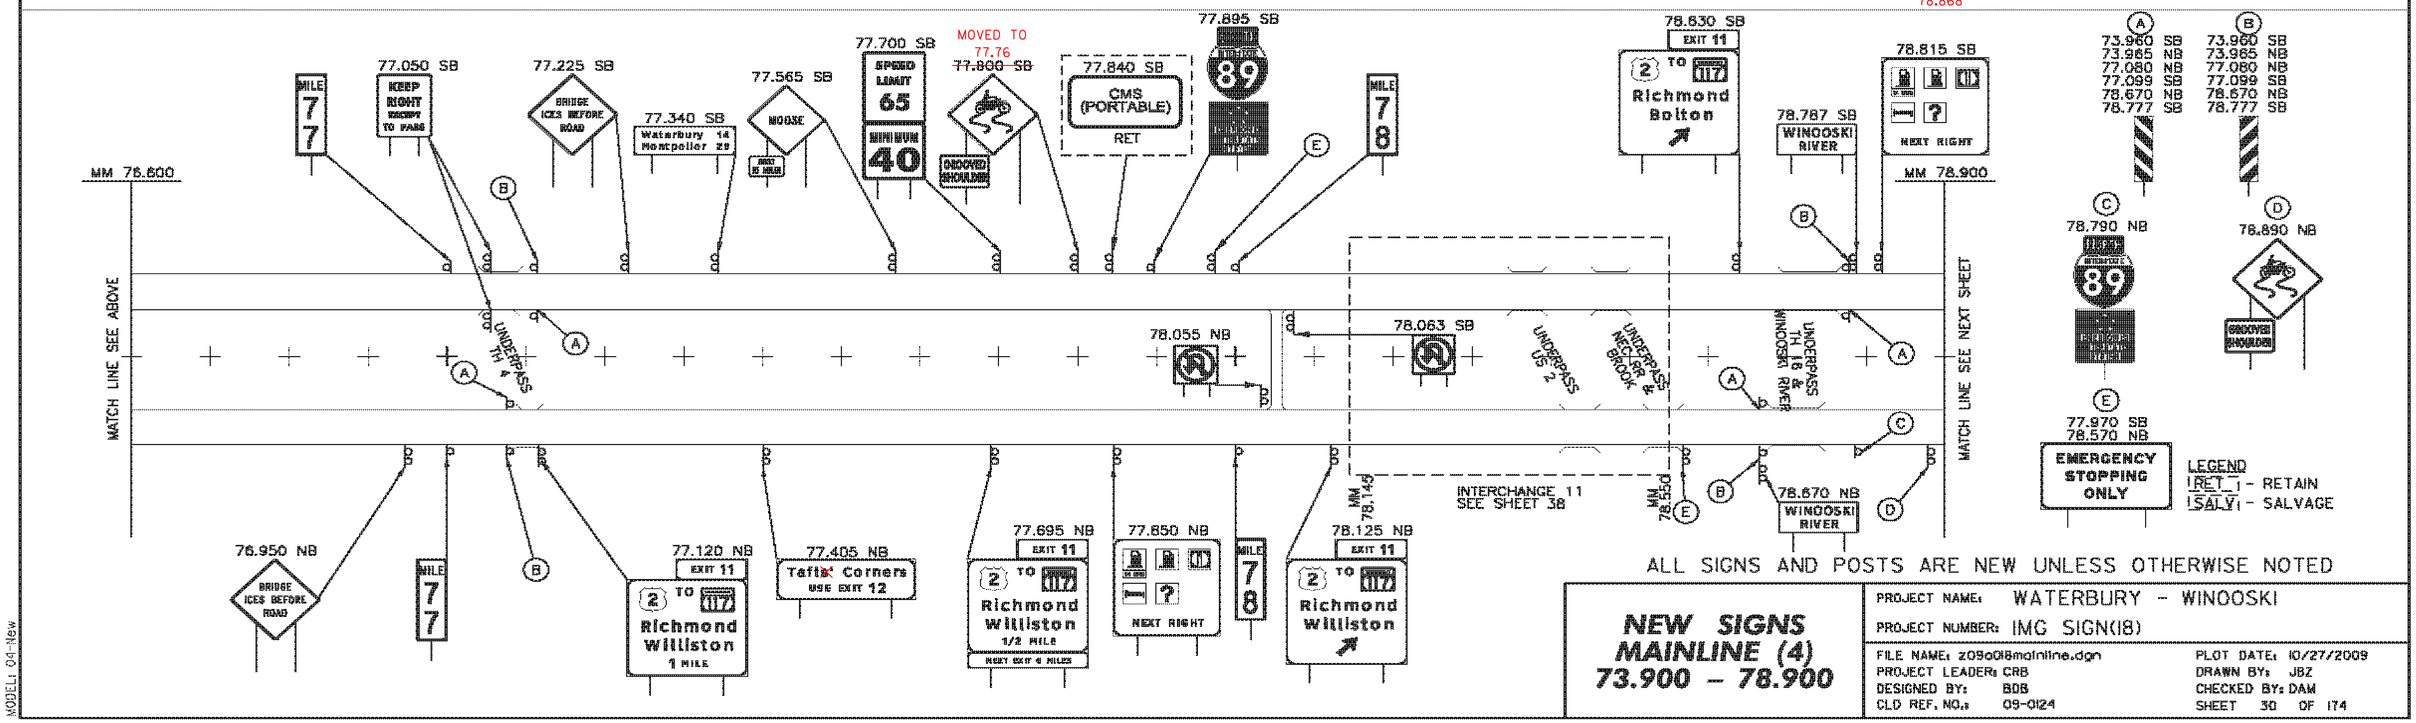

ALL SIGNS AND POSTS ARE NEW UNLESS OTHERWISE NOTED

NEW SIGNS MAINLINE (4)
73.900 – 78.900

PROJECT NAME: WATERBURY - WINOOSKI
PROJECT NUMBER: IMG SIGN(18)

FILE NAME: z09a018mainline.dgn
PROJECT LEADER: CRB
DESIGNED BY: BDB
CLD REF. NO.: 09-0124
PLOT DATE: 10/27/2009
DRAWN BY: JBZ
CHECKED BY: DAM
SHEET 30 OF 174

MODEL: 04-New