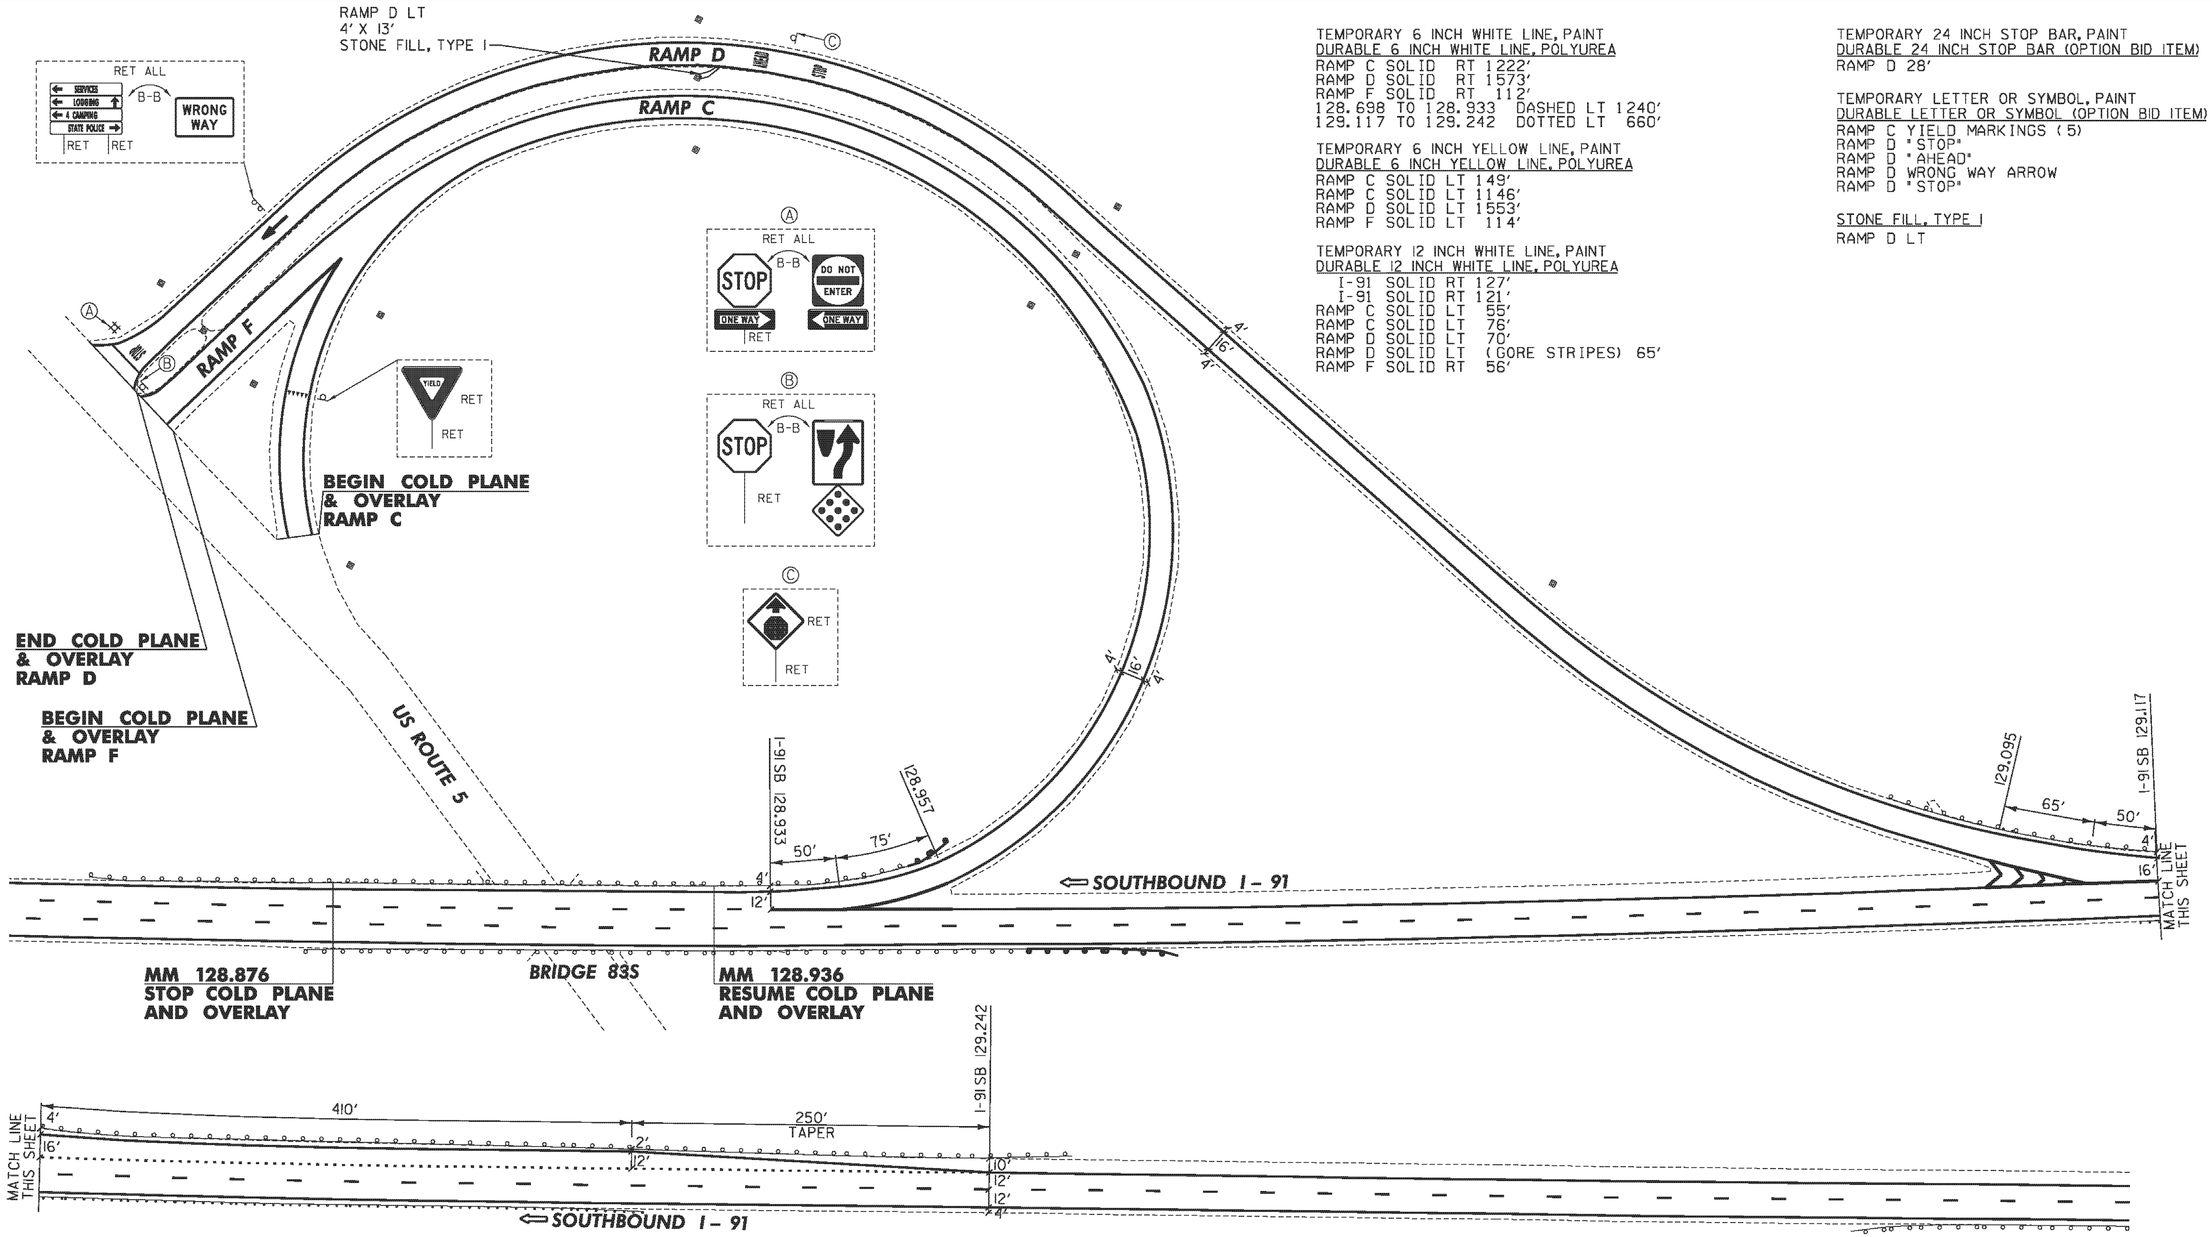

TEMPORARY 6 INCH WHITE LINE, PAINT
DURABLE 6 INCH WHITE LINE, POLYUREA
RAMP C SOLID RT 1222'
RAMP D SOLID RT 1573'
RAMP F SOLID RT 112'
128.698 TO 128.933 DASHED LT 1240'
129.117 TO 129.242 DOTTED LT 660'

TEMPORARY 6 INCH YELLOW LINE, PAINT
DURABLE 6 INCH YELLOW LINE, POLYUREA
RAMP C SOLID LT 149'
RAMP C SOLID LT 1146'
RAMP D SOLID LT 1553'
RAMP F SOLID LT 114'

TEMPORARY 12 INCH WHITE LINE, PAINT
DURABLE 12 INCH WHITE LINE, POLYUREA
I-91 SOLID RT 127'
I-91 SOLID RT 121'
RAMP C SOLID LT 55'
RAMP C SOLID LT 76'
RAMP D SOLID LT 70'
RAMP D SOLID LT (GORE STRIPES) 65'
RAMP F SOLID RT 56'

TEMPORARY 24 INCH STOP BAR, PAINT
DURABLE 24 INCH STOP BAR (OPTION BID ITEM)
RAMP D 28'

TEMPORARY LETTER OR SYMBOL, PAINT
DURABLE LETTER OR SYMBOL (OPTION BID ITEM)
RAMP C YIELD MARKINGS (5)
RAMP D "STOP"
RAMP D "AHEAD"
RAMP D WRONG WAY ARROW
RAMP D "STOP"

STONE FILL, TYPE I
RAMP D LT

NOT TO SCALE

EXIT 20 SOUTHBOUND DETAIL SHEET

PROJECT NAME: ST. JOHNSBURY-LYNDON	
PROJECT NUMBER: IM 091-3(50)	
FILE NAME: lla346/cos/zlla346int20sb.dgn	PLOT DATE: 10/17/2013
PROJECT LEADER: PTS	DRAWN BY: JLS
DESIGNED BY: NLL	CHECKED BY: PTS
IPARM FILE NAME: plla346_44	SHEET 44 OF 72