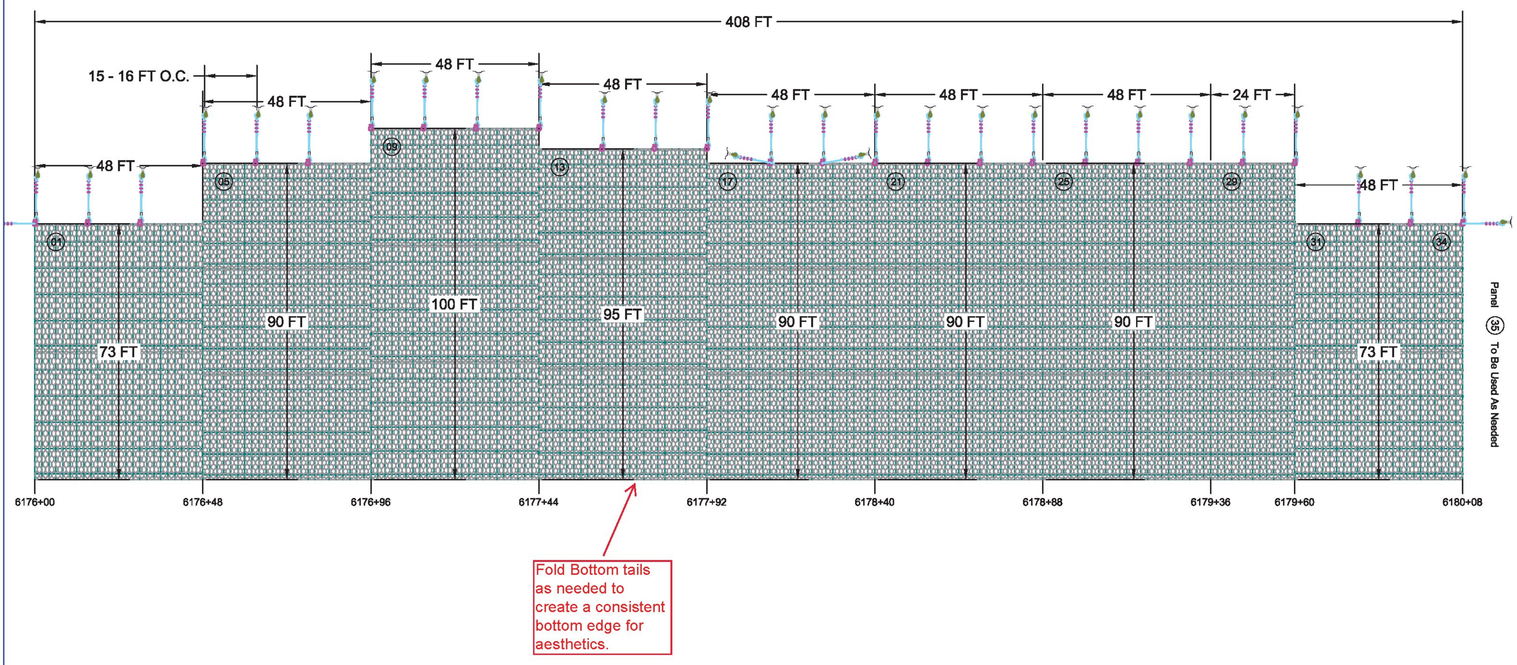

Maccaferri Inc. assumes no responsibility for the drawings and calculations it provides, as they must be intended as a general indication to suggest the proper use of its products.

Rev:	Issue / Revision:	Drawn:	App:	Date:

Scaled to fit 24X36(ANSI D) on sheet: Tabloid

Drawing Title: RockMesh 30100 Drapery
Project Panel & Anchor Layout Elevation View

Project No: RFBU2017 - 102
Client: VAOT
Drawing No: 2 / 03
Units: Feet
Scale: NTS
Rev: 1
Printed on: 9/22/17

Designed: - Date: -
Drawn: BL Date: 08.24.17
Checked: - Date: -

Project: RYEGATE IM 091-2 (80) / ROCK SLOPE PROTECTION

TYPICAL DRAWINGS

MACCAFERRI

Maccaferri, Inc.
10303 Governor Lane Blvd.
Williamsport, MD 21795-3116 USA
Ph. (301) 223-6910 Fax (301) 223-6134