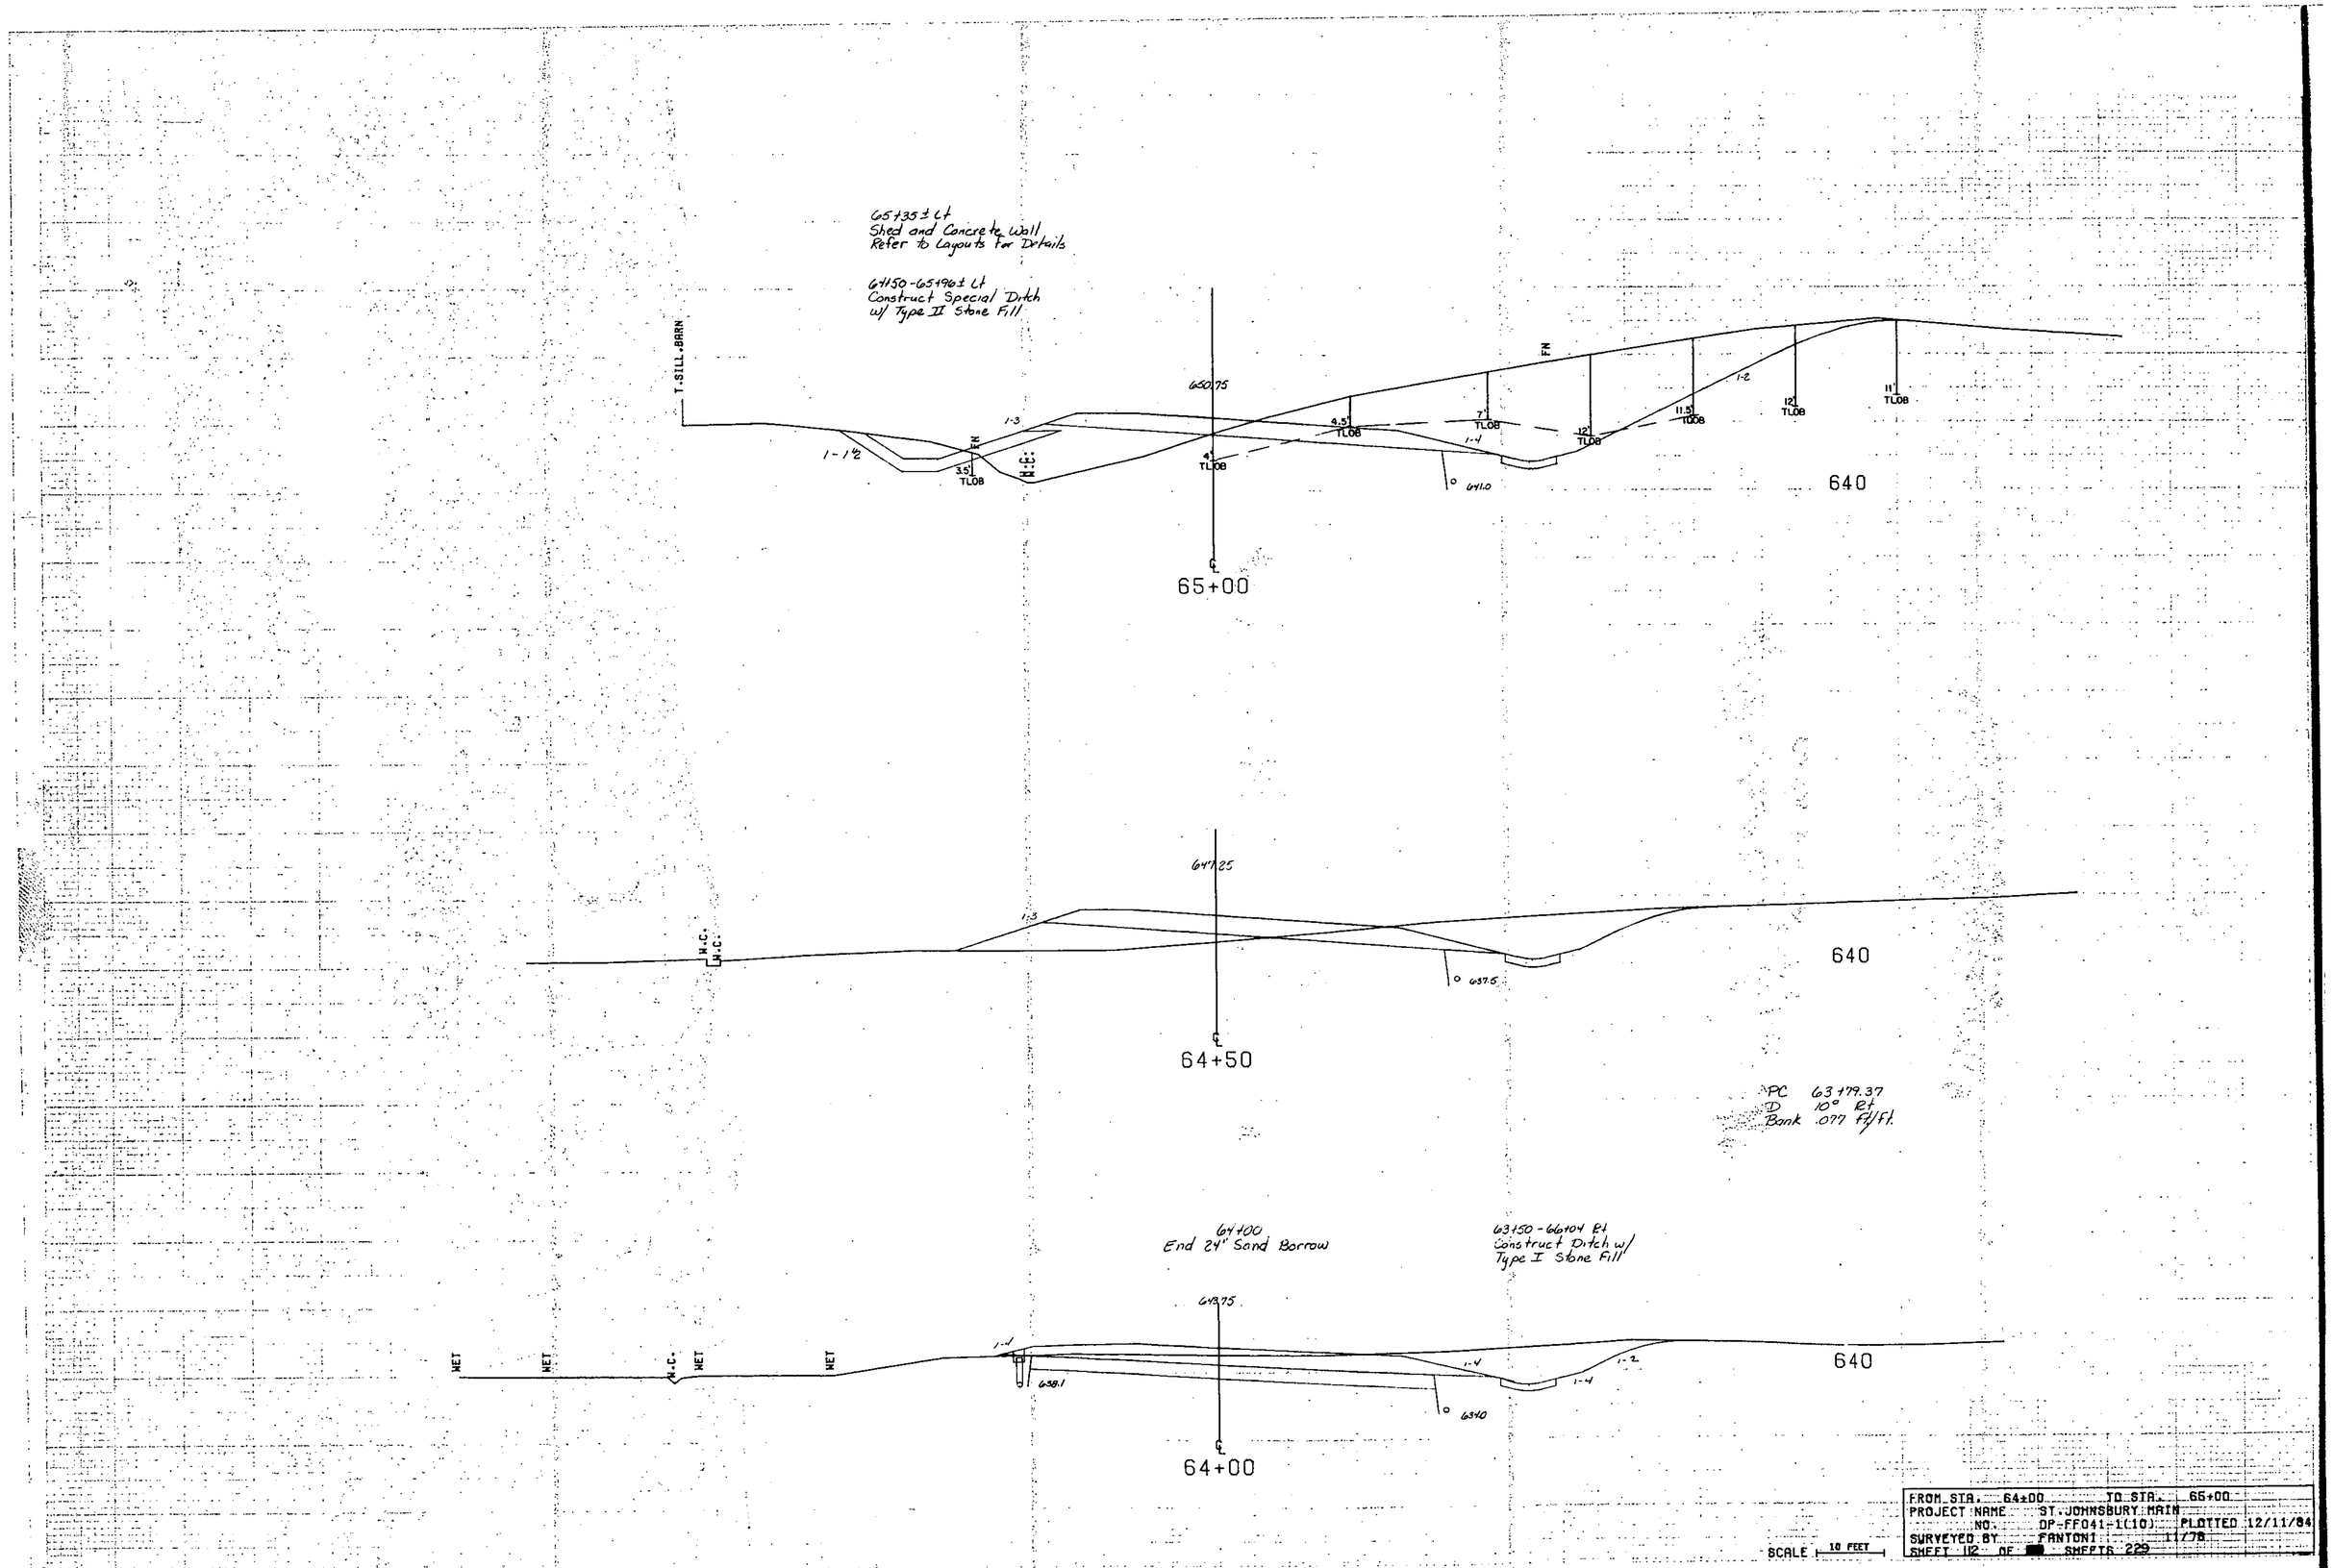
65+35± Lt
Shed and Concrete Wall
Refer to Layouts for Details
64+50-65+96± Lt
Construct Special Ditch
w/ Type II Stone Fill
T.SILL.BARN
650.75
1-3
1-1½
FN
3.5' TLOB
4' TLOB
4.5' TLOB
7' TLOB
1-4
12' TLOB
11.5' TLOB
1-2
12' TLOB
11' TLOB
641.0
640
65+00
647.25
1-3
W.C.
637.5
640
64+50
PC 63+79.37
D 10° Rt
Bank .077 Ft/Ft.
64+00
End 24" Sand Borrow
63+50-66+04 Rt
Construct Ditch w/
Type I Stone Fill
643.75
WET
WET
W.C.
WET
WET
1-4
638.1
1-4
1-2
1-4
634.0
640
64+00
SCALE 10 FEET
FROM STA. 64+00 TO STA. 65+00
PROJECT NAME ST.JOHNSBURY MAIN
NO. DP-FF041-1(10) PLOTTED 12/11/84
SURVEYED BY FANTONI 11/78
SHEET 102 OF [redacted] SHEETS 229