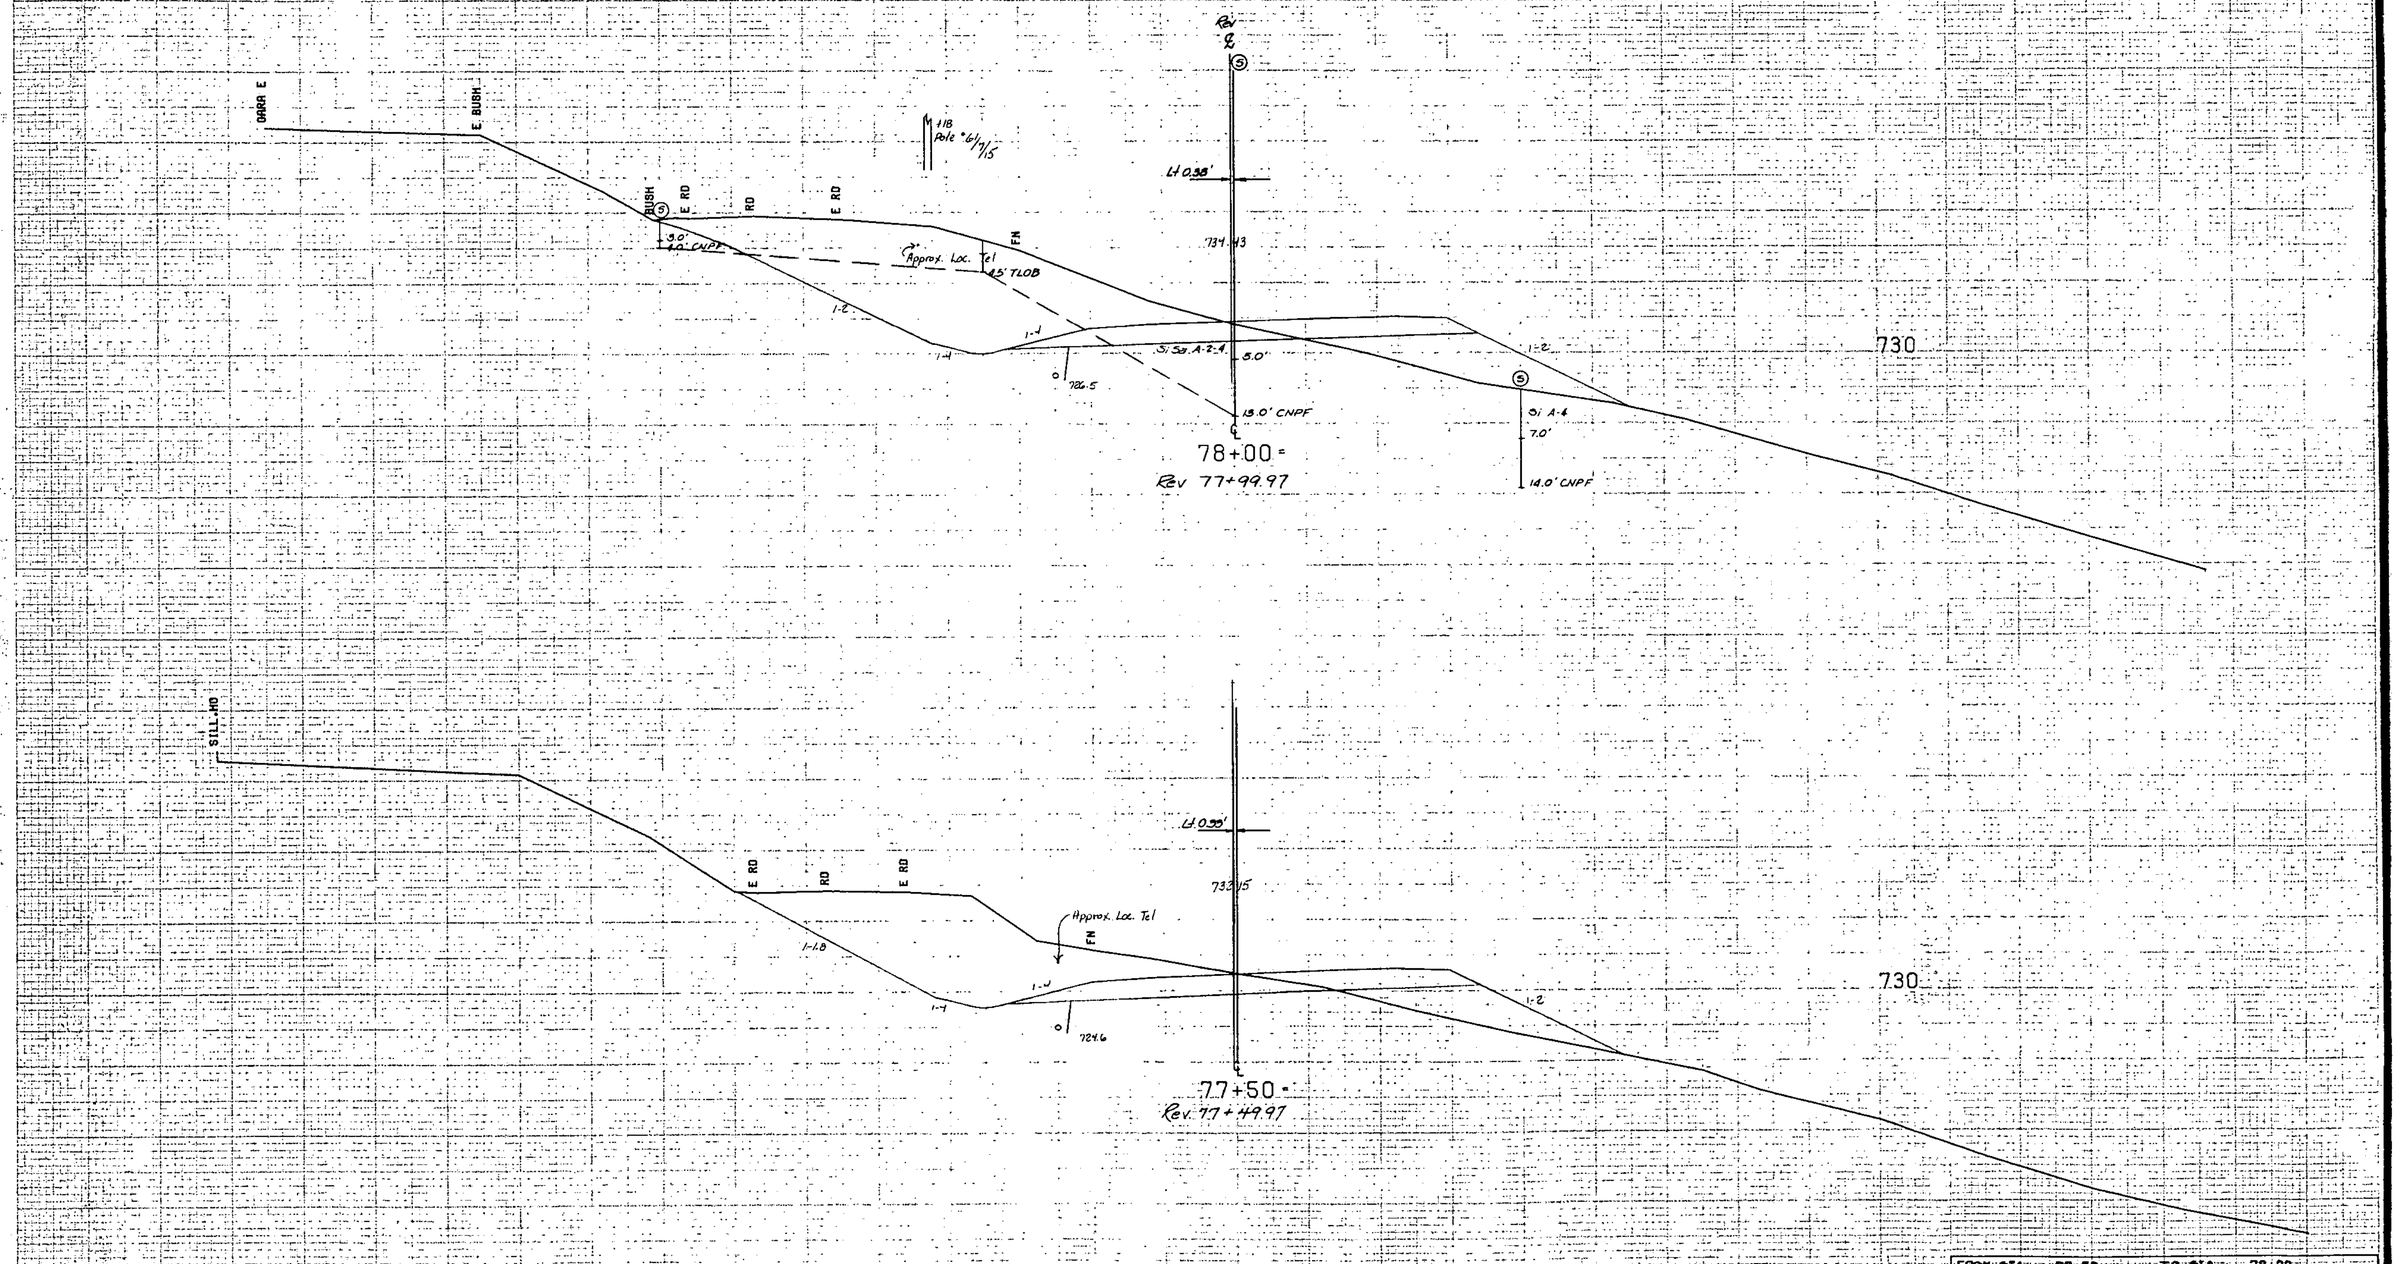

FROM STA. 77+50 TO STA. 78+00
PROJECT ST. JOHNSBURY MAINLINE
NO. DP-FF041-1(10) PLOTTED 2/11/8
SURVEYED BY FANTONI 11/78
SCALE 10 FEET
SHEET 124 OF [redacted] SHEETS 229