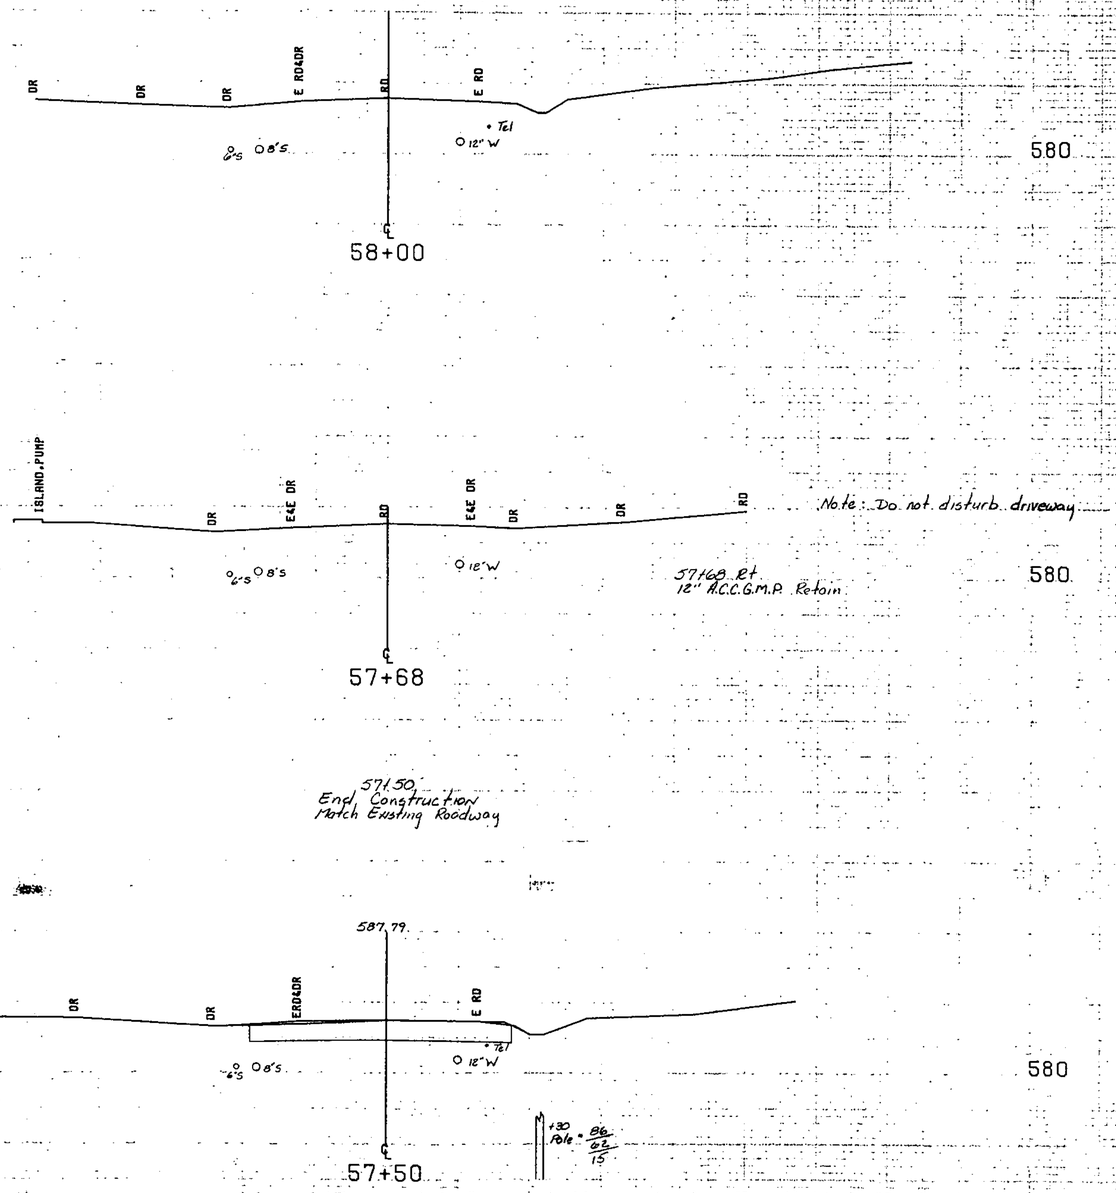

FROM STA.	57+50	TO STA.	58+00
PROJECT NAME	ST. JOHNSBURY U.S. RTE. 5		
NO.	DP-FF041-1(10)	PLOTTED	12/11/84
SURVEYED BY	FANTONI		11/78
SHEET 168 OF [redacted]	SHEETS [redacted] 229		

SCALE 10 FEET