


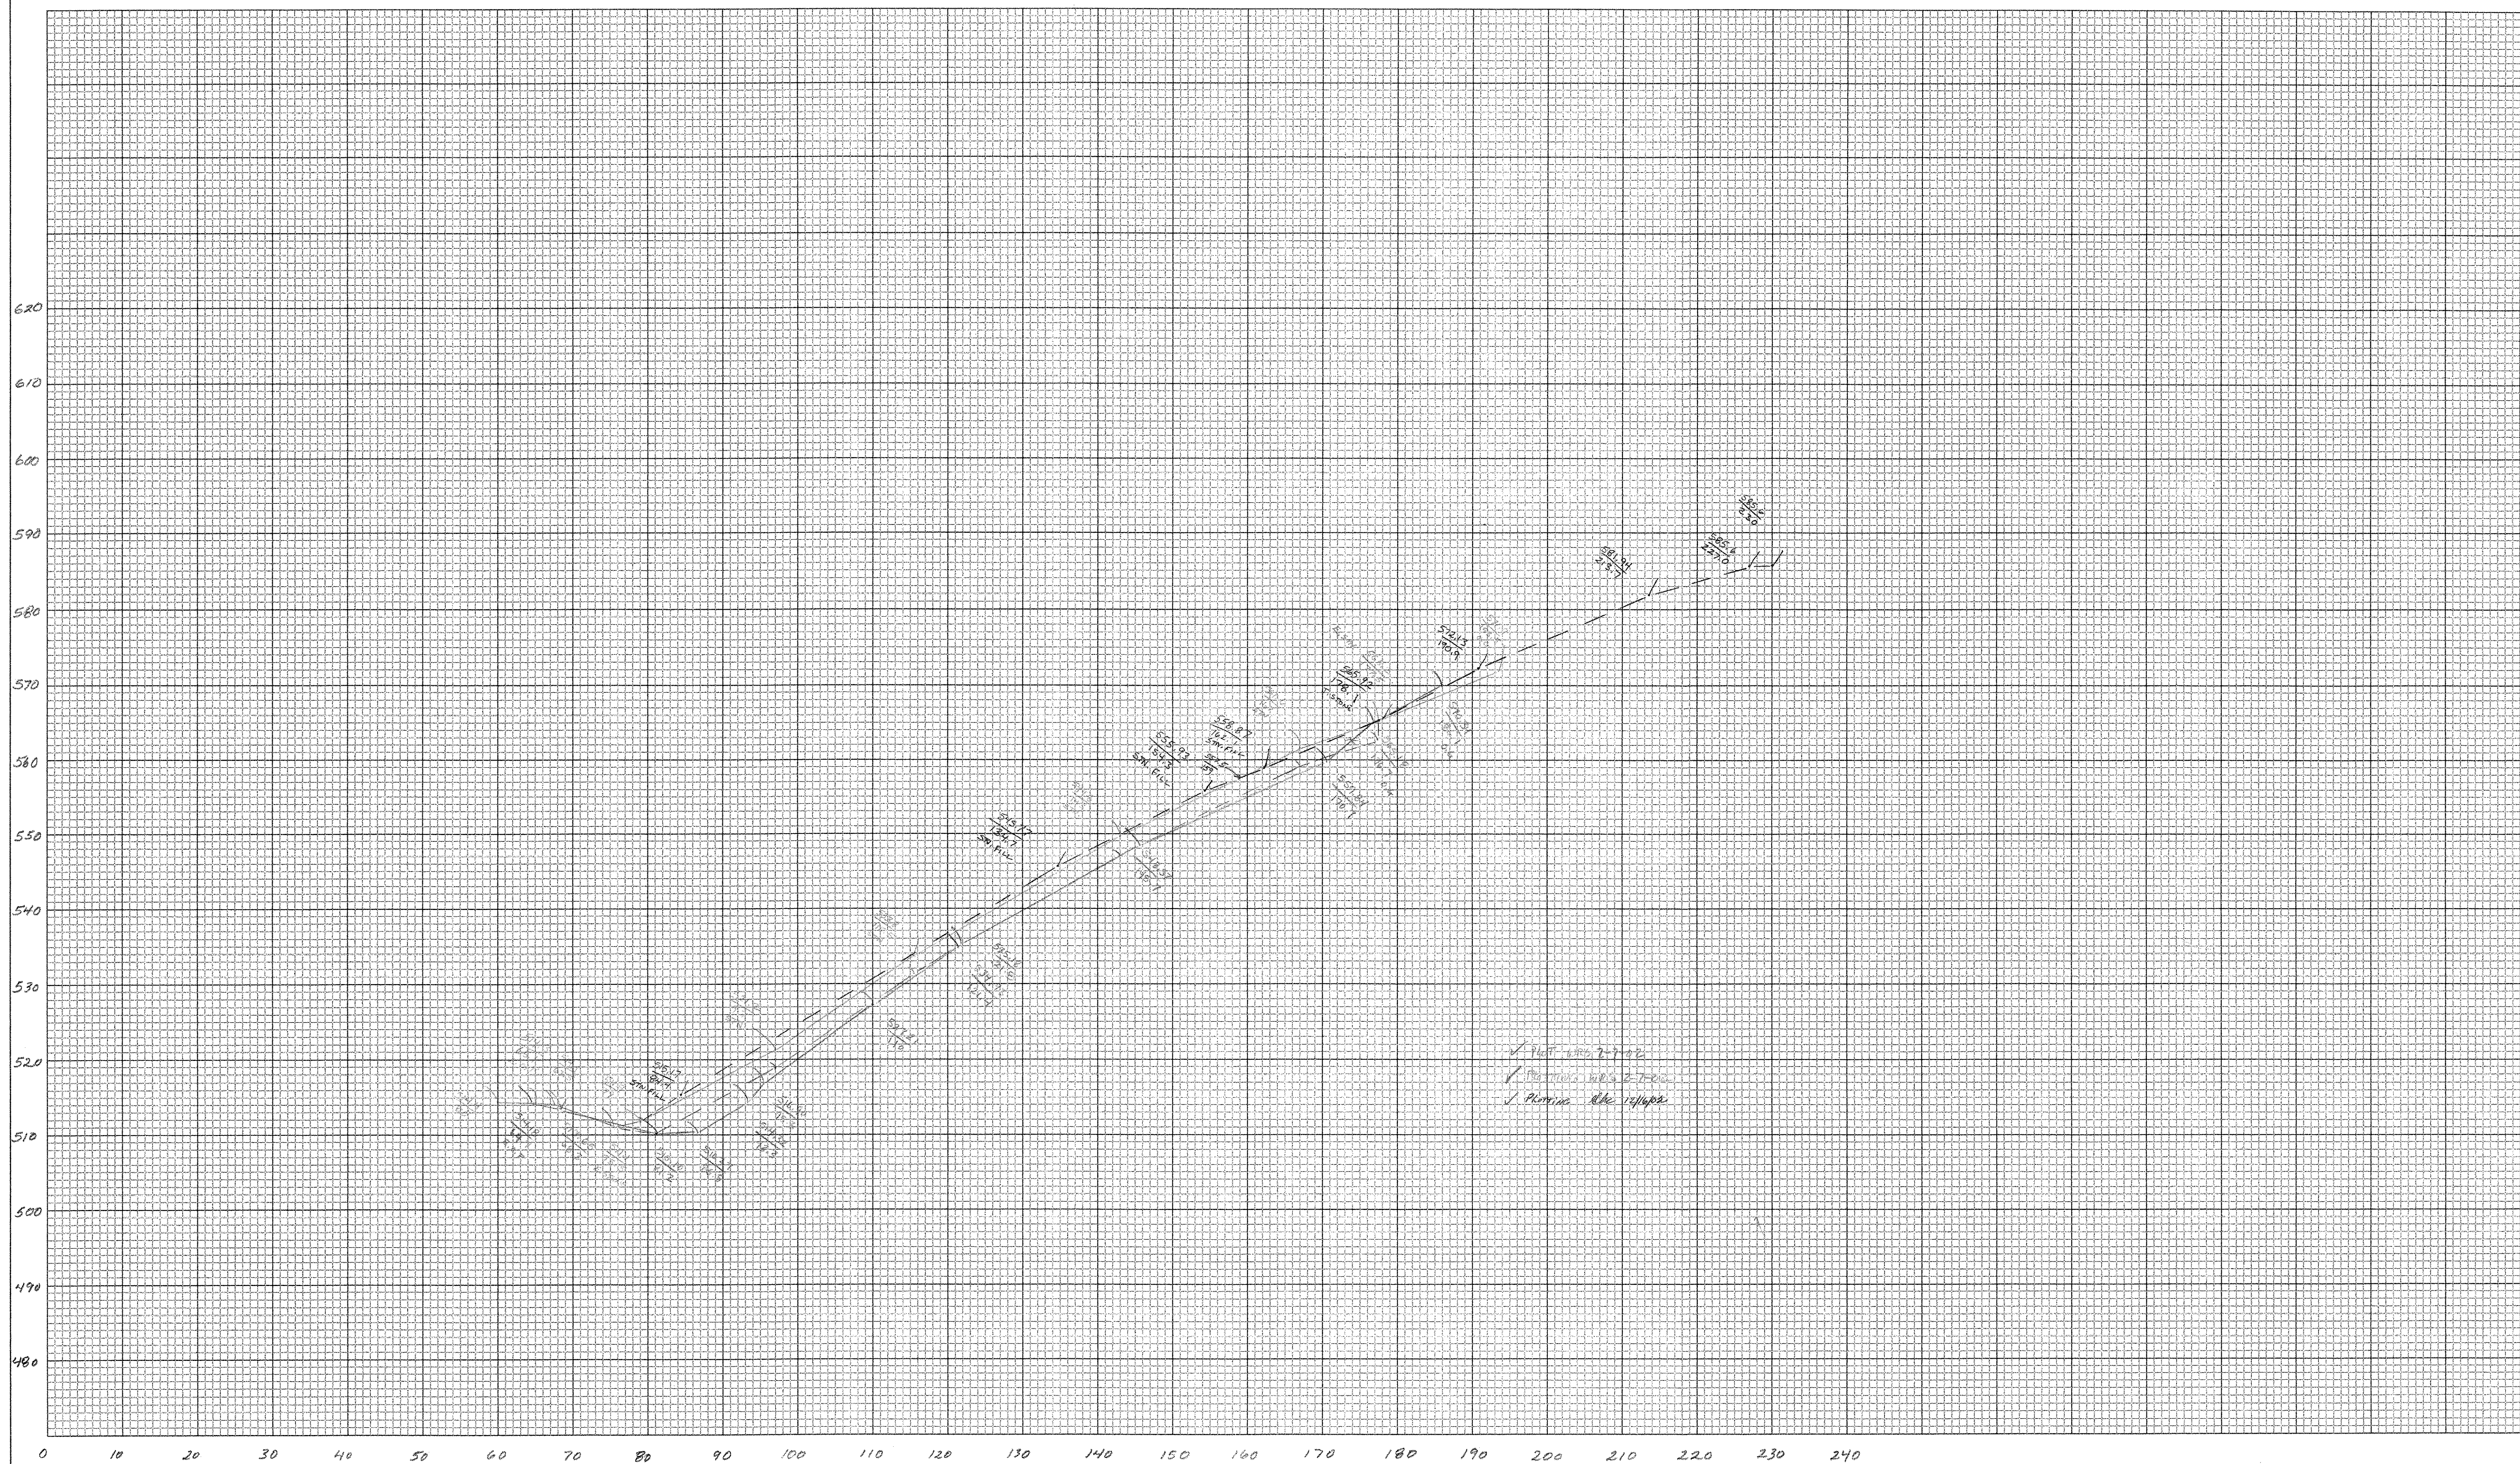

BUTT
STONE FILL

CROSS SECTION SHEET

PROJECT NAME:	HARTFORD - ROYALTON		
PROJECT NUMBER:	IM IR 089-1(8)		
FILE NAME:	_____	PLOT DATE:	05-JUN-2000 09
PROJECT LEADER:	_____	DRAWN BY:	_____
DESIGNED BY:	_____	CHECKED BY:	_____
const: g:/common/cadd/e-xsection.dgn		SHEET	160A OF _____