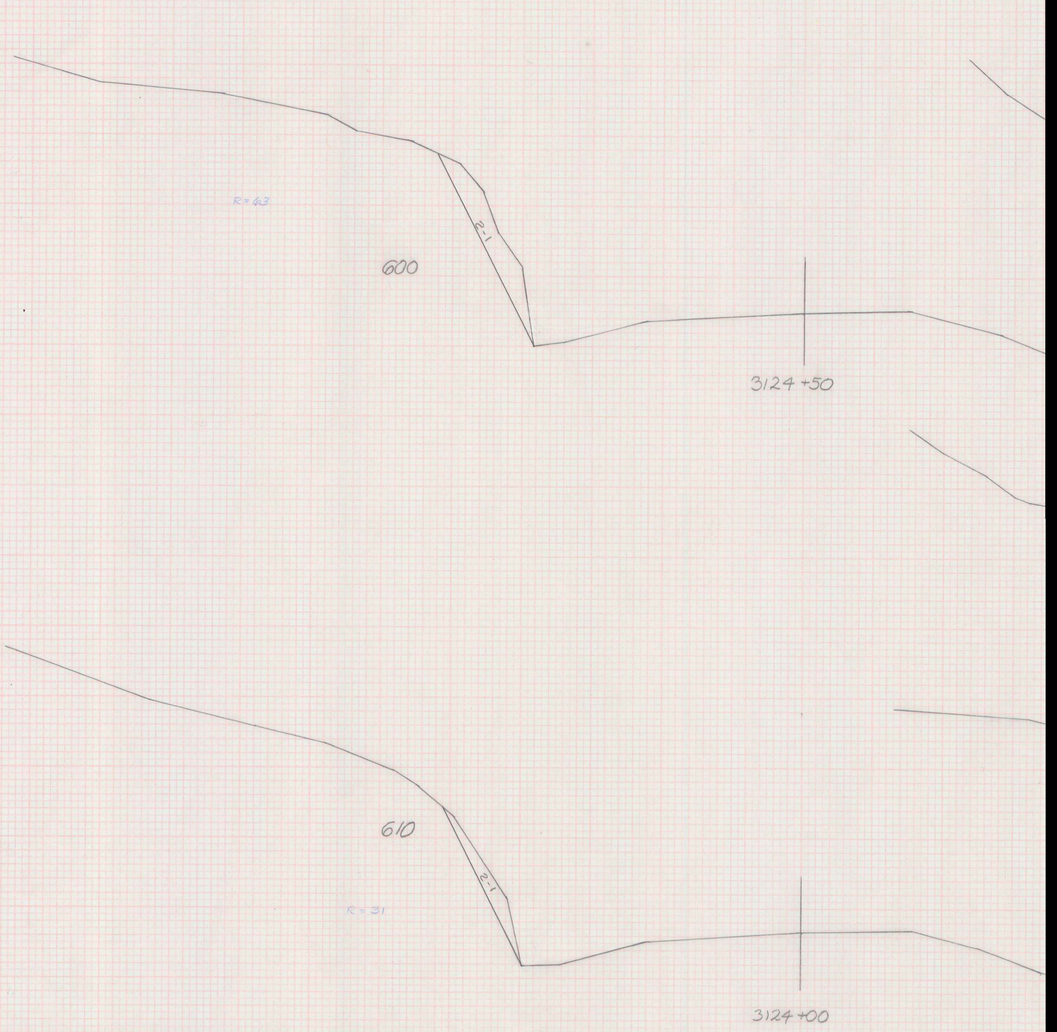

MM 58.90 ± SB OUT.
BEGIN EXCAVATION OF SOLID ROCK.

MM 58.90 = STA. 3123+84