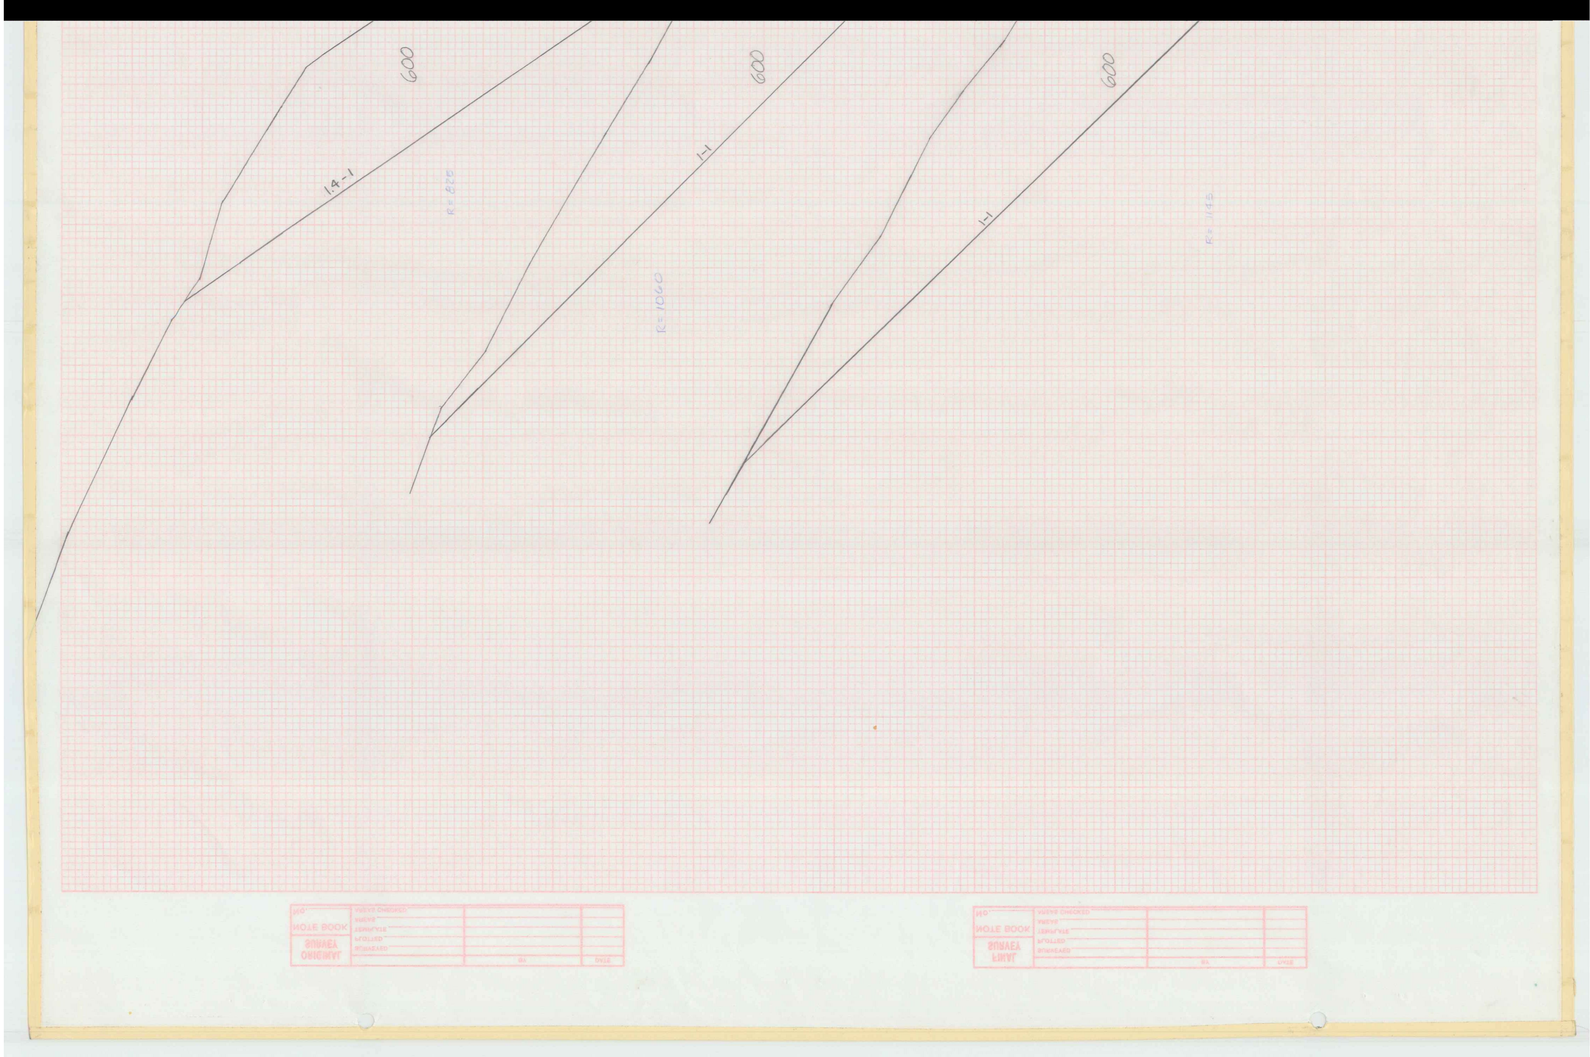
600
14-1
600
1-1
600
1-1