MM 59.05 ± SB OUT.
END EXCAVATION OF SOLID ROCK.

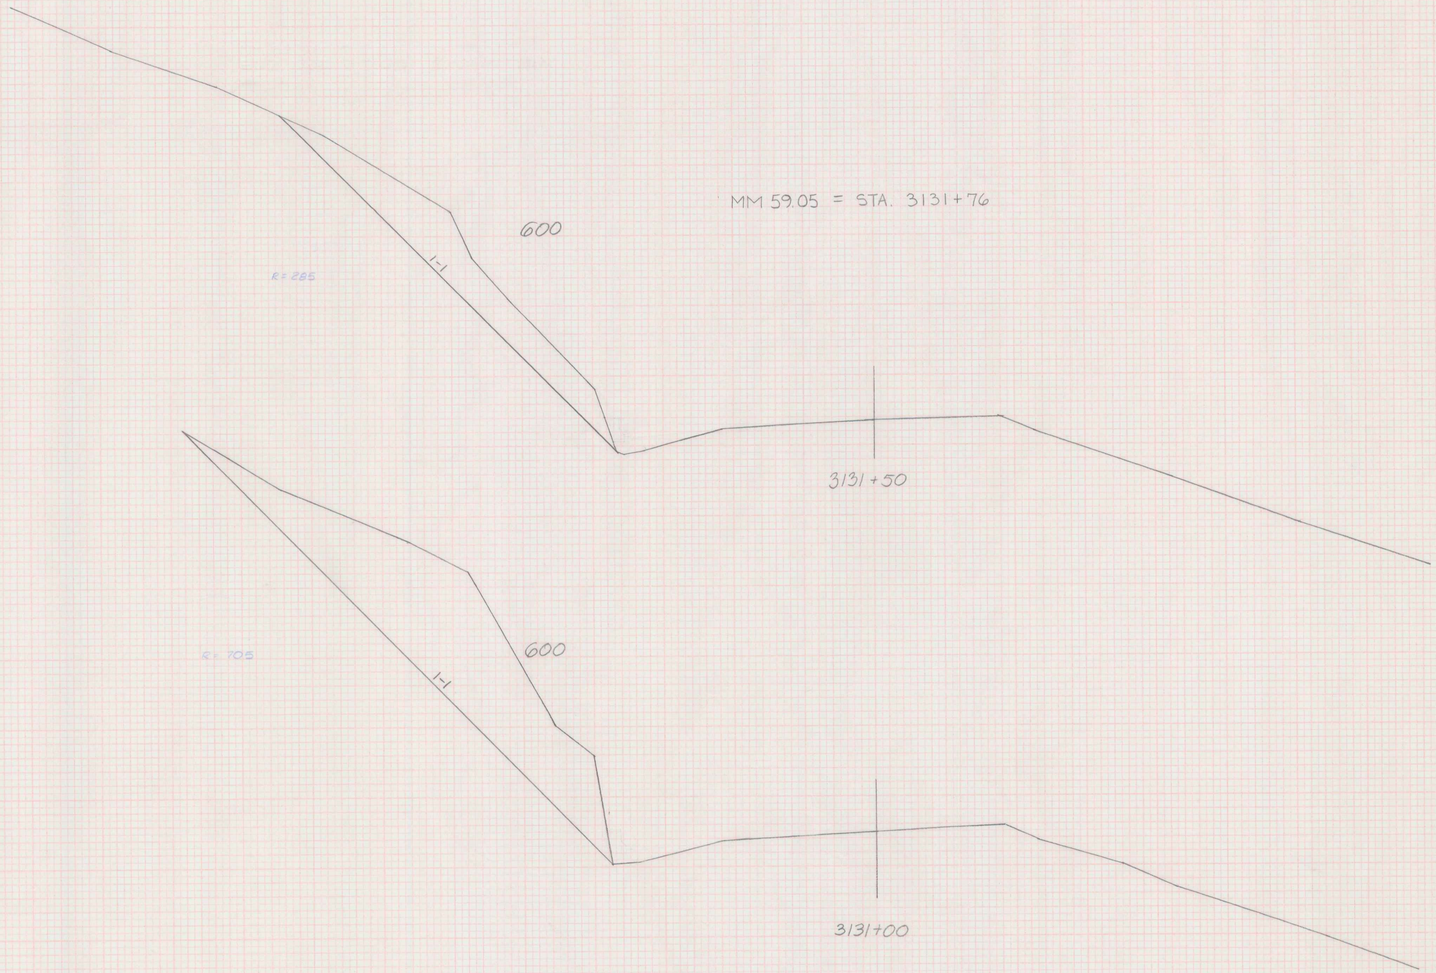

MM. 58.90 MM.
STA. 3131+0 STA.
TOWN SPRINGFIELD-HA
PROJECT ID NO. 051-
SHEET 58 OF
HORIZ. AND VERT. SC
1"= 10'
DATE: JAN. '90