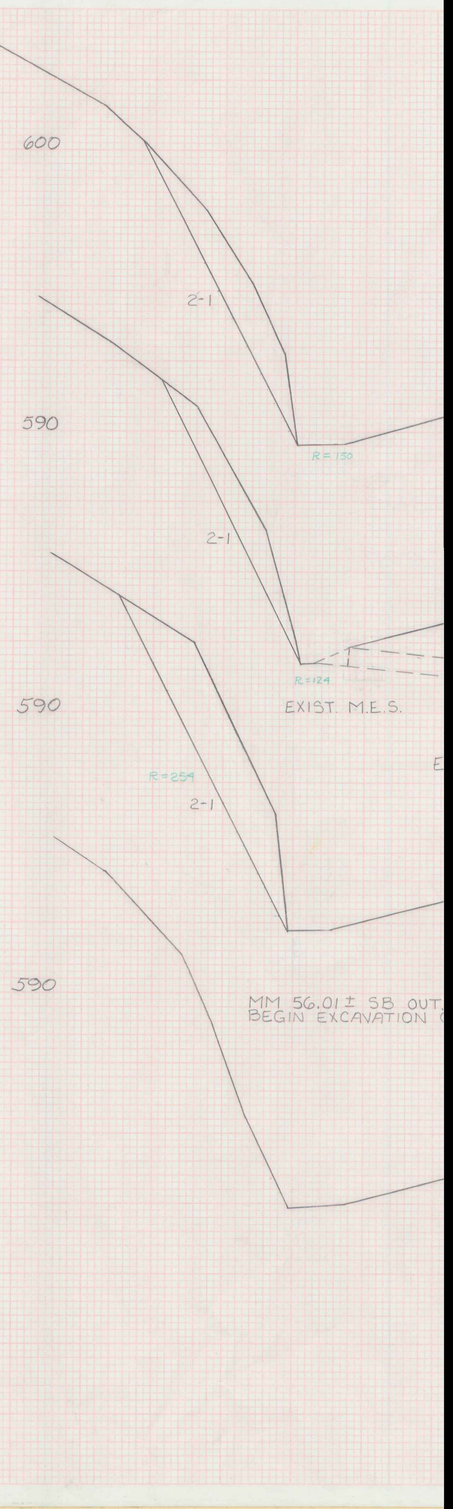

600
2-1
590
R=150
2-1
R=124
590
EXIST. M.E.S.
R=254
2-1
590
MM 56.01± SB OUT
BEGIN EXCAVATION