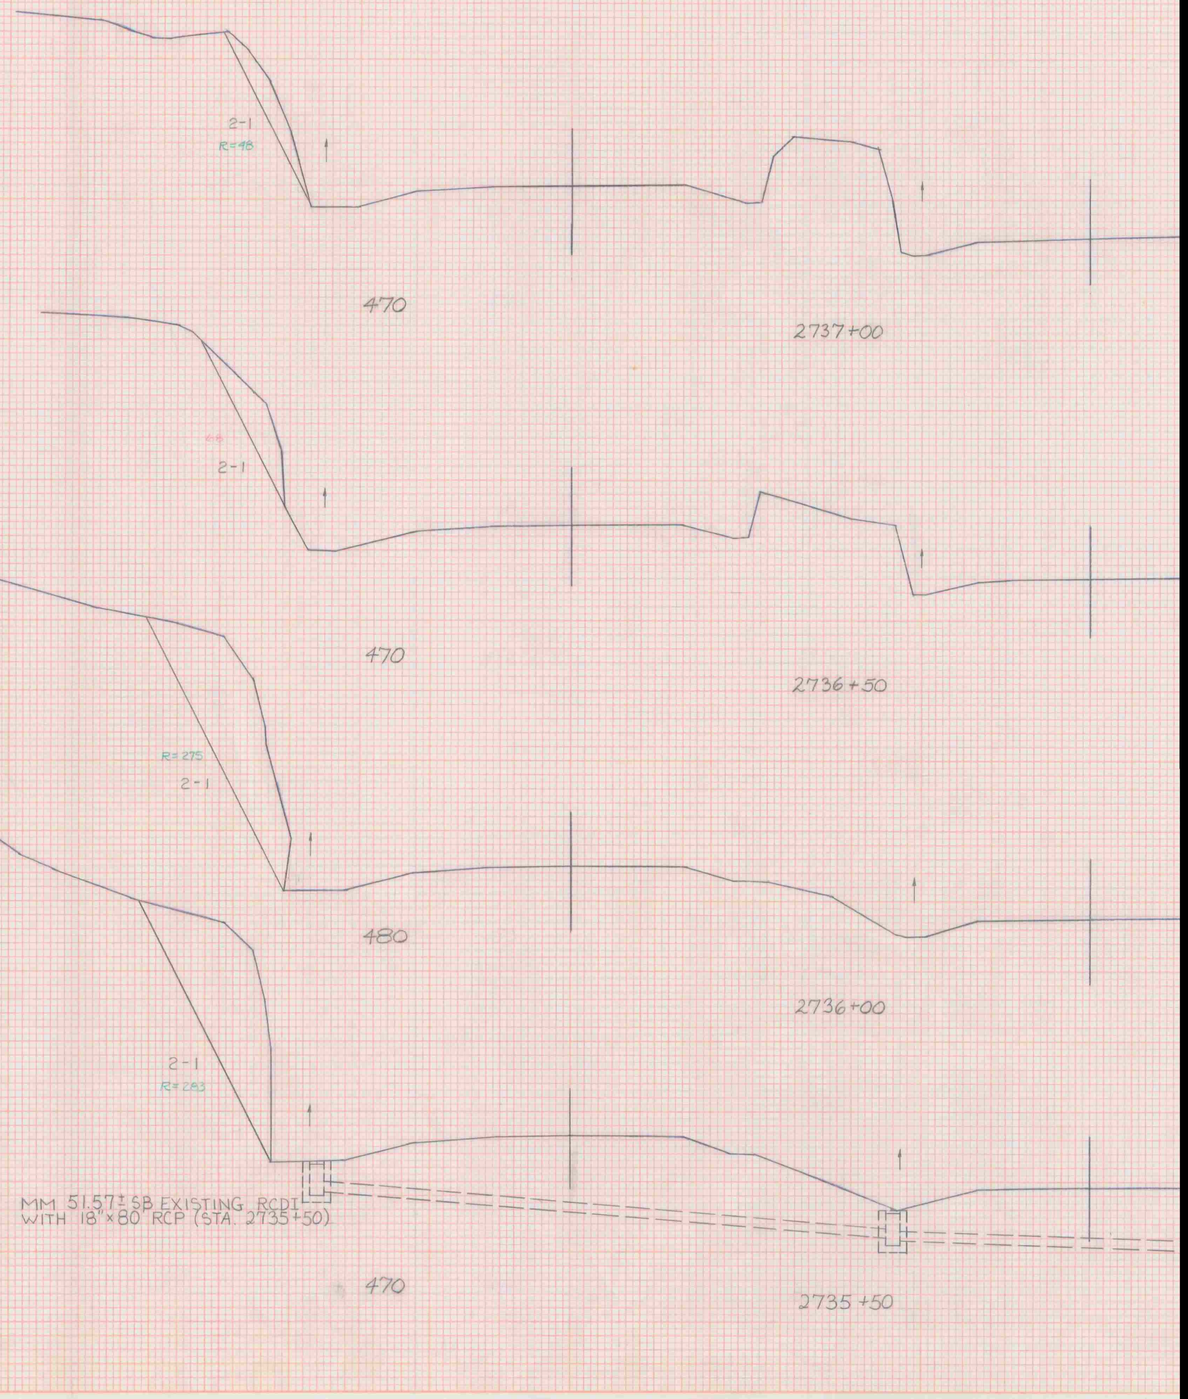


FINAL SURVEY
SURVEYED
PLOTTED
TEMPLATE
AREAS CHECKED
DATE
BY
NO.
ORIGINAL SURVEY
SURVEYED
PLOTTED
TEMPLATE
AREAS CHECKED
DATE
BY
NO.