



MM 51.65 = STA. 273

450

MM 51.65± S.B. OUT.
END EXCAVATION OF SOLID ROCK.

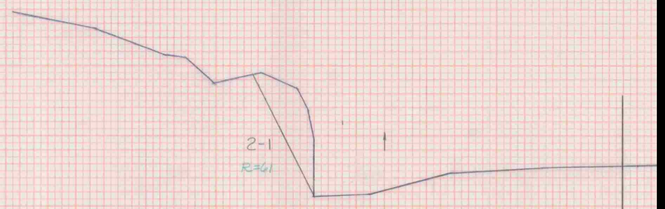

460

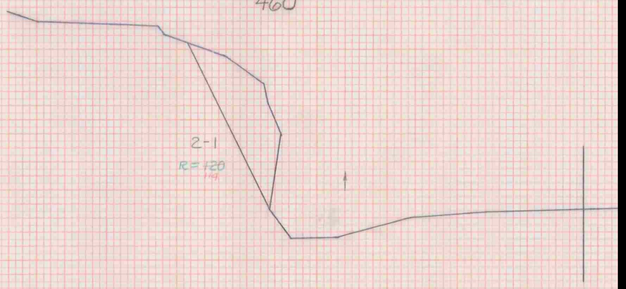

460