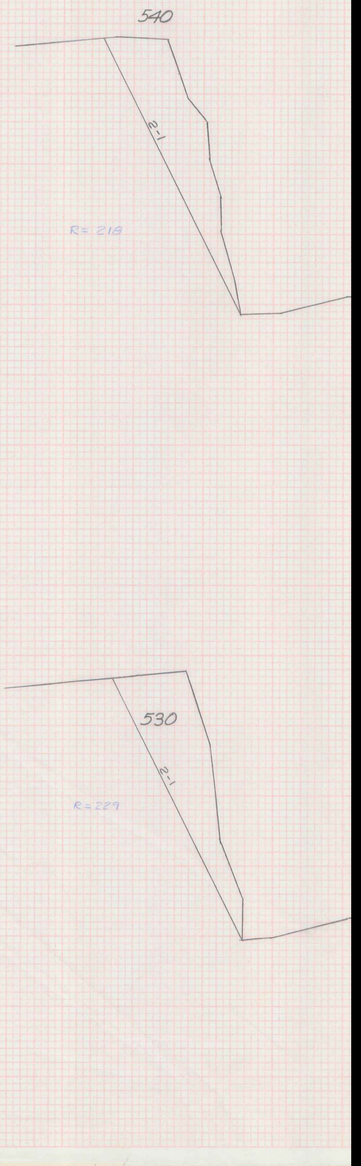

540
2-1
R= 218

530
2-1
R=229