FINAL SURVEY
NOTE BOOK
NO.
SURVEYED
PLOTTED
TEMPLATE
AREAS
AREAS CHECKED
BY
DATE



ORIGINAL SURVEY
NOTE BOOK
NO.
SURVEYED
PLOTTED
TEMPLATE
AREAS
AREAS CHECKED
BY
DATE

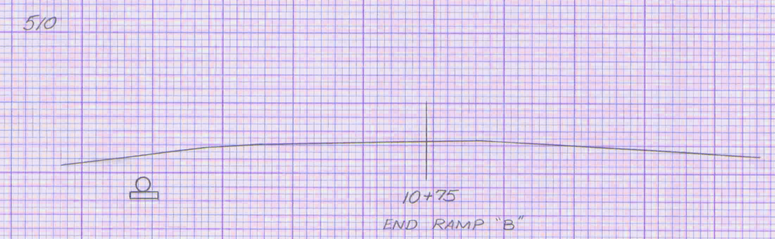


PLATE 3 CROSS SECTION
DIETZGEN COR

EXIT 8 - RAM

MM	51.50	MM	
STA	N/A	STA	
TOWN	SPRINGFIELD-HA		
PROJECT	IR 091-1(2		
HORIZ. & VERT. SCALES			
1"=10'			
DATE :	JAN '90		
SHEET	73	OF	133

PLATE 3 CROSS SECTION O. P. R. & R. E. STANDARD
DIETZGEN CORPORATION



STA 10+60 RT.
END EXCAVATION OF SOLID ROCK

