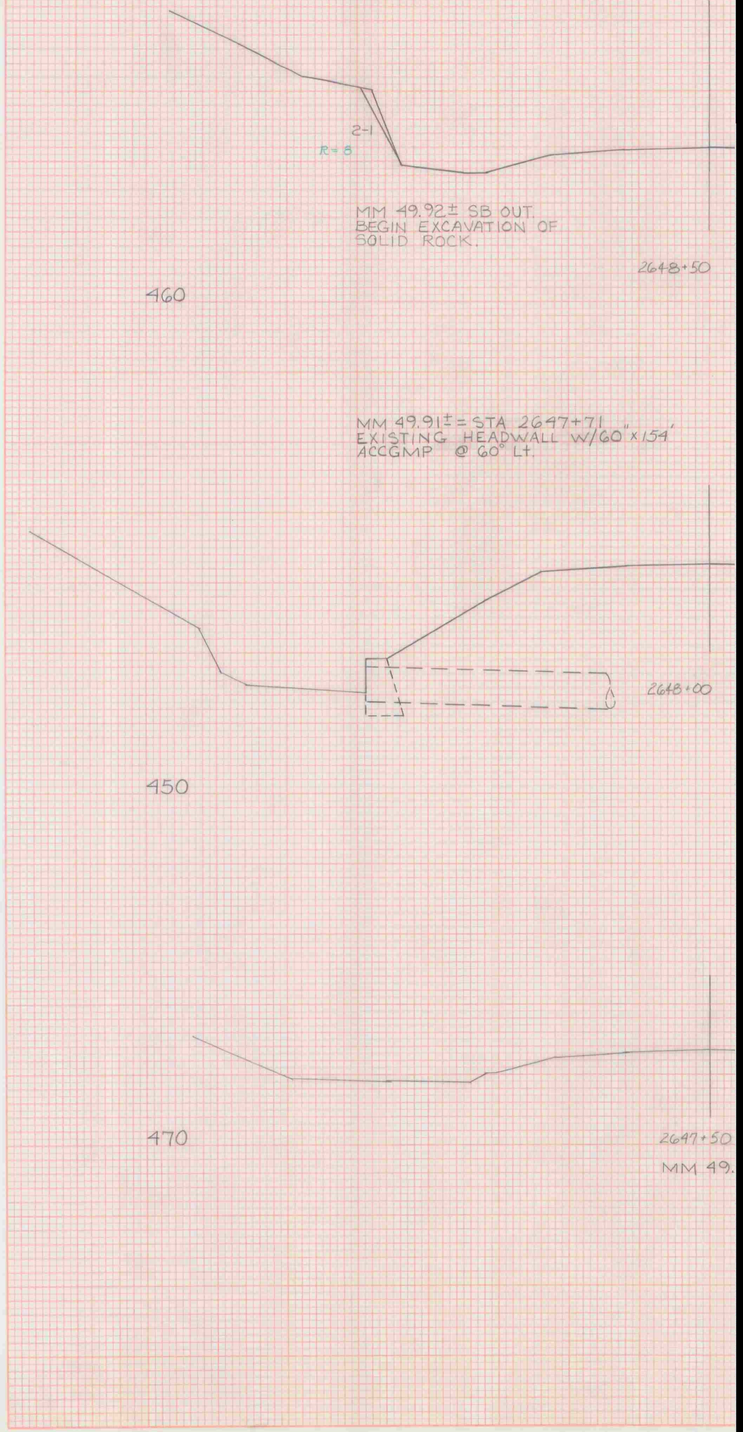
2-1
R=8
MM 49.92± SB OUT.
BEGIN EXCAVATION OF
SOLID ROCK.
2648+50
460
MM 49.91± = STA 2647+71
EXISTING HEADWALL W/60" x 154'
ACCGMP @ 60° LT.
2648+00
450
470
2647+50
MM 49.