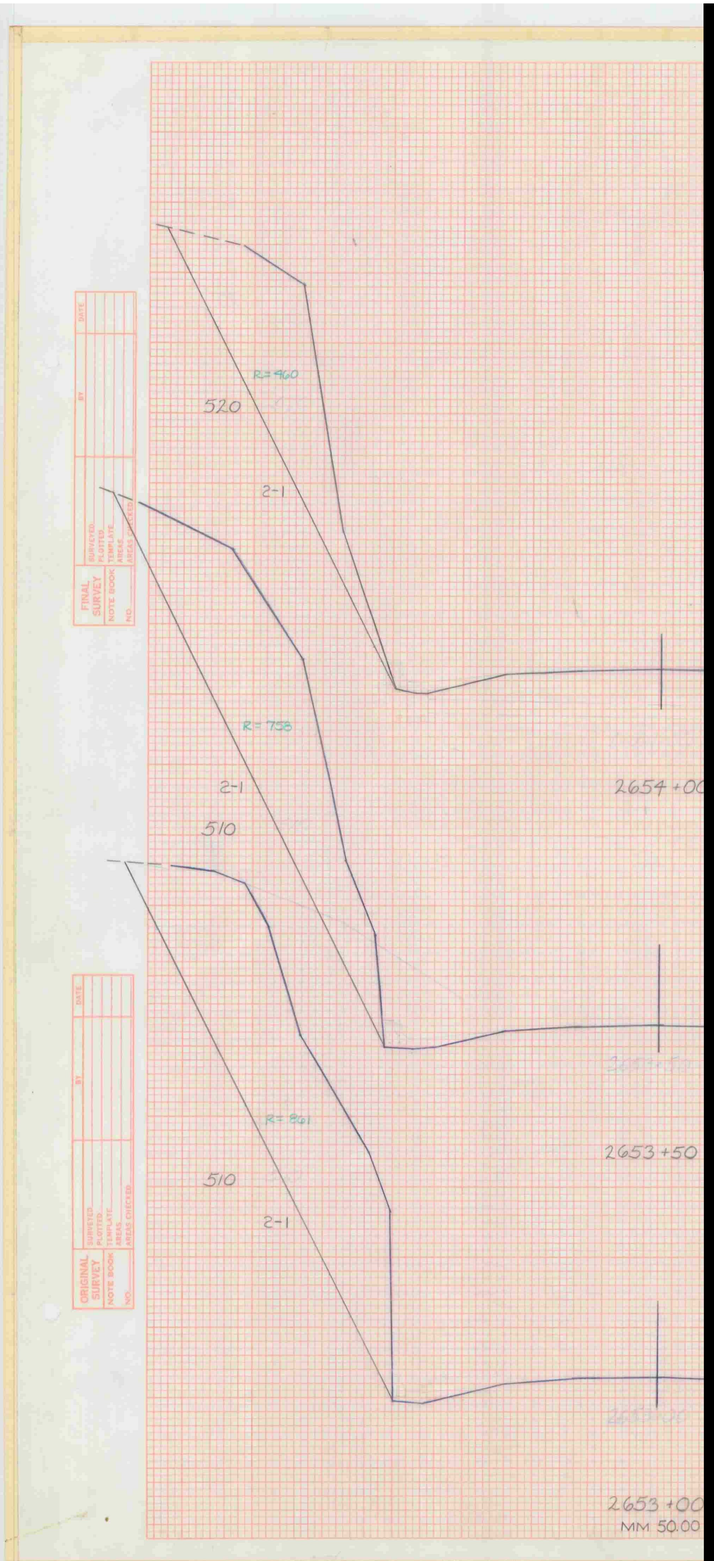
R=960
520
2-1
R=758
2-1
2654+00
510
R=861
2653+50
510
2-1
2653+00
MM 50.00