


DATE	BY	REVIEWED	DATE
FINAL SURVEY	DATE	REVIEWED	DATE

DATE	BY	REVIEWED	DATE
ORIGINAL SURVEY	DATE	REVIEWED	DATE

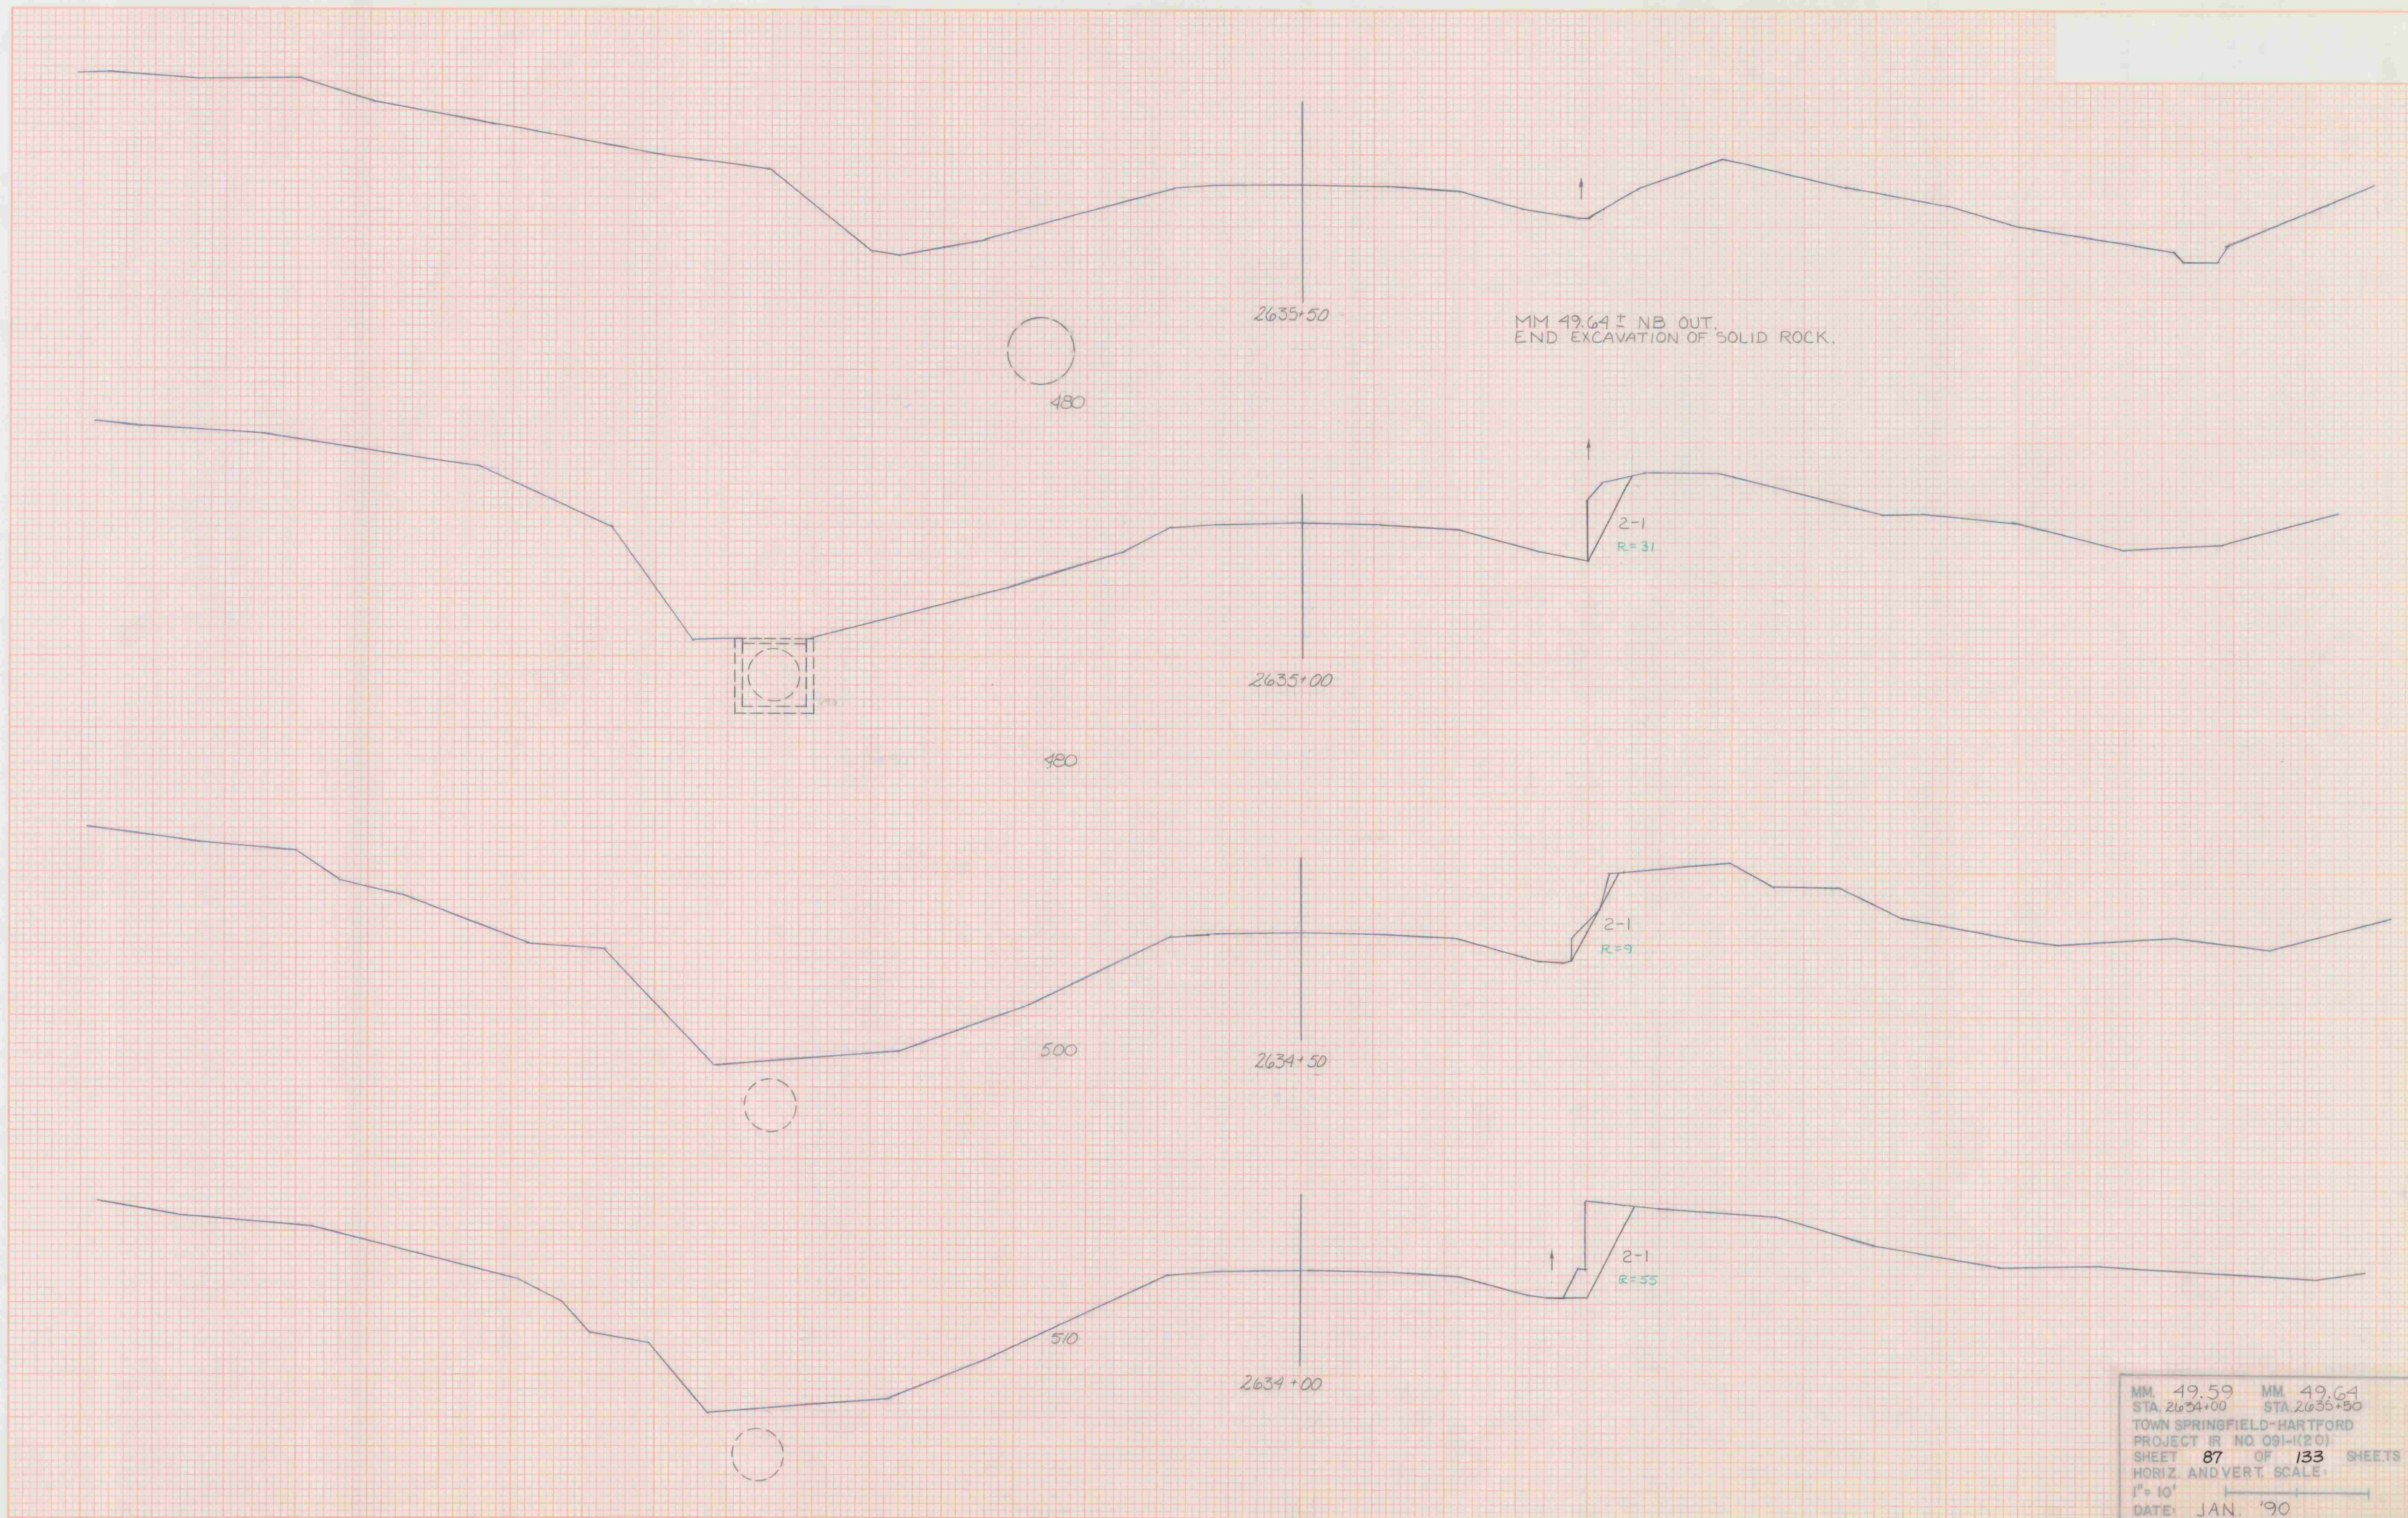

MM. 49.59 STA. 2634+00
 MM. 49.64 STA. 2635+50
 TOWN SPRINGFIELD-HARTFORD
 PROJECT IR NO 091-1(20)
 SHEET 87 OF 133 SHEETS
 HORIZ. AND VERT. SCALE:
 1" = 10'
 DATE: JAN. '90