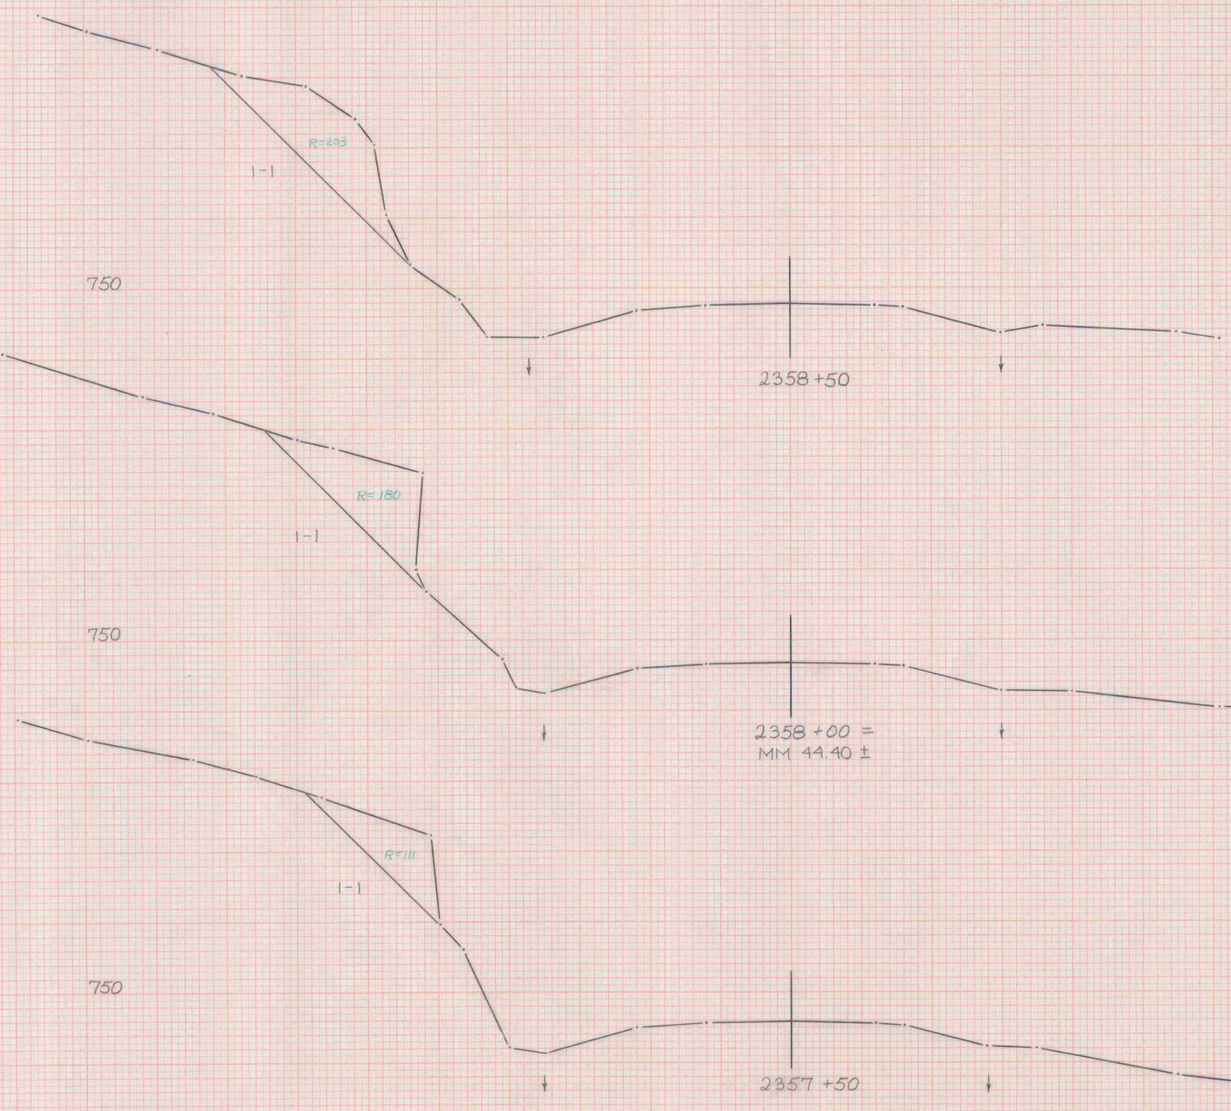

SOUTHBOUND

MM	44.34	MM	44.4
STA	2357+50	STA	2358

TOWN SPRINGFIELD-HARTFO
PROJECT IR 091-1(20)
HORIZ. & VERT. SCALES
1"=10'
DATE : JAN '90
SHEET 91 OF 133 SHEE

Keuffel & Esser Company PLATE 3, CROSS SECTION 4B7056 Made in U.S.A.