
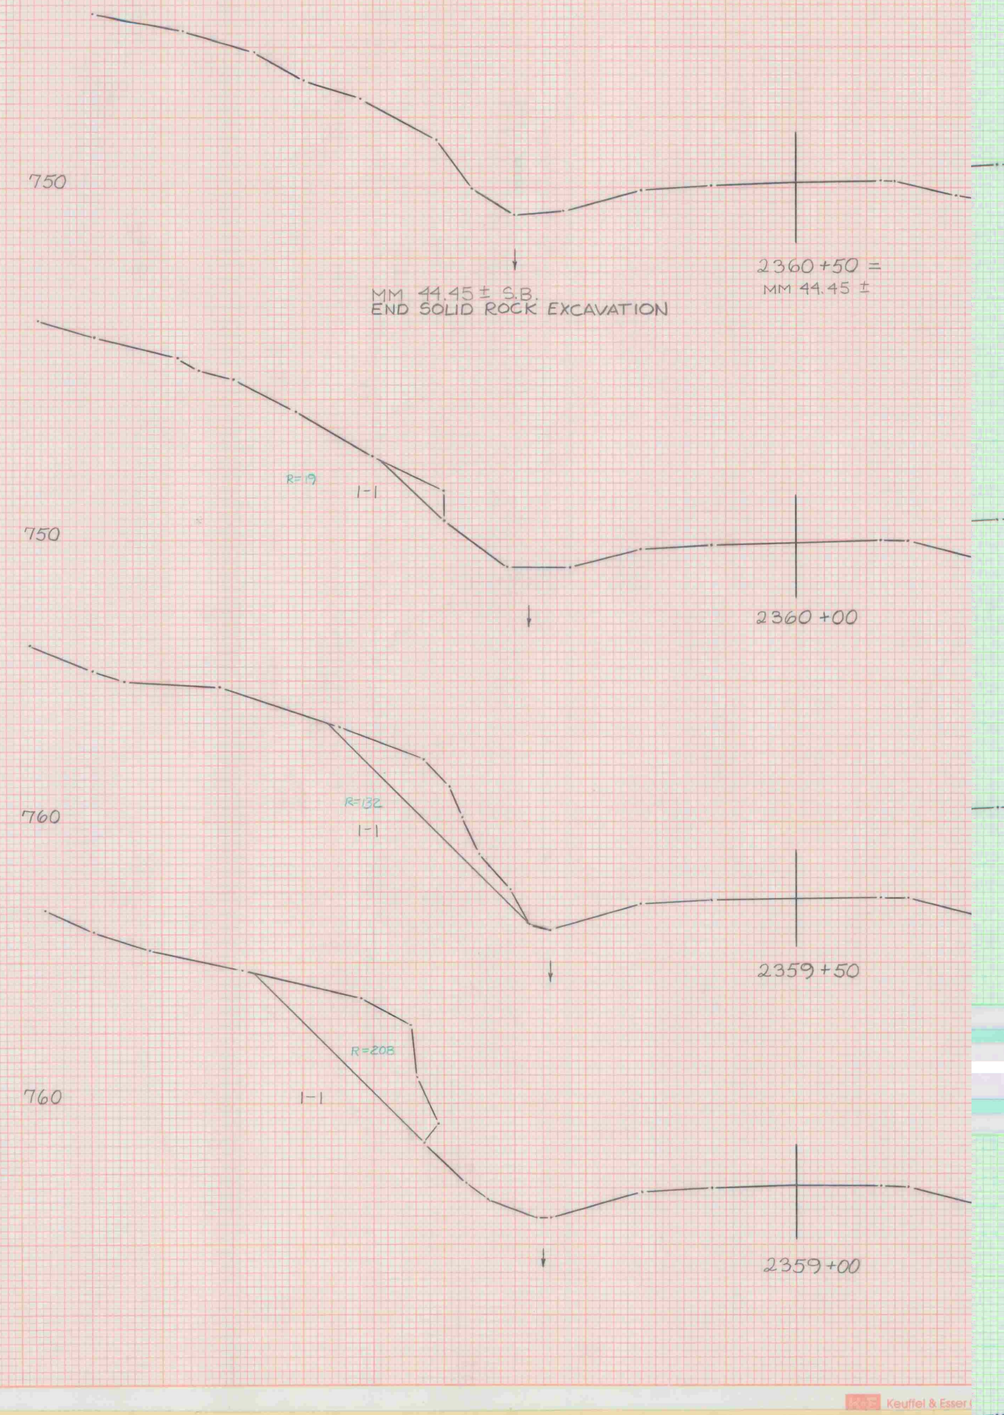


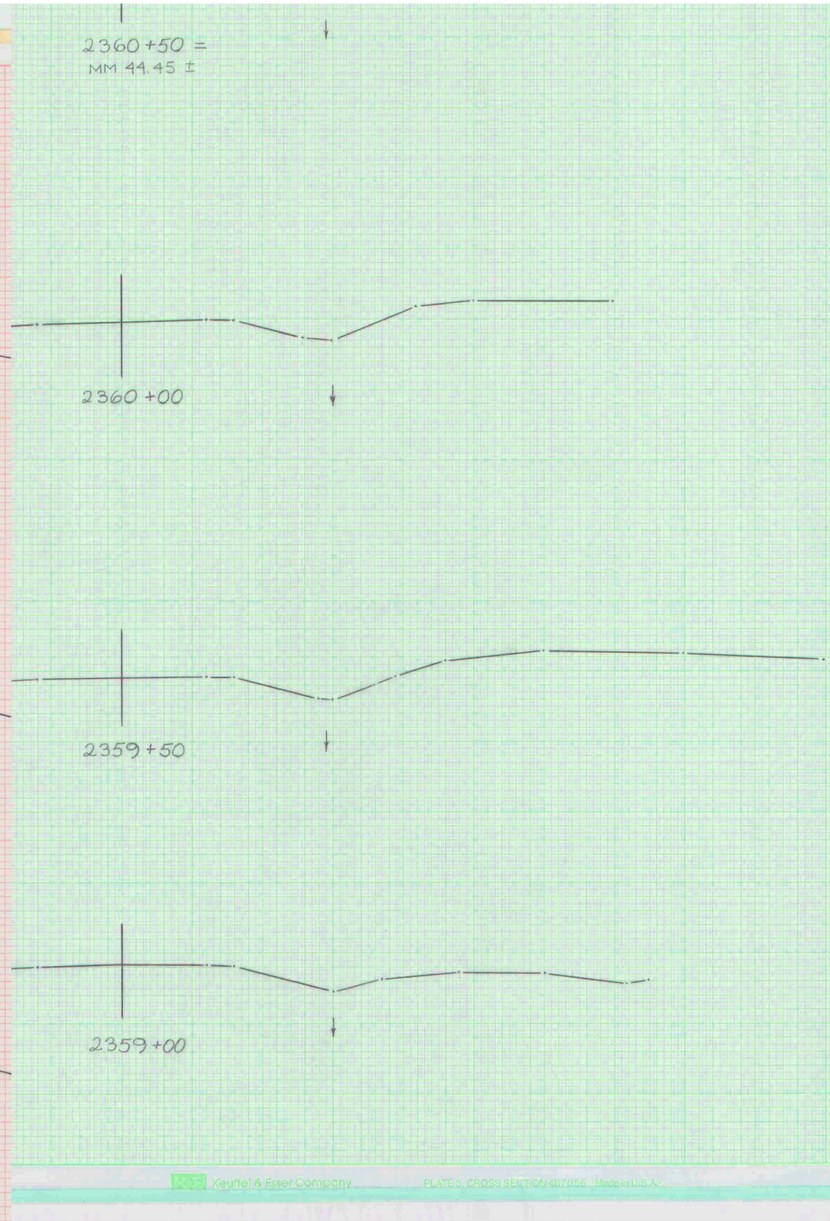

FINAL SURVEY
SURVEYED
PLOTTED
TEMPLATE
AREAS
AREAS CHECKED
WITH BOOK
NO.
BY
DATE
ORIGINAL SURVEY
SURVEYED
PLOTTED
TEMPLATE
AREAS
AREAS CHECKED
WITH BOOK
NO.
BY
DATE
Keuffel & Esser Company
PLATE 6 CROSS SECTION NO. 7026 Made in U.S.A.

MM
STA
TOWN
PROJE
HORIZ.
1"=10'
DATE
SHEET