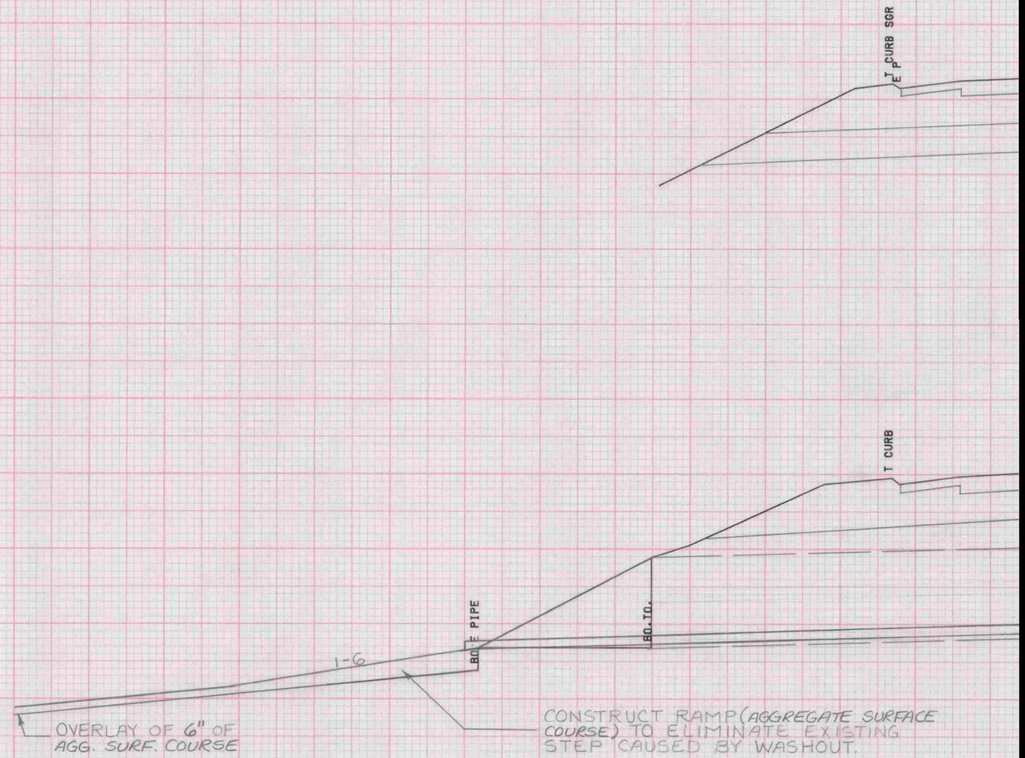
T CURB SGR
T CURB
BO. TO.
E PIPE
1-6
OVERLAY OF 6" OF AGG. SURF. COURSE
CONSTRUCT RAMP (AGGREGATE SURFACE COURSE) TO ELIMINATE EXISTING STEP CAUSED BY WASHOUT.

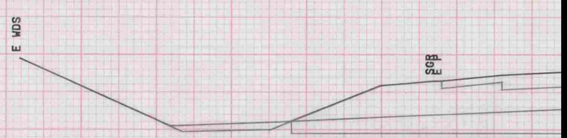
E WDS
SGR
E

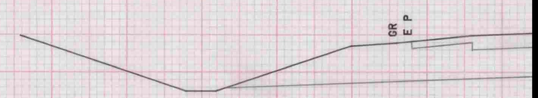
GR
E P