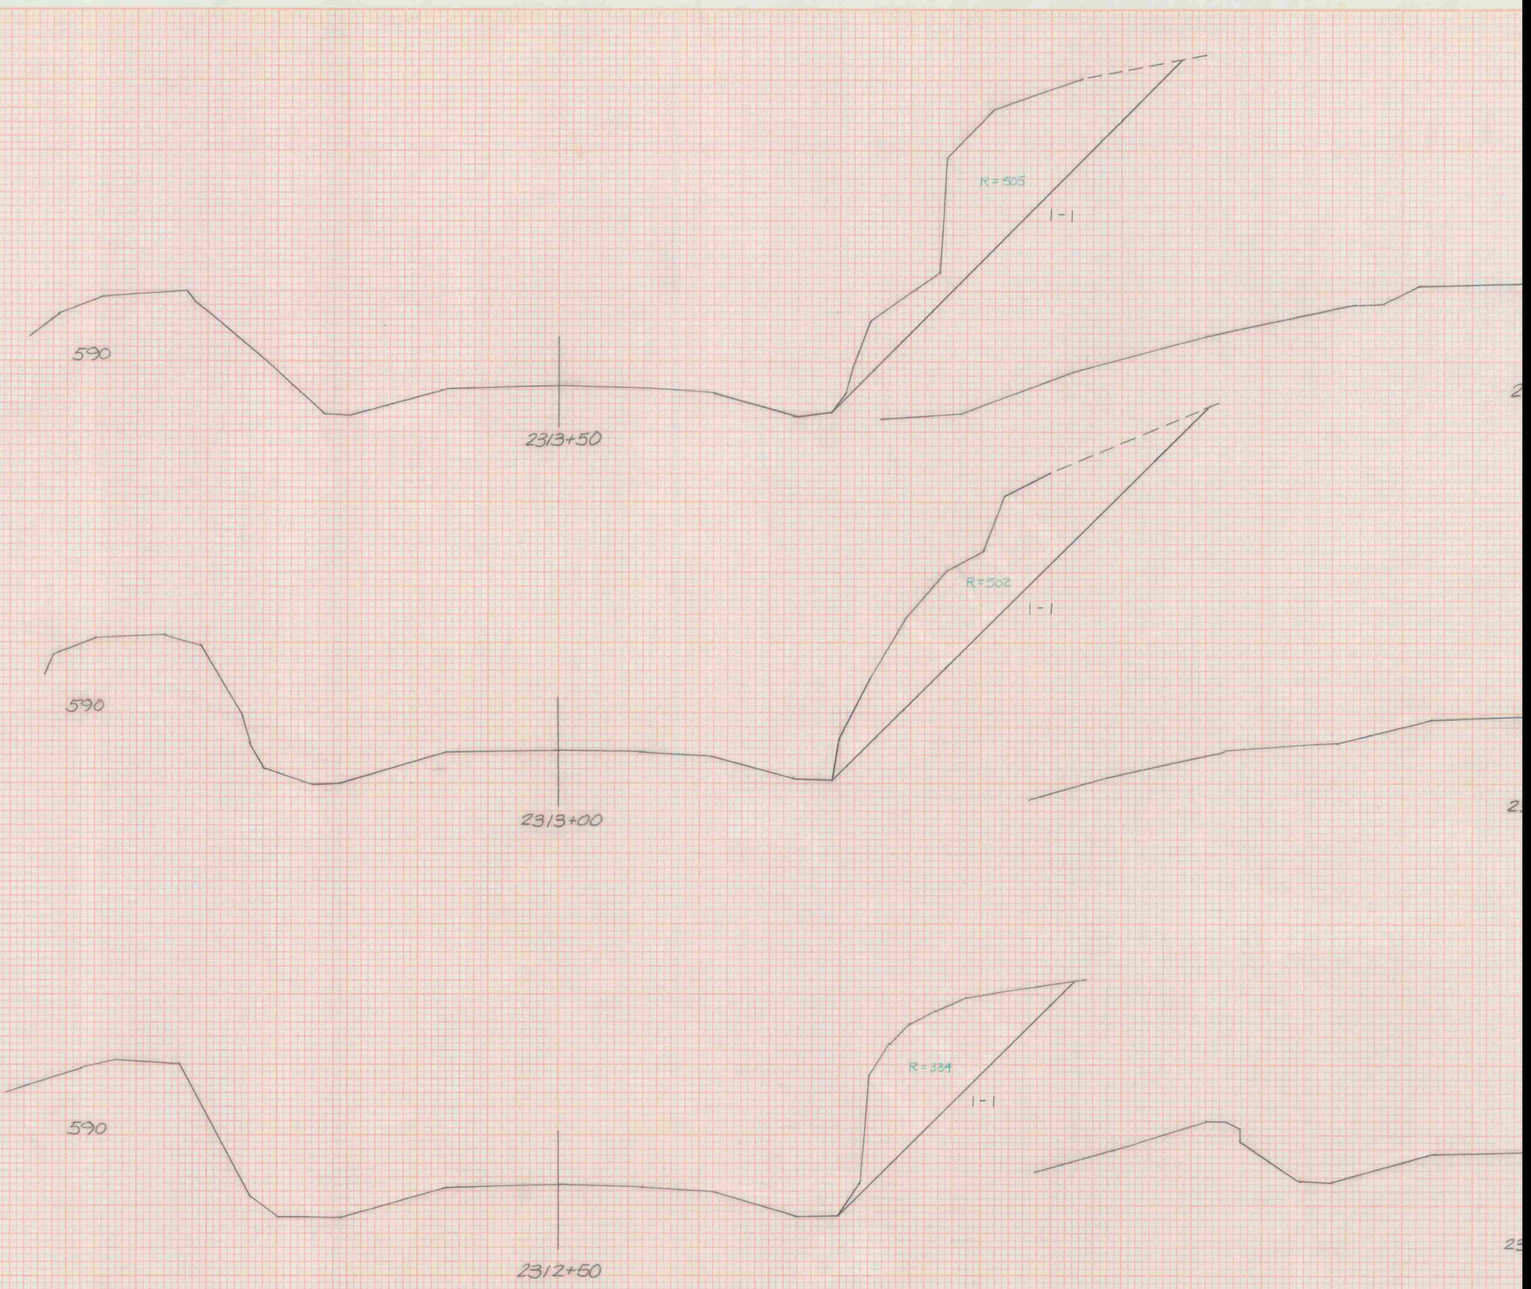


FINAL SURVEY
SURVEYED
COMPUTED
TOPPLATE
AREAS
AREAS CHECKED
BY
DATE
NOTE BOOK
NO.

ORIGINAL SURVEY
SURVEYED
COMPUTED
TOPPLATE
AREAS
AREAS CHECKED
BY
DATE
NOTE BOOK
NO.