FINAL SURVEY
NOTE BOOK
No.
SURVEYED
PLOTTED
TEMPLATE
AREAS
AREAS CHECKED
BY
DATE


183' FROM N.B. E. PAV. TO S.B. E. PAV.




U-TURN @ MM 6
SECTION TAKEN 30' EAST
NO SLOPE FLATTENING REQ

ORIGINAL SURVEY
NOTE BOOK
No.
SURVEYED
PLOTTED
TEMPLATE
AREAS
AREAS CHECKED
BY
DATE

183' FROM N.B. E. PAV. TO S.B. E. PAV.

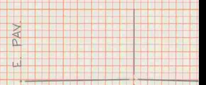

U-TURN @ MM 6
SECTION TAKEN 30' WEST
FLATTEN SOUTH SLOPE

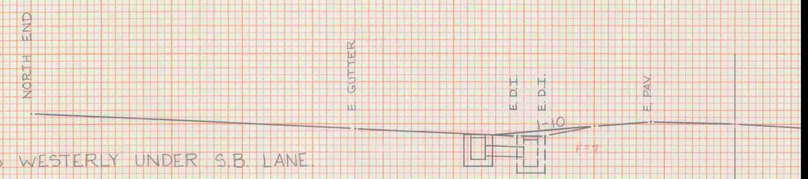

D.I. DUMPS WESTERLY UNDER S.B. LANE

CONSTRUCT NEW R.C.D.I. AT TOE OF PROPOSED SLOPE. INSTALL NEW 18" x 6' OPTION PIPE FROM NEW D.I. INTO EXISTING D.I. & CAP EXISTING D.I.

43' FROM N.B. E.PAV. TO S.B. E.PAV.

U-TURN @ MM 66
FLATTEN NORTH & SO

PLATE 3 CROSS SECTION O. P. R. &