


TBM #2 - SPIKE
IN MED OAK
ELEV 124.276
N: 34081.7000
E: 494640.0680

SPIRAL TRANSITION CURVE
STA 0+183.704 - 0+233.704
INSIDE EDGE OF PAVEMENT ONLY
STA 0+200 - RIGHT OFFSET = 3.615 m±
STA 0+220 - RIGHT OFFSET = 3.811 m±

STA 0+233.704
FULL SUPER +
X SLOPE = 8%

TRANSITION EDGE OF PAVEMENT AT
GORE AREA FOR 31 m NORTH OF
GORE NOSE AT SLOPE OF 35:1

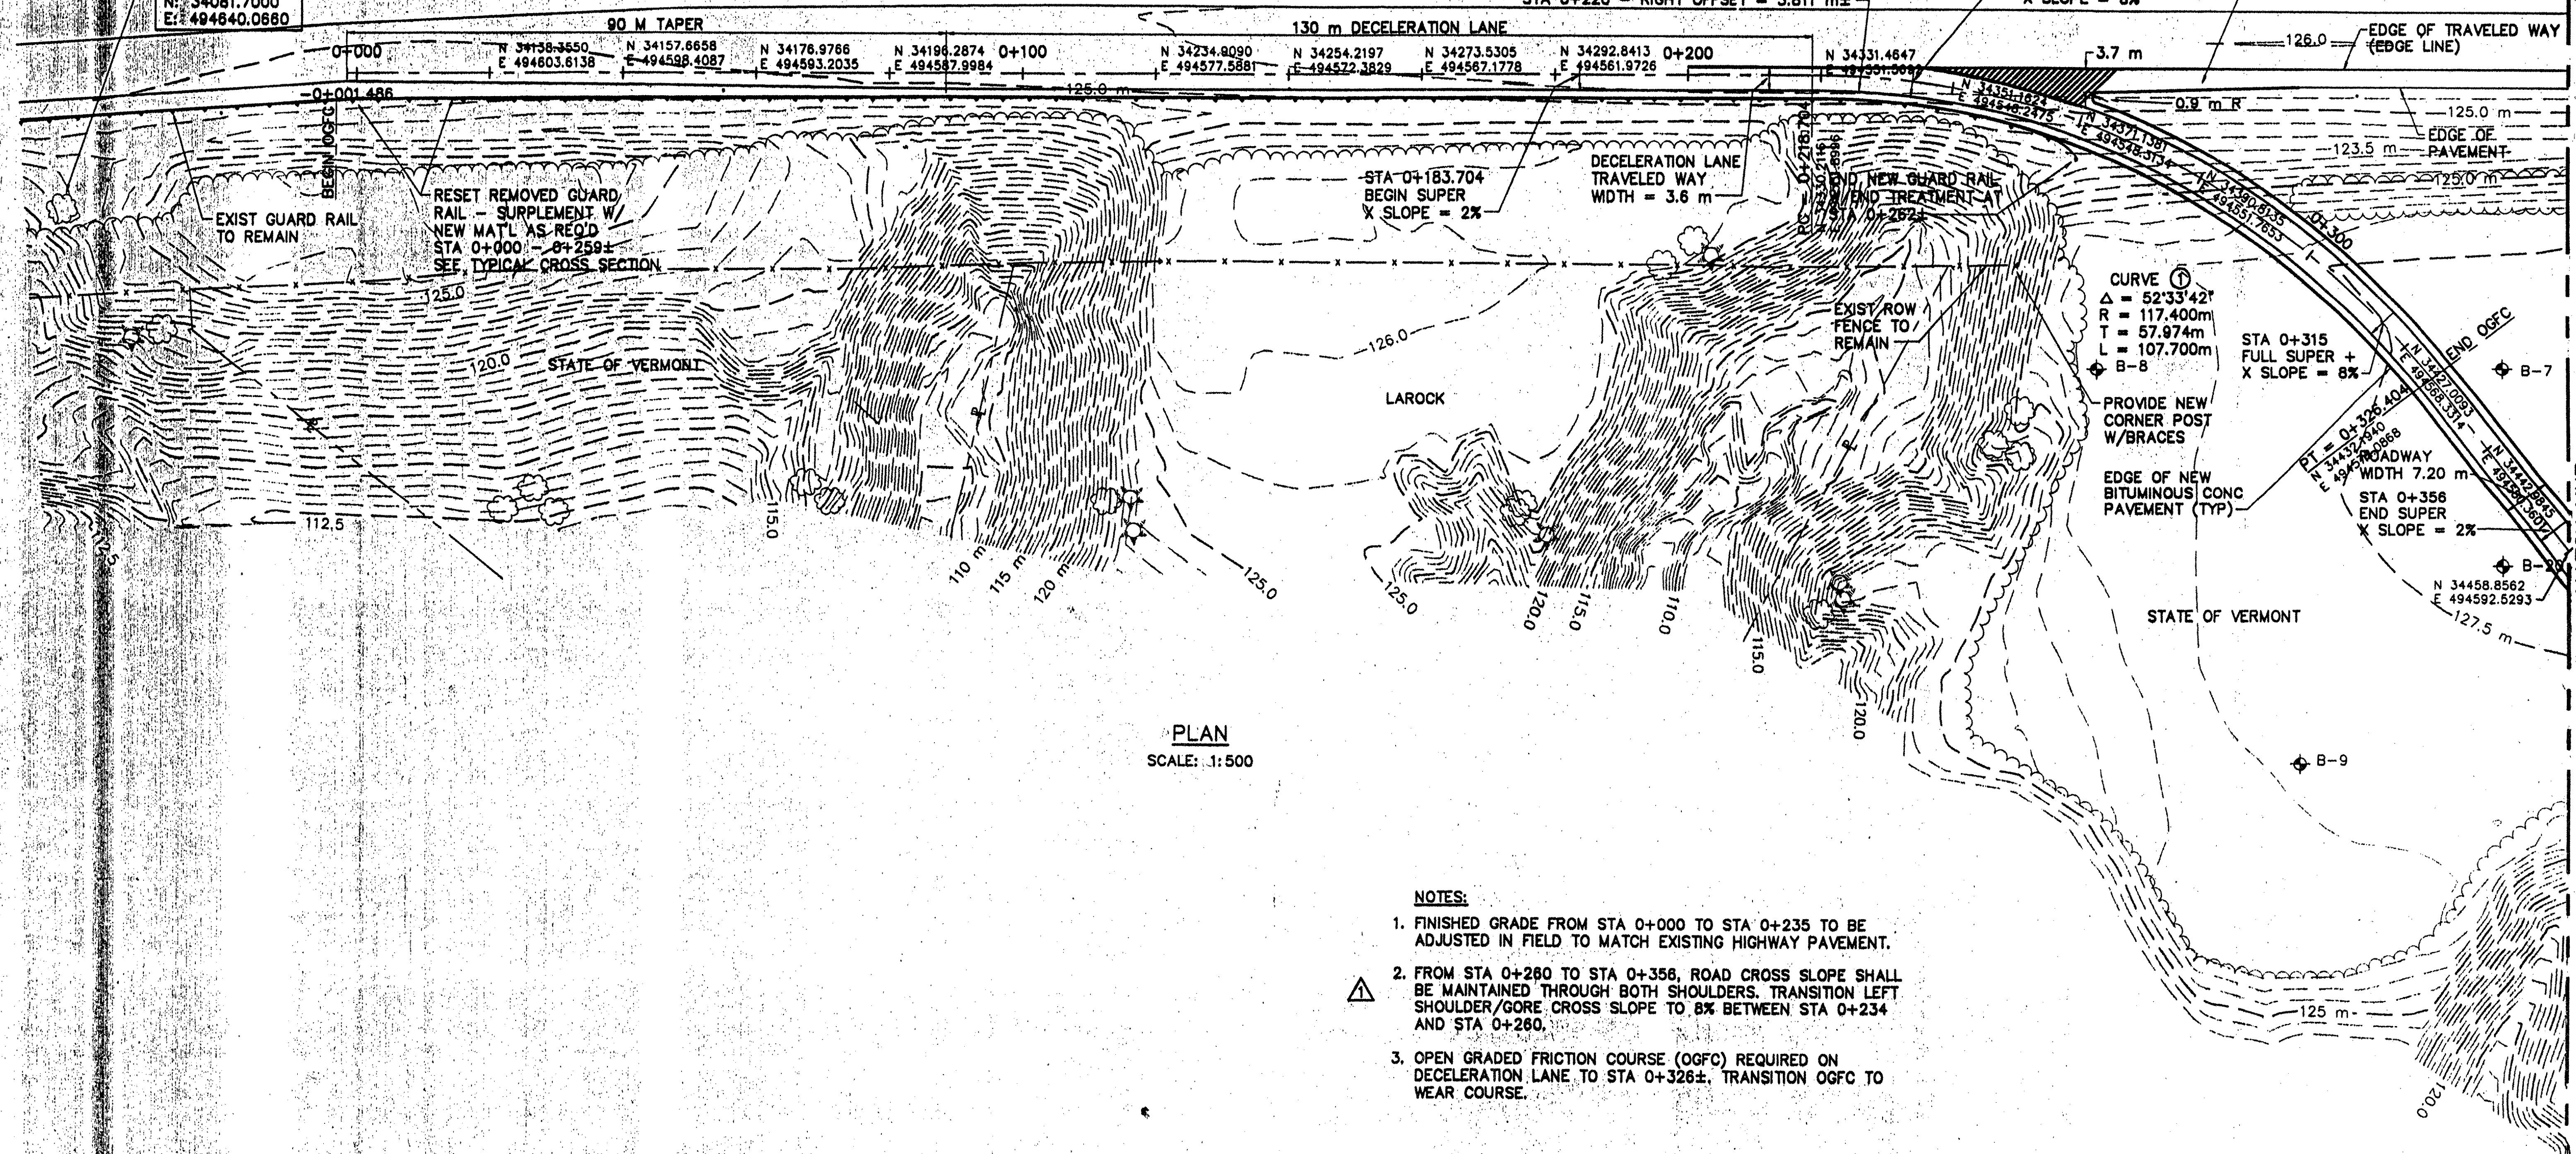

PLAN
SCALE: 1:500

NOTES:

1. FINISHED GRADE FROM STA 0+000 TO STA 0+235 TO BE ADJUSTED IN FIELD TO MATCH EXISTING HIGHWAY PAVEMENT.
2. FROM STA 0+260 TO STA 0+356, ROAD CROSS SLOPE SHALL BE MAINTAINED THROUGH BOTH SHOULDERS. TRANSITION LEFT SHOULDER/GORE CROSS SLOPE TO 8% BETWEEN STA 0+234 AND STA 0+260.
3. OPEN GRADED FRICTION COURSE (OGFC) REQUIRED ON DECELERATION LANE TO STA 0+326±. TRANSITION OGFC TO WEAR COURSE.

GUILFORD
IM 091-1(33)
This sheet for information only.
BR 3 N&S
Sheet 110 of 114

Metric

TIMOTHY D. SMITH & ASSOCIATES, PC ARCHITECTS OLD RAILROAD STATION NORTH BENNINGTON, VERMONT 05257 802-442-8184 FAX 802-442-5241				PROJECT NO. IM 091-1 (30) SOUTHEAST VERMONT WELCOME CENTER GUILFORD, VERMONT PRELIMINARY DRAWINGS				STATE OF VERMONT AGENCY OF ADMINISTRATION DEPARTMENT OF BUILDINGS & GENERAL SERVICES			
WRIGHT ENGINEERING, LTD. ROBT W. HALL T.J. BOYLE AND ASSOCIATES CIVIL ENGINEERS CONSULTING ENGINEERS, INC. LANDSCAPE ARCHITECTS 180 MERCHANTS ROW - P.O. BOX 170 640 MEADOW STREET EXTENSION, STE. 8 301 COLLEGE STREET RUTLAND, VERMONT 05702-0176 AGAWAM, MASSACHUSETTS 01001-0002 BURLINGTON, VERMONT 05401 802-779-2011 FAX 779-2016 415-769-0950 FAX 769-3295 802-686-3655 FAX 865-1682				DSGN BY: JAC DRWN BY: DSM CHKD BY: JAC				CHKD BY: JCO			
NO. DATE REVISIONS				SHEET TITLE: ROAD PLAN				DATE: 1-16-98 SHEET NO. 110 OF 114 SHEETS			

\\CAD2\5501\W00001 Fr1 May 1 10:14:21 1998