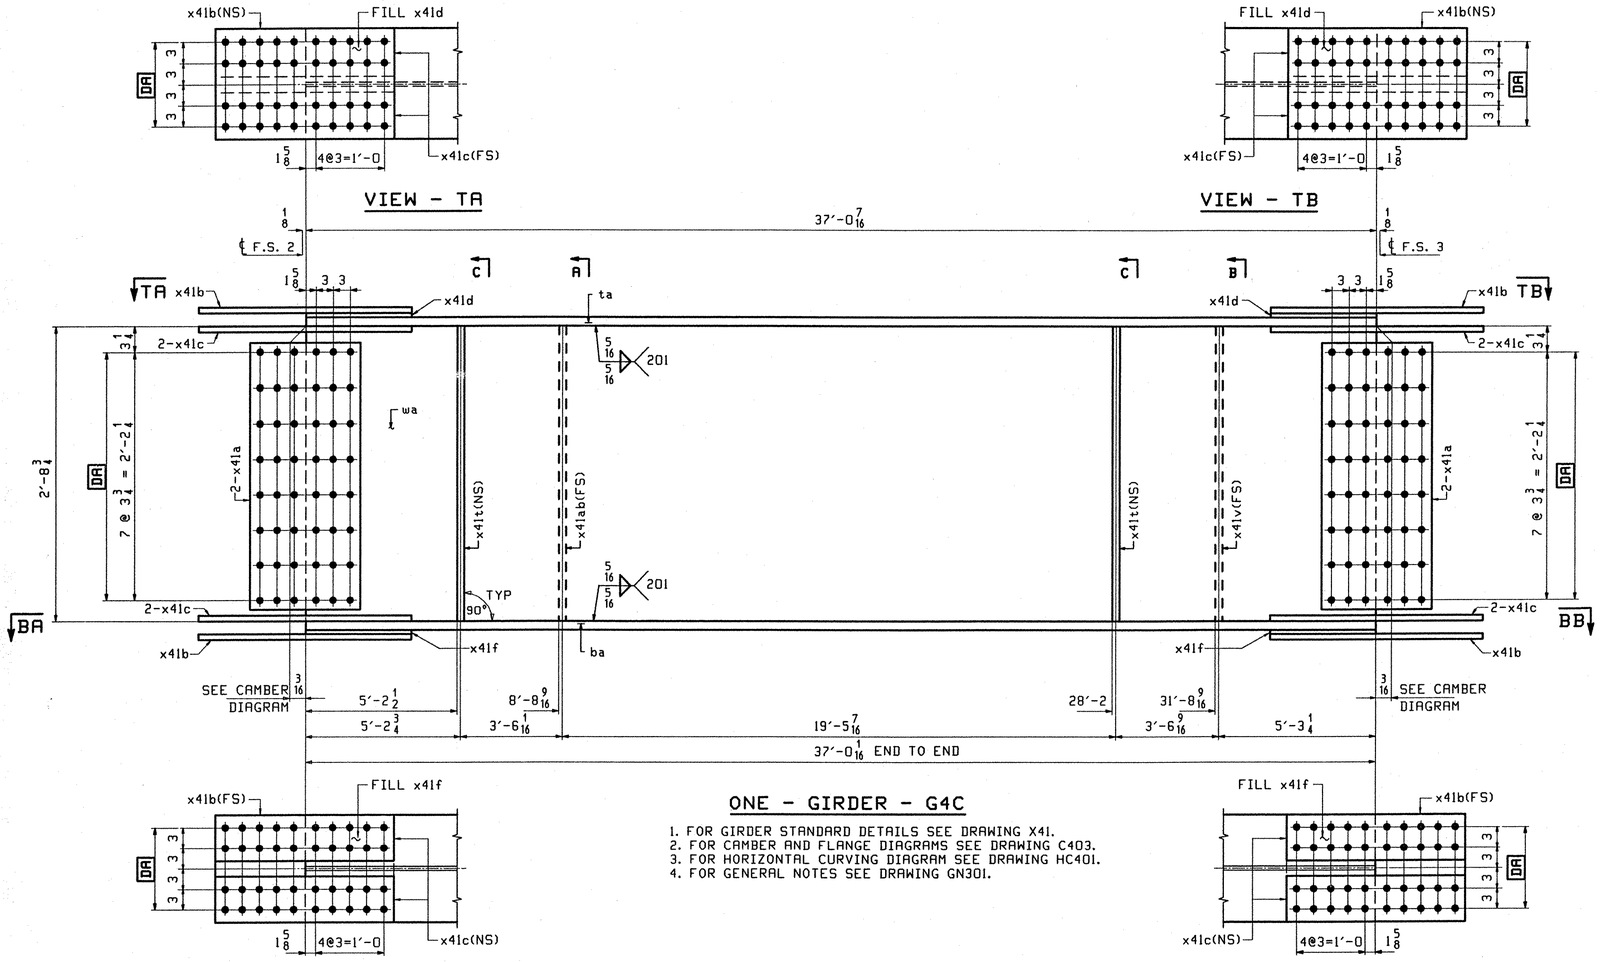

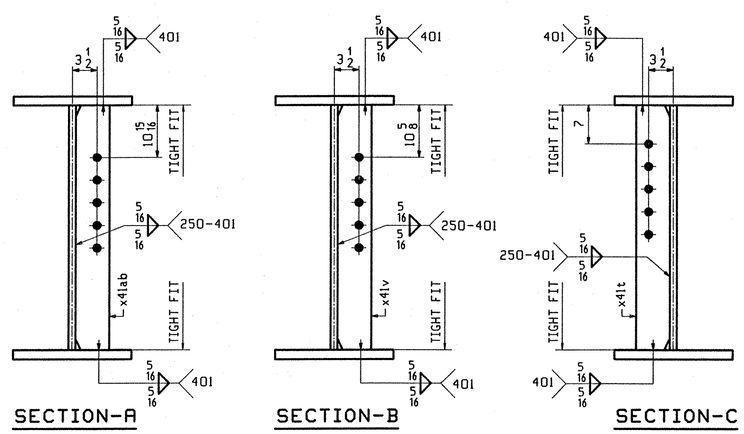

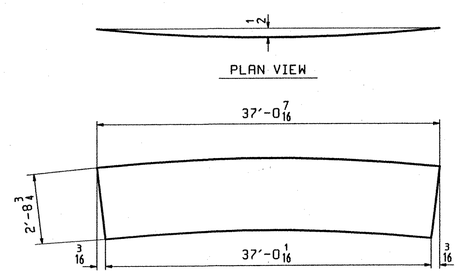

ABM INFO		SHIP	BILL OF MATERIAL					JOB NO.	DRAWING NO.	REV.
									414	
PAGE	LINE	MARK	QTY	MARK	MATERIAL	LENGTH FT	LENGTH INCHES	REMARKS	WT	PROCUREMENT NOTES
		G4C	1		GIRDER				7033	
401	Q		1	wa	PL 1/2x33 7/16	37	0 7/16	(H270-50WT2) (H2-3)		
401	J		1	ta	PL 7/8x16	37	0 7/16	(H270-50WT2) (H2-3)		
401	E		1	ba	PL 15/16x16	37	0 1/16	(H270-50WT2) (H2-3)		
402	B		4	x41a	PL 1/2x29 3/4	1	7	(H270-50WT2) (H2-3)		
402	C		4	x41b	PL 5/8x16	2	7	(H270-50WT2) (H2-3)		
402	D		8	x41c	PL 5/8x7	2	7	(H270-50WT2) (H2-3)		
402	F		2	x41d	PL 3/4x16	1	3 3/8	FILL		
402	G		2	x41f	PL 11/16x16	1	3 3/8	FILL		
402	M		2	x41t	PL 1/2x5	2	8 3/4			
402	M		1	x41ab	PL 1/2x5	2	8 3/4			
402	M		1	x41v	PL 1/2x5	2	8 3/4			

TVGA
Engineering, Surveying, P.C.

☒ NO EXCEPTIONS TAKEN ☐ REJECTED
☐ FURNISH AS CORRECTED
☐ REVISE AND RESUBMIT
ENGINEER has reviewed Shop Drawings and Samples and other data which Contractor is required to submit, only for conformance with the information given in the Contract Documents and compatibility with the design concept of the completed Project as a functioning whole as indicated in the Contract Documents. Such review do not extend to means, methods, techniques, sequences, or procedures of construction or to safety precautions and programs incident thereto. Contractor is responsible for dimensions to be confirmed and correlated at the job site; for information that pertains solely to the fabrication processes or to techniques of construction; and for coordination of the work of all trades.

BY: [illegible]
DATE: 01-11-2002

OUT FOR APPROVAL	10-03-01									
OUT FOR APPROVAL										
ISSUED TO SHOP										
FIELD & OFFICE										
REV.	REMARKS	DATE	DWN	CHK	APP	Q.A.	NO.	DIA.	LGT	TYPE	WASHER

MATERIAL:	ELECTRODES:	HOLES:	SHOP BOLTS:
M270 GR. 50W (UN)		15/16 ø (U.N.)	7/8 ø (U.N.)

SURFACE PREP. & PAINT:
- STEEL WITHIN 10'-0 OF ABUT. 2 SHALL BE PAINTED (SEE GN301)
- ALL OTHER STEEL SHALL BE BLAST CLEANED AND LEFT UNPAINTED.

DESCRIPTION: GIRDER - G4C	DRAWN BY	DATE
JOB: I-89 NB OVER LITTLE RIVER I-89 IMPROVEMENTS BETWEEN TOWNS OF MIDDLESEX & BOLTON COUNTY OF WASHINGTON VERMONT	BW	08/02
	CHKD BY	
	ELC	9/12/01
	APPROV BY	
TENSOR 2107-N	SUPERVISOR	W. J. GATTI
PROJ NO. IM-089-2(26)	Q.A.	
CUSTOMER: VERMONT AGENCY OF TRANSPORTATION		

CASCO BAY STEEL STRUCTURES, INC.
75 SPRING HILL ROAD SACO, MAINE 04072
PHONE (207) 282-7360 FAX. (207) 282-1179

JOB NO.	DRG. NO.
119-48N	414
	REV. △

BW Thu Sep 20 14:14:46 EDT 2001 /home/r/jobs/2107-2w/414 : Rev0