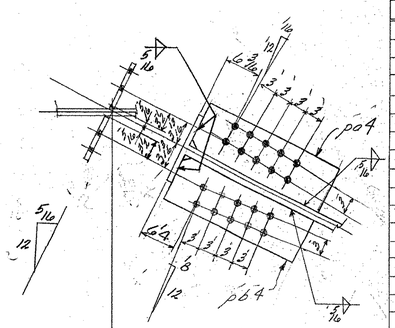

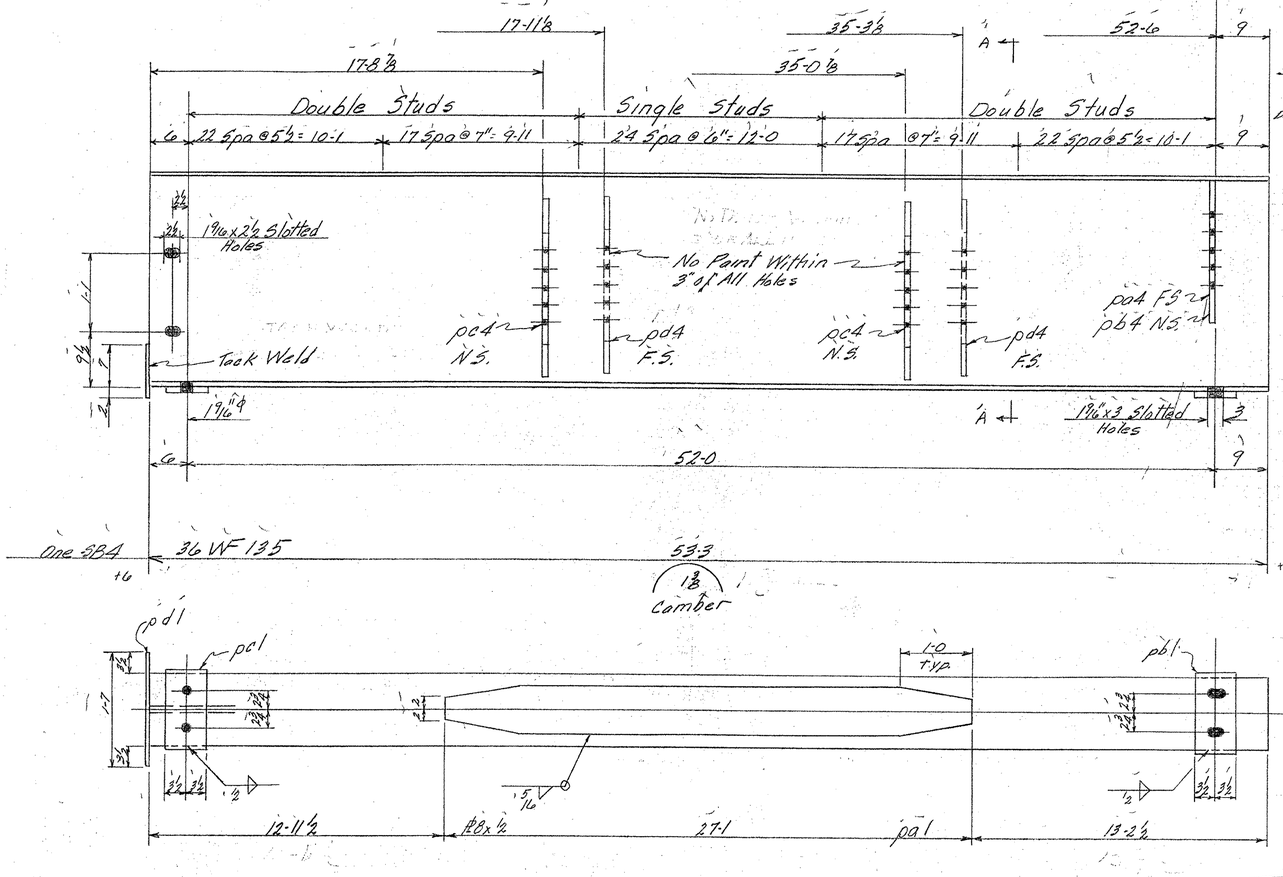

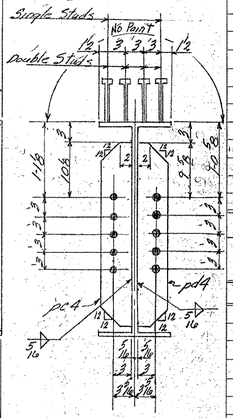

BILL OF MATERIAL

NO. PIECES	MARK	DESCRIPTION	LENGTH FT.	LENGTH IN.		WEIGHT	

JOB NO. _____ SHEET NO. _____

BILL OF MATERIAL

ASTM-A36 17 (17)

NO. PIECES	MARK	DESCRIPTION	LENGTH FT.	LENGTH IN.		WEIGHT	
		Beam					
1	36A	36 WF 135	53	3	ord BB6682	7189	V
1	pa1	Bar 8 x ½	27	1	ord BB6679	368	V
1	pb1	Bar 7 x 1	1	1	Reqd @ 20-0		
1	pb1	do	1	1		52	V
1	pd1	PL 9 x ½	1	7	Cut PL 48 x 4 x 10-0	13	V
2	pd4	Bar 5 x ½	2	6	Reqd @ 20-0	43	V
1	pc4	Bar 8 x ½	2	0	Reqd @ 20-0		
1	pb4	do	2	0	ord BB6679	54	V
2	pa4	Bar 5 x ½	2	6	Reqd @ 20-0	43	V
		½" Weld	2	4		2	V
		5/16" Weld	84	9		~~31.21~~	
		Con't #66-1184-226				7785	~~7795~~
366		⅞" Shear Studs	0	7	Stk	368	368 V
							8163

VERMONT STRUCTURAL STEEL CORPORATION
BURLINGTON, VT.

Proj. # I89-3(35) Cont. #2

		DATE
DRAWN BY	LC	11-9-66
OK'D BY	RLM	11-21-66

HOLES 15/16" ϕ As Noted
BOLTS None
PAINT Red Lead V.T.
Spaces As Noted

PROJECT I89 Over Approach Road
LOCATION Georgia-Fairfax-Fairfield-St. Albans
CUSTOMER Lane Constr. Co.
ARCHITECT State of Vt. Dept. of Highways
JOB NO. 66-1184-200 SHEET NO. 4
66-1184-226 Shear Studs

PRINT RECORD NO.	FOR	DATE
3	APP	11-24
2 P	SHOP	11-24
1 ⓐ	Shop	12-5
2	STATE	12-8
2	LANE	12-28

BRIDGE SHEET BR468
REFERENCE SHEET 14 OF 37
SHEET 220 OF 370

SM 10-63 GCP