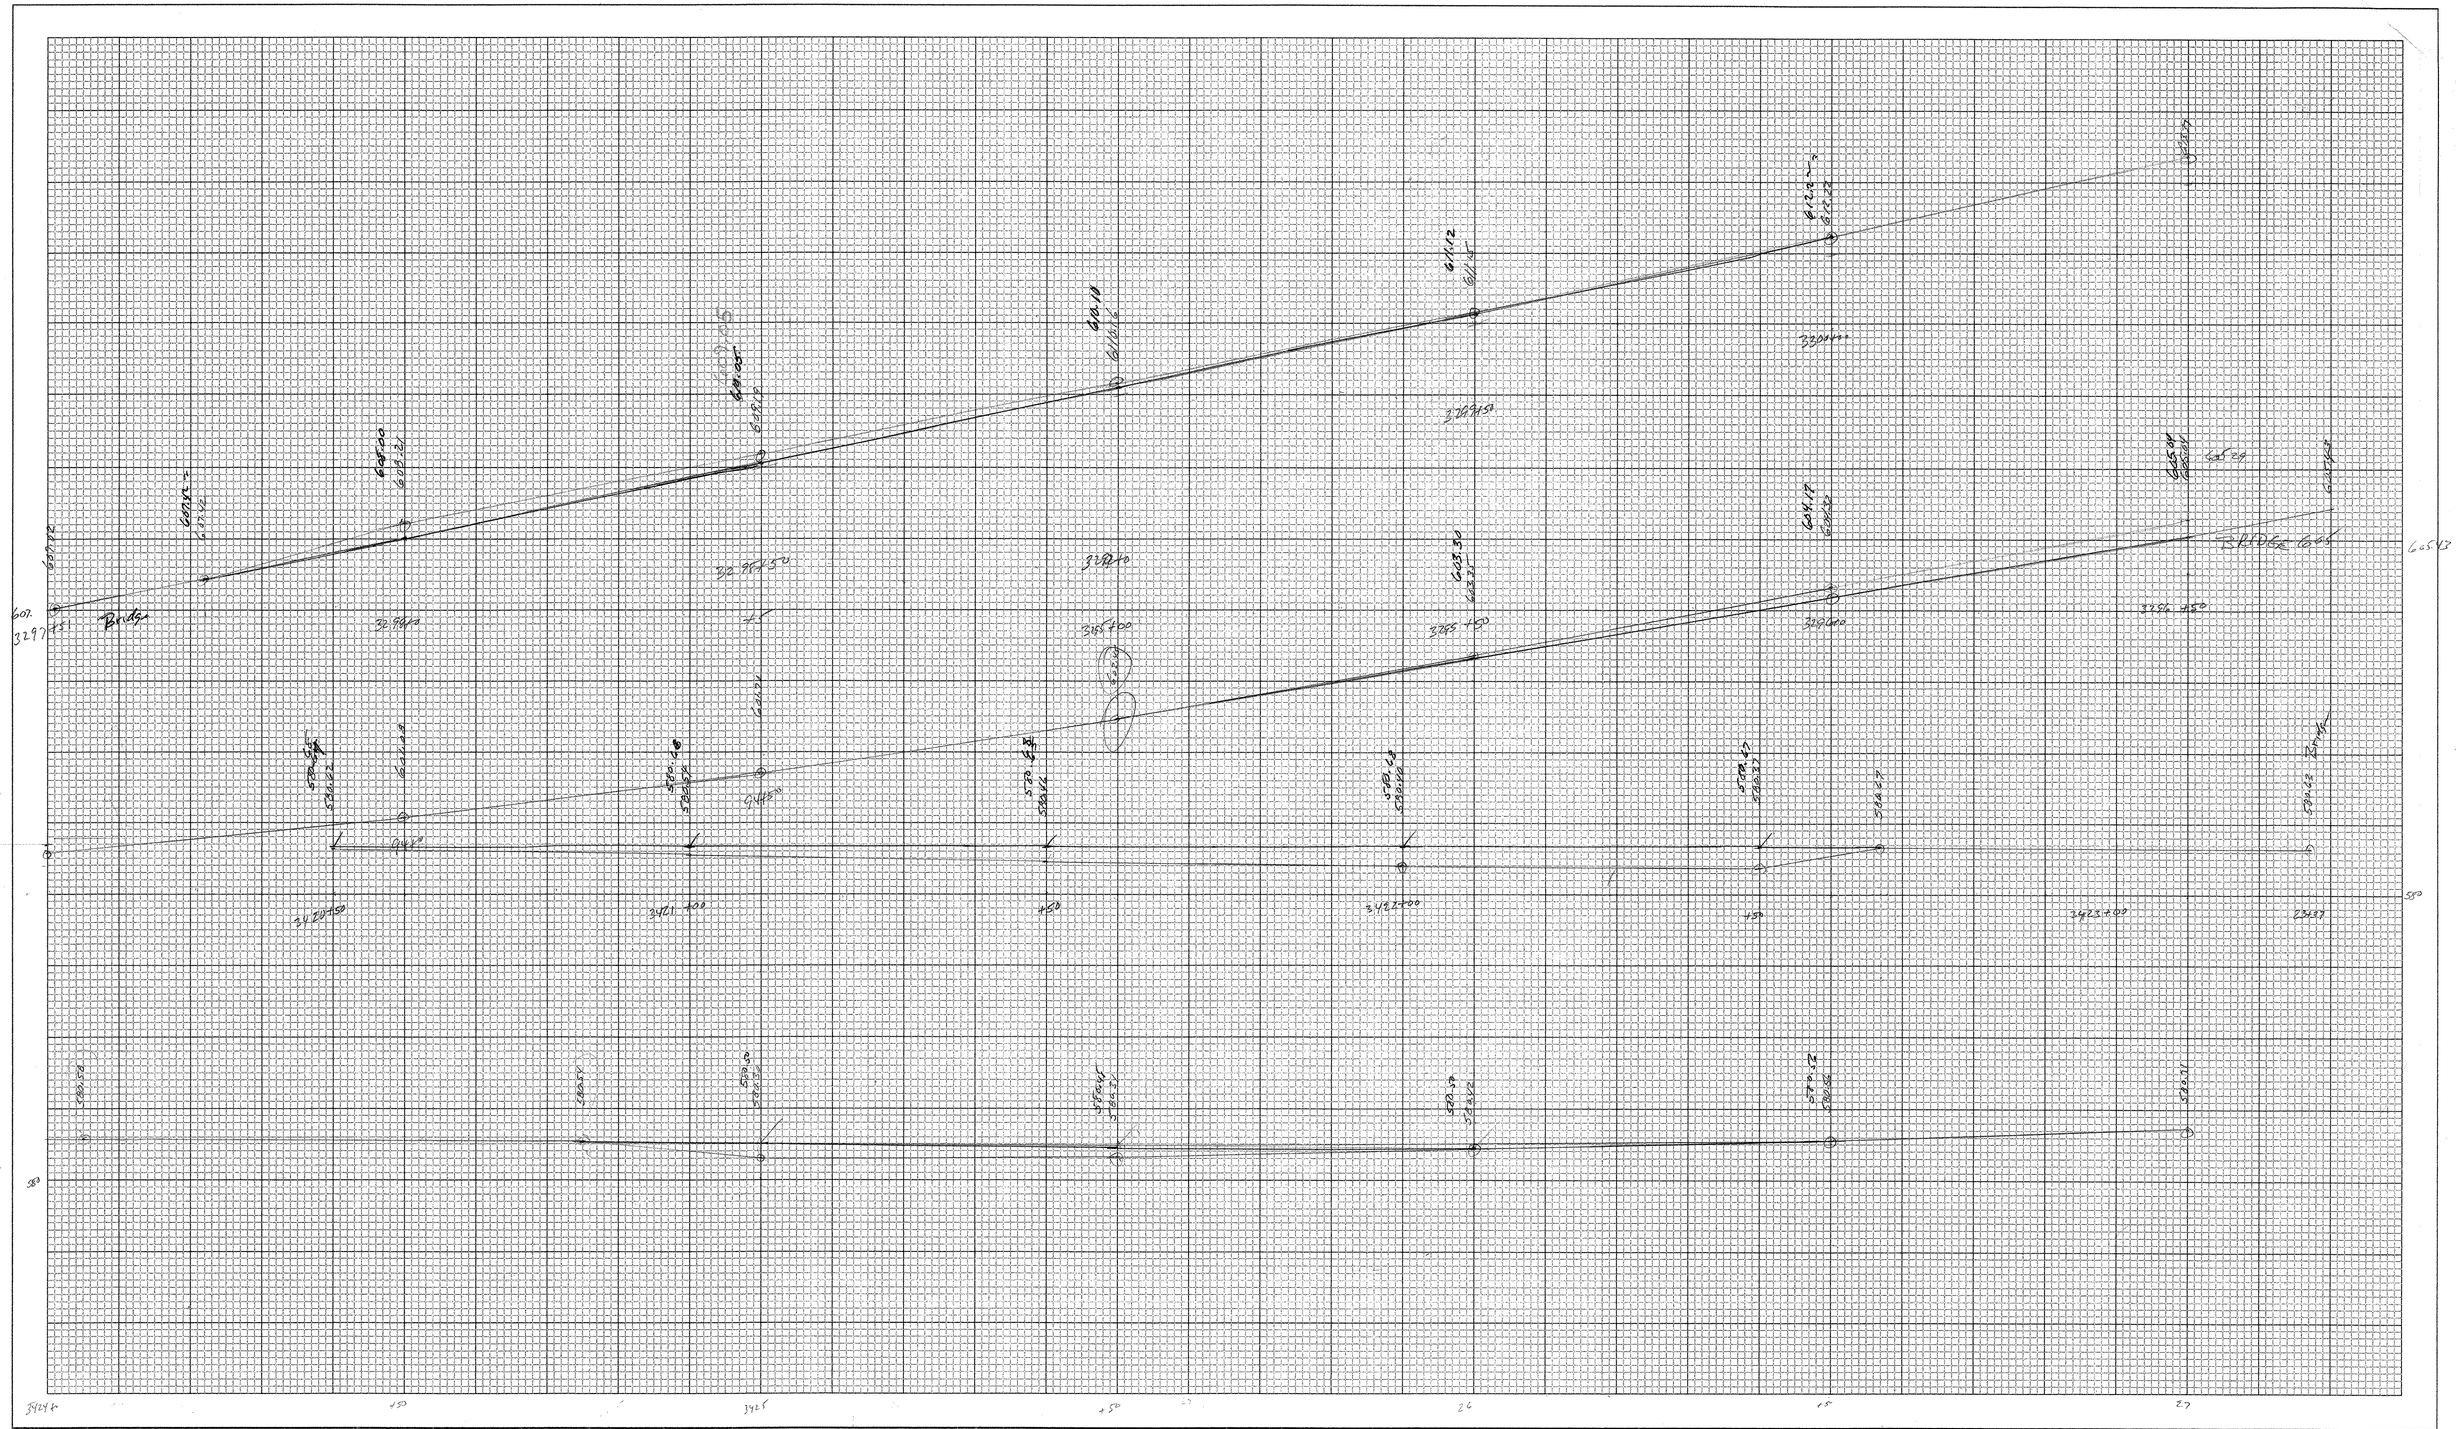

CROSS SECTION SHEET

PROJECT NAME:	
PROJECT NUMBER:	
FILE NAME:	PLOT DATE: 05-JUN-2000 09
PROJECT LEADER:	DRAWN BY:
DESIGNED BY:	CHECKED BY:
const: g:/common/cadd/e-xsection.dgn	SHEET ~~413~~ OF 467