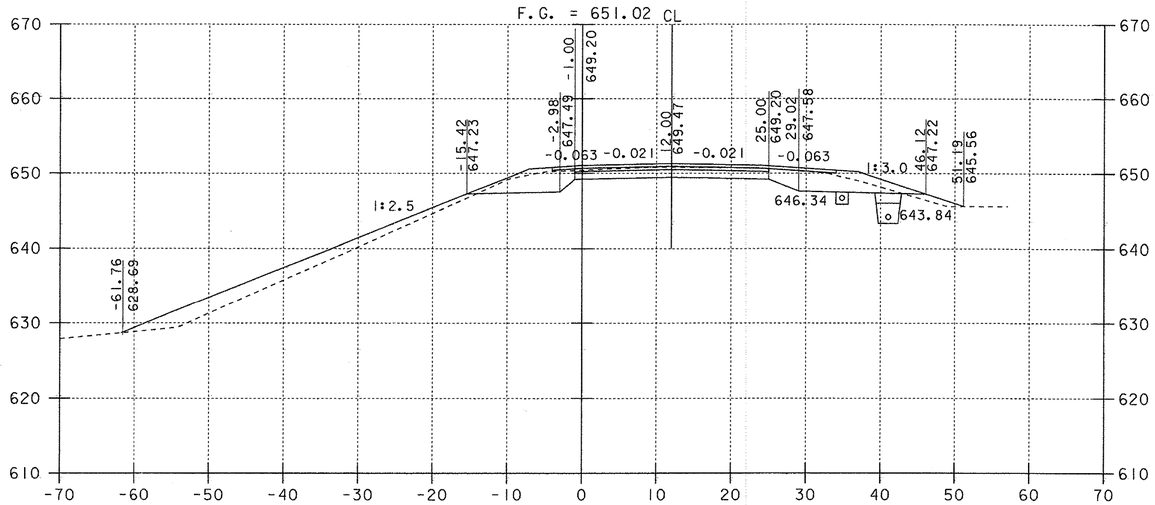

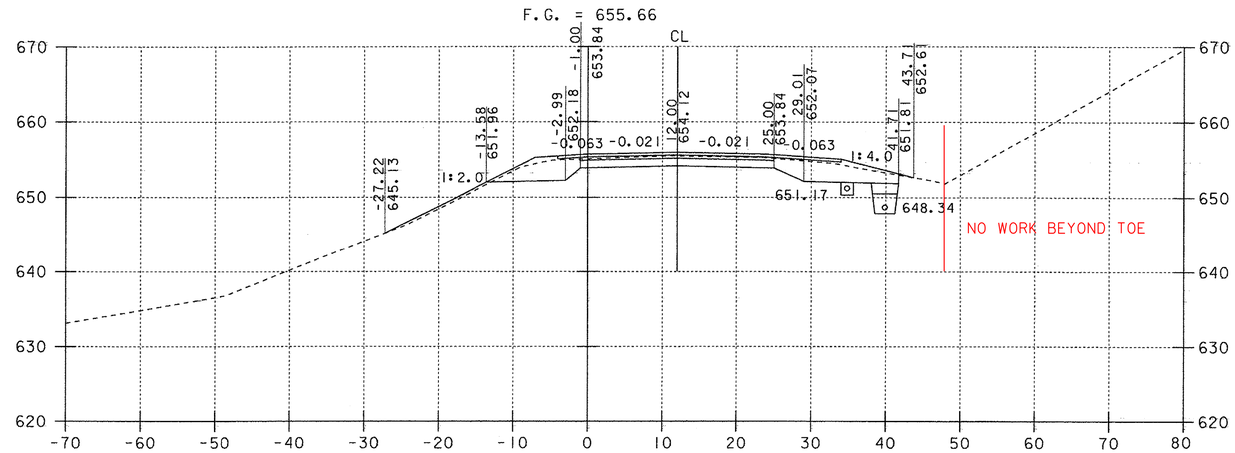

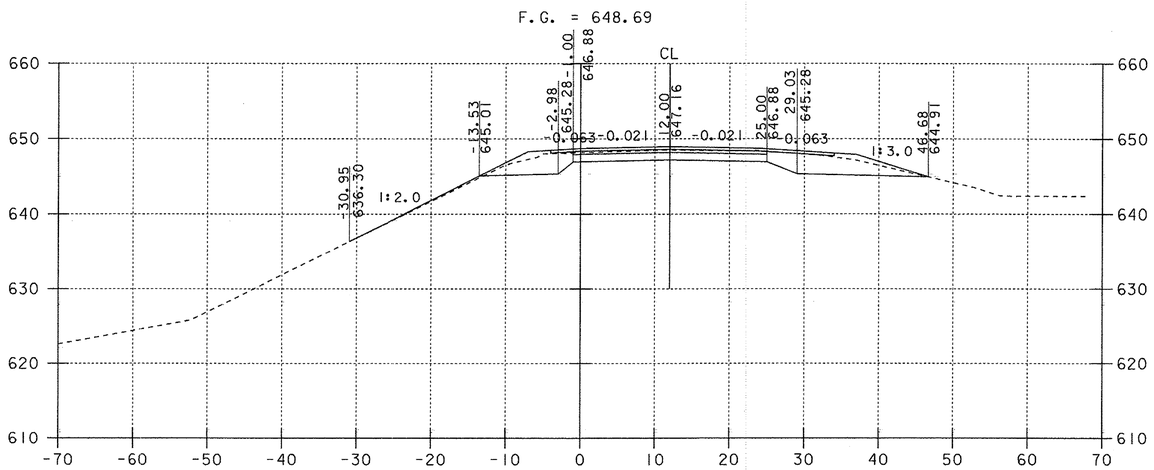

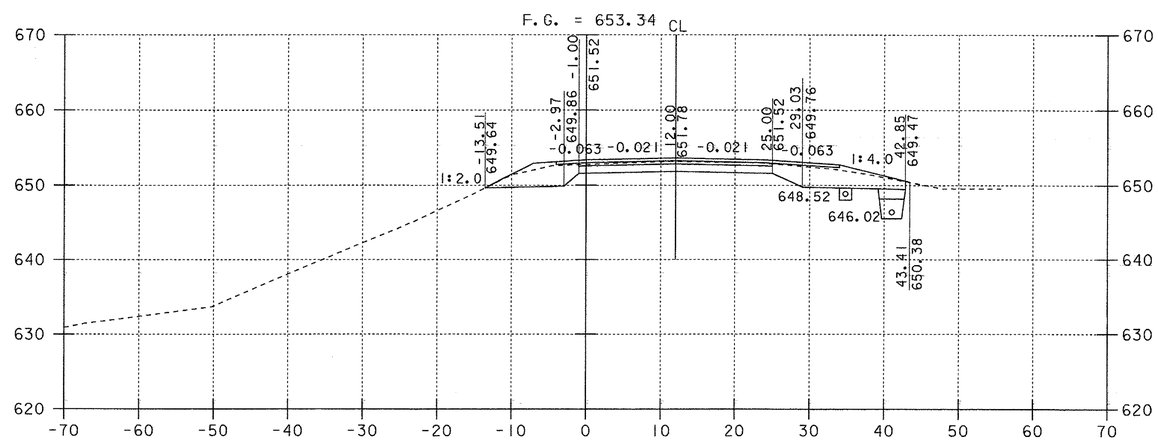

NOTE: OFFSET DISTANCES ARE MEASURED FROM THE GRADE LINE.

0 10 20
SCALE IN FEET

NORTHBOUND CROSS SECTIONS

PROJECT: FAIRFAX - FAIRFIELD - ST. ALBANS	PROJECT NO.: IM 089-3(27)
DESIGN FILE NAME: /87A007B/DESIGN/DA007XSI.DGN IPARM FILE NAME: DA007X07 SURVEYED BY: ORVIS SQUAD LEADER: DELLA SANTA	PLOT DATE: 25-JAN-2002 SURVEY DATE: 6/98 DRAWN BY: SQUAD B SHEET: 346 OF 370